

3/16/92 1 ADDED CONC ENCASEMENT TO S/S LINE 'B'


CITY OF ADDISON, TEXAS
 DEPT. OF PUBLIC WORKS—ENGINEERING DIV.
 WAL-MART/SAM'S CLUB
 ACCESS ROAD
 SANITARY SEWER LINE 'B' / 24" R.C.P. STORM DRAIN

DUNAWAY ASSOCIATES, Inc.
 ENGINEERS - PLANNERS - SURVEYORS
 FORT WORTH, TEXAS

SUB. _____ CONSULTING ENGINEER REC. _____ CHIEF DESIGN ENGINEER

REV. _____ ENGINEER

DESIGNED: OCS DATE _____ FILE _____ SHEET _____
 DRAWN: JCP
 CHECKED: TOH FEB. 1992 9102800 6A OF 24

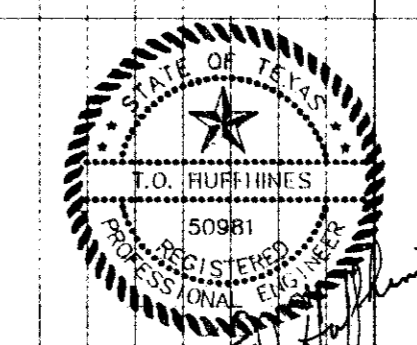

AS BUILT PLANS