

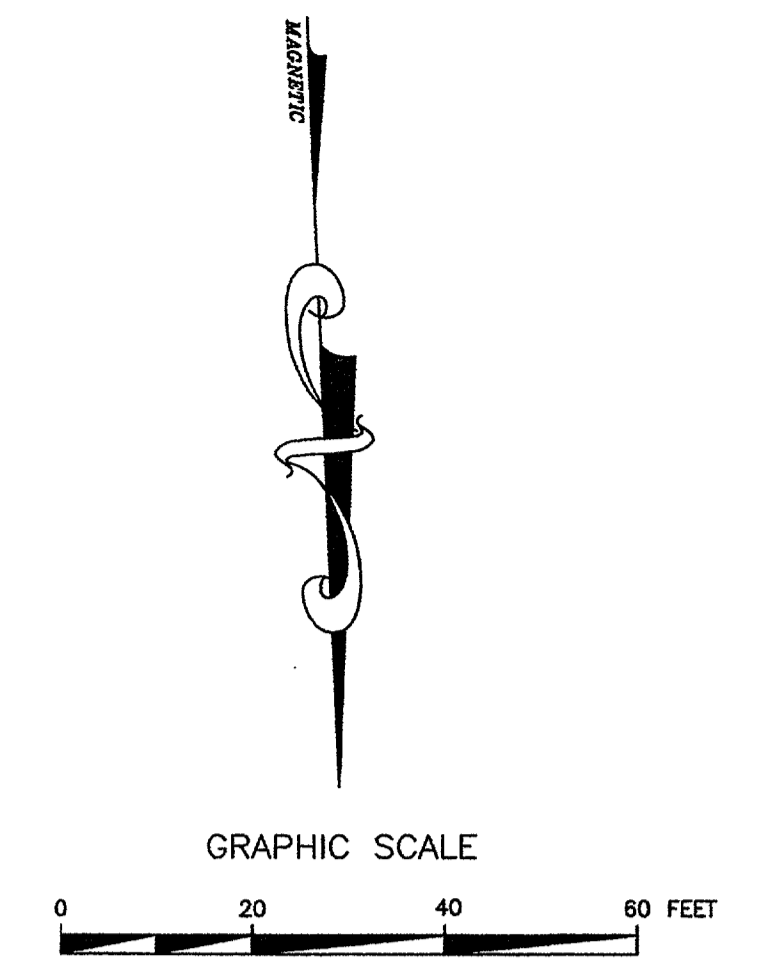


EXISTING SAM'S CLUB #6376
 F.F.E.=100.00

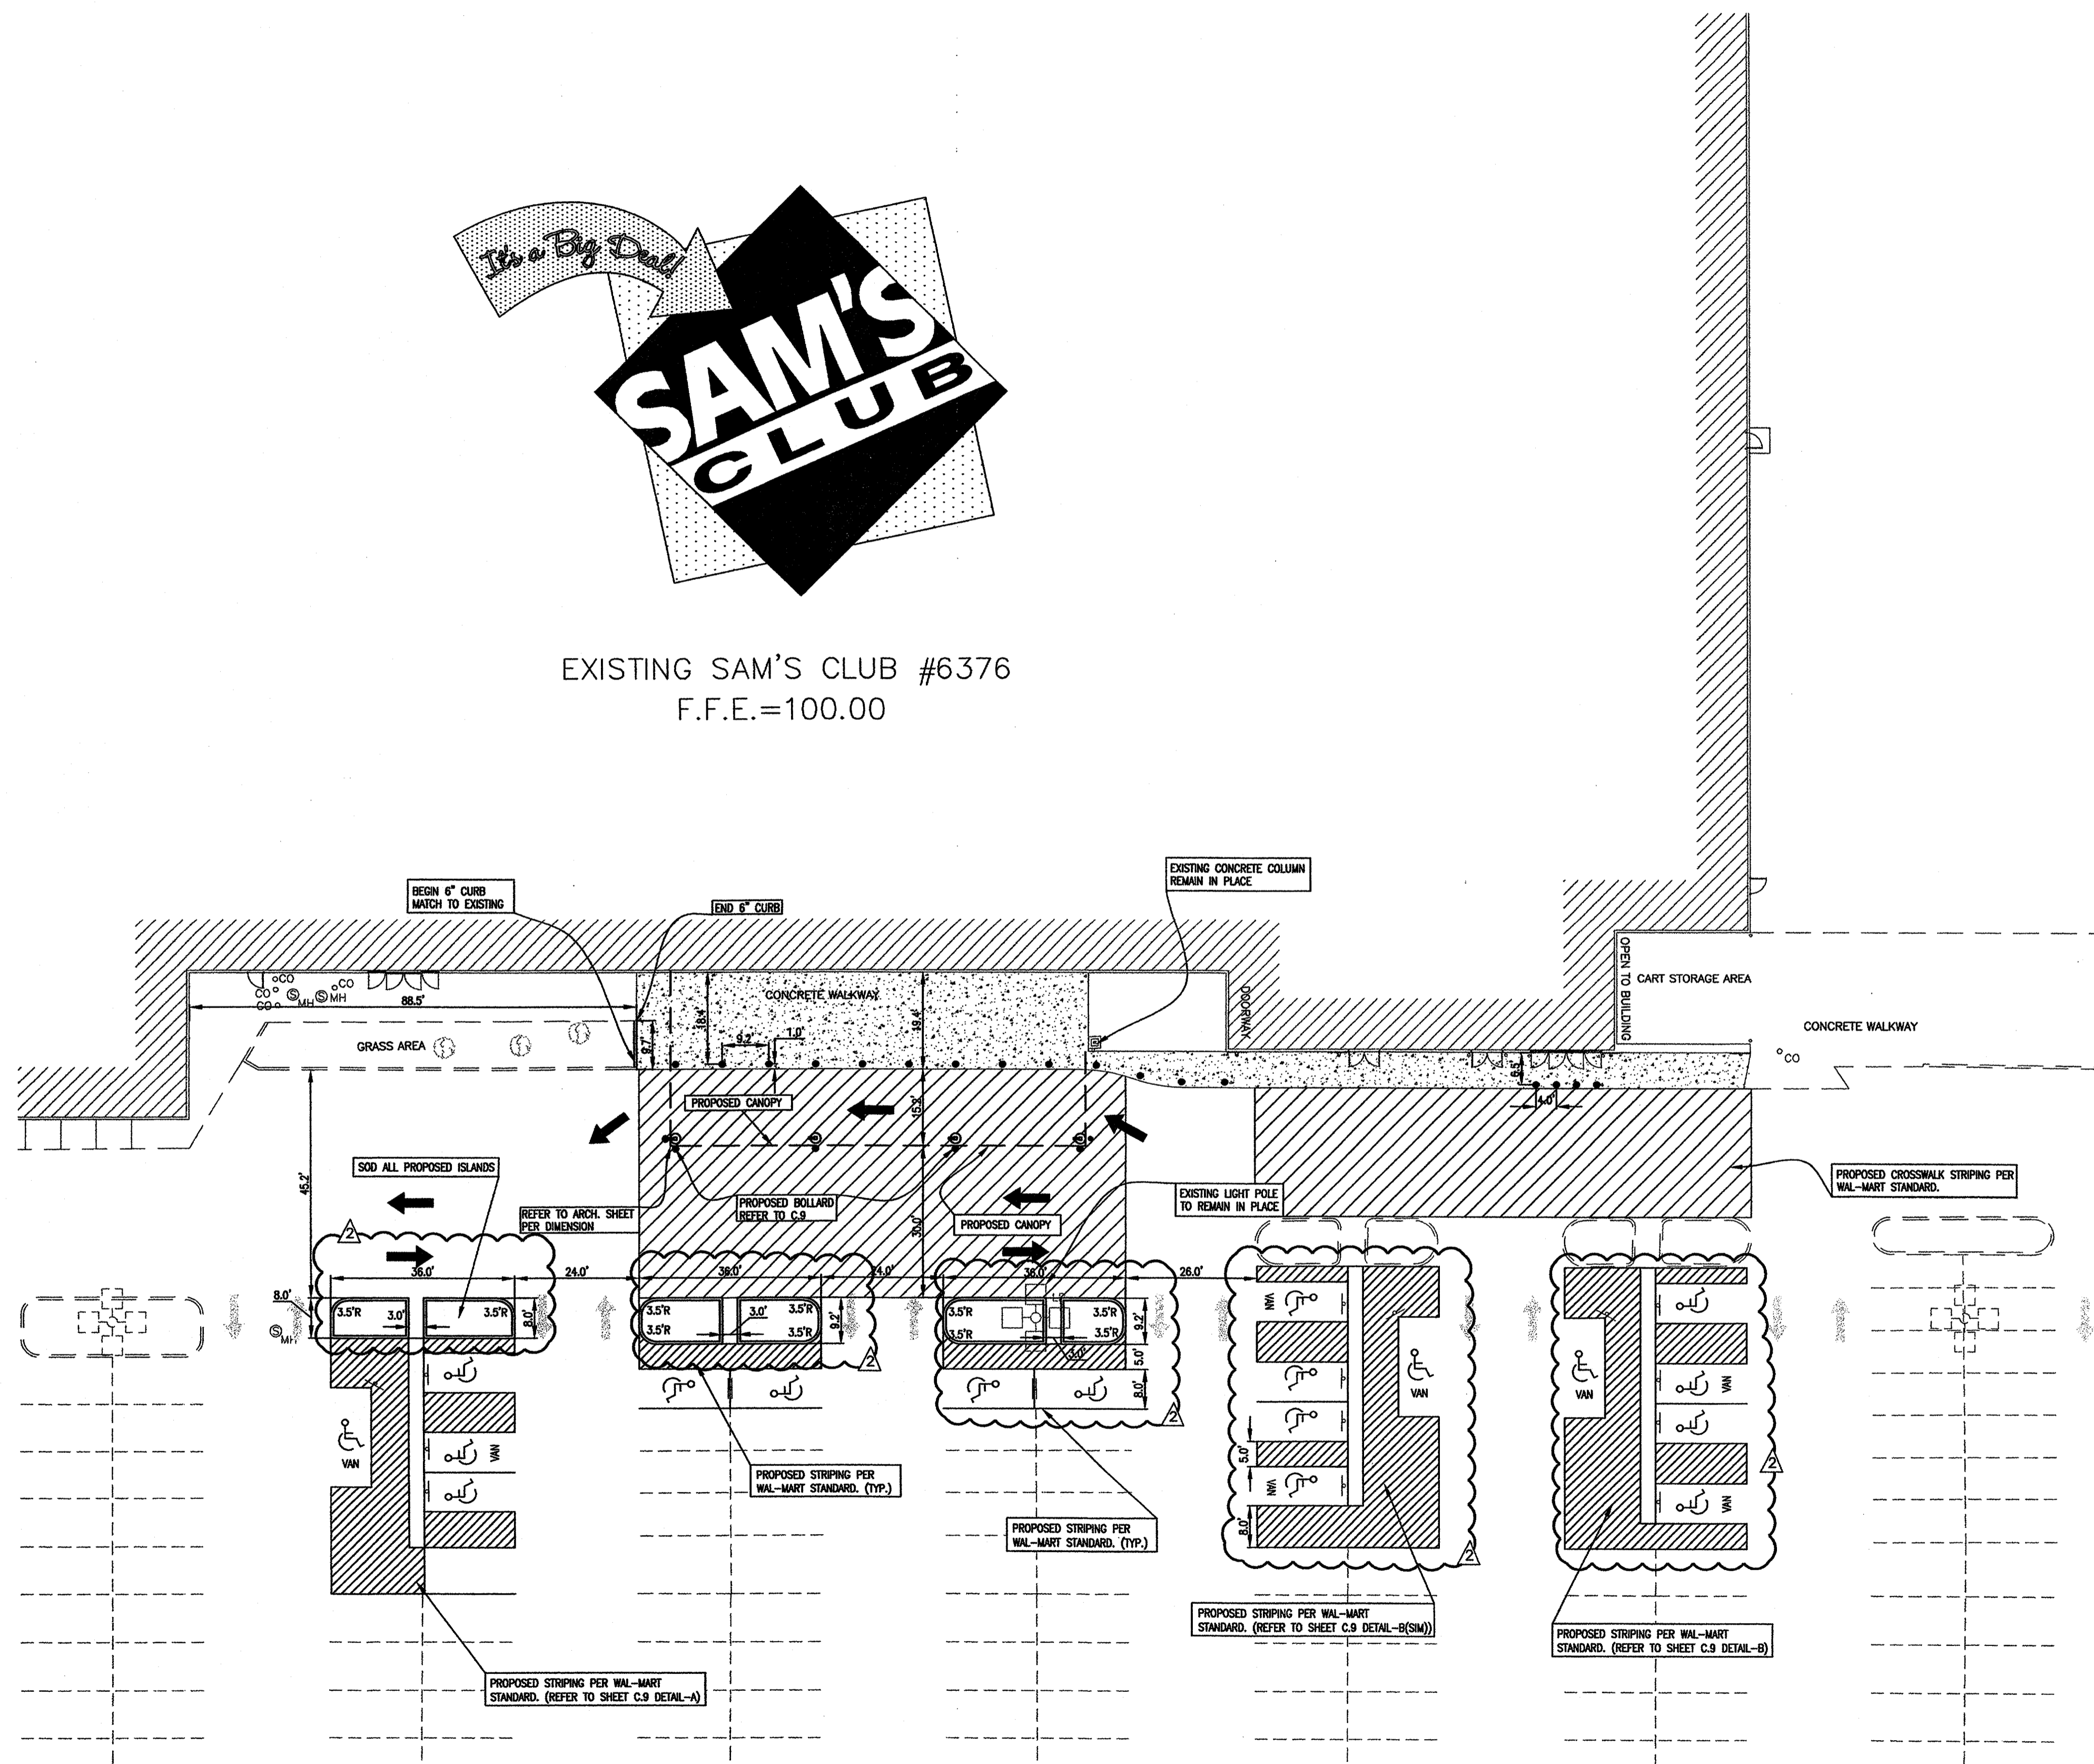

LEGEND

	PROP. CONC. SIDEWALK
	PROP. HC. SIGNS
	PROP. BOLLARD GUARD

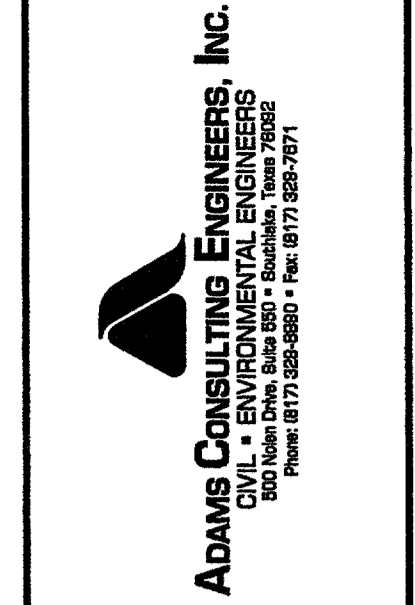


STIPULATION FOR REUSE
 THIS DRAWING WAS PREPARED FOR THE CLIENT'S USE ONLY. IT IS NOT TO BE REPRODUCED, COPIED, OR TRANSMITTED IN ANY FORM OR BY ANY MEANS, ELECTRONIC OR MECHANICAL, INCLUDING PHOTOCOPYING, RECORDING, OR BY ANY INFORMATION STORAGE AND RETRIEVAL SYSTEM, WITHOUT THE WRITTEN PERMISSION OF THE ENGINEER. THE ENGINEER'S LIABILITY IS LIMITED TO THE PROFESSIONAL SERVICES PROVIDED BY THE ENGINEER. THE ENGINEER'S LIABILITY IS NOT EXTENDED TO ANY OTHER SERVICES OR TO ANY OTHER PARTIES. THE ENGINEER'S LIABILITY IS LIMITED TO THE PROFESSIONAL SERVICES PROVIDED BY THE ENGINEER. THE ENGINEER'S LIABILITY IS NOT EXTENDED TO ANY OTHER SERVICES OR TO ANY OTHER PARTIES.

REMODEL
ADDISON,
TEXAS
CLUB #6376
 JOB NUMBER: 2004-207

ISSUE BLOCK

1	OTP	10/18/04
2	ADA	11/08/04

CHECKED BY: BS
 DRAWN BY: CAI
 DOCUMENT DATE: 10/18/04

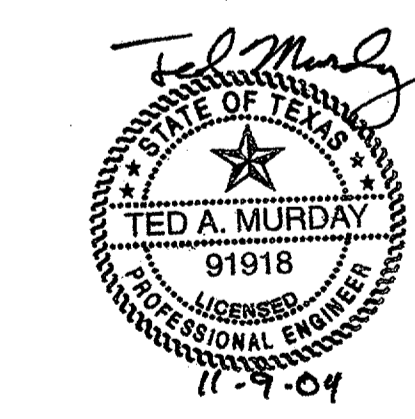

DIMENSIONAL CONTROL PLAN