


BY	DATE	REVISIONS
SH	1/10/02	
LWM	3/20/02	
		1ST SUBMITTAL TO ARCHITECT
		2-REVISIONS PER CITY











ADAMS CONSULTING ENGINEERS, INC.
 CIVIL - ENVIRONMENTAL ENGINEERS
 2445 E. Southchase Blvd., Suite 100 • Southchase, Texas 75082
 Phone: (817) 328-8880 • Fax: (817) 328-7871

RAYMOND HARRIS AND ASSOCIATES ARCHITECTS
 PROPOSED SAM'S CLUB BUILDING REMODEL
 4150 BELLINE ROAD
 ADDISON, TEXAS

TOWN OF ADDISON DETAILS

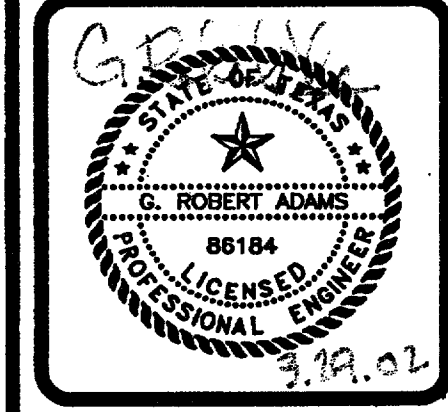

PROJECT MGR.	J.L.
PROJECT TECH.	J.S.H.
CHECKED BY	J.H.W.
JOB NO.	2001.189
SHEET NO.	6

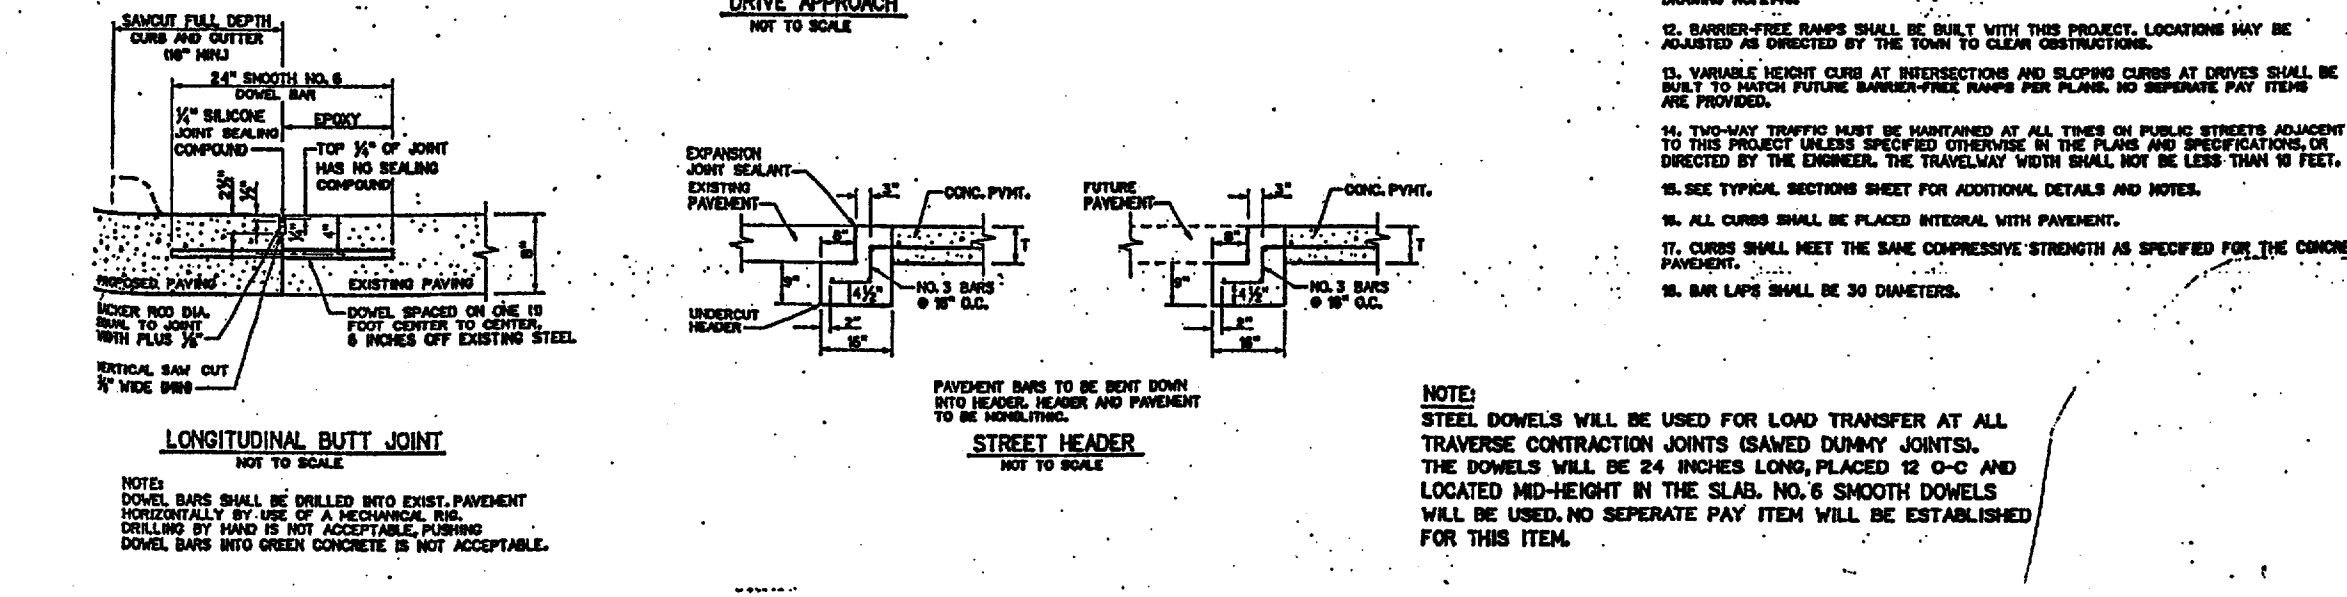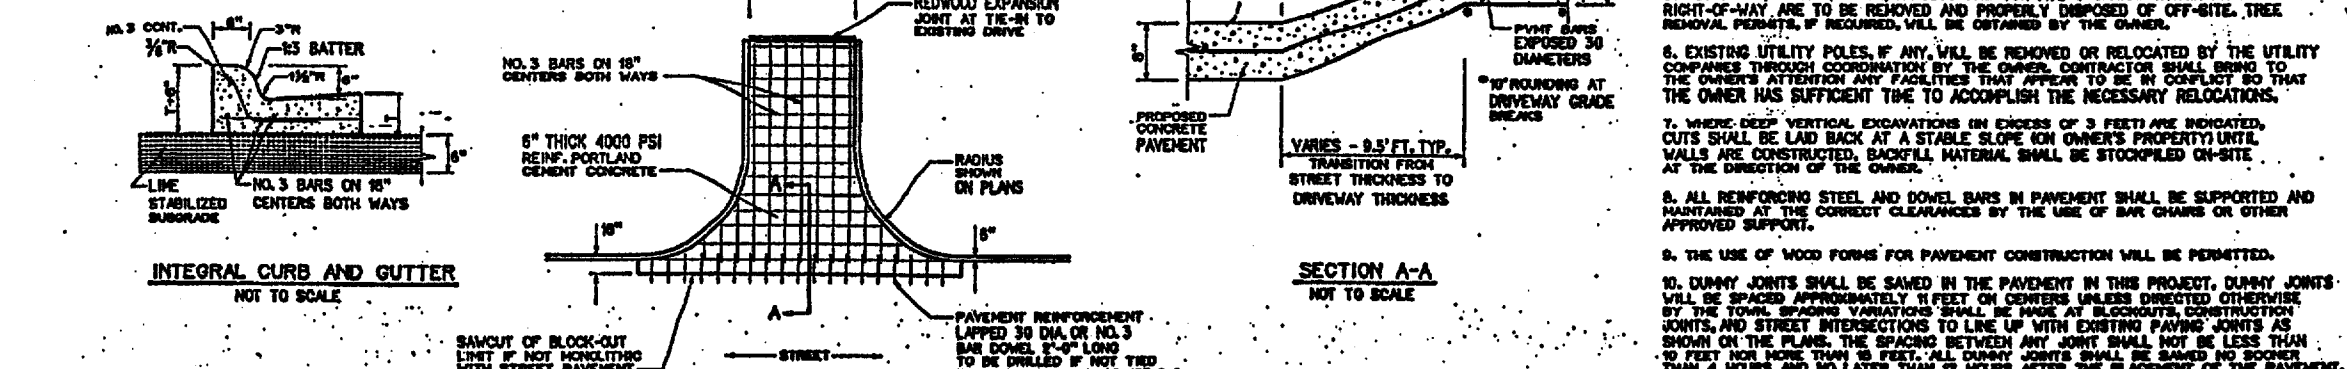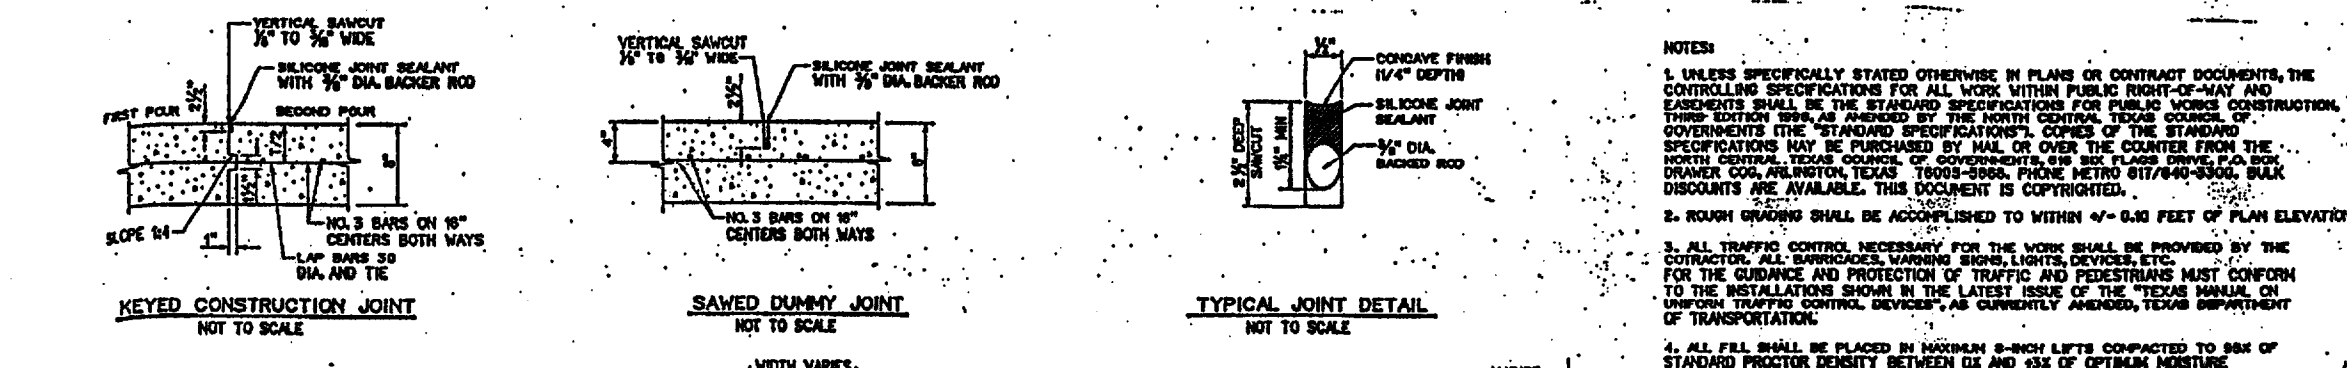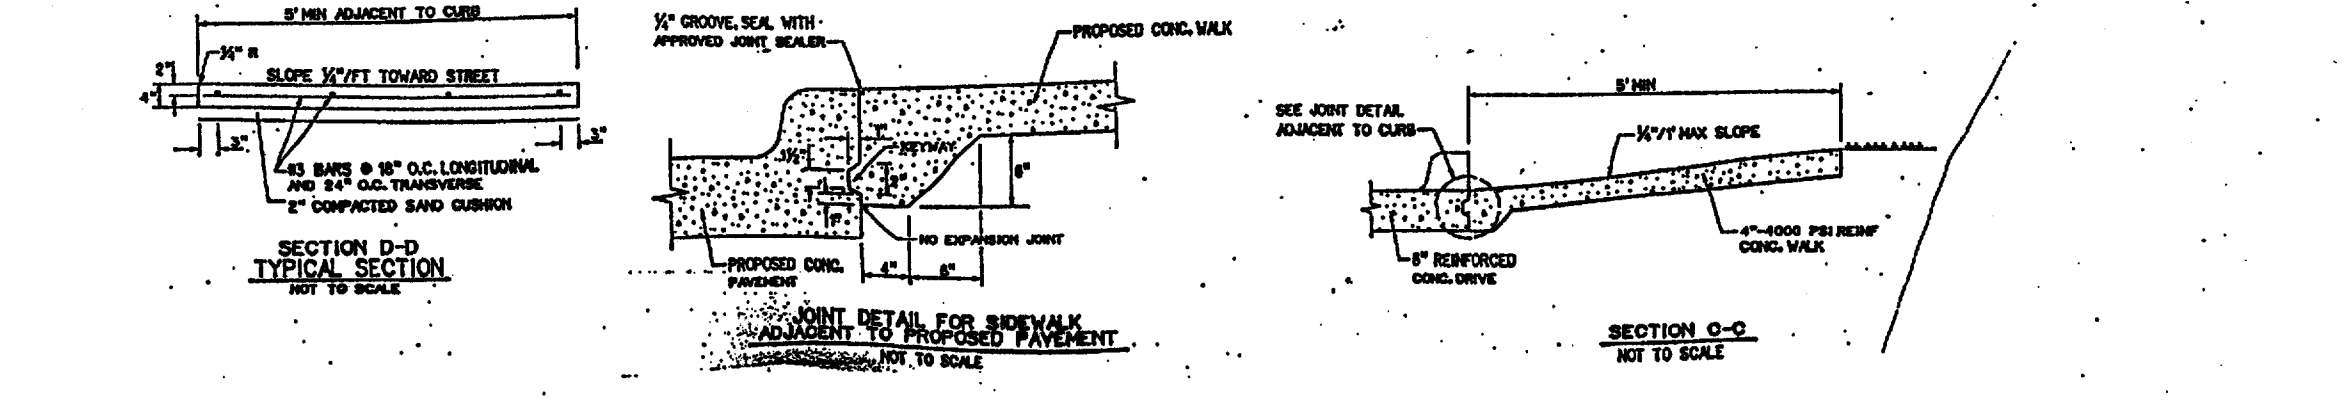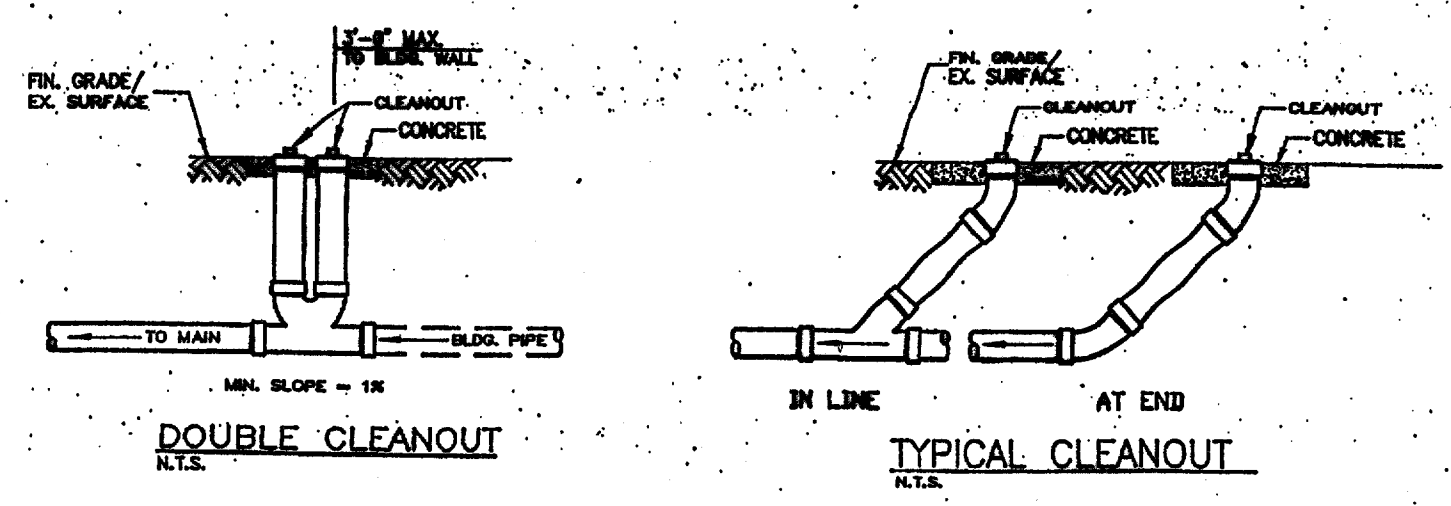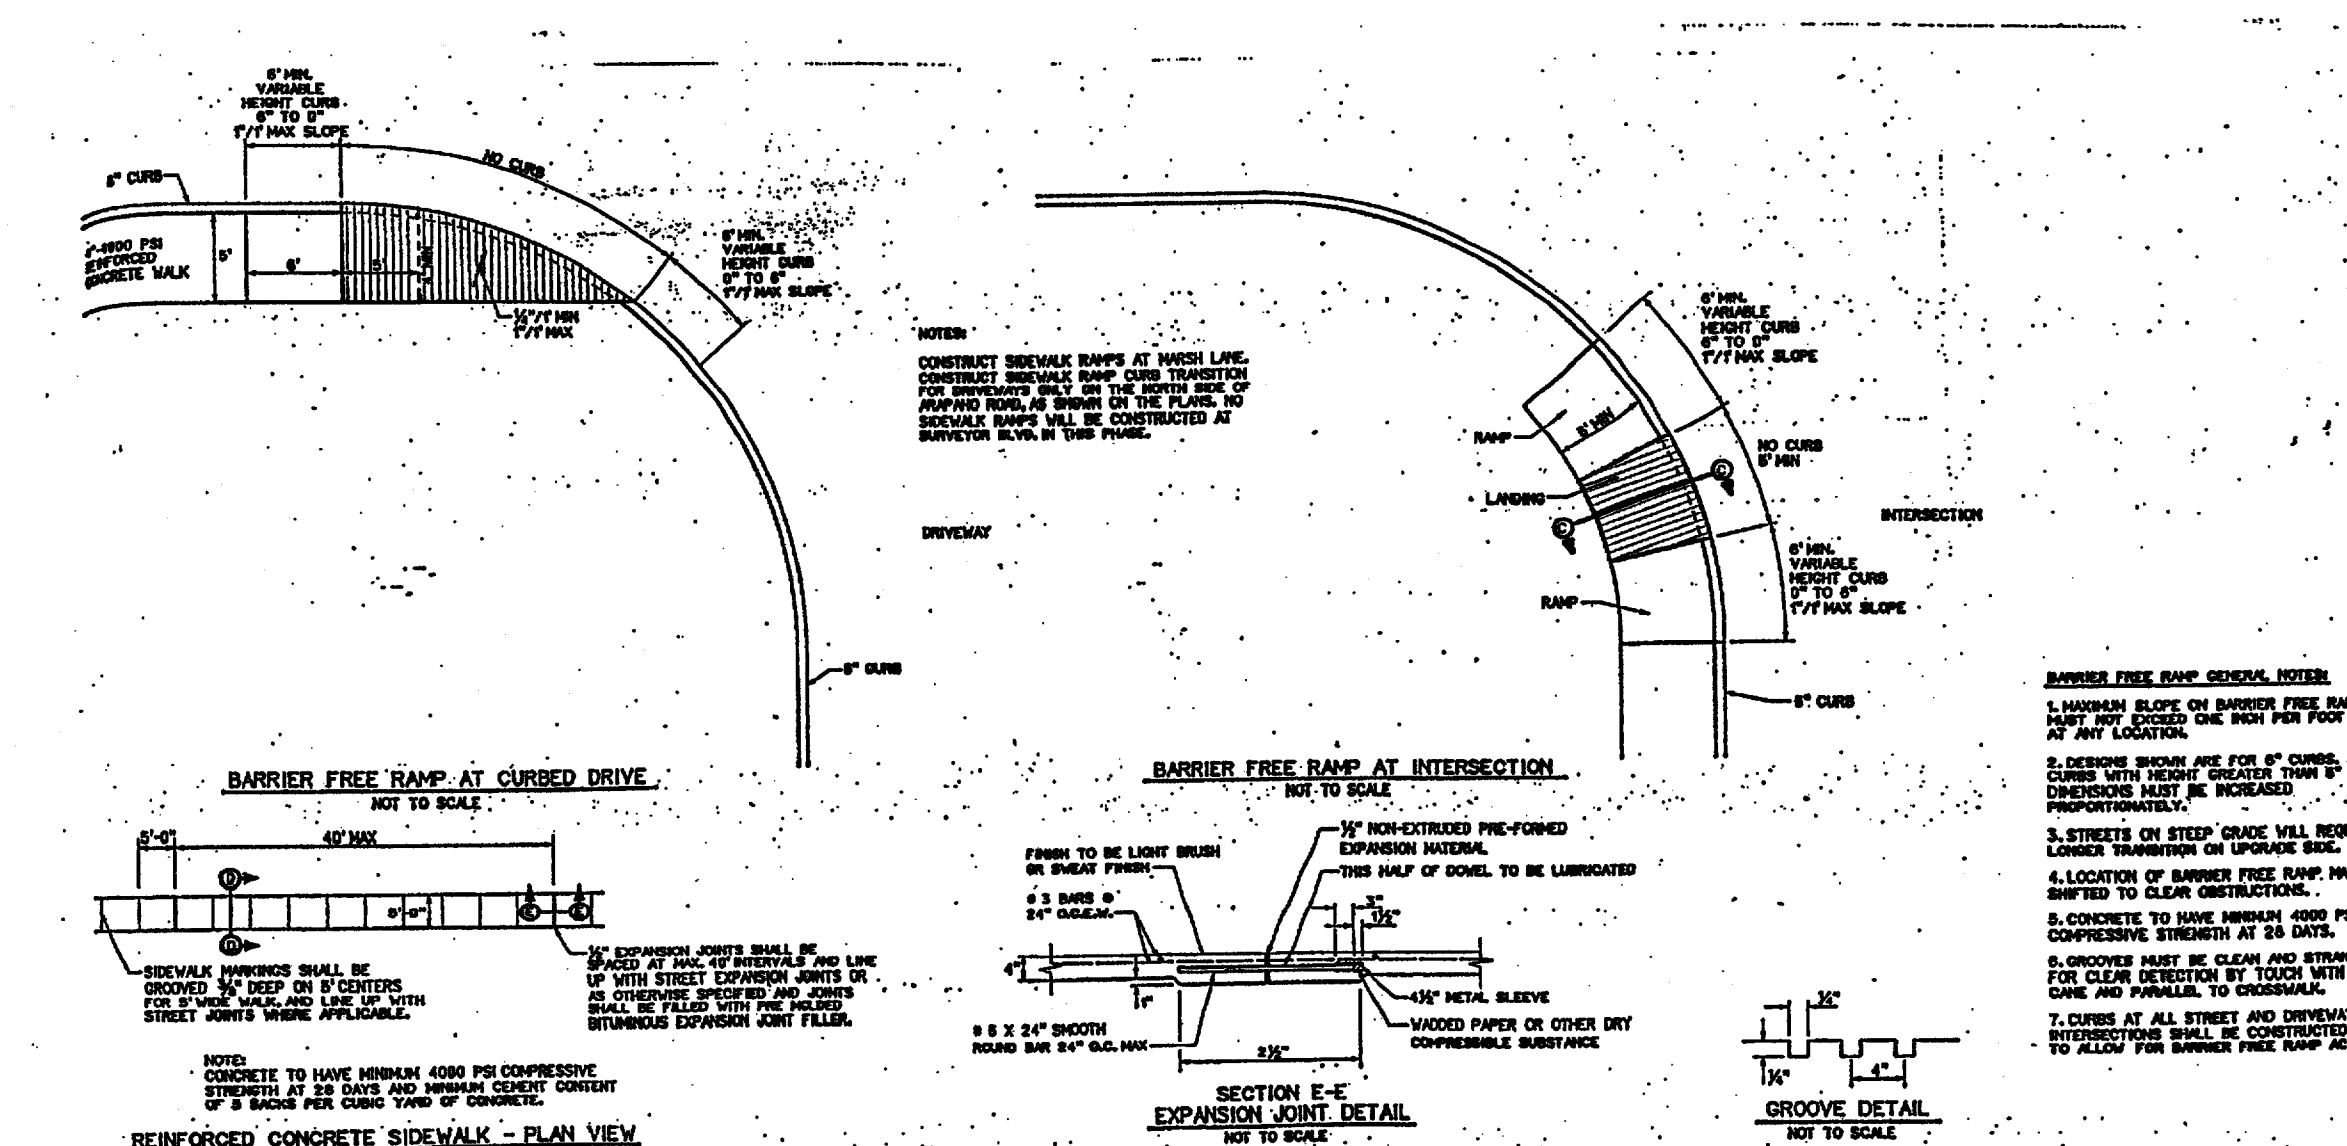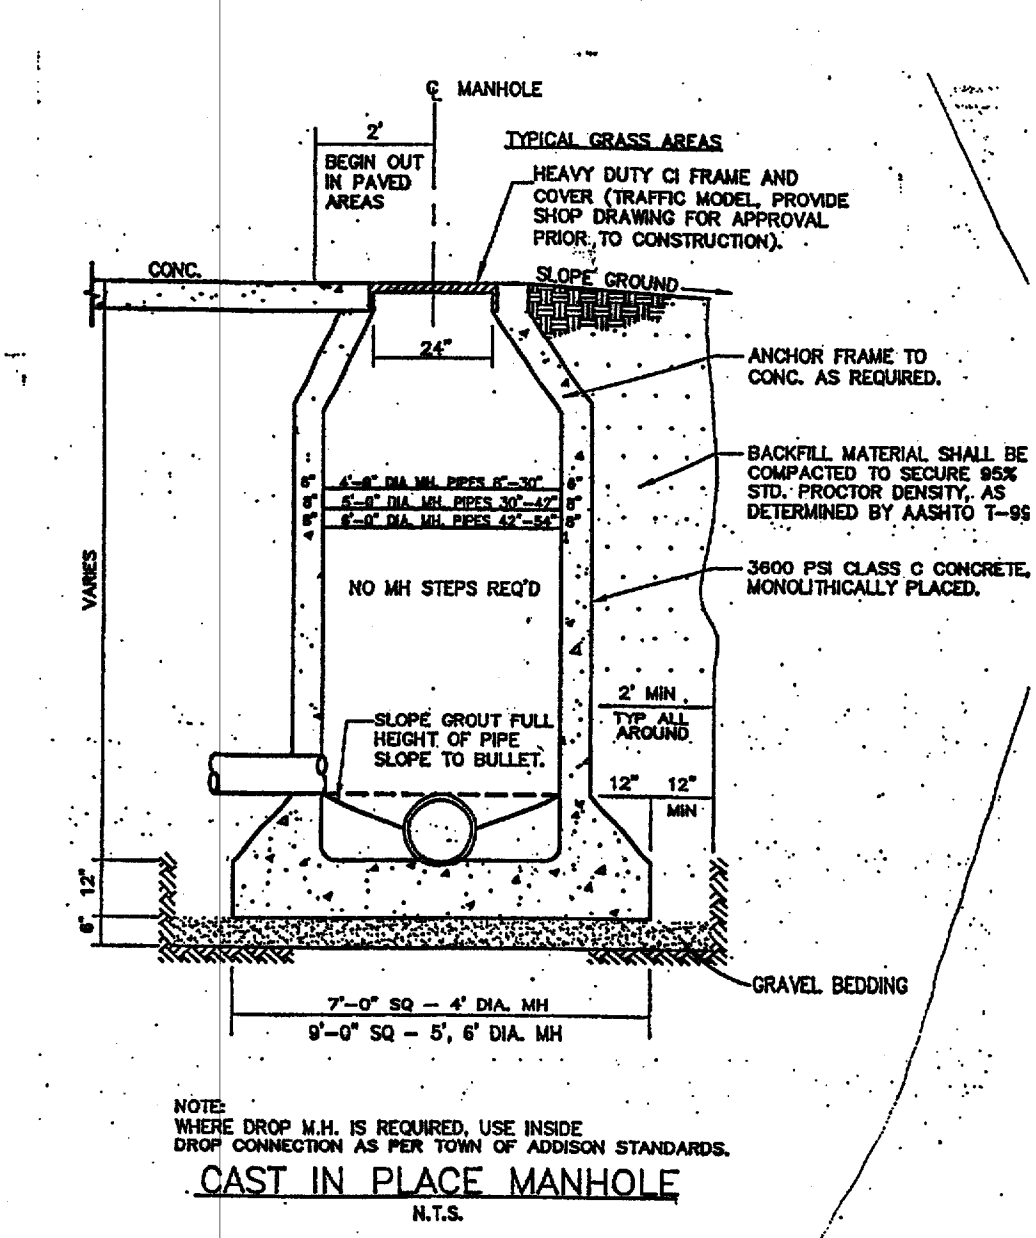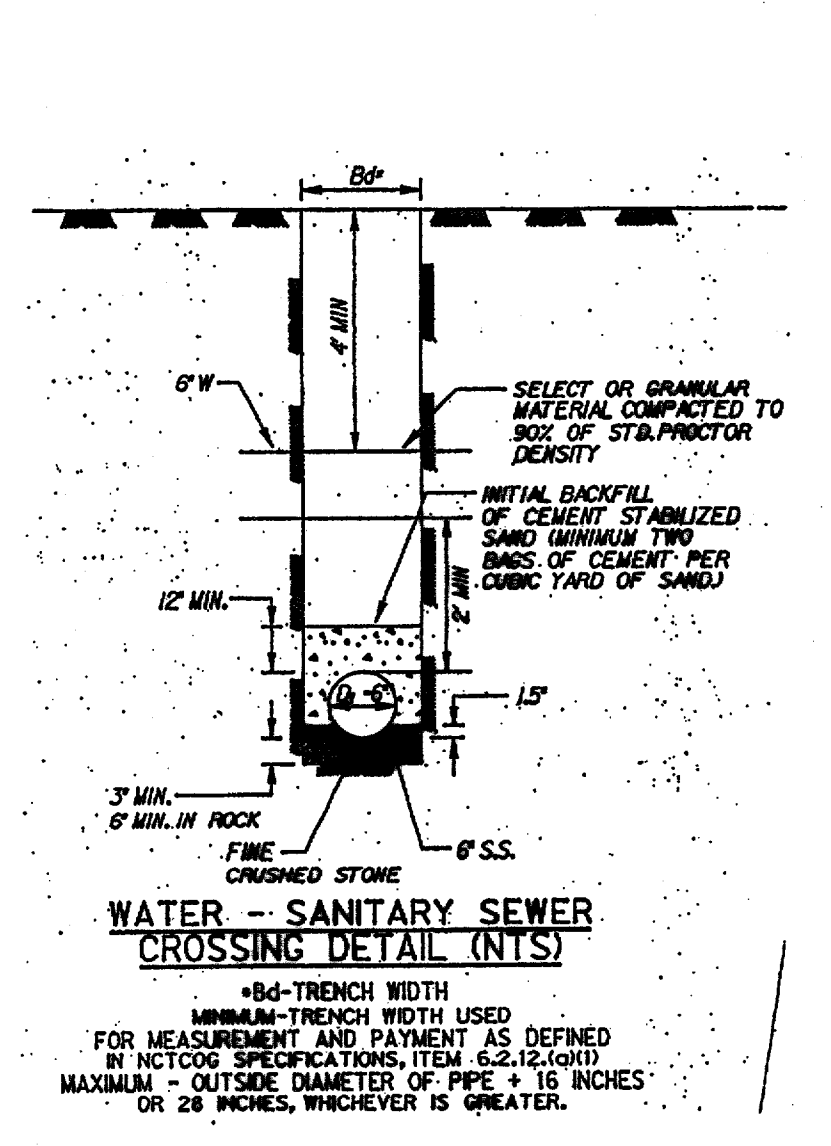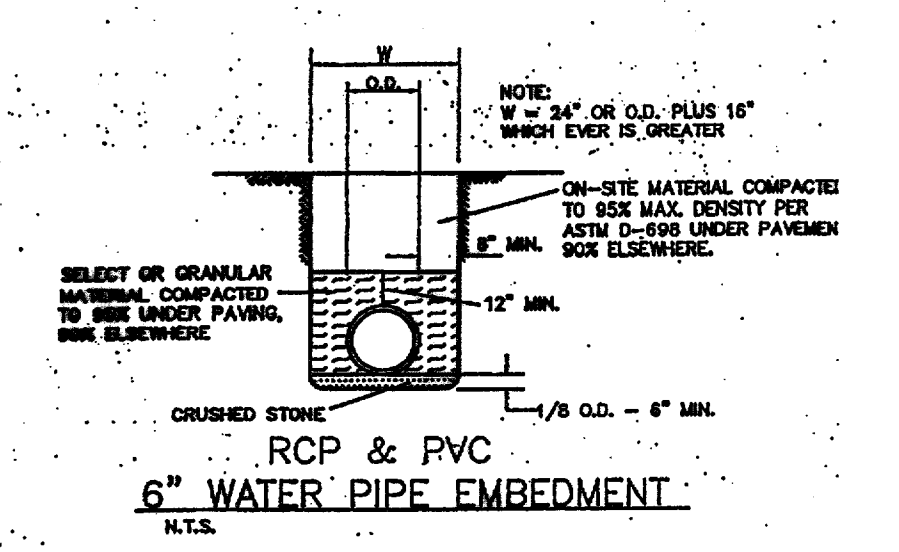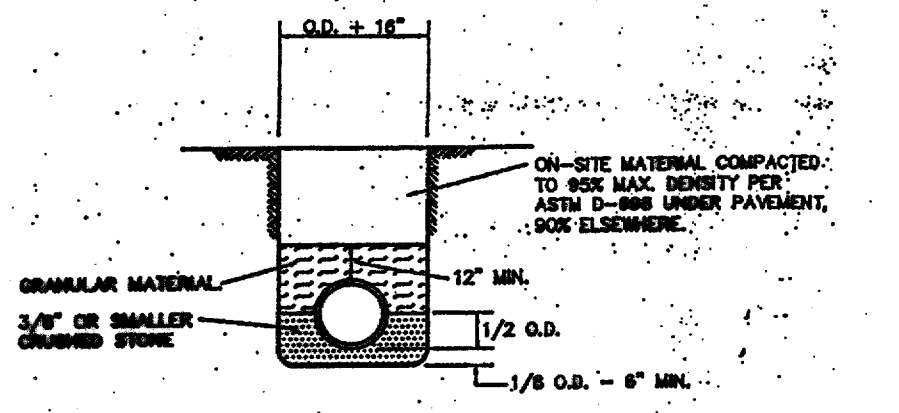

NOTES:

- REFER SPECIFICALLY STATED OVERLAP IN PLANS OR CONTRACT DOCUMENTS. THE CONTROLLING SPECIFICATIONS FOR ALL WORK WITHIN PUBLIC RIGHT-OF-WAY AND ON PUBLIC PROPERTY SHALL BE THE LATEST EDITIONS OF THE STANDARD SPECIFICATIONS FOR HIGHWAY CONSTRUCTION, LATEST EDITION, TEXAS DEPARTMENT OF TRANSPORTATION.
- ALL REVISIONS SHALL BE ACCORDING TO SECTION 401.02 OF THE PLAN ELEVATION.
- ALL REVISIONS SHALL BE MADE IN THE WORK SHALL BE PROVIDED BY THE OWNER FOR THE QUANTITY AND PROVISION OF TRAFFIC AND PEDESTRIAN MUST CONFORM TO THE REQUIREMENTS OF THE LATEST EDITIONS OF THE STANDARD SPECIFICATIONS FOR HIGHWAY CONSTRUCTION, LATEST EDITION, TEXAS DEPARTMENT OF TRANSPORTATION.
- ALL REVISIONS SHALL BE MADE IN THE WORK SHALL BE PROVIDED BY THE OWNER FOR THE QUANTITY AND PROVISION OF TRAFFIC AND PEDESTRIAN MUST CONFORM TO THE REQUIREMENTS OF THE LATEST EDITIONS OF THE STANDARD SPECIFICATIONS FOR HIGHWAY CONSTRUCTION, LATEST EDITION, TEXAS DEPARTMENT OF TRANSPORTATION.
RECORD DRAWINGS

The intent of the owner and engineer was to construct these facilities according to these plans as approved by the Town of Addison. The lines and grades were set on the ground for construction according to said plans. The Town of Addison inspected the construction. Neither the owner nor the engineer verified lines or grades after construction. We are not aware of any changes or revisions to these plans during construction except as noted.