

TIRE SALES ADDITION



SCALE: 1" = 20'-0"

REQUIREMENTS WITH

NEW TIRE SALES
ADDITION
2,340 S.F.

EXISTING CONTROLLER LOCATED
UPSTAIRS, IF OPEN STATIONS AVAILABLE.

EXEMPT
6-3" MAX MYRTLES

15' EAS

4' DIA. MANHOLE

EXISTING PARKING
POLE TO REMAIN

28

28

RECORD DRAWINGS:

THE INTENT OF THE OWNER AND ENGINEER WAS TO CONSTRUCT THESE FACILITIES ACCORDING TO THESE PLANS AS APPROVED BY THE CITY OF ADDISON. THE LINES AND GRADES WERE SET ON THE GROUND FOR CONSTRUCTION ACCORDING TO SAID PLANS. THE CITY OF ADDISON INSPECTED THE CONSTRUCTION. NEITHER THE OWNER NOR THE ENGINEER VERIFIED LINES OR GRADES AFTER CONSTRUCTION. WE ARE NOT AWARE OF ANY CHANGES OR REVISIONS TO THESE PLANS DURING CONSTRUCTION EXCEPT AS NOTED.

BY: *Michael Ramsey* DATE: 8/16/02
MICHAEL RAMSEY, R.L.A.

NOTE:


RUN WIRES BACK TO EXISTING CONTROLLER, IT IS POSSIBLE THAT WIRES FOR THE REMAINING OPEN STATIONS HAVE BEEN RUN FROM THE EXISTING CONTROLLERS TO AN EXTERIOR AREA. UTILIZE WIRES IF AVAILABLE

ALTERNATE #1

IF WIRES CANNOT BE FOUND AND NEW WIRES CANNOT BE RUN TO THE EXISTING CONTROLLER ADD CONTROLLER FOR THE SIX NEW ZONES.

LEIT 2000 W/ PEDESTAL AMBIENT LIGHT IRRIGATION CONTROLLER. THIS CONTROLLER CANNOT OPERATE AT THE SAME TIME AS THE EXISTING CONTROLLERS.

74

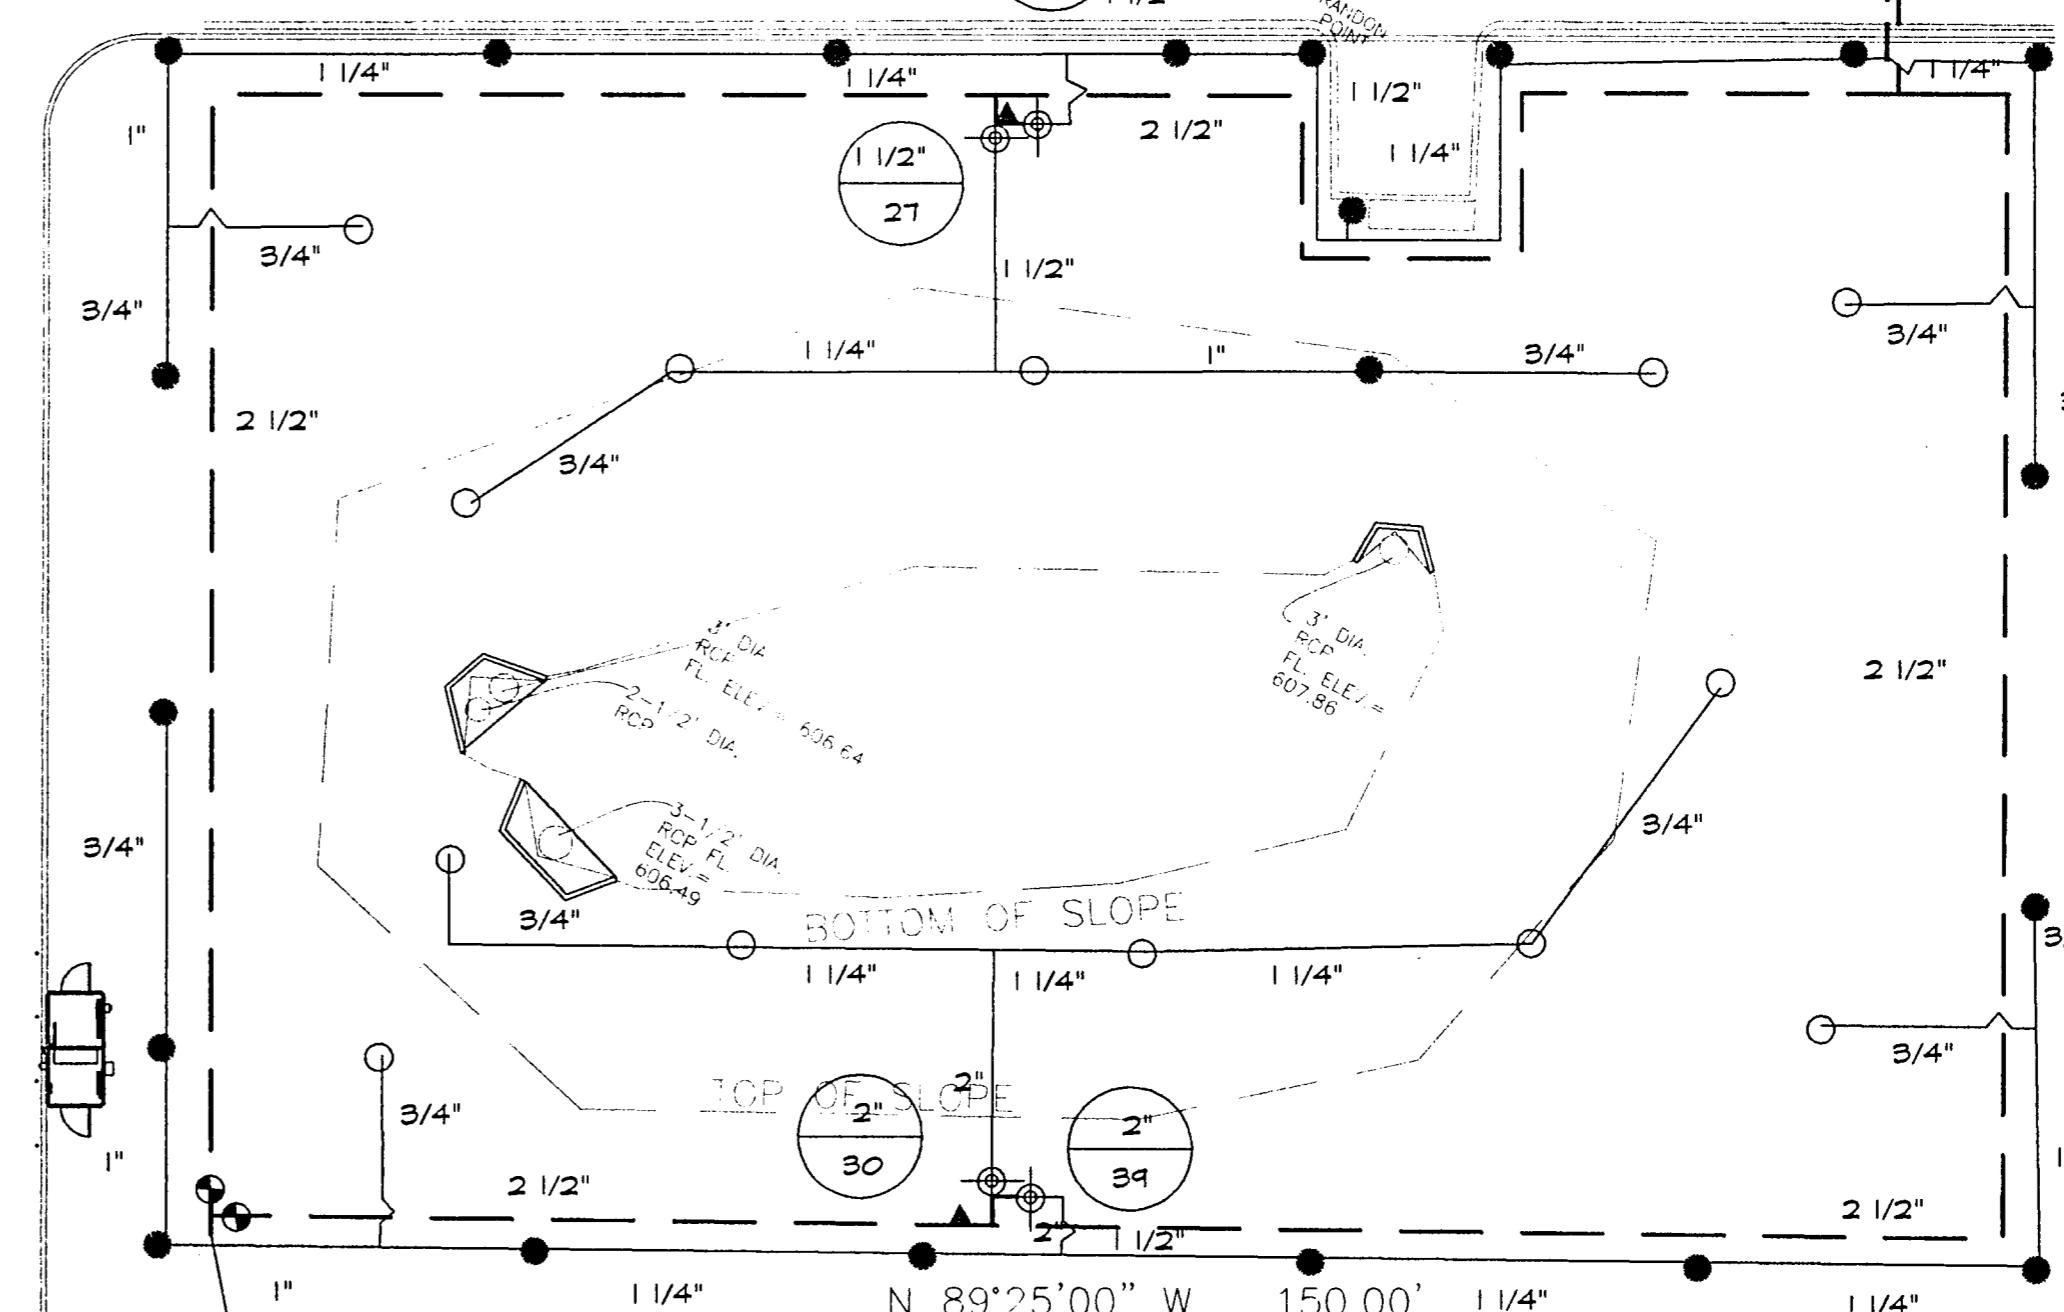

DETENTION PONDS




SCALE: 1" = 20'-0"
JAN 3, 2002

REVISIONS	DATE	BY

IRRIGATION SPECIALIST
JOHN WINGFIELD - (972) 601-3816

RAYMOND HARRIS AND ASSOCIATES ARCHITECTS
PROPOSED SAM'S CLUB BUILDING REMODEL
BELTLINE ROAD
ADDISON, TEXAS

IRRIGATION PLAN

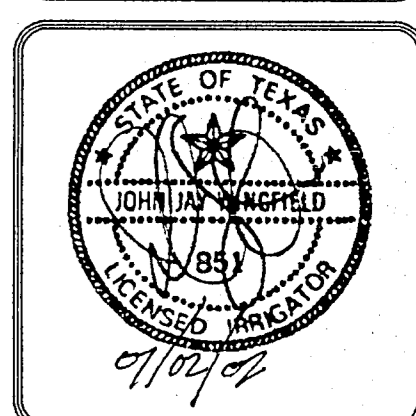

PROJECT MGR.
JW

PROJECT TECH.
JW

CHECKED BY
JW

JOB NO.

SHEET NO.
L4

OF 5