

ARCHITECTS
 VAN LOM /
 EDWARDS
 A.I.A., P.C.
 34 N.W. First Avenue, Suite 309
 Portland, Oregon 97209 503/226-0690

S.E. CORNER OF BELTLINE ROAD
 AND MIDWAY ROAD
 ADDISON, TEXAS




Job No. 1498-01
 Date: 7/17/92
 Rev: 7/28/92
 10/05/92
 10/21/92

HORIZONTAL
 CONTROL
 PLAN

Sheet No.


C11

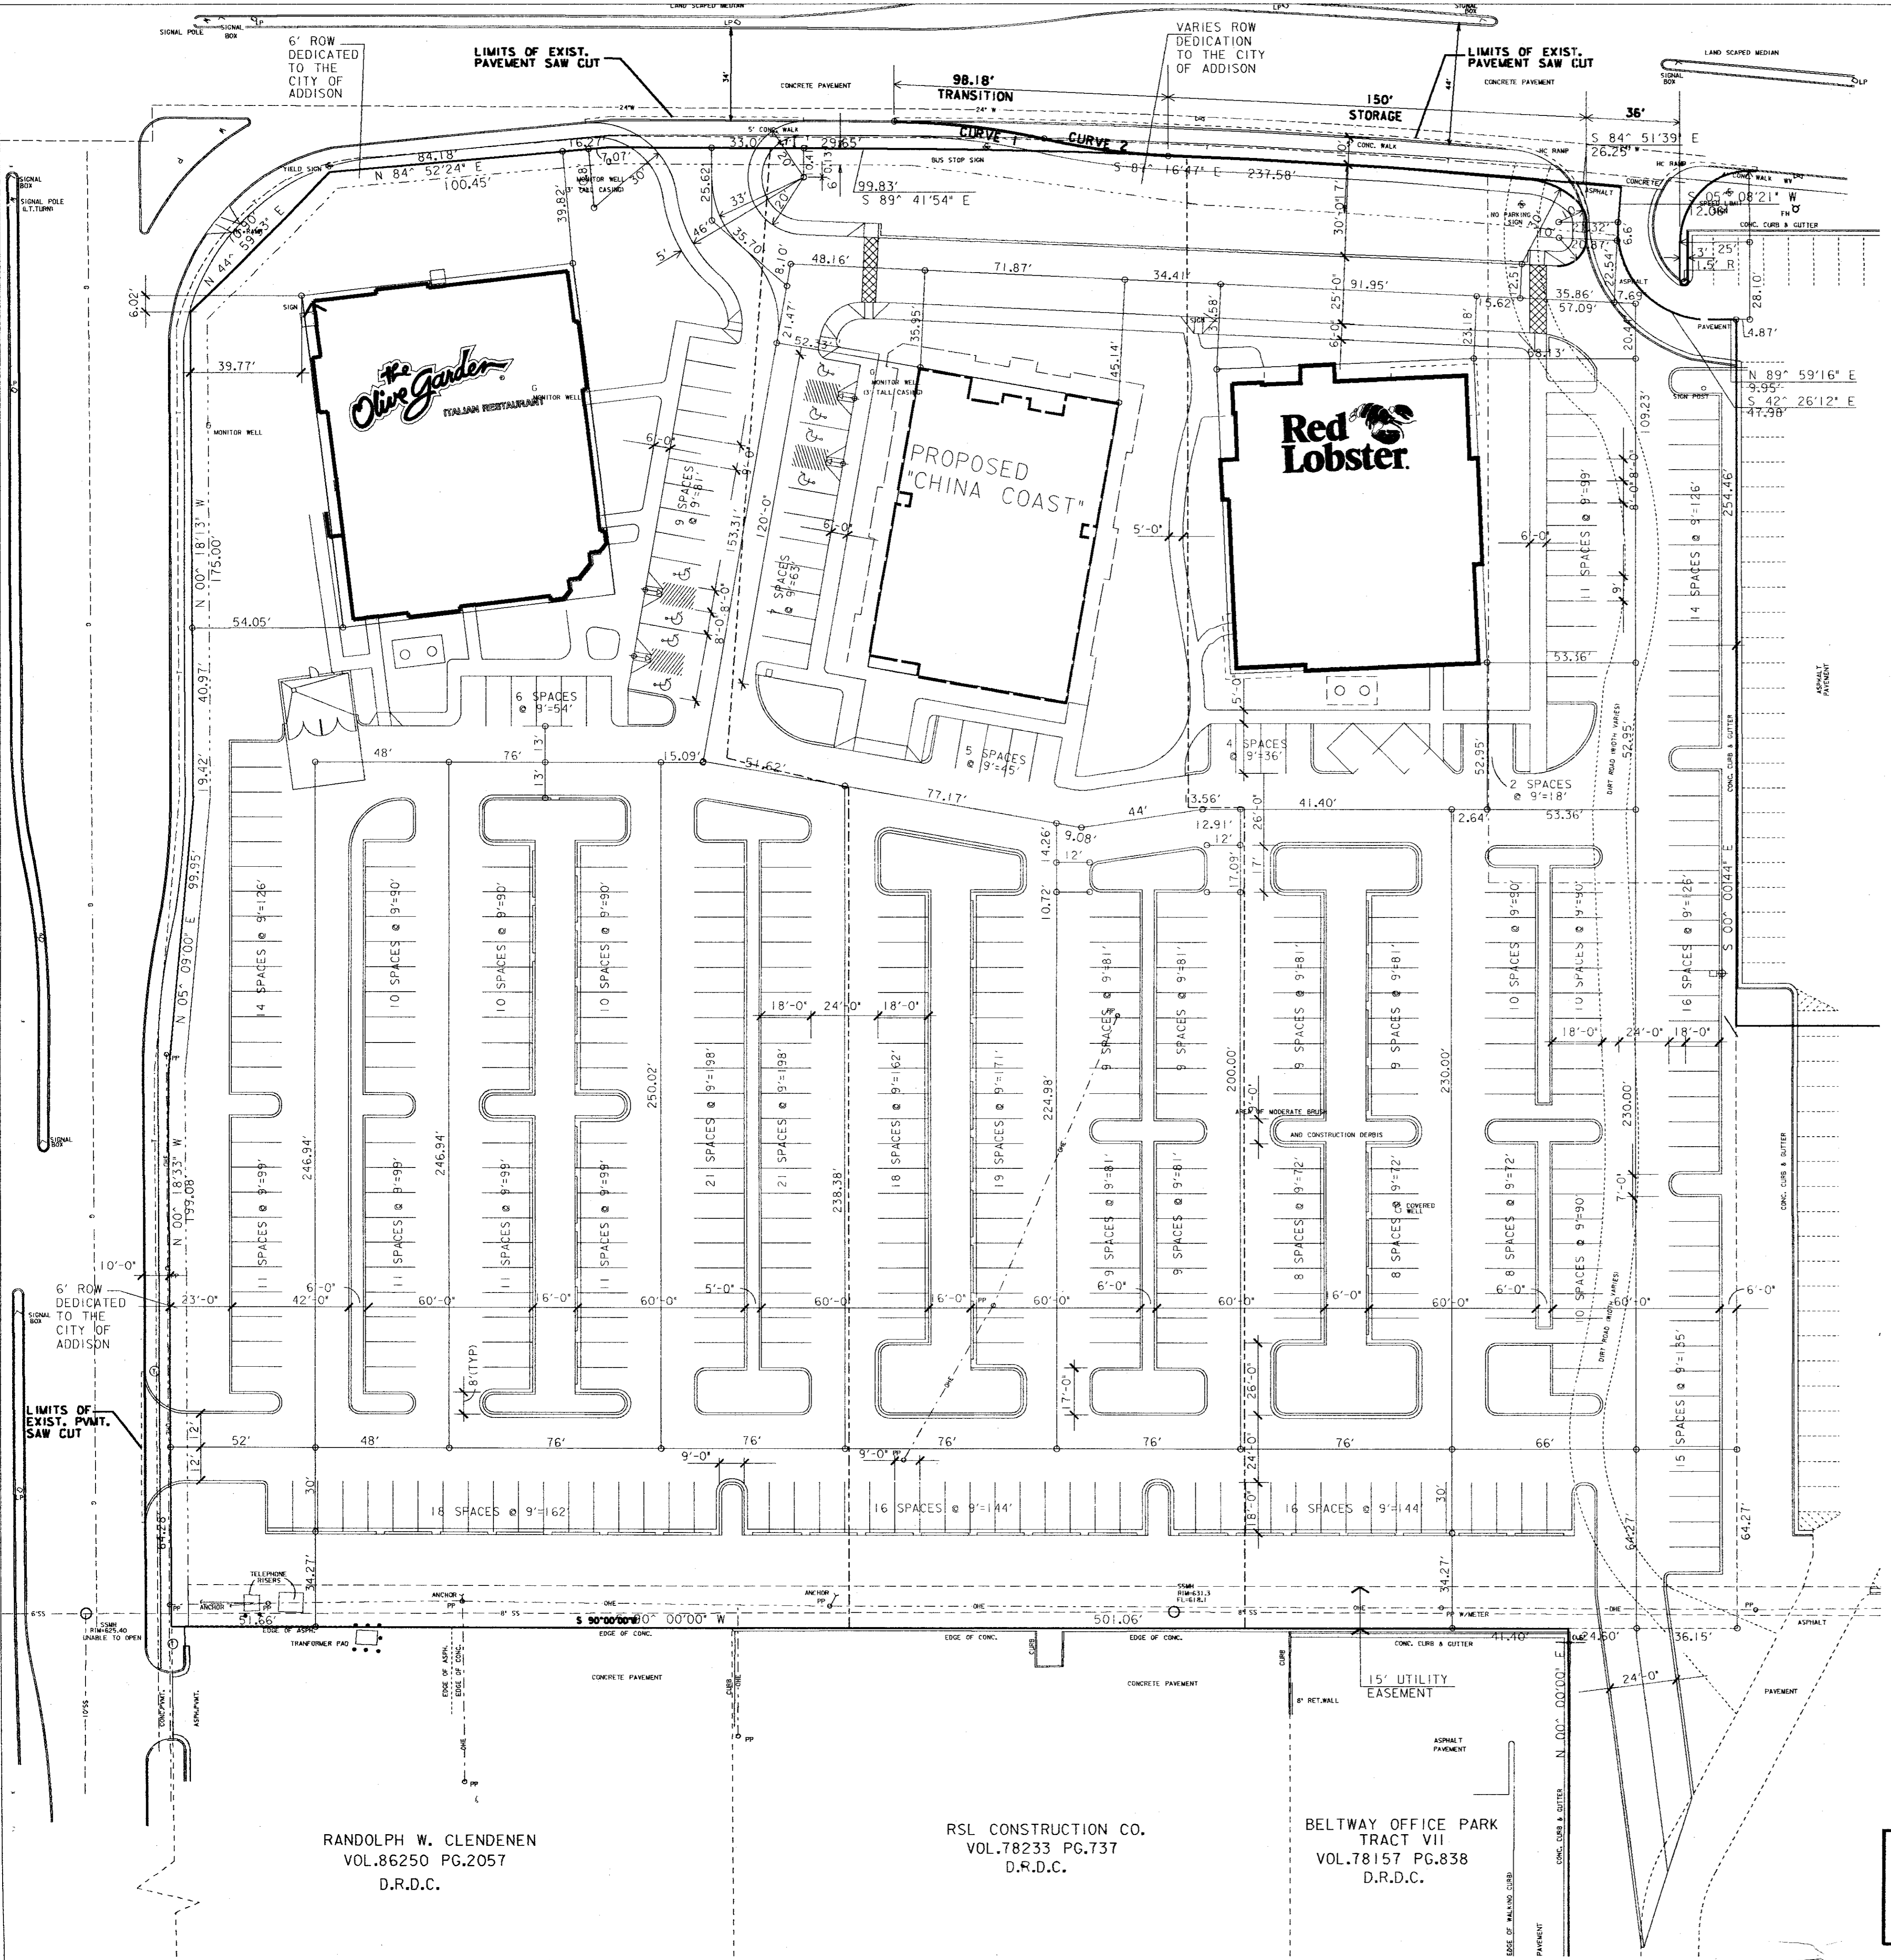


CURVE NO. 1
 R • 250.00'
 Δ • 12°24'13"
 L • 54.12'
 T • 27.17'

CURVE NO. 2
 R • 250.00'
 Δ • 10°18'39"
 L • 44.99'
 T • 22.56'

The construction of this Plan was completed according to the design.

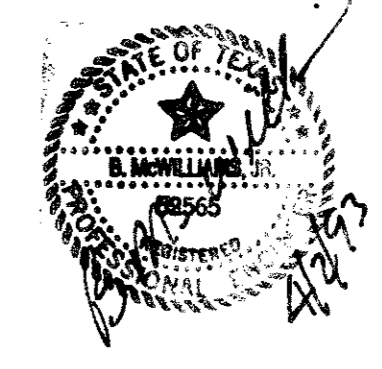

"AS BUILT"

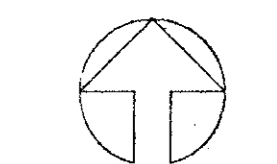

1" = 30'-0"

HUITT - ZOLLARS

3131 MCKINNEY AVENUE/SUITE 600
 DALLAS, TEXAS/214-871-3311

NOTE :
 ALL DIMENSIONS
 TO FACE OF CURB

RANDOLPH W. CLENDENEN
 VOL.86250 PG.2057
 D.R.D.C.

RSL CONSTRUCTION CO.
 VOL.78233 PG.737
 D.R.D.C.

BELTWAY OFFICE PARK
 TRACT VII
 VOL.78157 PG.858
 D.R.D.C.