

ARCHITECTS  
 VAN LOM /  
 EDWARDS  
 A.I.A., P.C.

34 N.W. First Avenue, Suite 309  
 Portland, Oregon 97209 503/226-0590

S.E. CORNER OF BELTLINE ROAD  
 AND MIDWAY ROAD  
 ITALIAN RESTAURANT  
 ADDISON, TEXAS



Job No. 1498-01

Date: 7/17/92  
 Rev: 7/28/92  
 10/05/92  
 10/21/92  
 03/09/93  
 03/17/93

DRAINAGE  
 AREA MAP

Sheet No.



C6

DETENTION SUMMARY			
POND	STORAGE (CU FT)	DEPTH (FT)	RELEASE RATE (CFS)
A	3,240	3'	7.5
B	3,840	3'	4.0
C	4,400	3'	5.0
D	19,335	3'	7.1
TOTALS	30,815		23.6

TOTAL STORAGE REQUIRED : 30,815 CU FT  
 TOTAL STORAGE PROVIDED : 32,780 CU FT

INLET DESIGN

AC  
 0  
 0  
 100 CFS

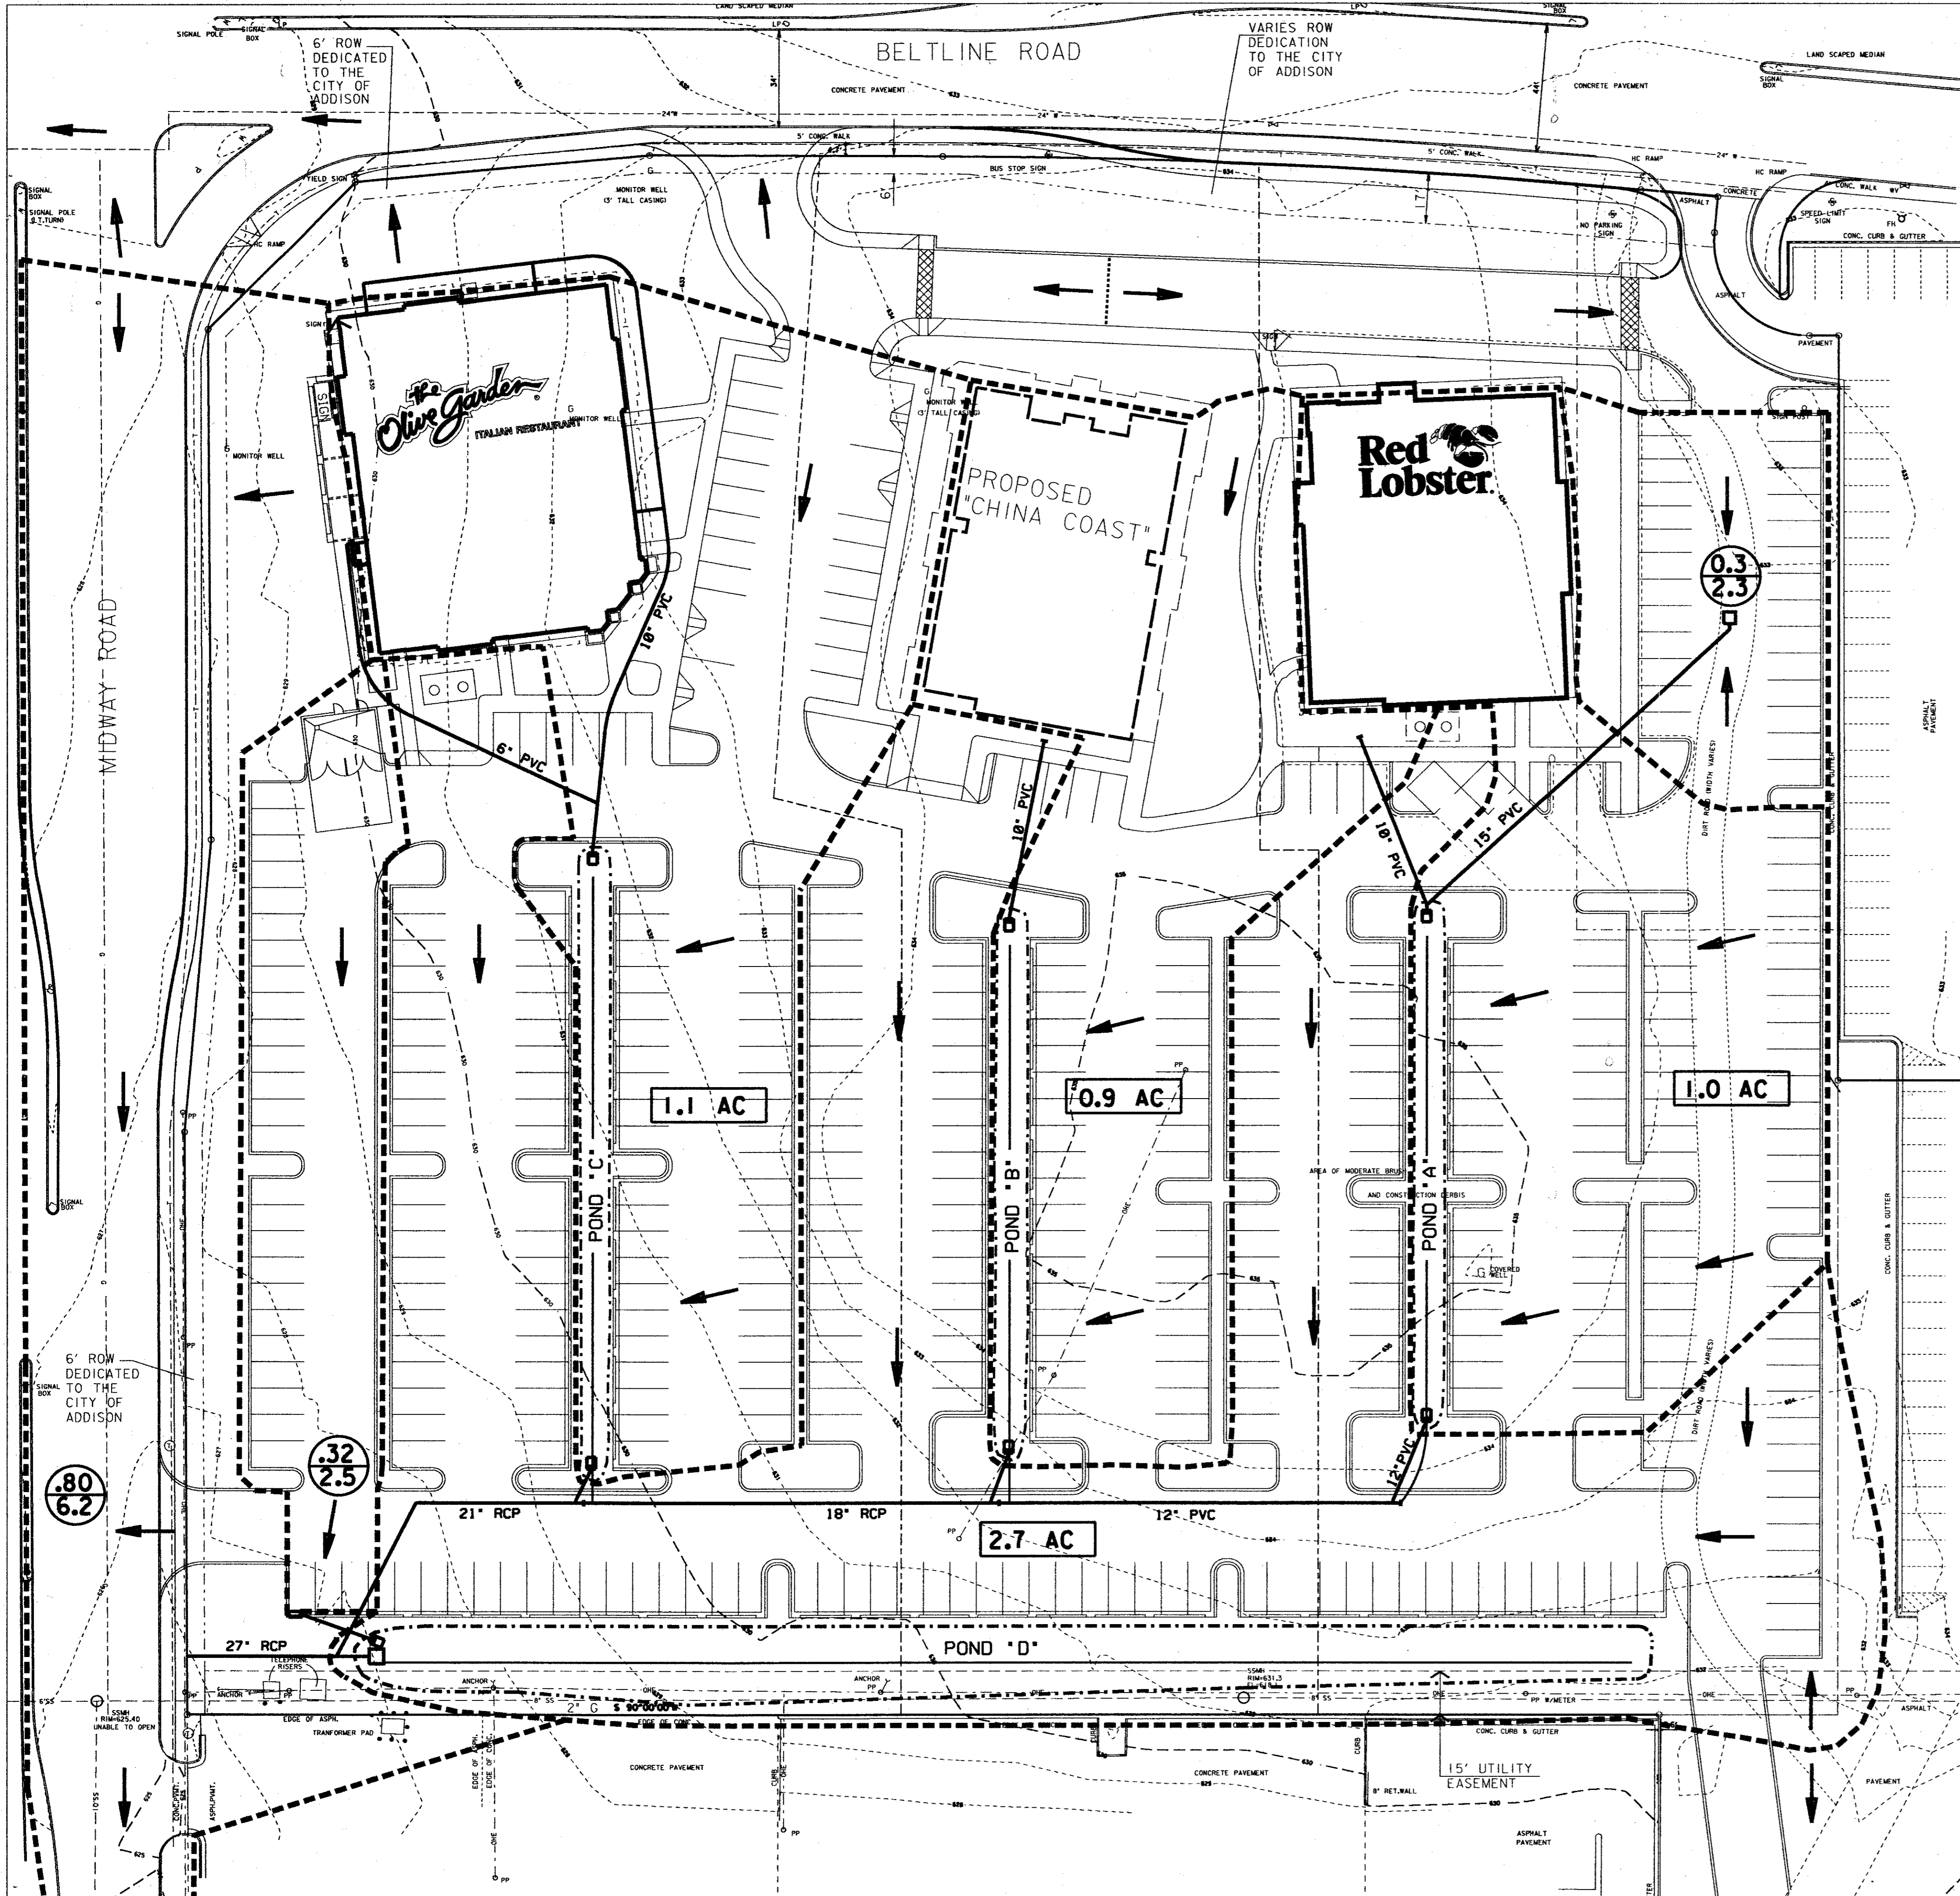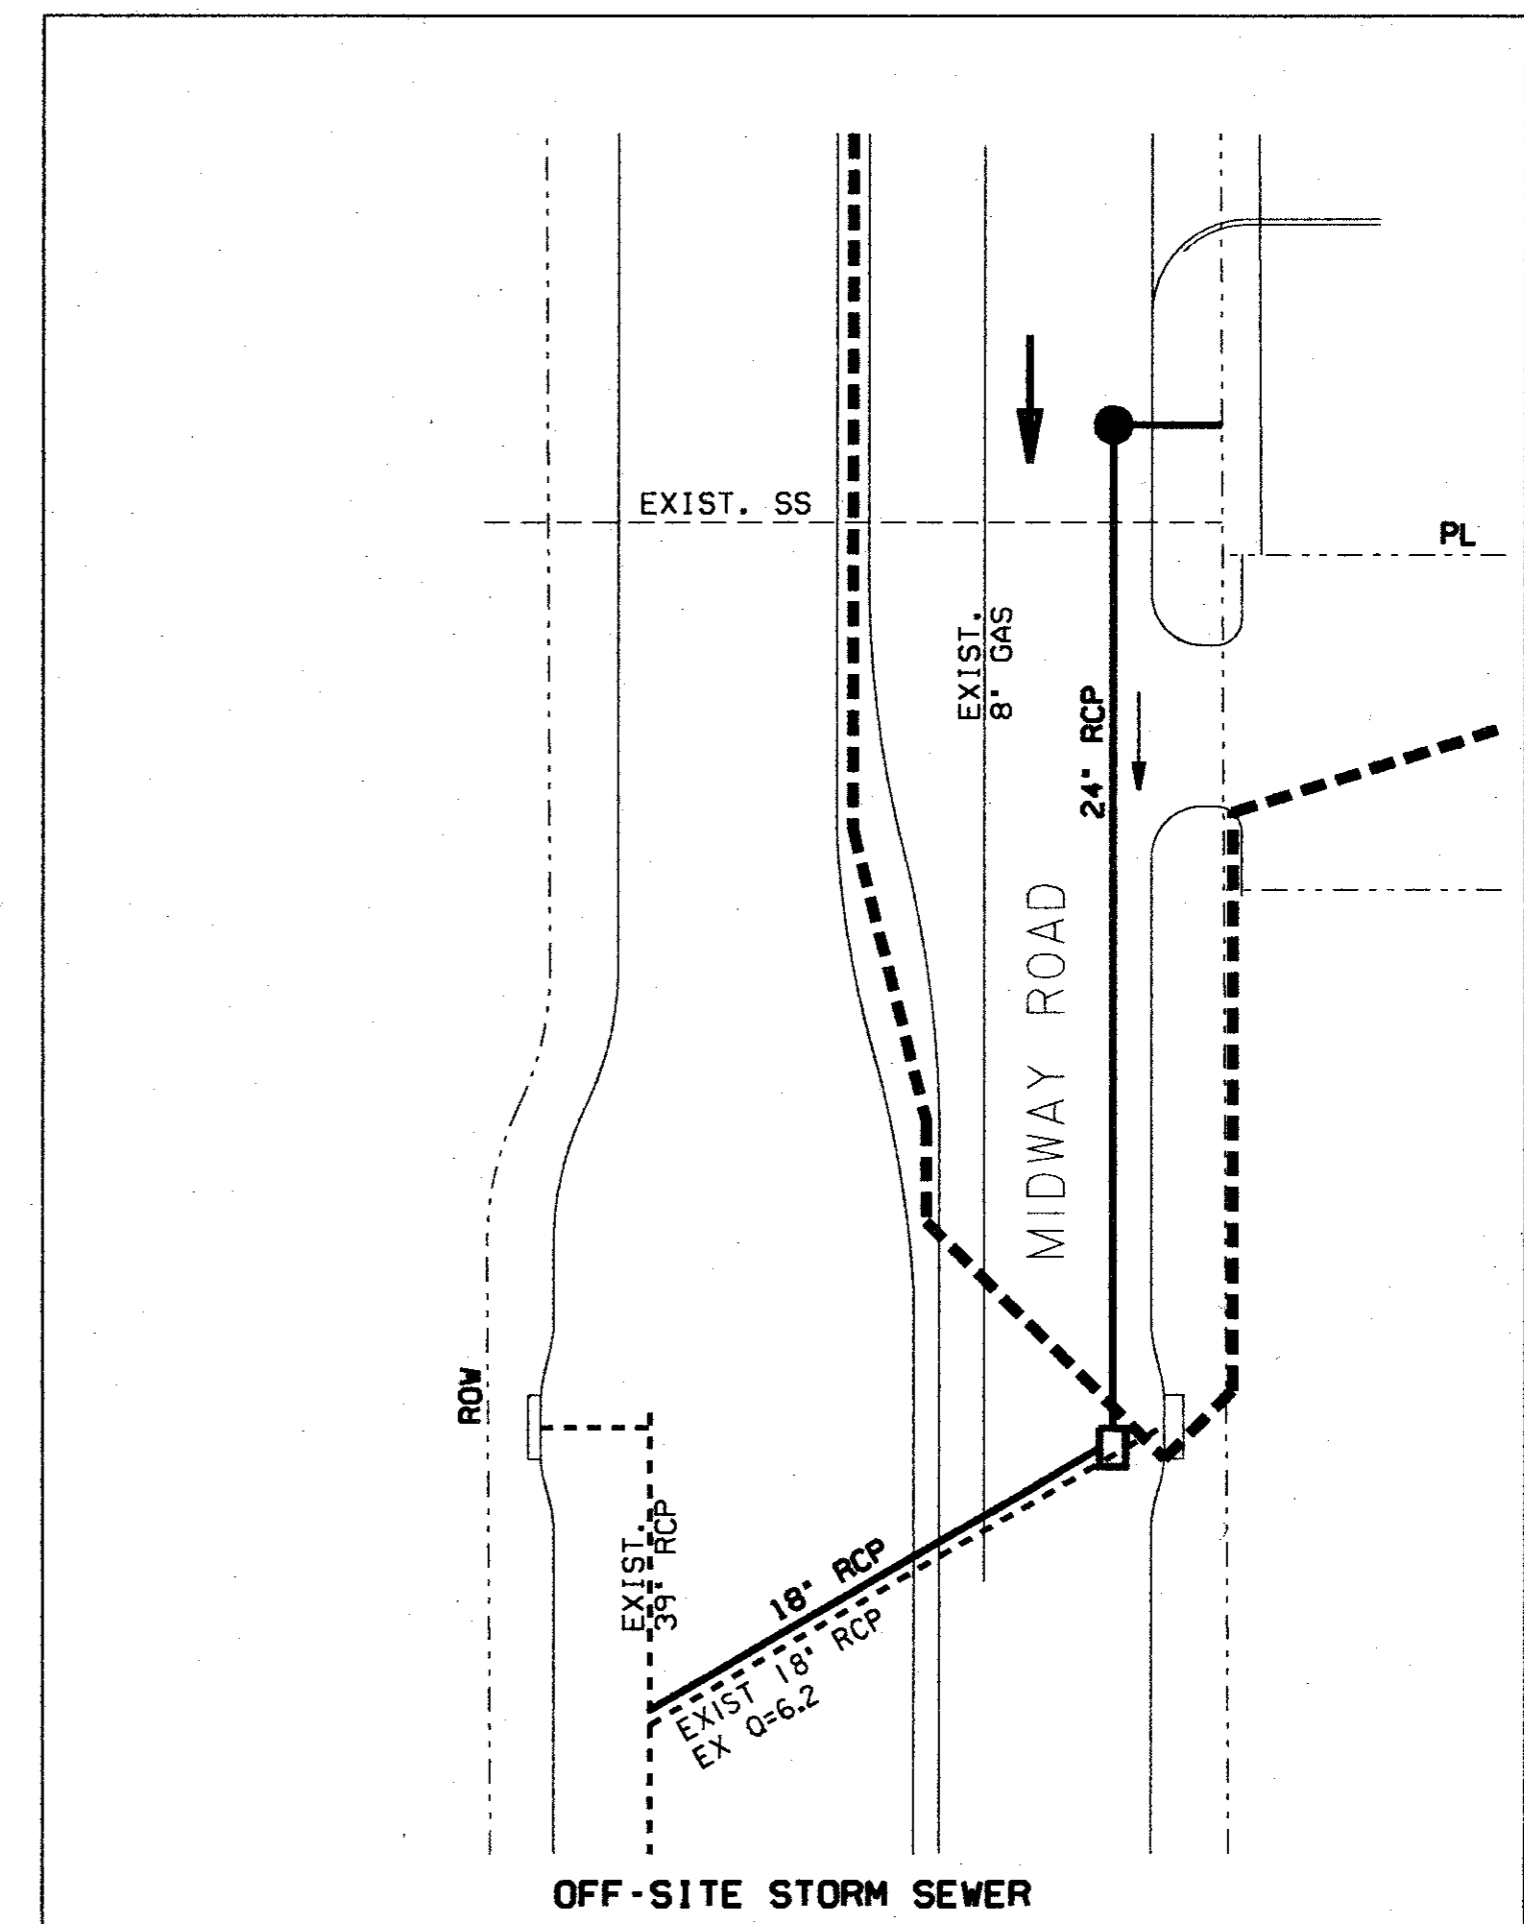

RANDOLPH W. CLENDENEN  
 VOL.86250 PG.2057  
 D.R.D.C.


RSL CONSTRUCTION CO.  
 VOL.78233 PG.737  
 D.R.D.C.

BELTWAY OFFICE PARK  
 TRACT VII  
 VOL.78157 PG.838  
 D.R.D.C.

BELTWAY CONSTRUCTION, INC.  
 VOL.86098 PG.1549  
 D.R.D.C.



"AS BUILT"

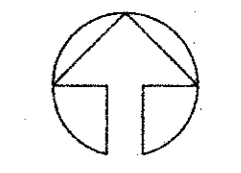

1" = 30'-0"

The construction of this Plan was completed according to the design.

HUITT - ZOLLARS

3131 MCKINNEY AVENUE/SUITE 600  
 DALLAS, TEXAS/214-871-3311