

ARCHITECTS
VAN LOM /
EDWARDS
A.I.A., P.C.

S.E. CORNER OF BELTLINE ROAD
AND MIDWAY ROAD
ADDISON, TEXAS

ITALIAN RESTAURANT




Job No. 1498-01
Date: 7/17/92
Rev: 7/28/92
10/05/92
10/21/92
03/09/93
03/17/93



STORM SEWER
PLAN

Sheet No.


C7

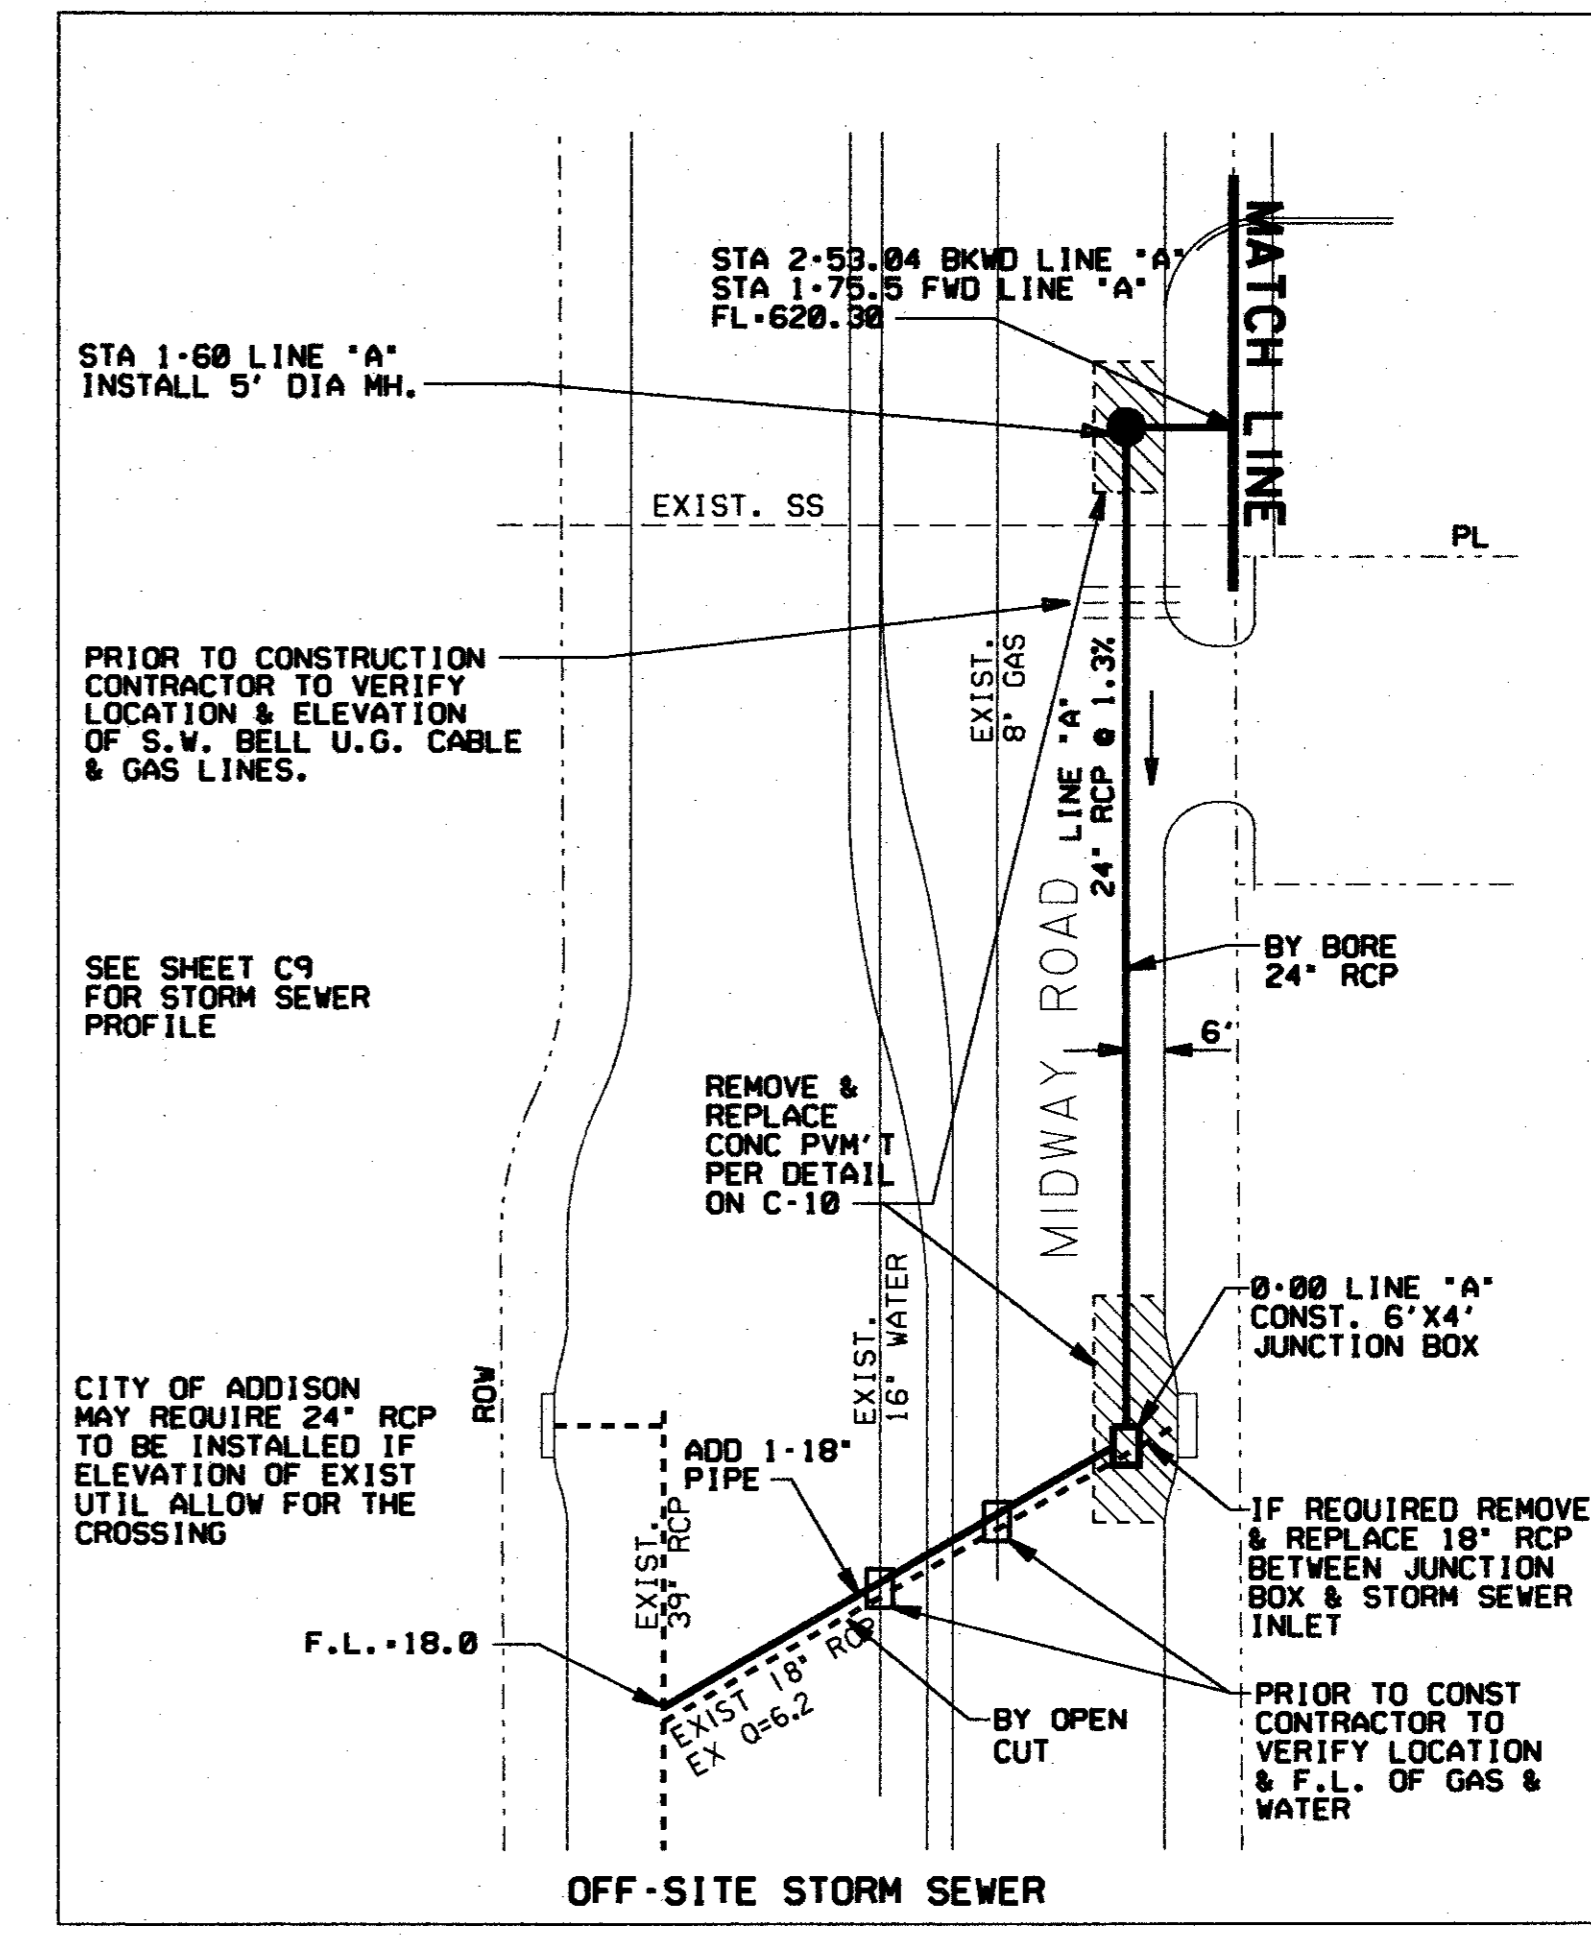

BELTWAY CONSTRUCTION, INC.
VOL. 88098 PG. 1549
D.R.D.C.

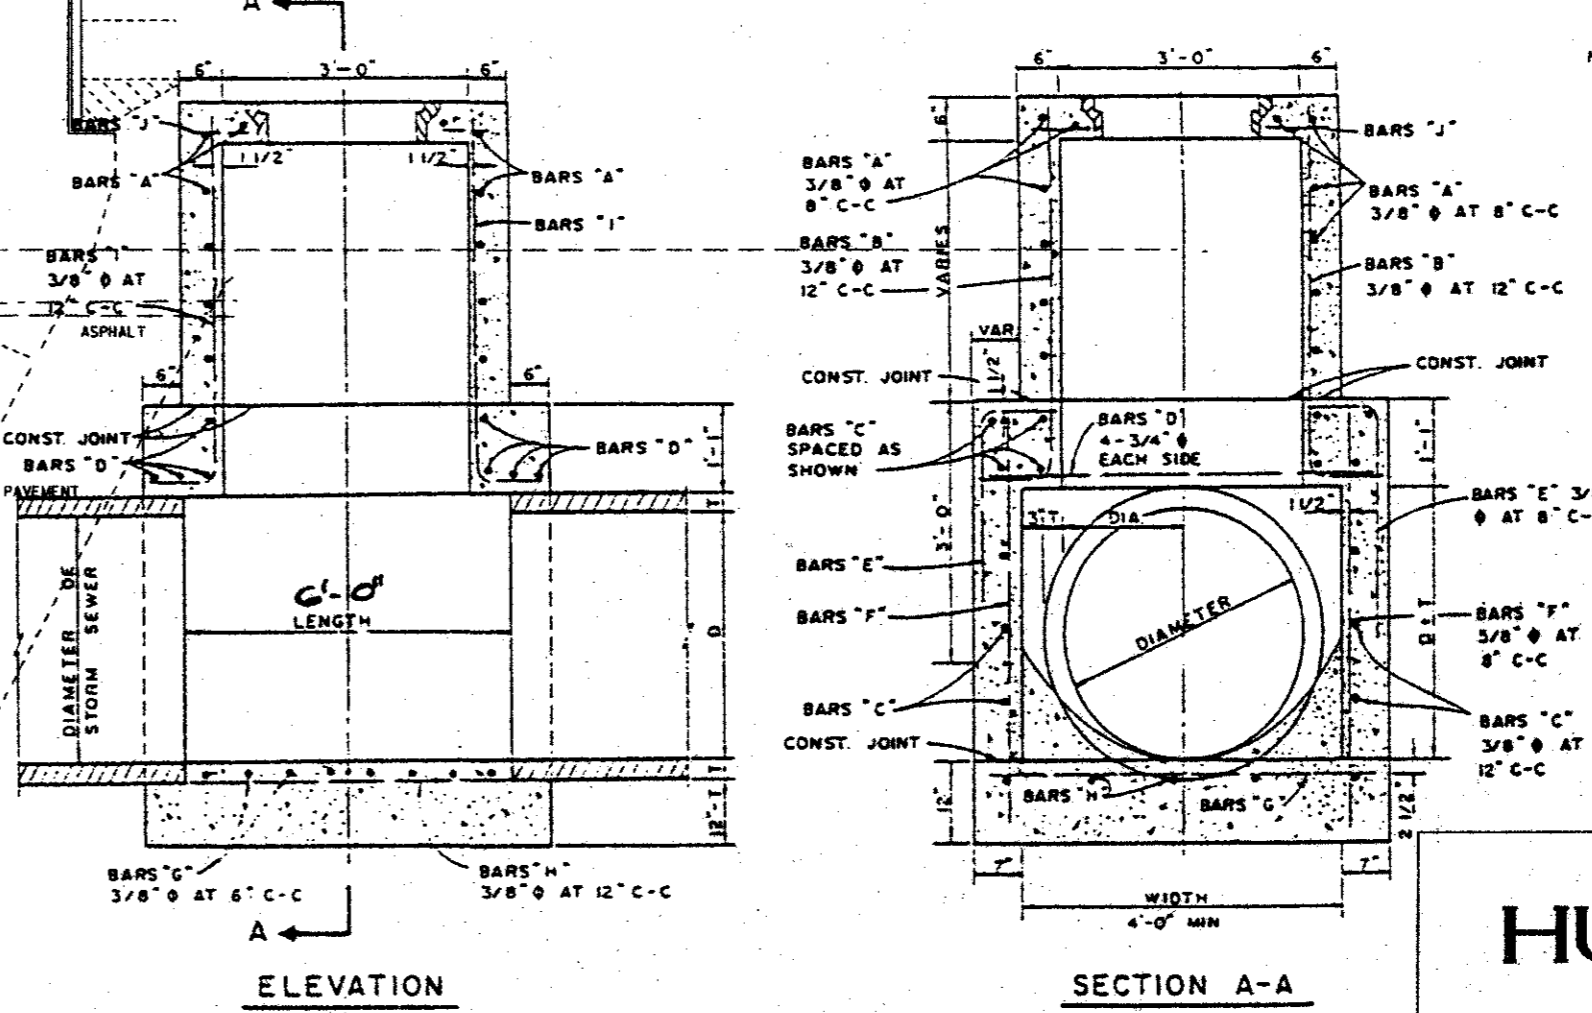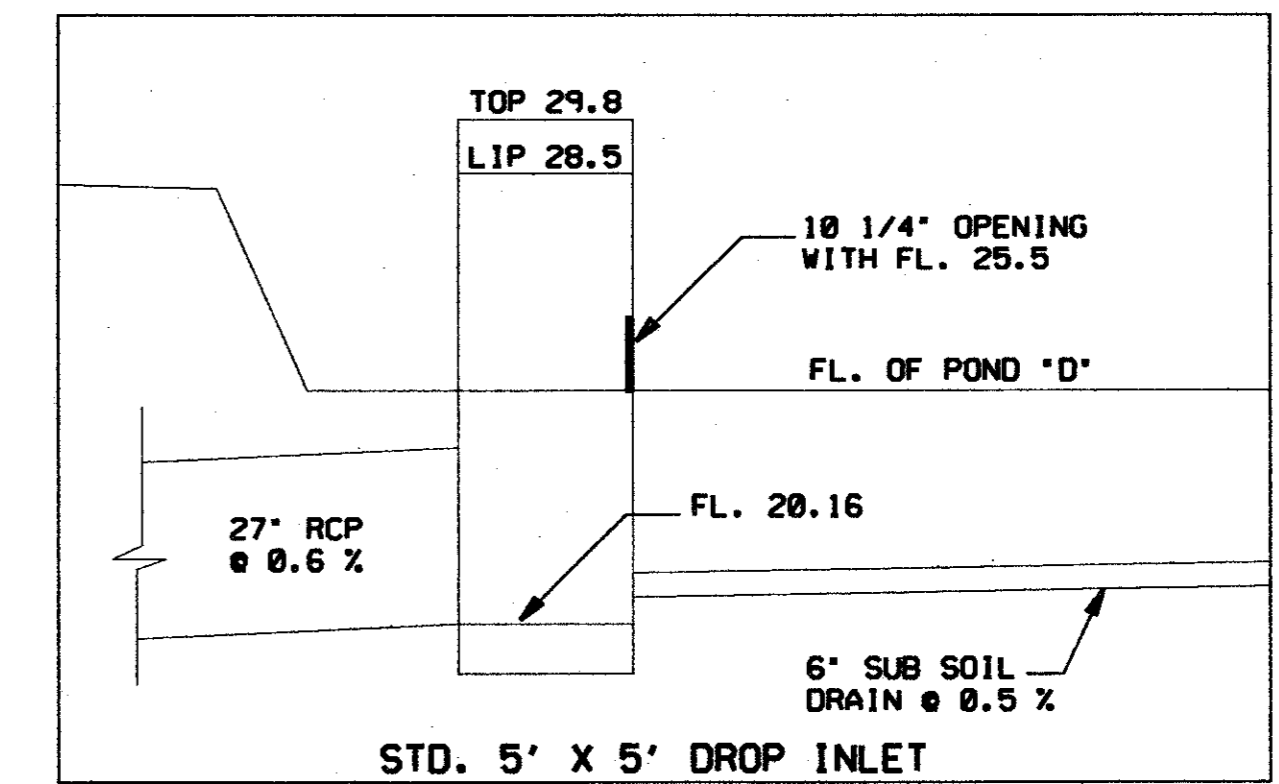

TYPE B STORM SEWER MANHOLE @ 0+00 W/4

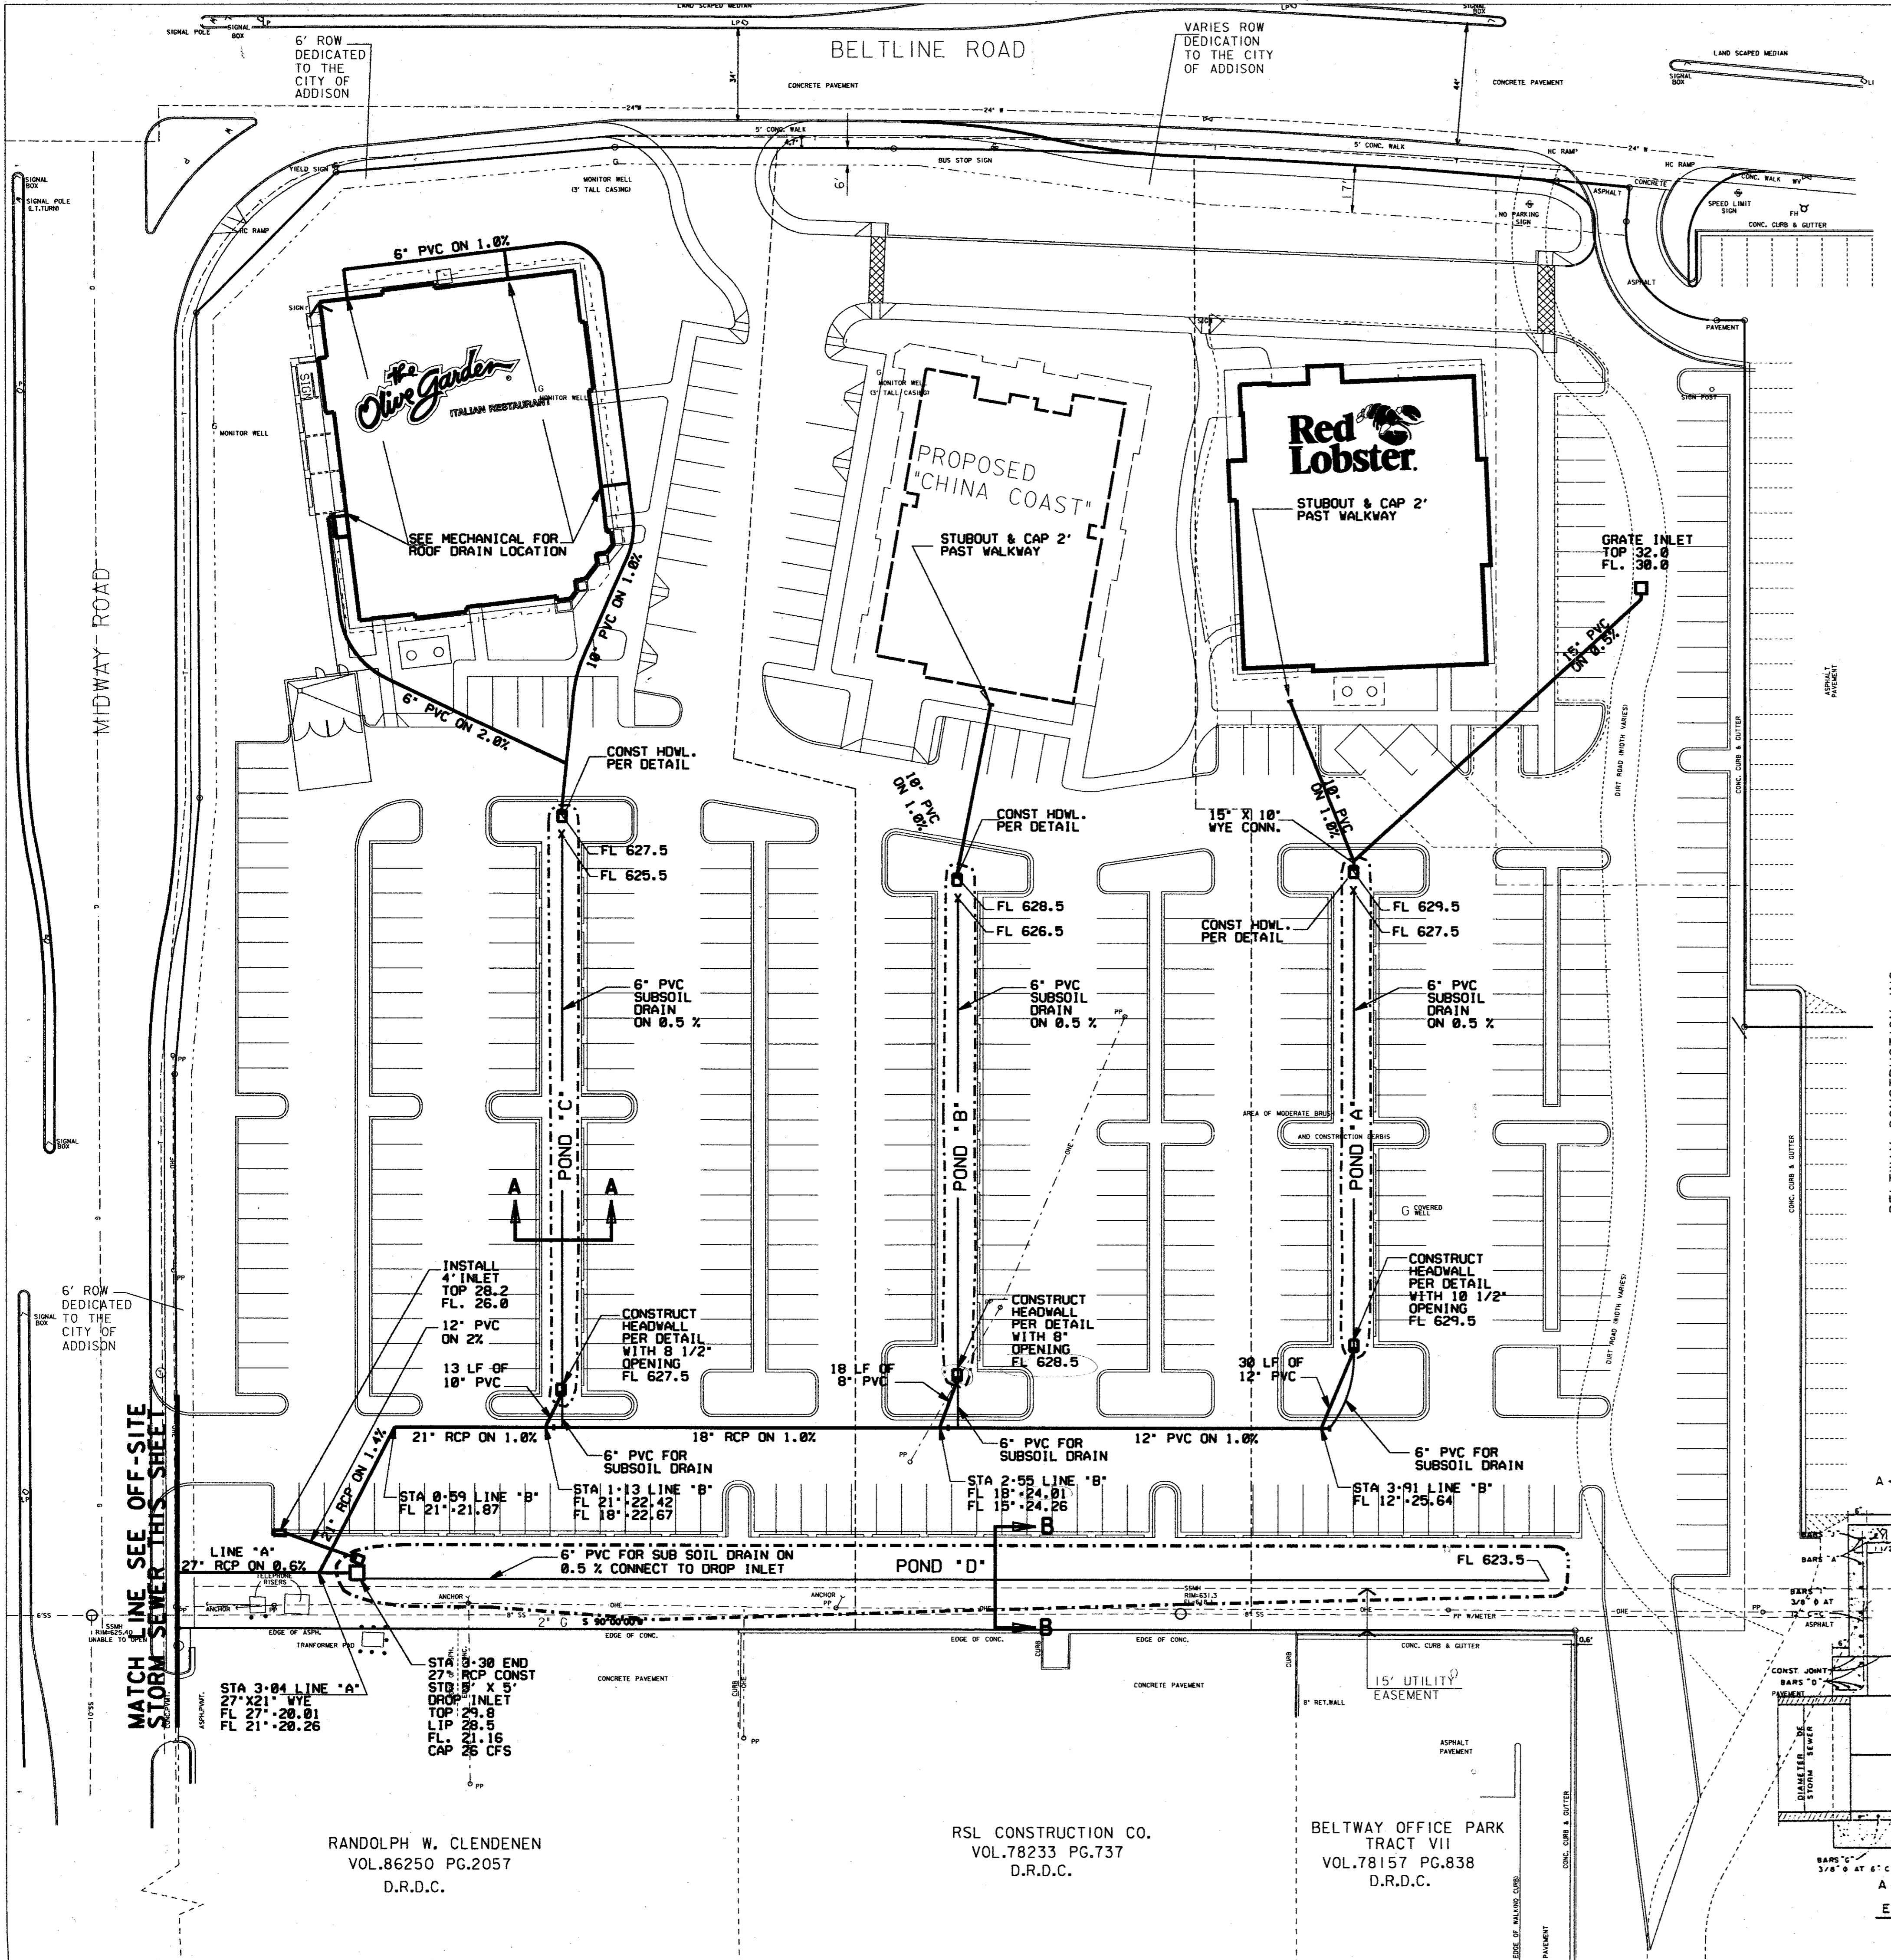

RANDOLPH W. CLENDENEN
VOL. 86250 PG. 2057
D.R.D.C.

RSL CONSTRUCTION CO.
VOL. 78233 PG. 737
D.R.D.C.

BELTWAY CONSTRUCTION, INC.
VOL. 88098 PG. 1549
D.R.D.C.

HUIT - ZOLLARS
3131 MCKINNEY AVENUE/SUITE 600
DALLAS, TEXAS 75244-1311