



NOTE:
CONTRACTOR TO VERIFY
SIZE AND ELEVATION
OF EXIST STORM SEWER
PRIOR TO CONSTRUCTION.

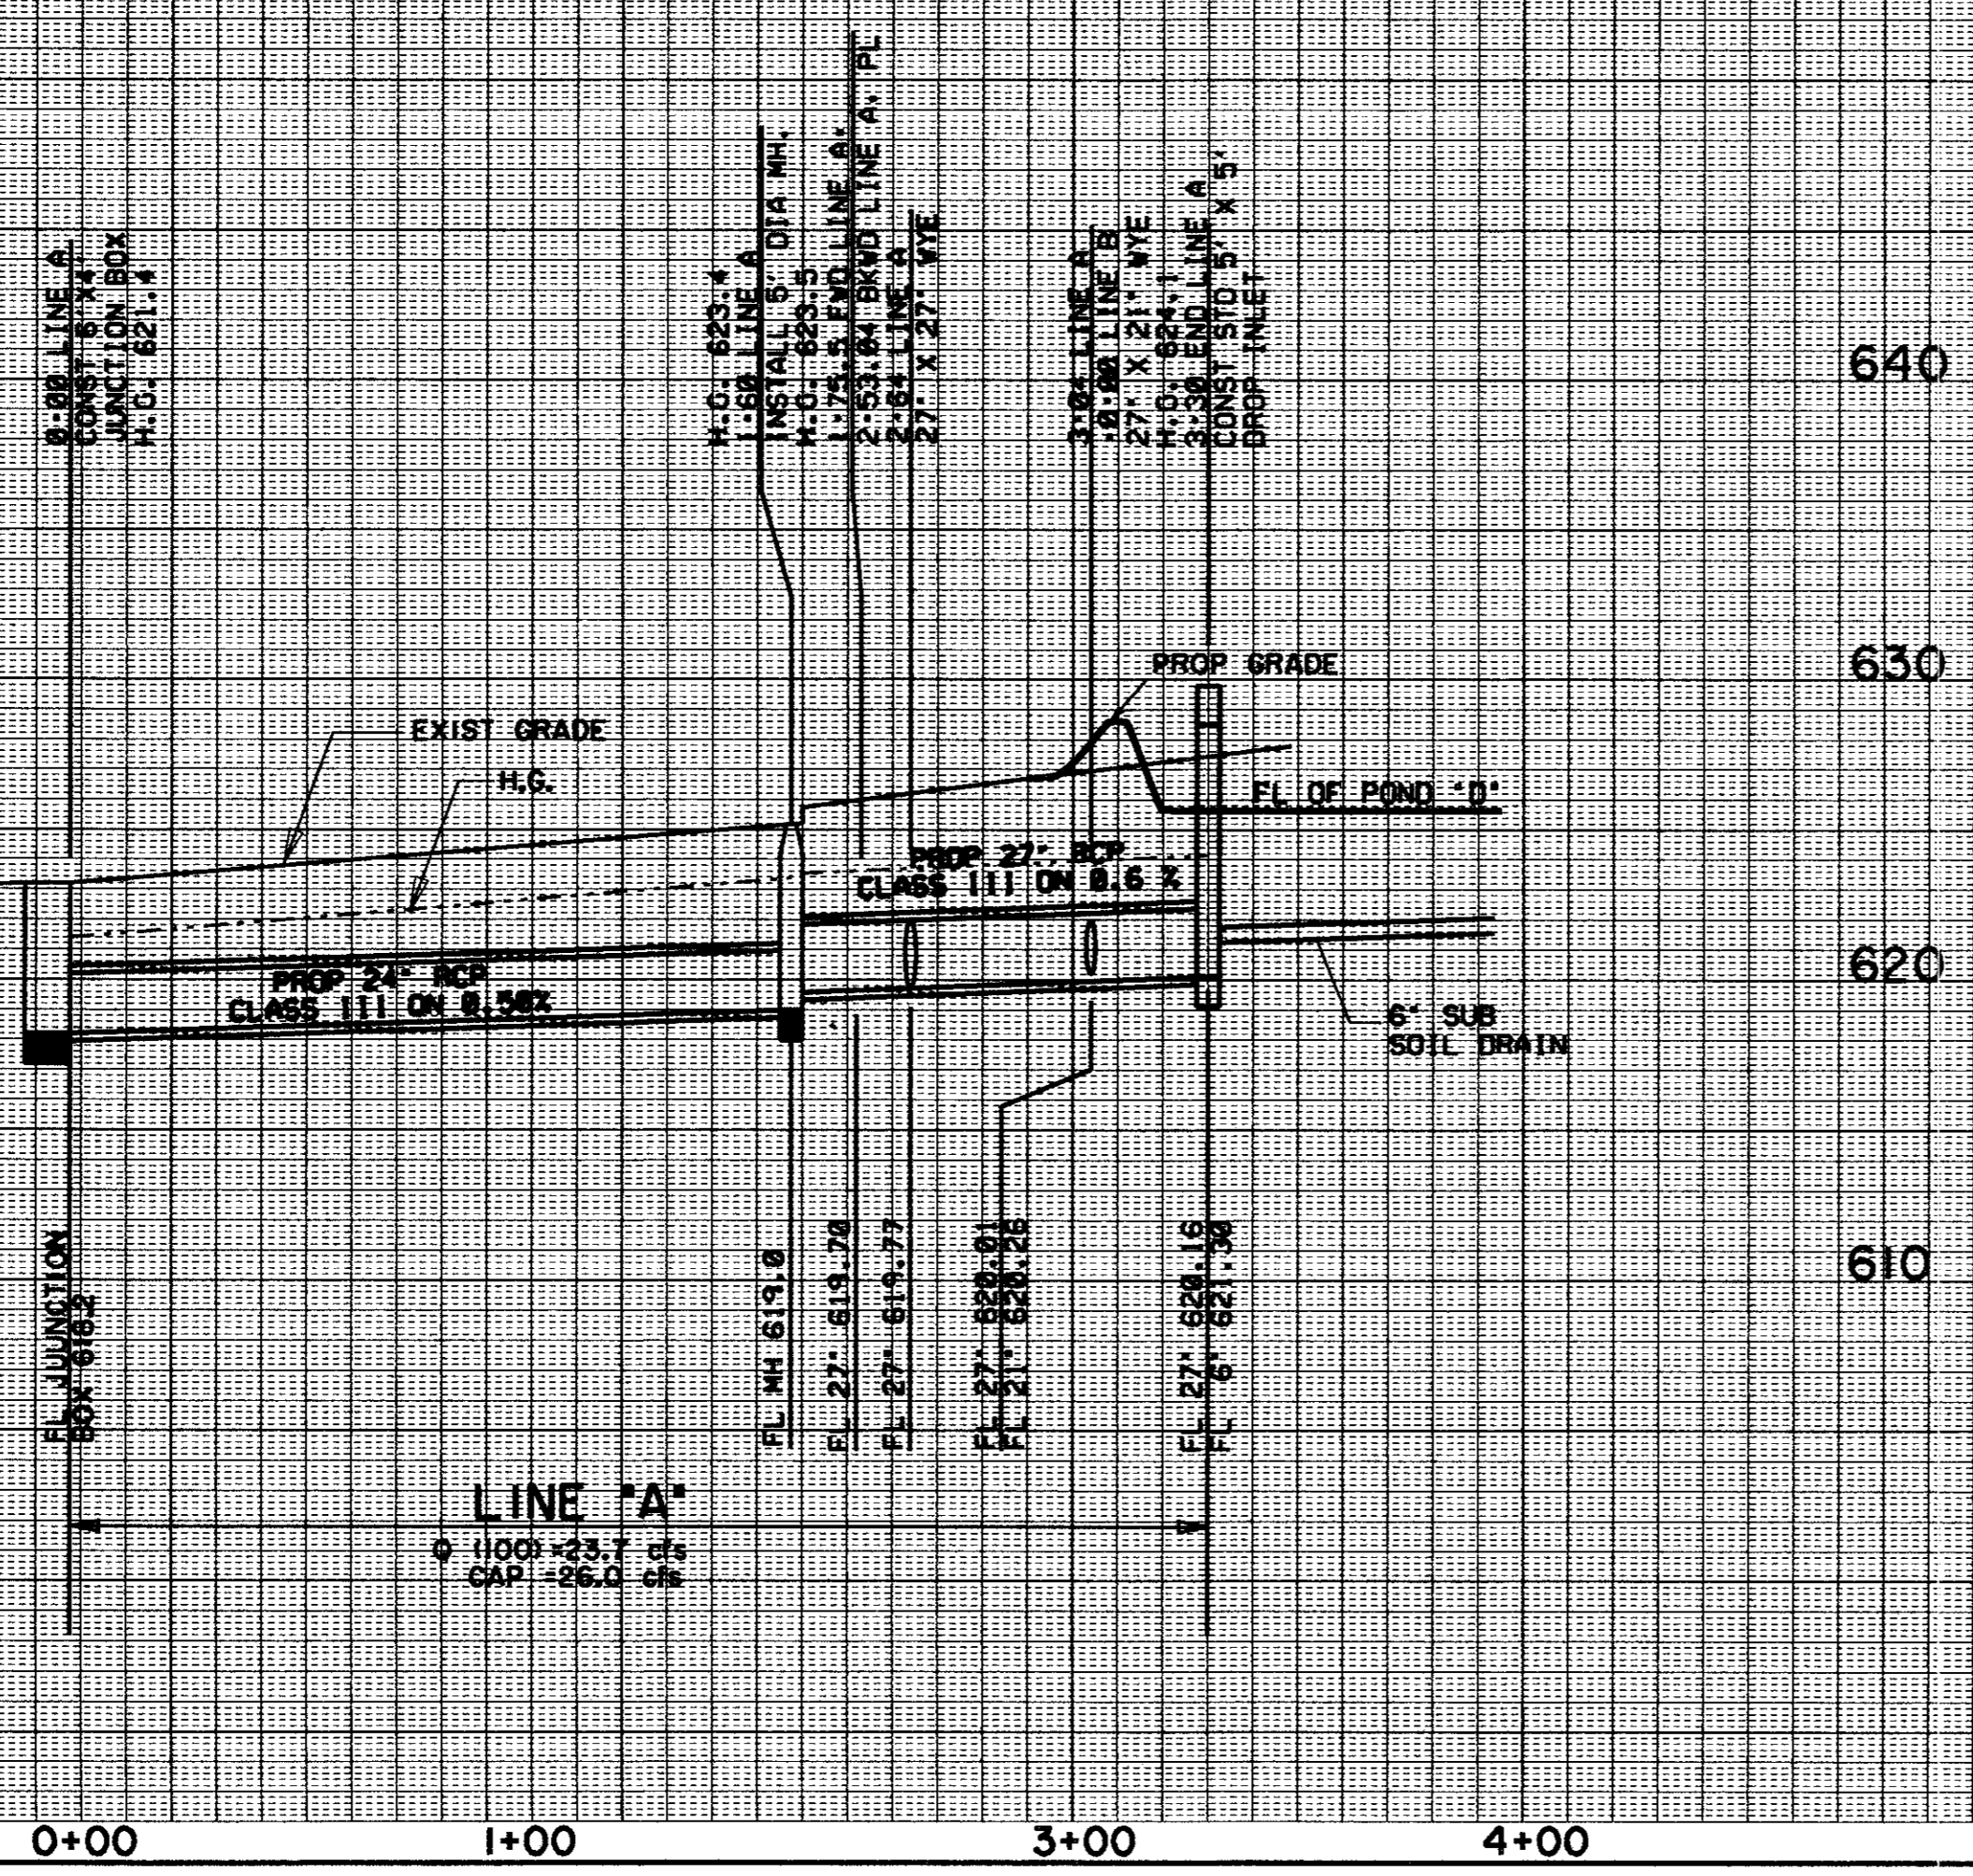

AS BUILT

| PROFILE SHEET | | | | | | |
|---|-------|---------|---------------------|---------|------|--------|
| THE OLIVE GARDEN - ITALIAN RESTAURANT | | | | | | |
| WATER UTILITIES DEPARTMENT | | | | | | |
| HUITT - ZOLLARS, INC./ CONSULTING ENGINEERS | | | | | | |
| 3131 MCKINNEY AVE./SUITE 600/DALLAS, TEXAS 75204 (214) 871-3311 | | | | | | |
| CITY OF ADDISON, TEXAS | | | | | | |
| DESIGN | DRAWN | CHECKED | SCALE | DATE | FILE | NUMBER |
| M.M. | A.B. | | H 1"=40' V 1"=6' | JULY 92 | | C9 |

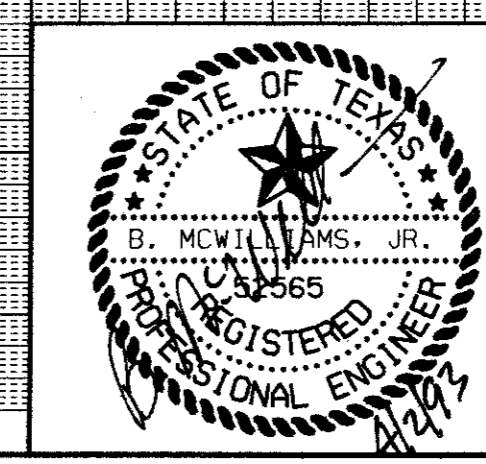

The construction of this Plan was completed according to the design.