

ARCHITECTS
VAN LOM /
EDWARDS
A.I.A., P.C.



S.E. CORNER OF BELTLINE ROAD
AND MIDWAY ROAD
ADDISON, TEXAS

The Garden
Olive Garden
ITALIAN RESTAURANT

Job No. 1498-01
Date: 7/17/92
Rev: 7/28/92
10/05/92
10/21/92

DETAIL SHEET


Sheet No.
C10

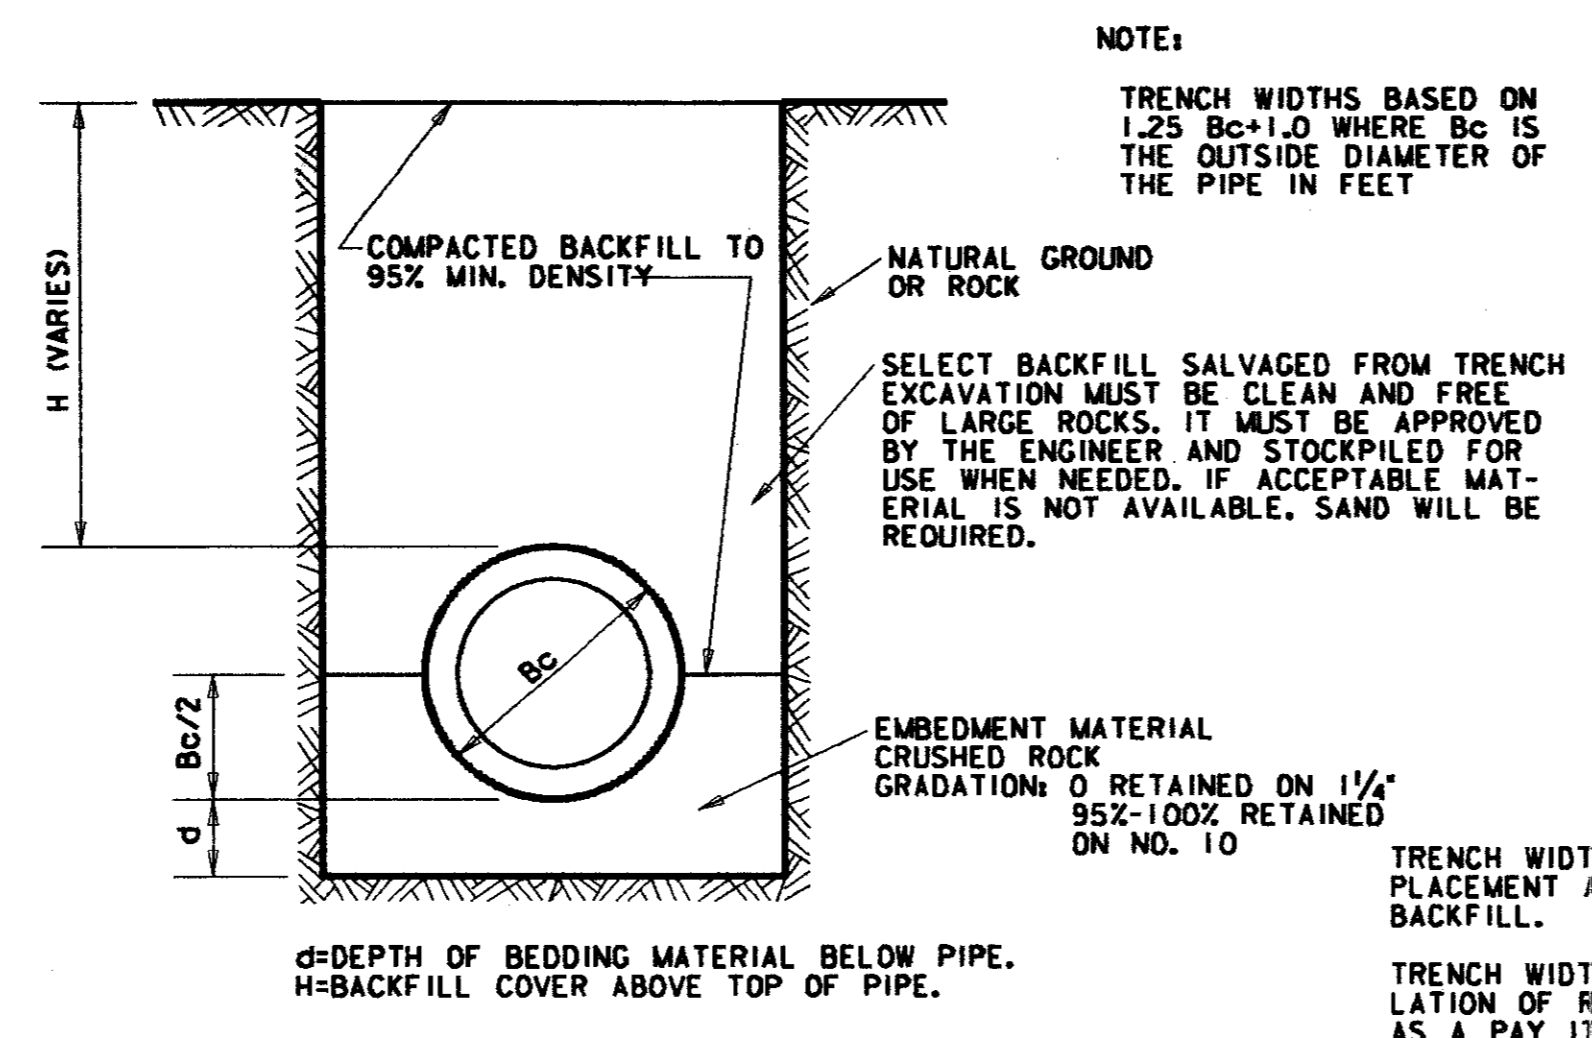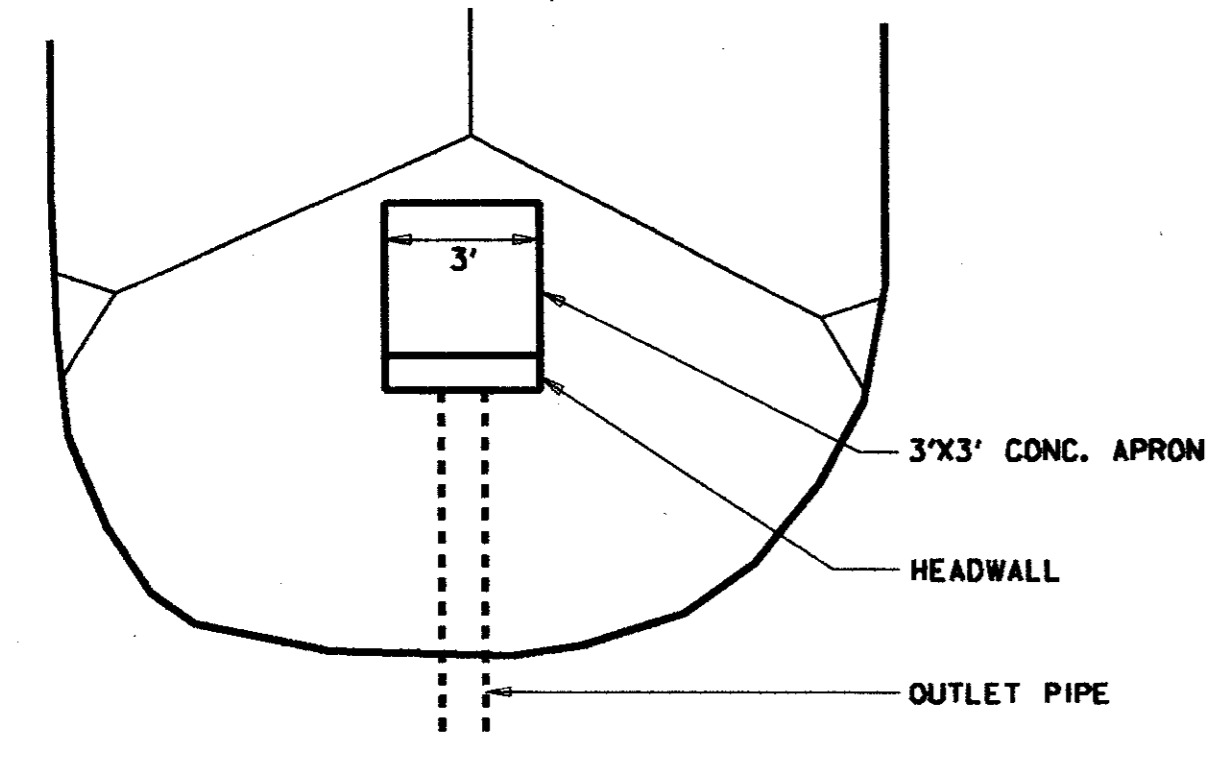


NOTE:
TRENCH WIDTHS BASED ON 1.25 Bc+1.0 WHERE Bc IS THE OUTSIDE DIAMETER OF THE PIPE IN FEET

PIPE DIAMETER (INCHES)	TRENCH WIDTH (FEET)
15	3.0
18	3.4
21	3.8
24	4.1
27	4.5
33	5.0
39	5.25

DEPTH OF BEDDING MATERIAL BELOW PIPE	
D (INSIDE DIAMETER)	d (MIN)
27" OR SMALLER	3"
33"	4"
39"	4"

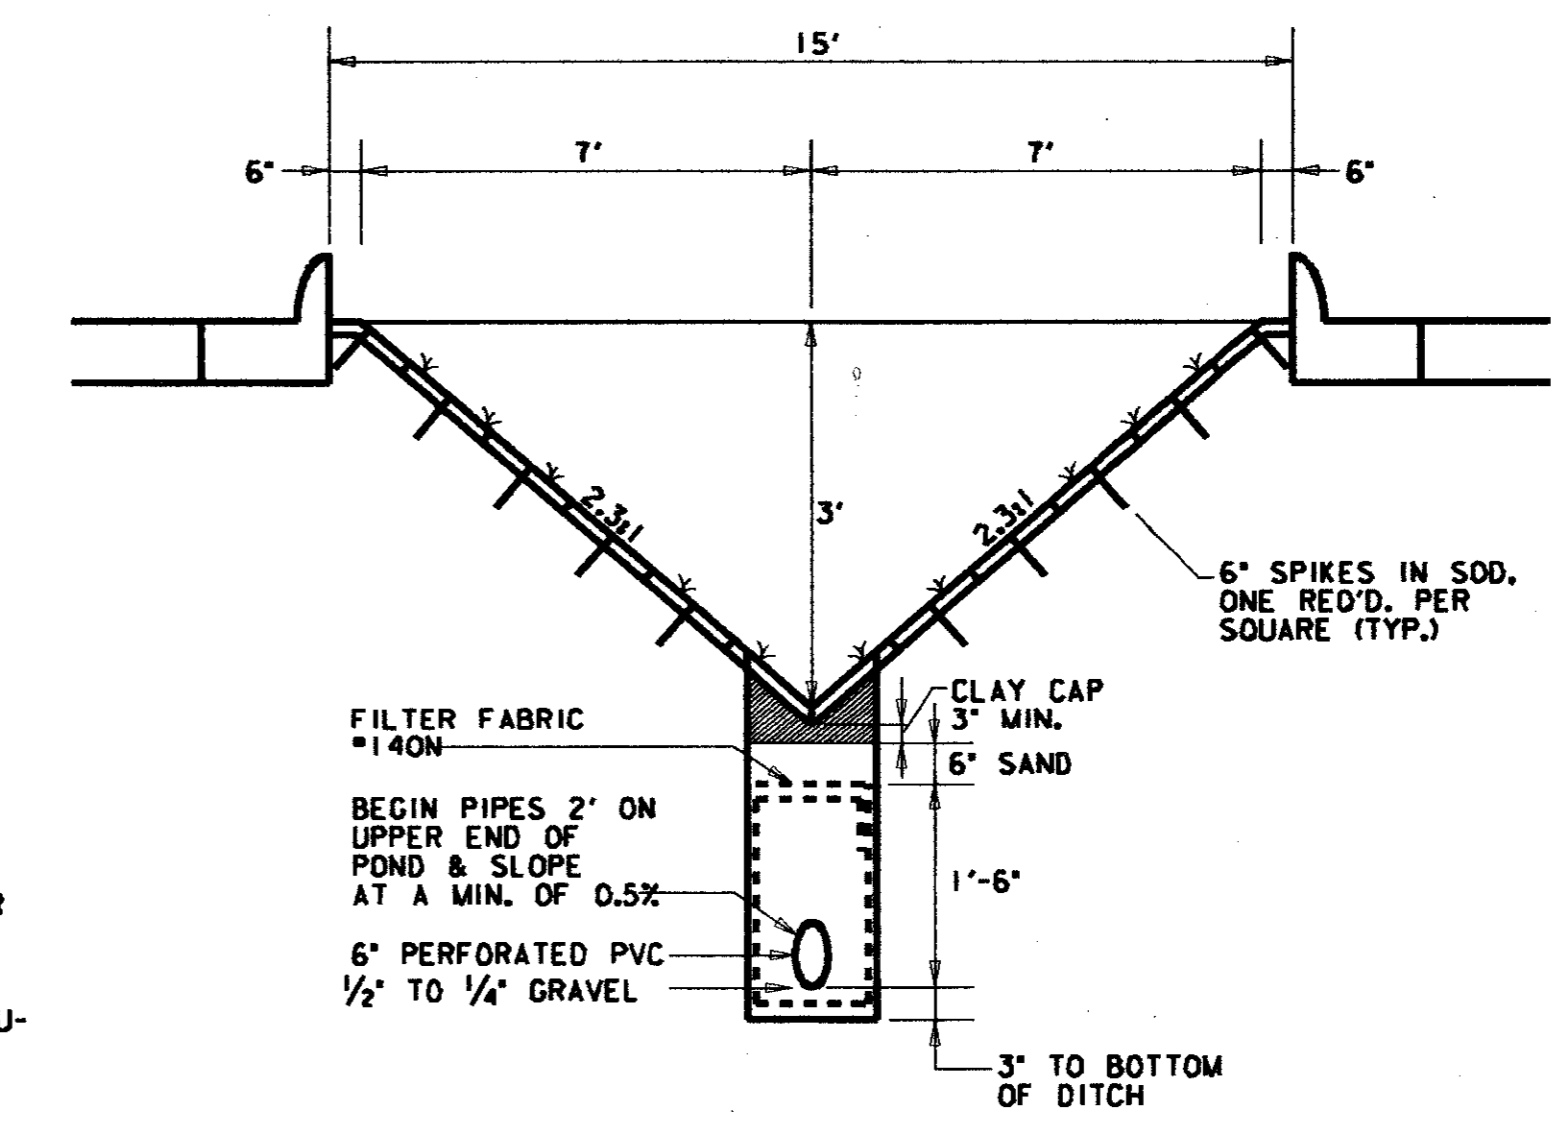


TYPICAL POND A, B & C SECTION "A-A"

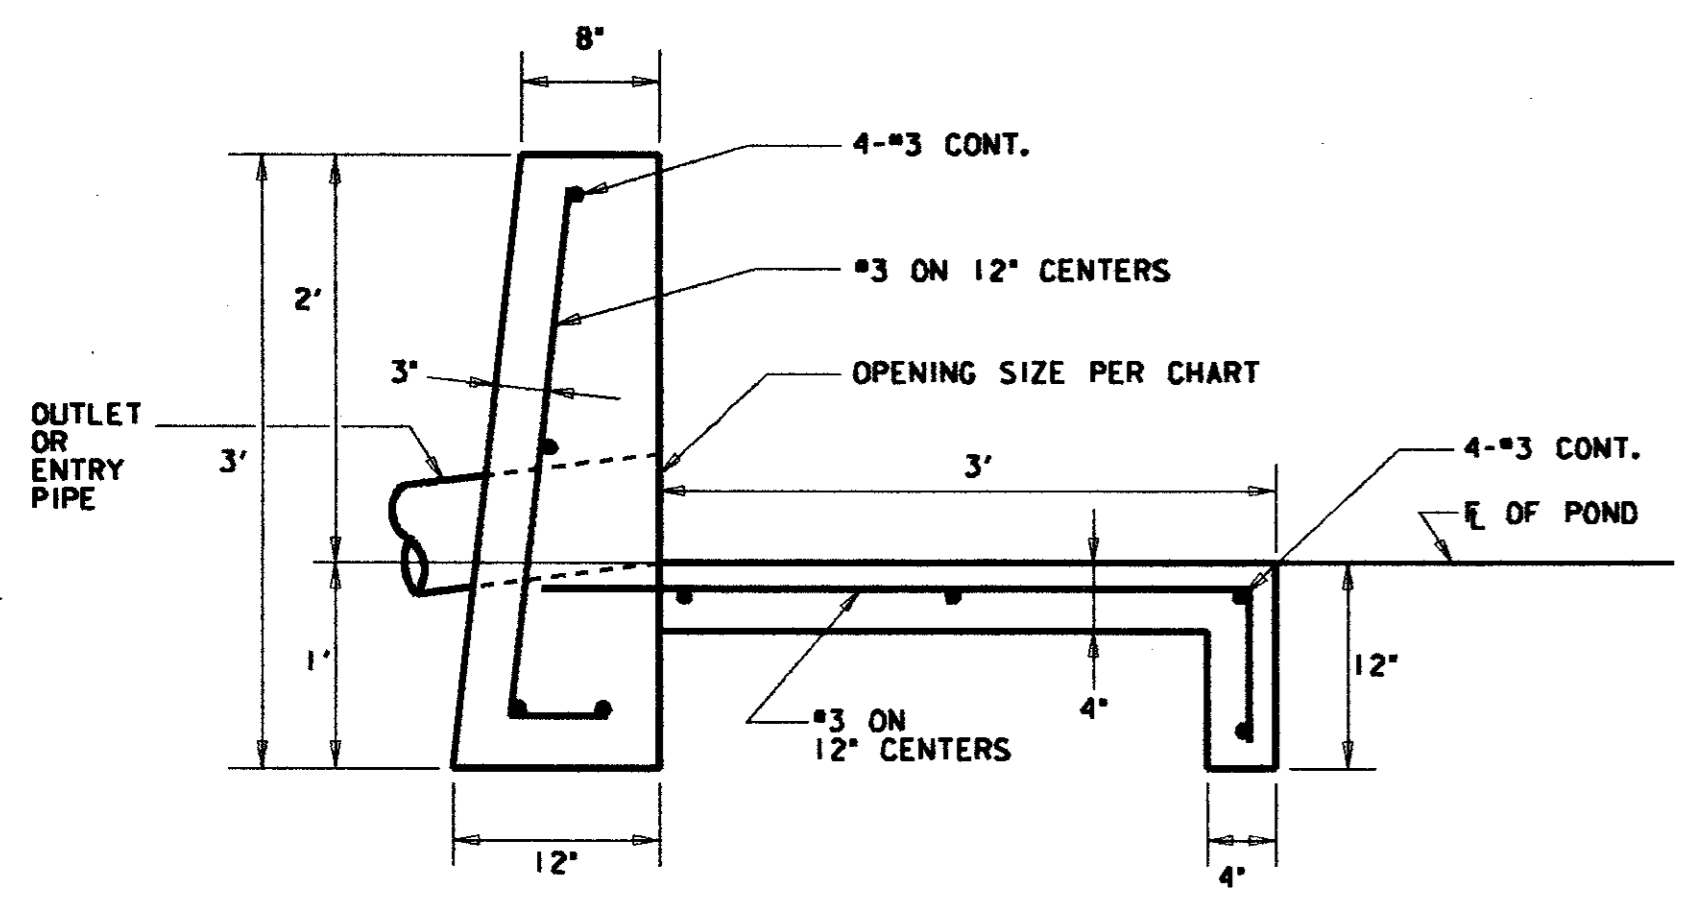


HEADWALL DETAIL
TYPICAL PONDS A, B, C, & D

REINFORCED CONCRETE CLASS III PIPE INSTALLATION

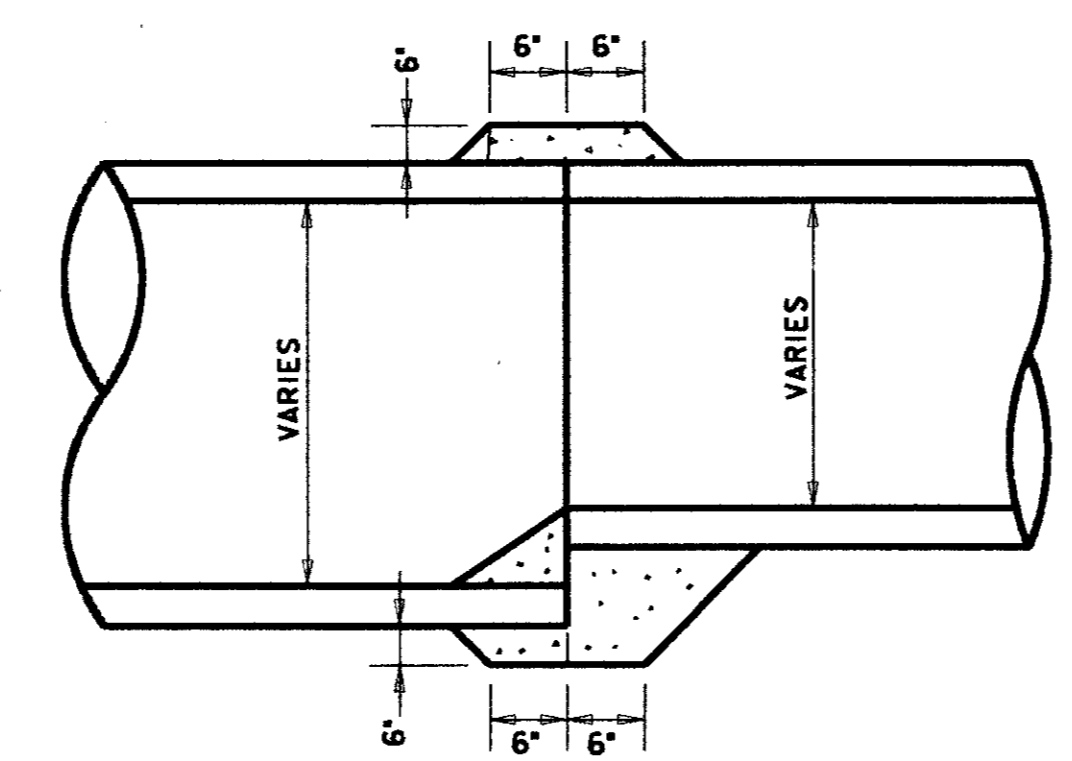


CONCRETE COLLAR DETAIL
FOR END TO END EXTENSIONS

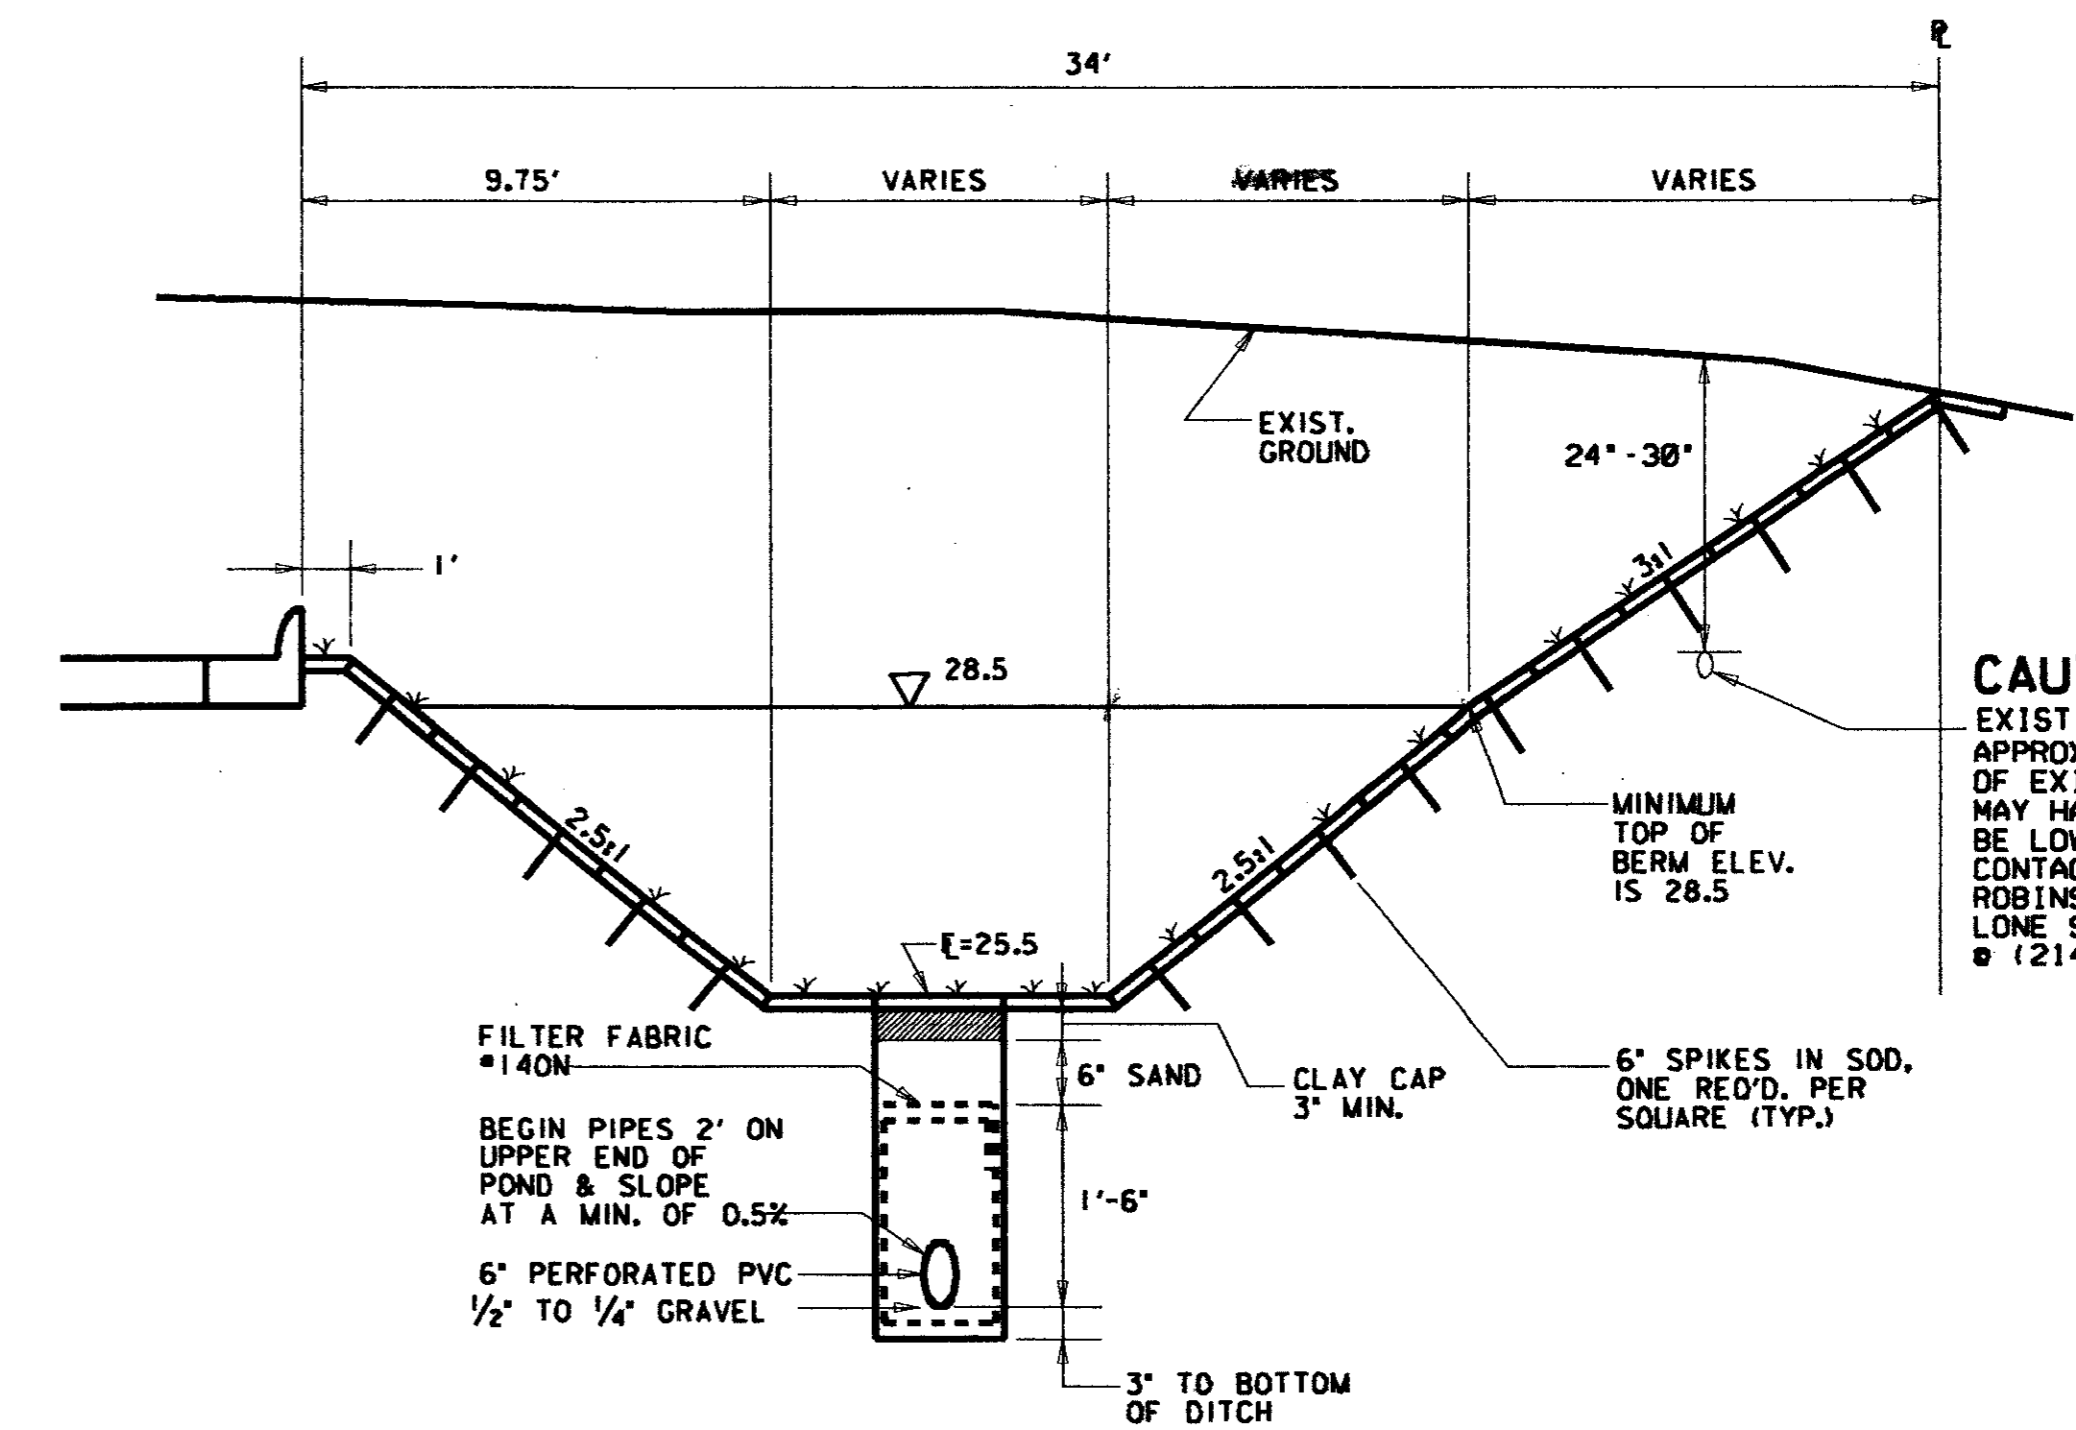


SECTION "B-B"
POND "D"


CAUTION !!
EXIST 2" GAS APPROX 450' OF EXIST GAS MAY HAVE TO BE LOWERED CONTACT BOB ROBINSON WITH LONE STAR GAS @ (214)380-5109

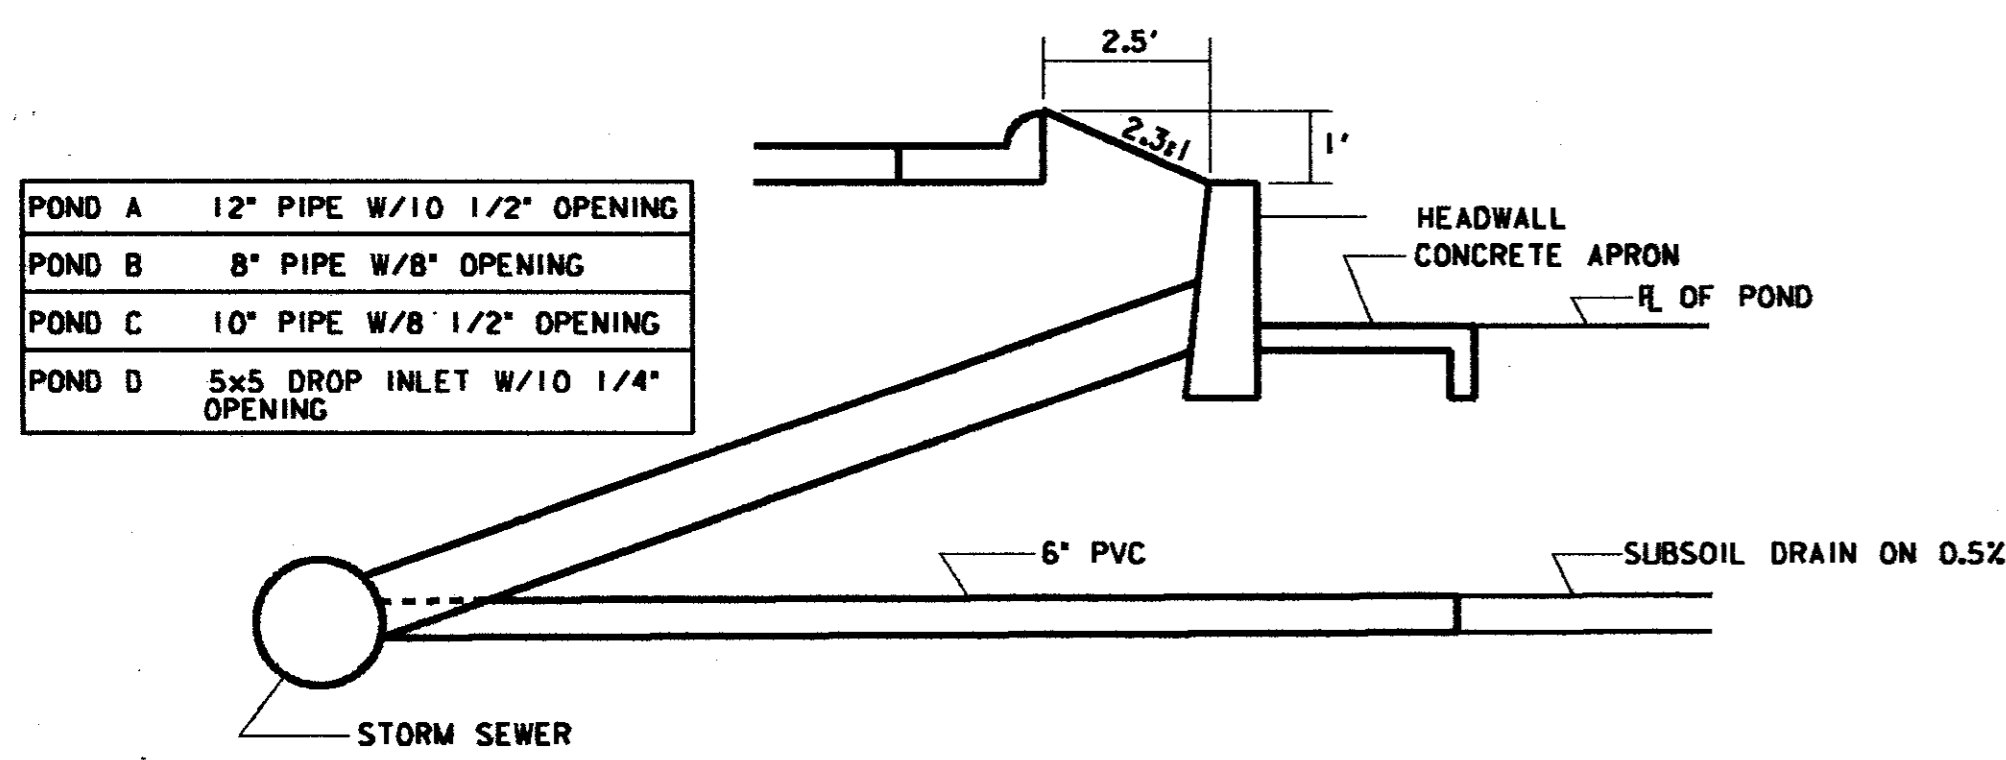


OUTLET STRUCTURES TYPICAL
TYPICAL PONDS A, B, C, & D

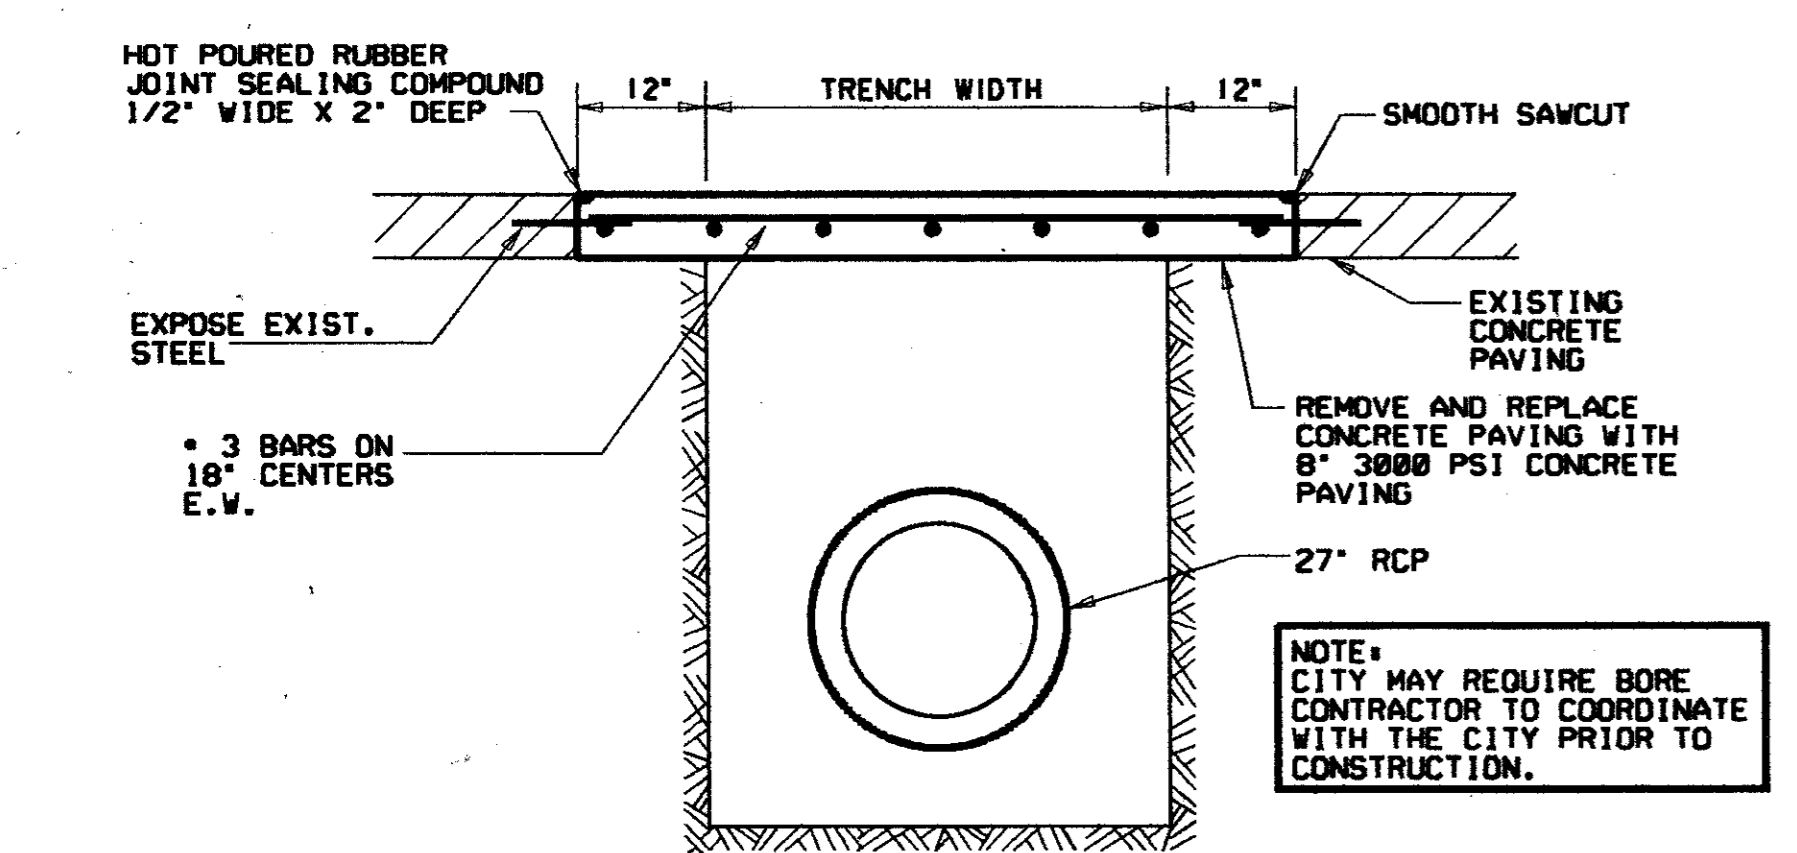

CONCRETE PAVEMENT REPLACEMENT AT MIDWAY ROAD
NTS

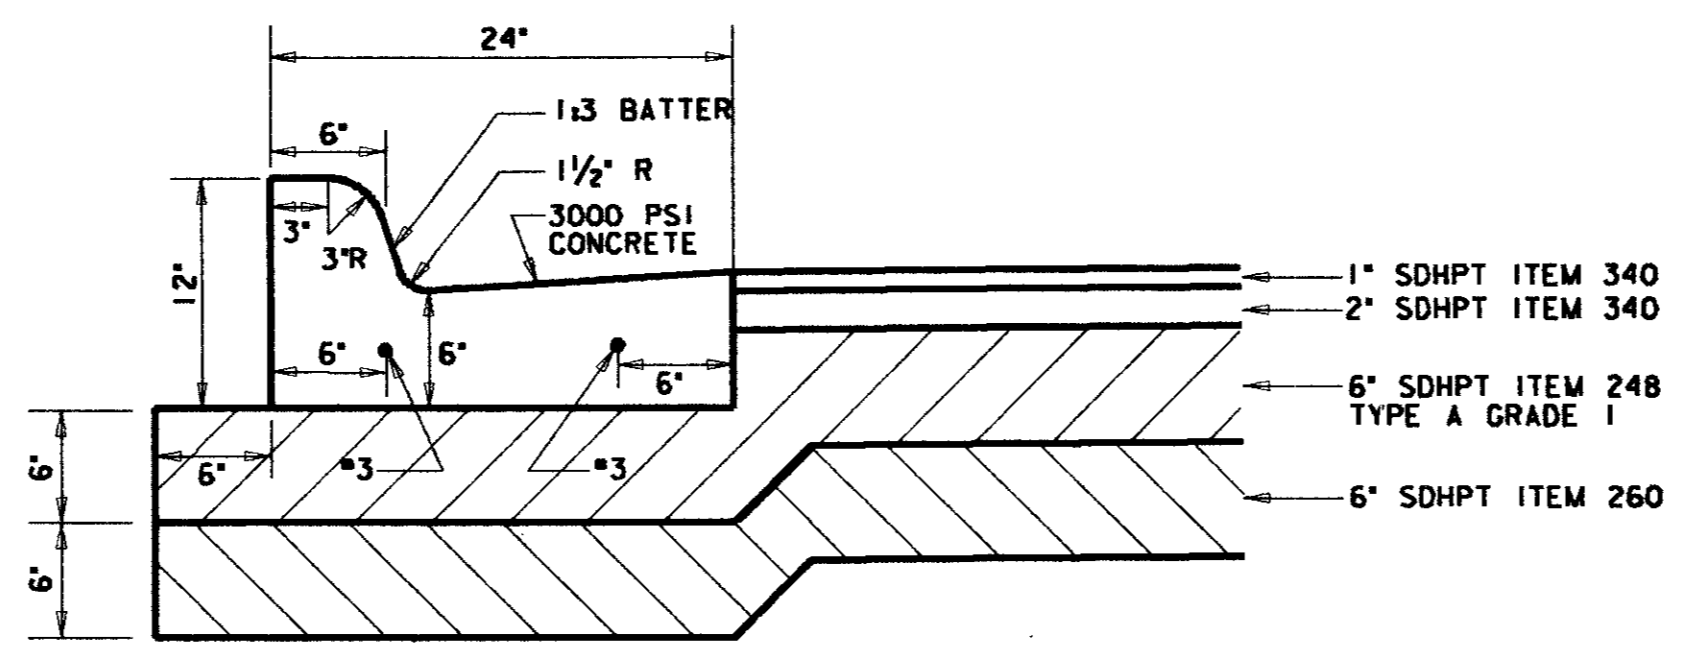


TYPICAL PAVING SECTION & CURB DETAIL AROUND DETENTION PONDS
SEE ARCHITECT PLANS FOR SEPARATE CURB DETAIL

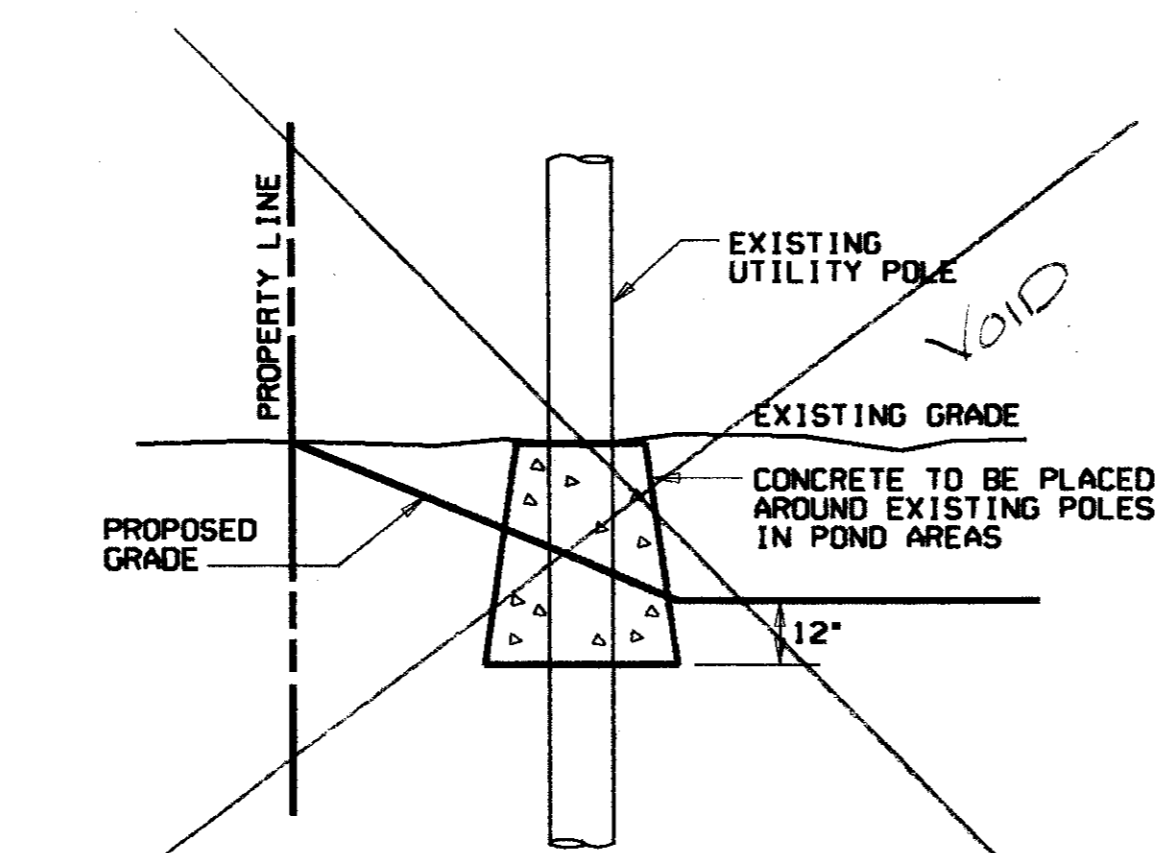

UTILITY POLE SUPPORT DETAIL
NTS

POND SLOPE TO GO AROUND POLE

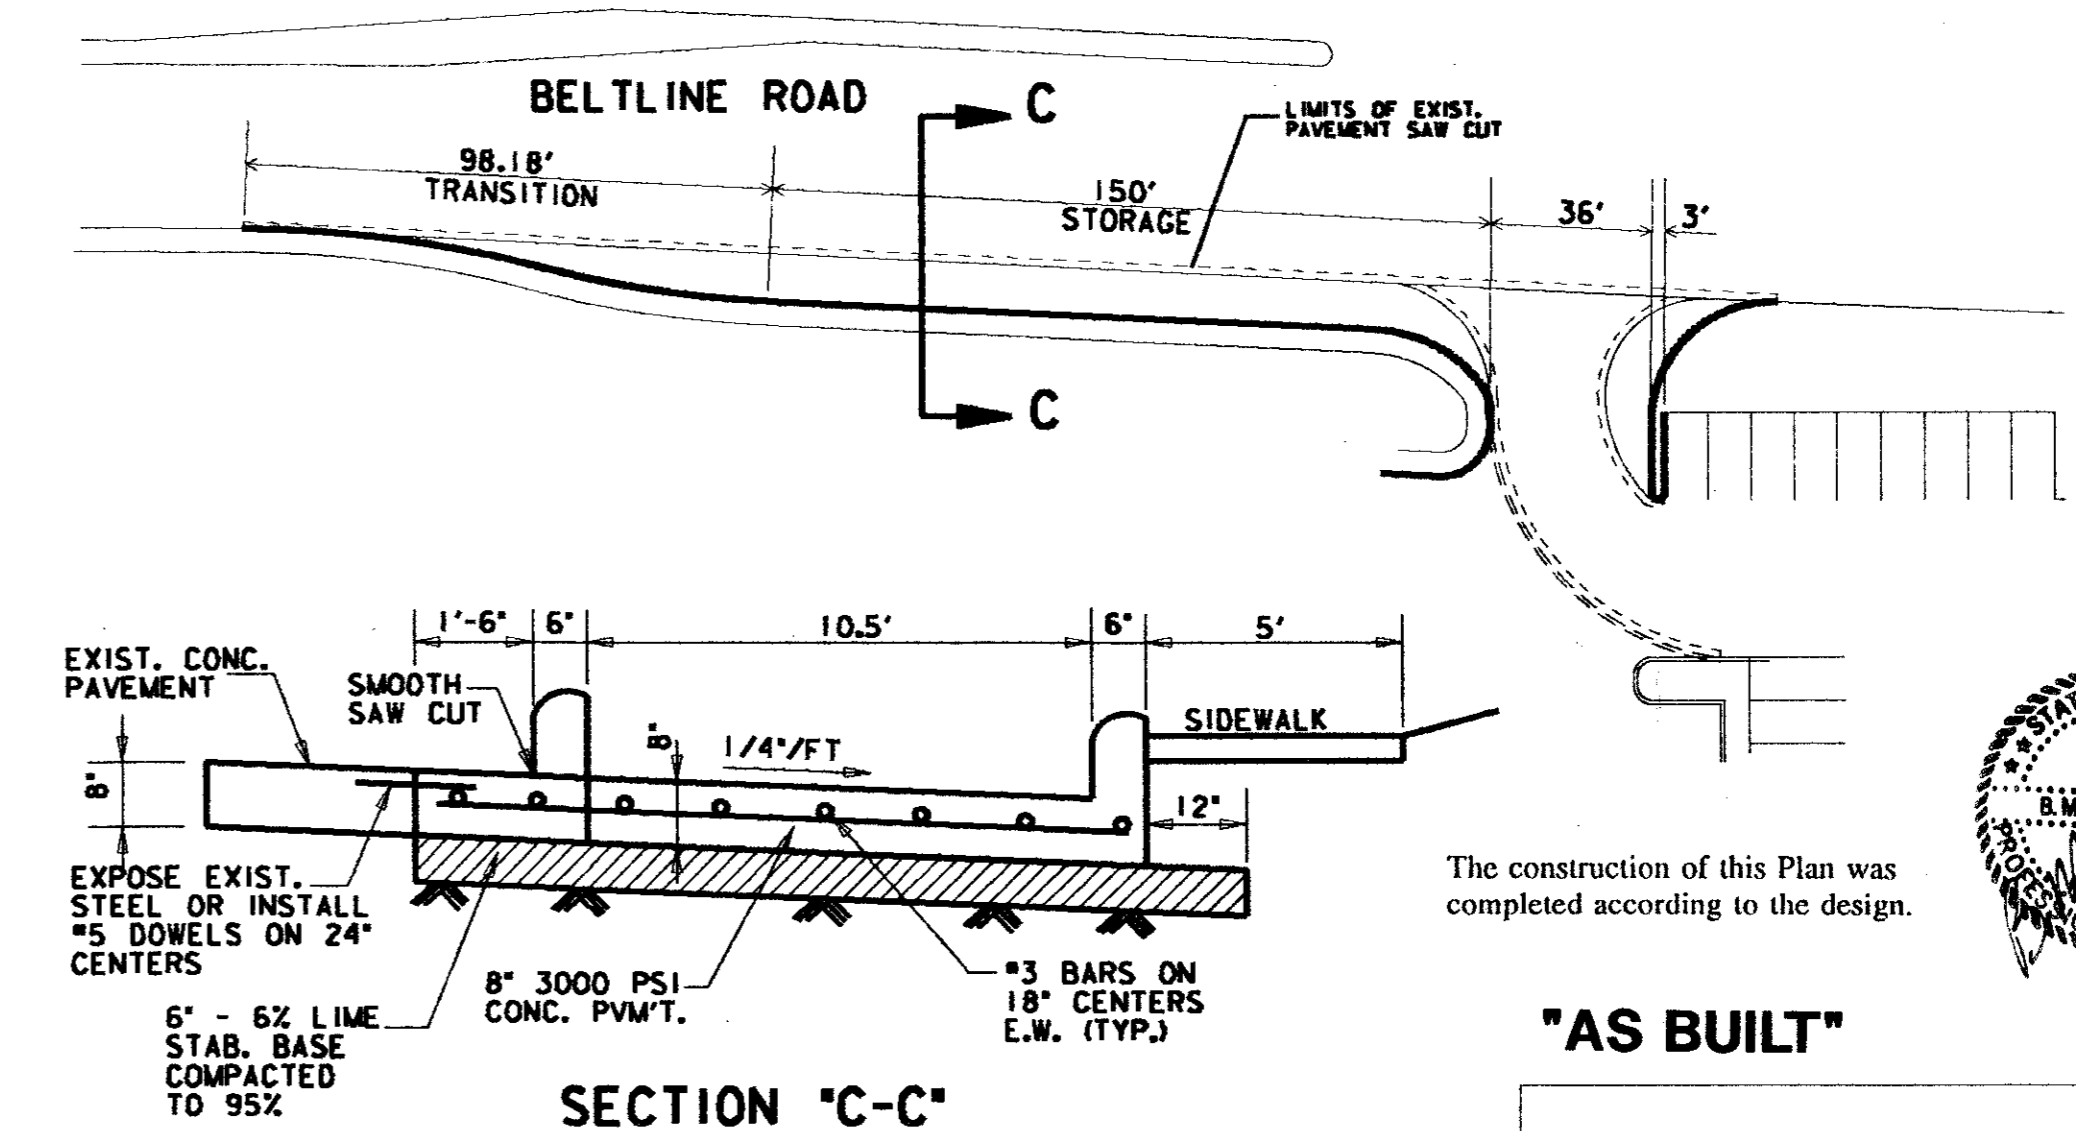

SECTION "C-C"
DECCELERATION LANE DETAIL
NTS

The construction of this Plan was completed according to the design.

"AS BUILT"

HUITT ~ ZOLLARS
3131 MCKINNEY AVENUE/SUITE 600
DALLAS, TEXAS/214-871-3311