


ARCHITECTS  
**VAN LOM / EDWARDS A.I.A., P.C.**  
 34 N.W. First Avenue, Suite 309  
 Portland, Oregon 97209 503/226-0590

S.E. CORNER OF BELTLINE ROAD  
 AND MIDWAY ROAD  
 ITALIAN RESTAURANT ADDISON, TEXAS

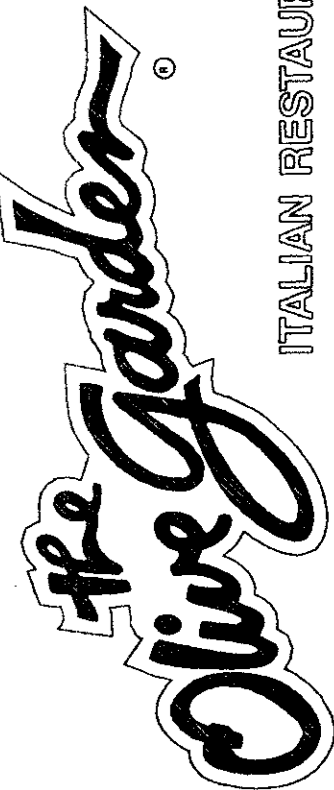

Job No. 1498-01

Date: 7/17/92  
 Rev: 7/28/92  
 10/05/92  
 10/21/92  
 03/09/93  
 03/17/93

**DRAINAGE AREA MAP**

Sheet No.



C6

DETENTION SUMMARY			
POND	STORAGE (CU FT)	DEPTH (FT)	RELEASE RATE (CFS)
A	3.240	3'	7.5
B	3.840	3'	4.0
C	4.400	3'	5.0
D	19.335	3'	7.1
TOTALS	30.815		23.6

TOTAL STORAGE REQUIRED : 30.815 CU FT  
 TOTAL STORAGE PROVIDED : 32.780 CU FT

**INLET DESIGN**

AC ACREAGE  
 O 100 CFS

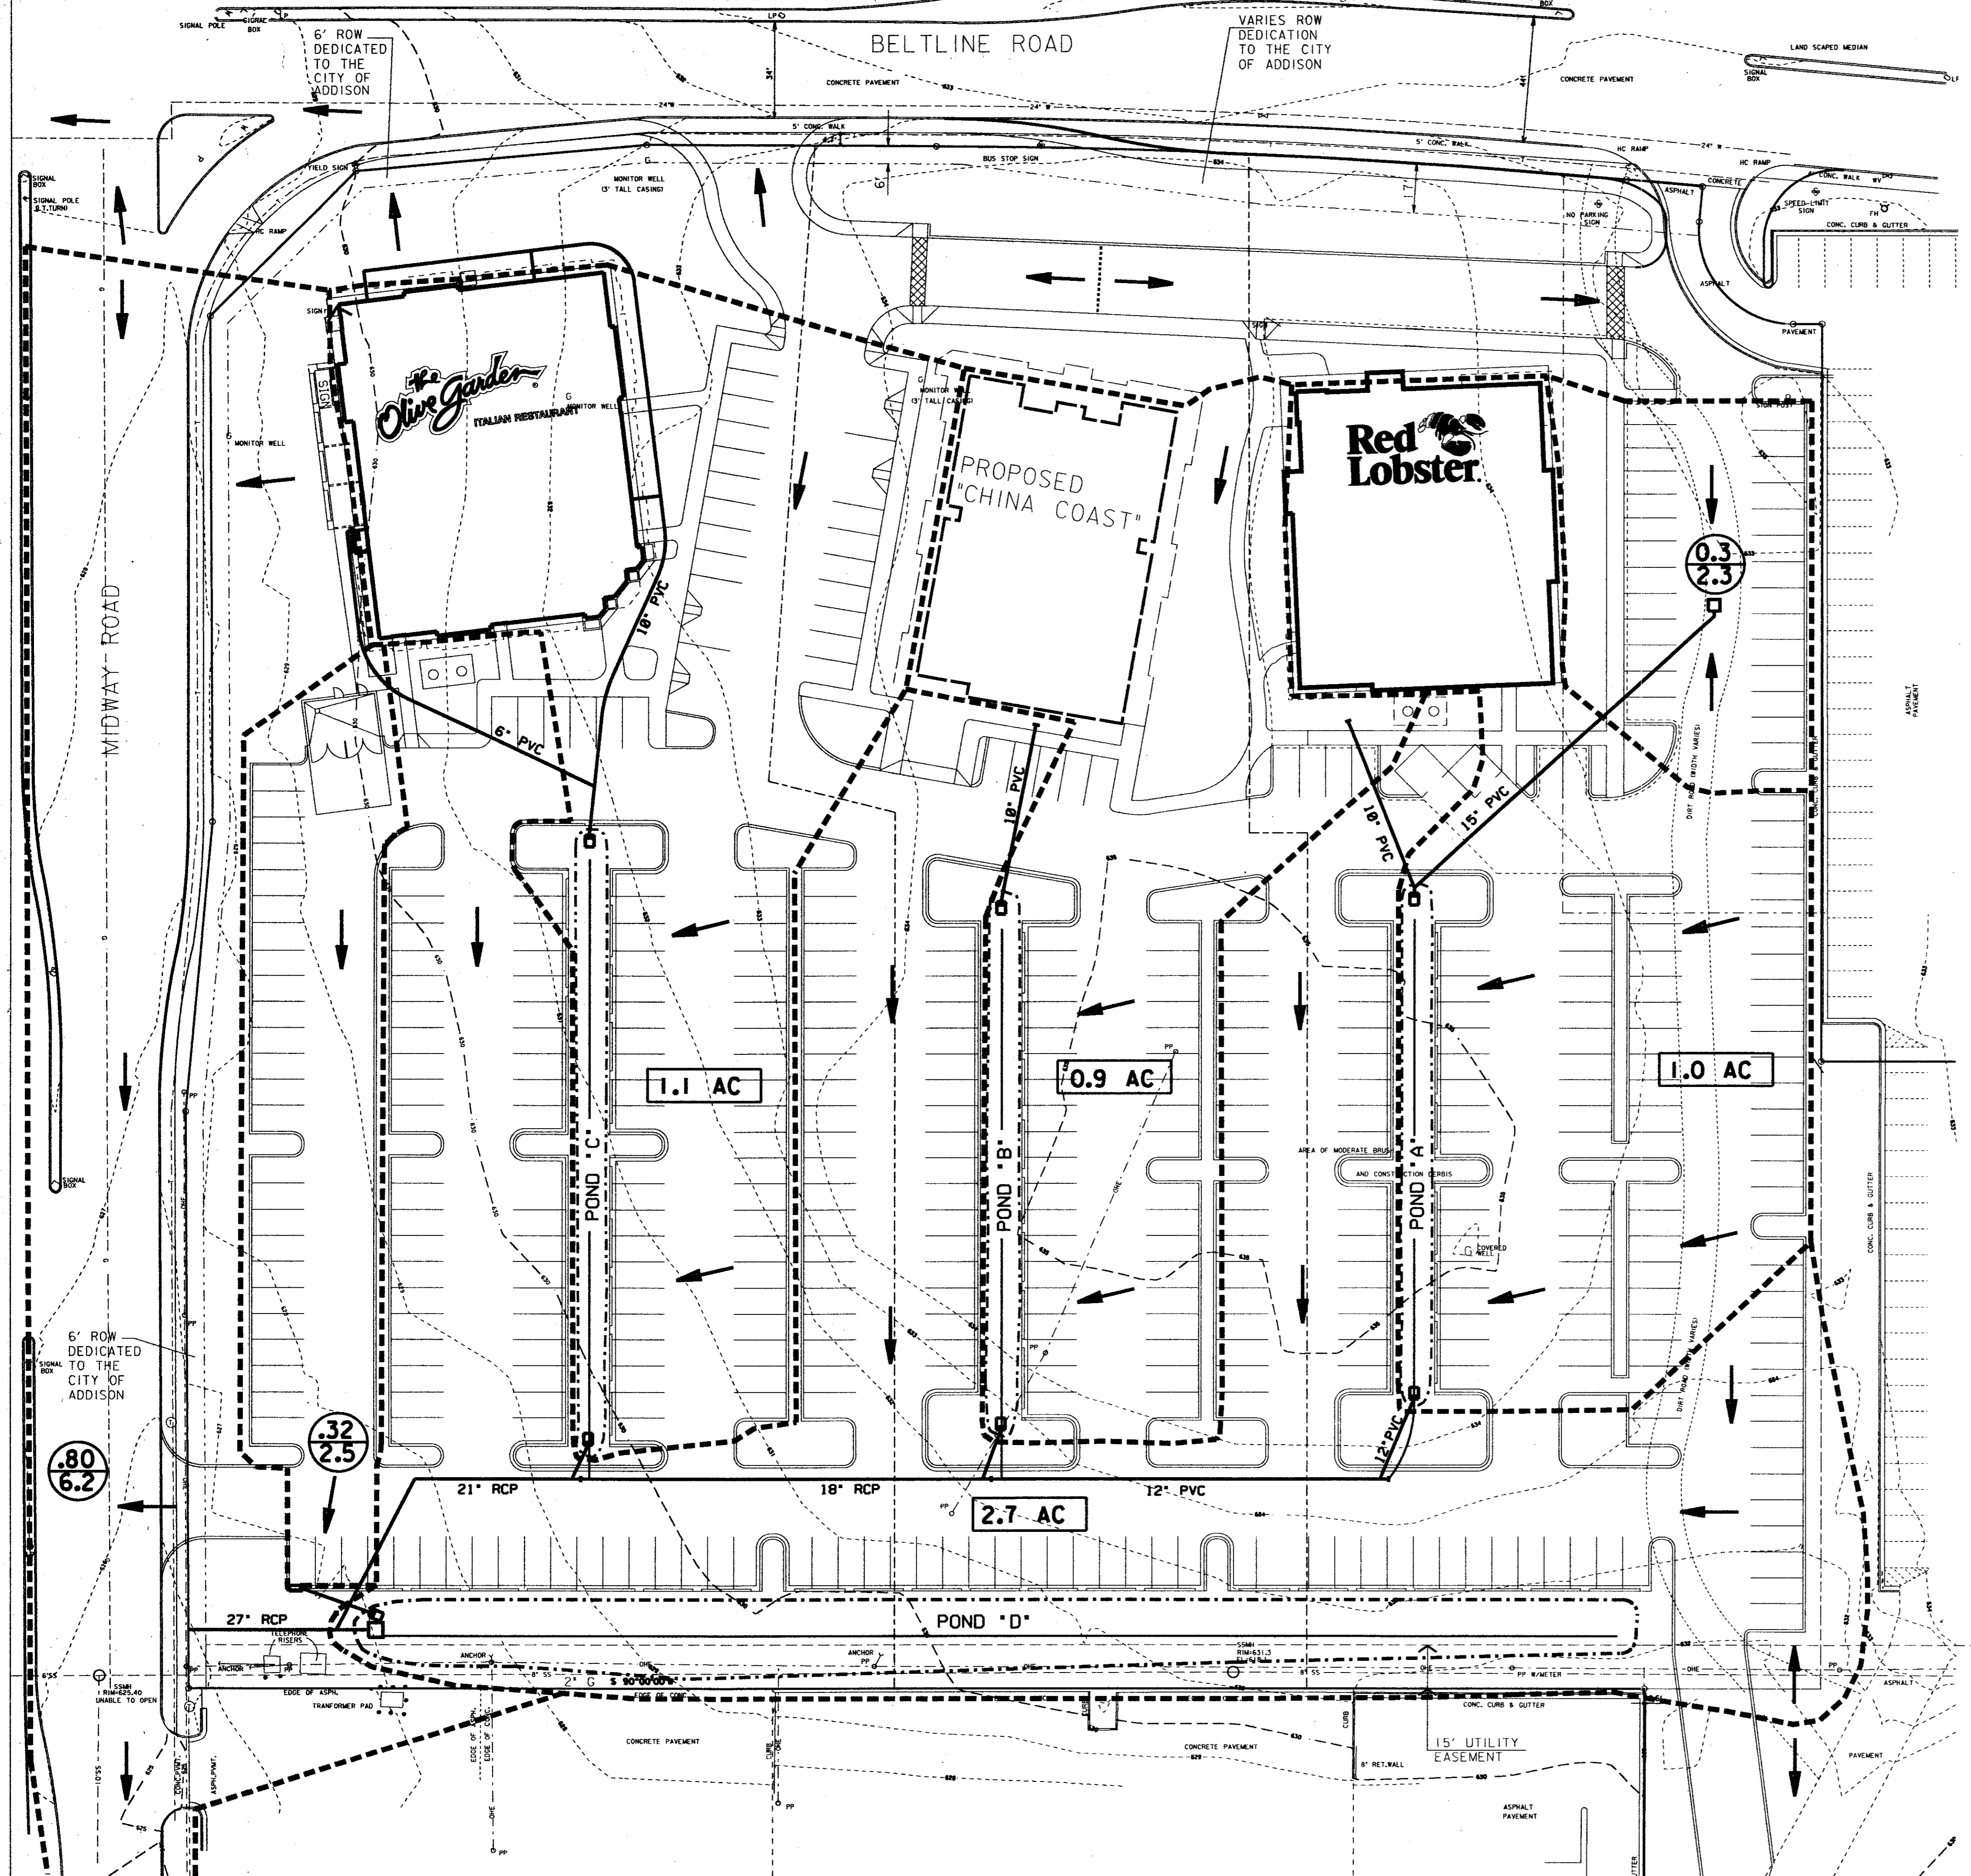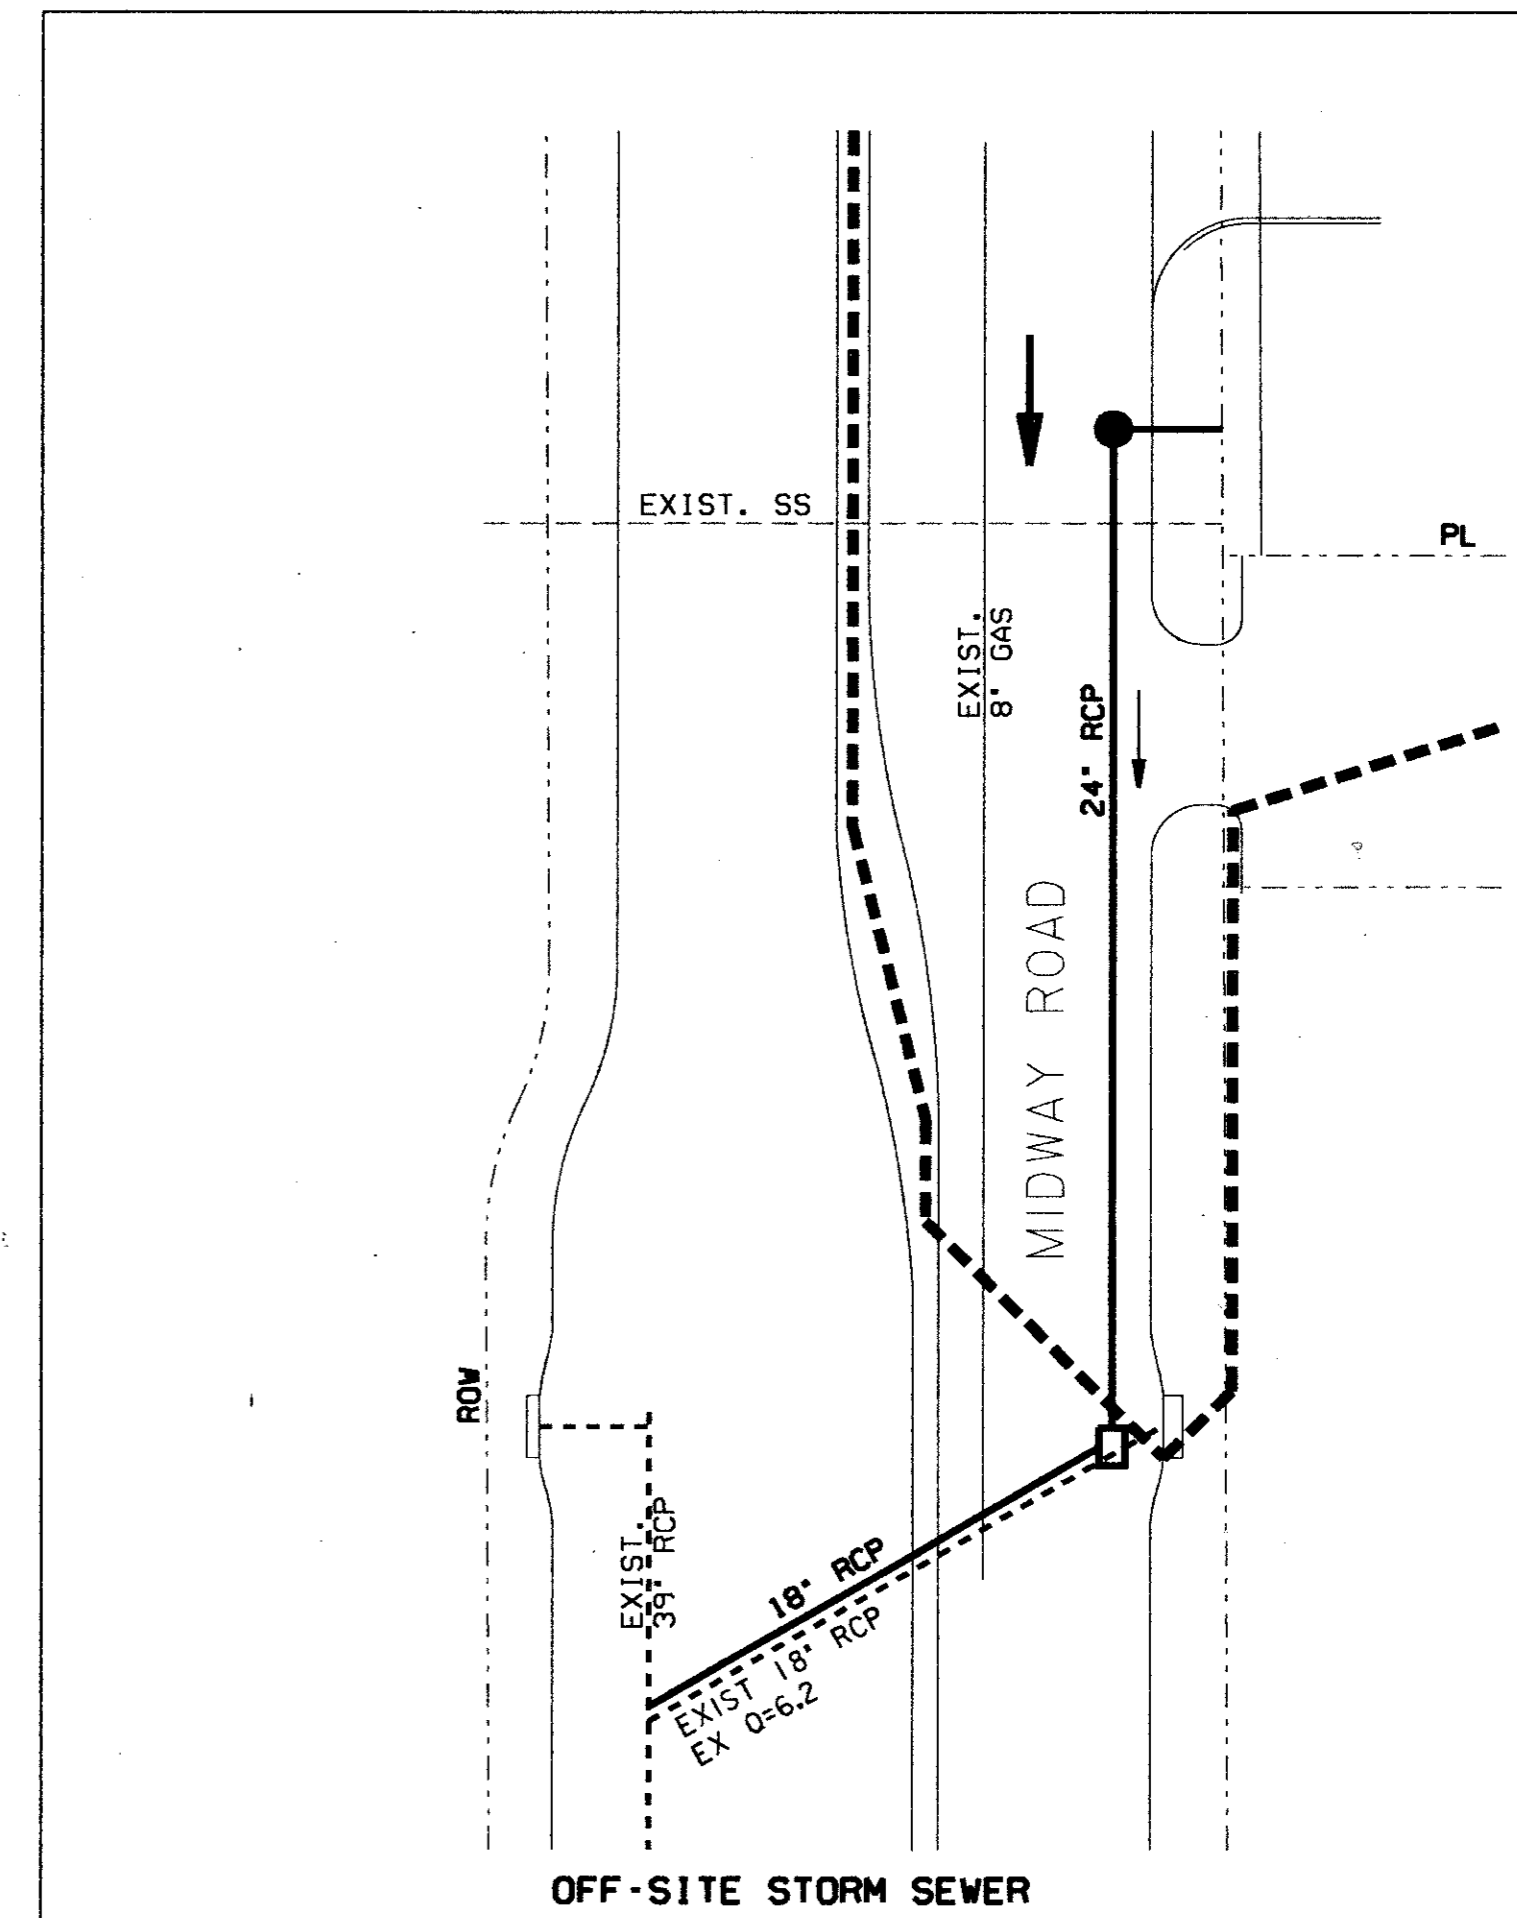

RANDOLPH W. CLENDENEN  
 VOL.86250 PG.2057  
 D.R.D.C.


RSL CONSTRUCTION CO.  
 VOL.78233 PG.737  
 D.R.D.C.

BELTWAY OFFICE PARK  
 TRACT VII  
 VOL.78157 PG.838  
 D.R.D.C.

BELTWAY CONSTRUCTION INC.  
 VOL.88098 PG.1549  
 D.R.D.C.



**"AS BUILT"**

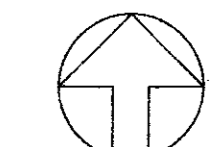

1" = 30'-0"

The construction of this Plan was completed according to the design.

**HUITT - ZOLLARS**

3131 MCKINNEY AVENUE/SUITE 600  
 DALLAS, TEXAS/214-871-3311