


ARCHITECTS
 VAN LOM /
 EDWARDS
 A.I.A., P.C.

S.E. CORNER OF BELTLINE ROAD
 AND MIDWAY ROAD
 ADDISON, TEXAS

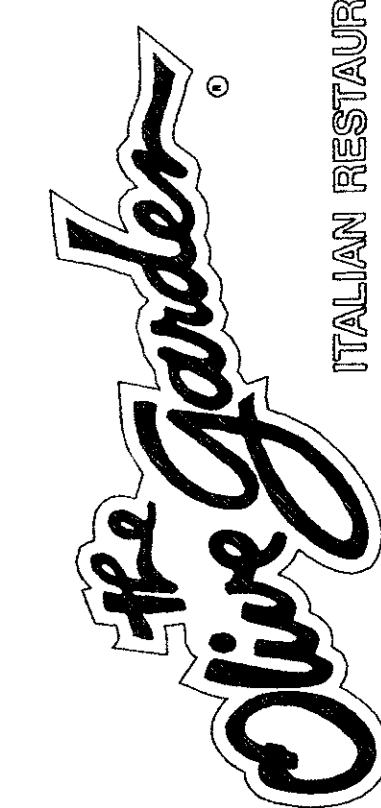


ITALIAN RESTAURANT



Job No. 1498-01
 Date: 7/17/92
 Rev: 7/28/92
 10/05/92
 10/21/92
 03/09/93
 03/17/93

STORM SEWER PLAN


Sheet No.
 C7

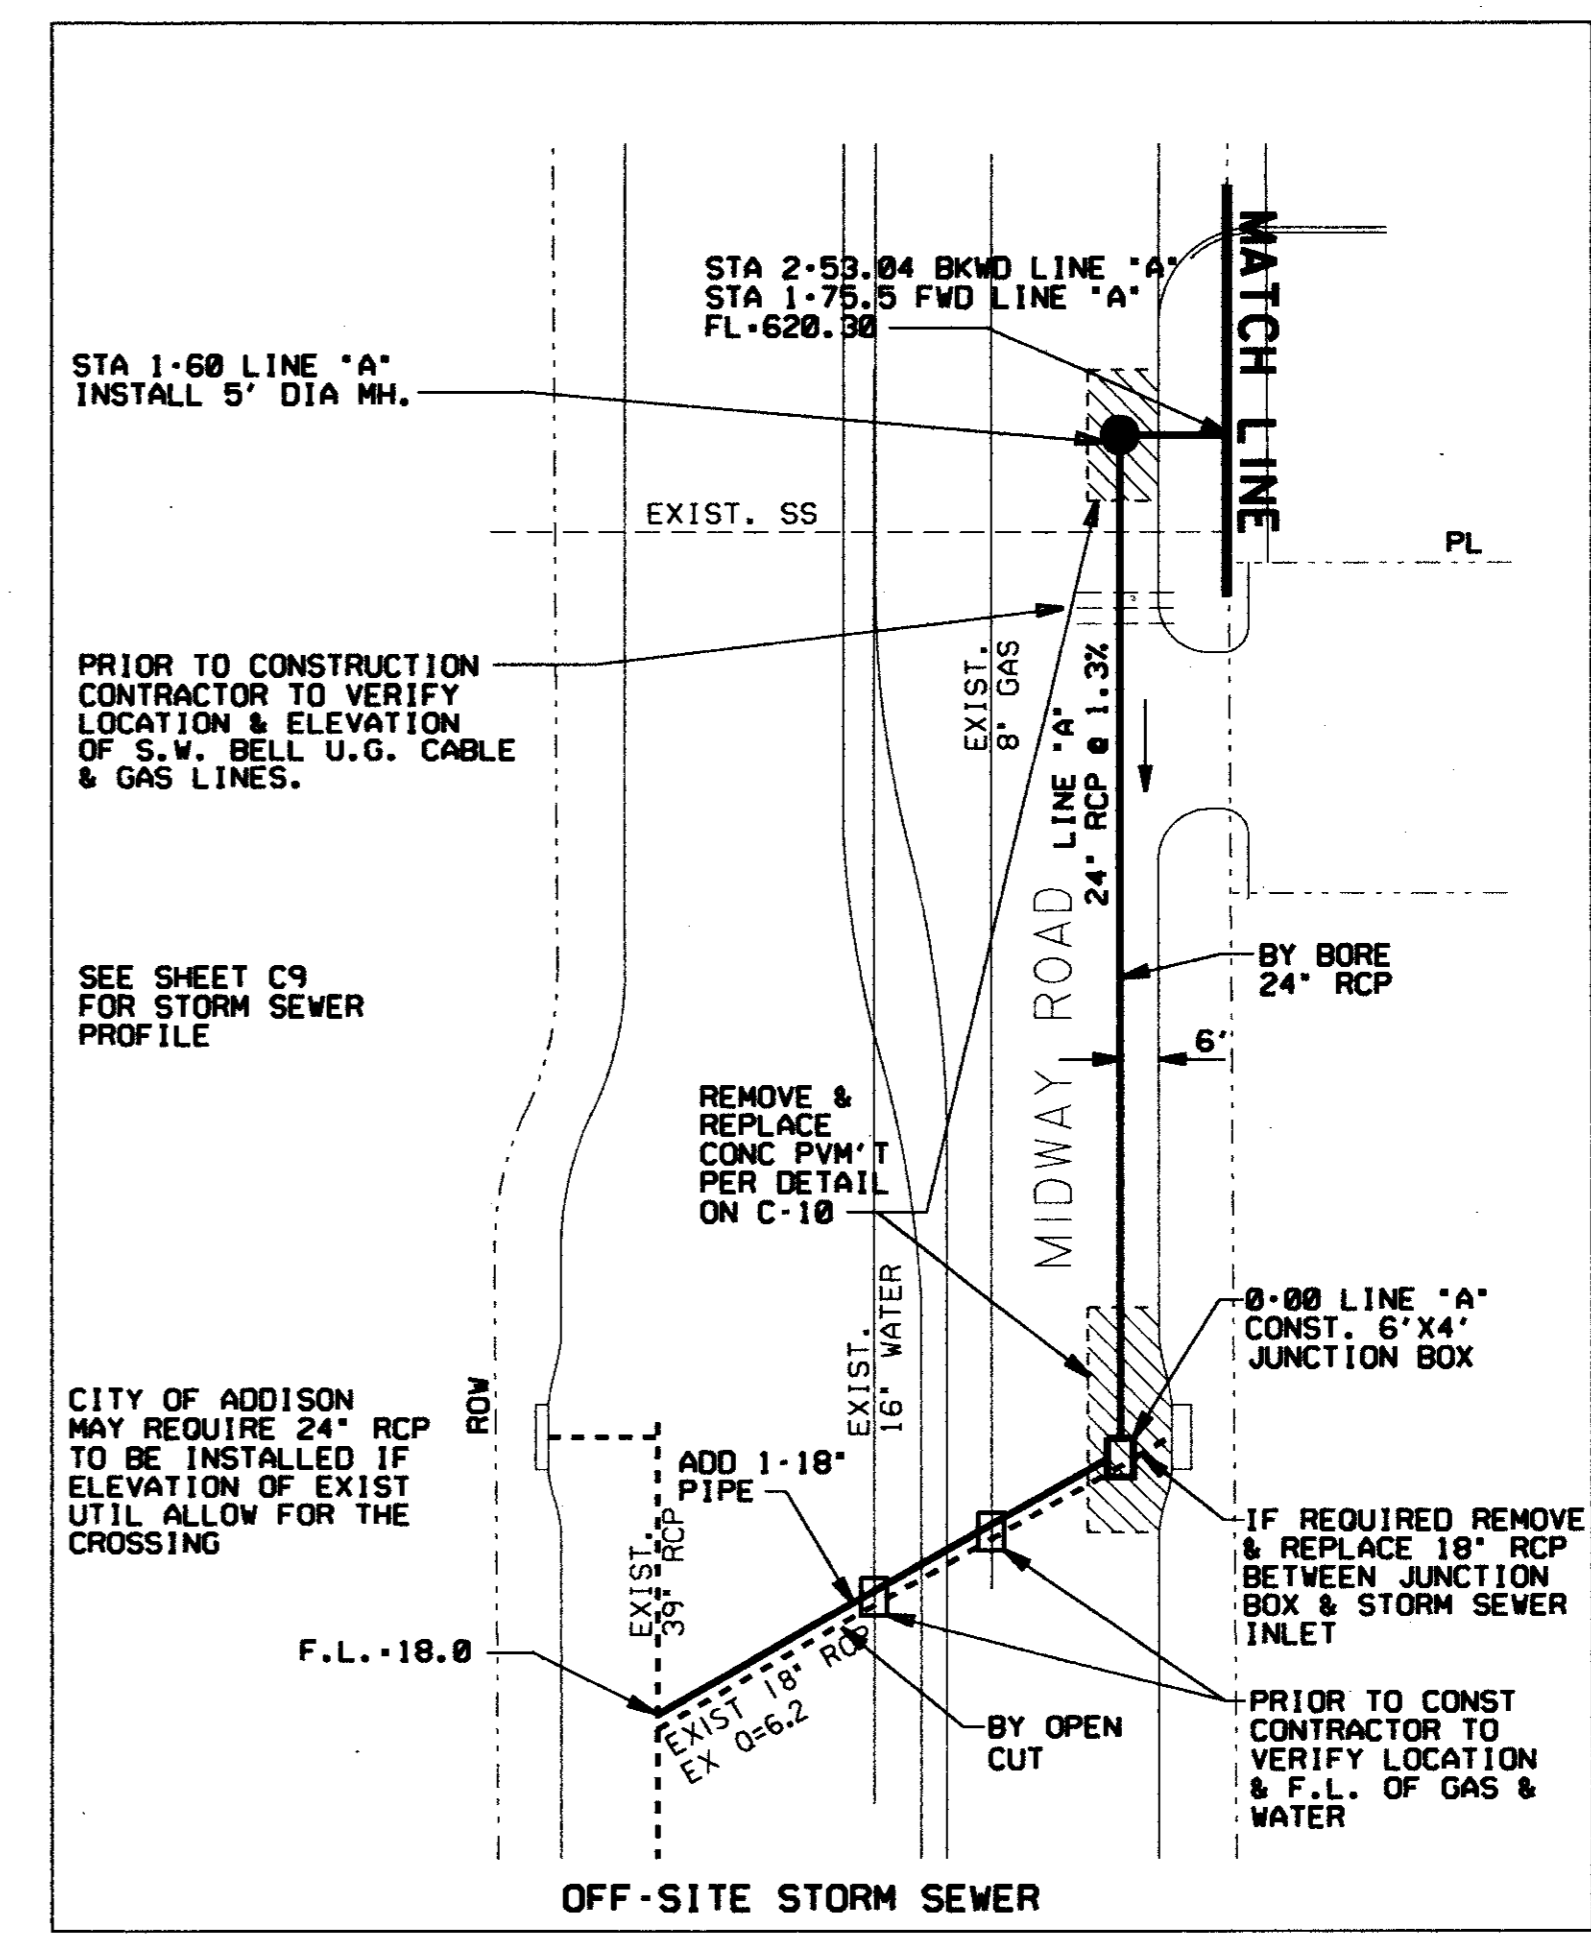

BELTWAY CONSTRUCTION INC.
 VOL. 88098 PG. 1549
 D.R.D.C.

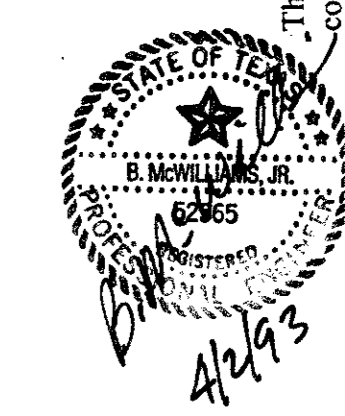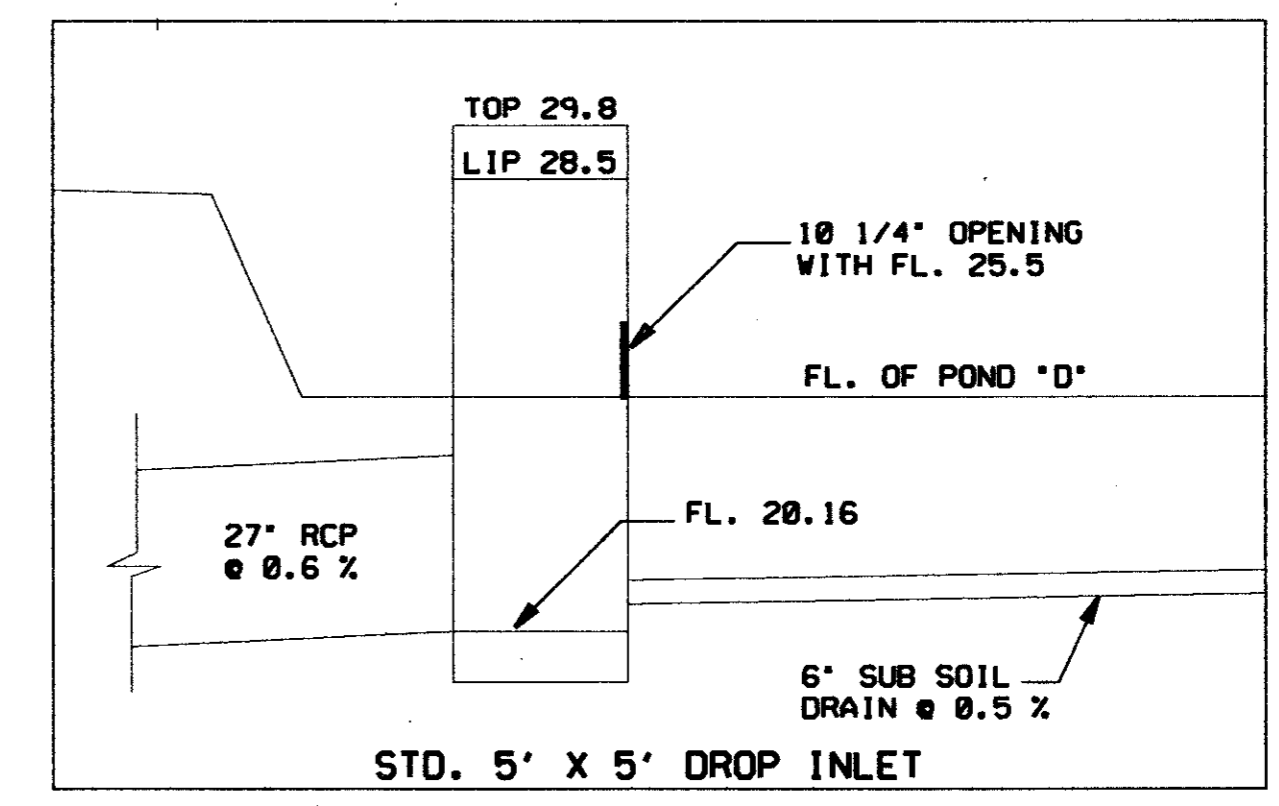


The construction of this Plan was completed according to the design.

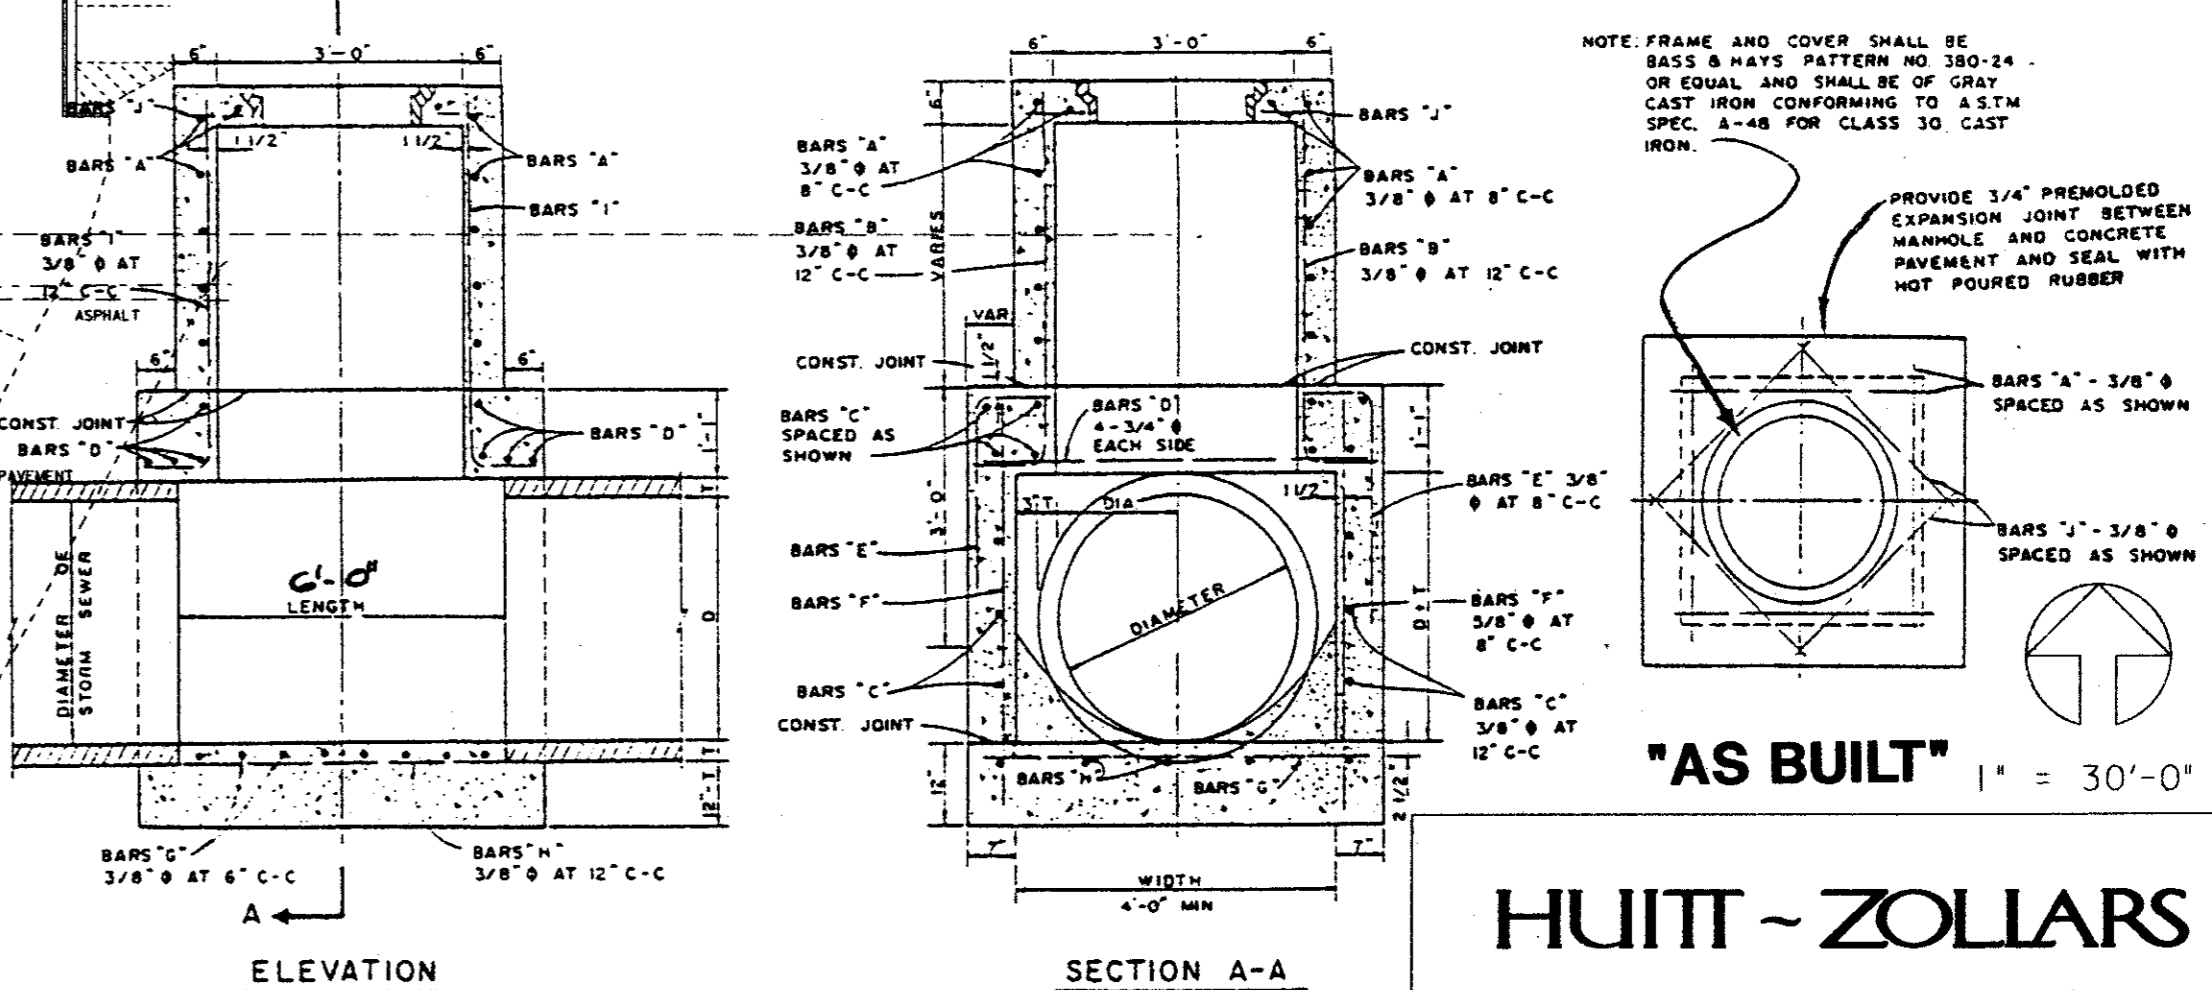

"AS BUILT" 1" = 30'-0"

HUITT - ZOLLARS
 3131 MCKINNEY AVENUE/SUITE 600
 DALLAS, TEXAS/214-871-3311

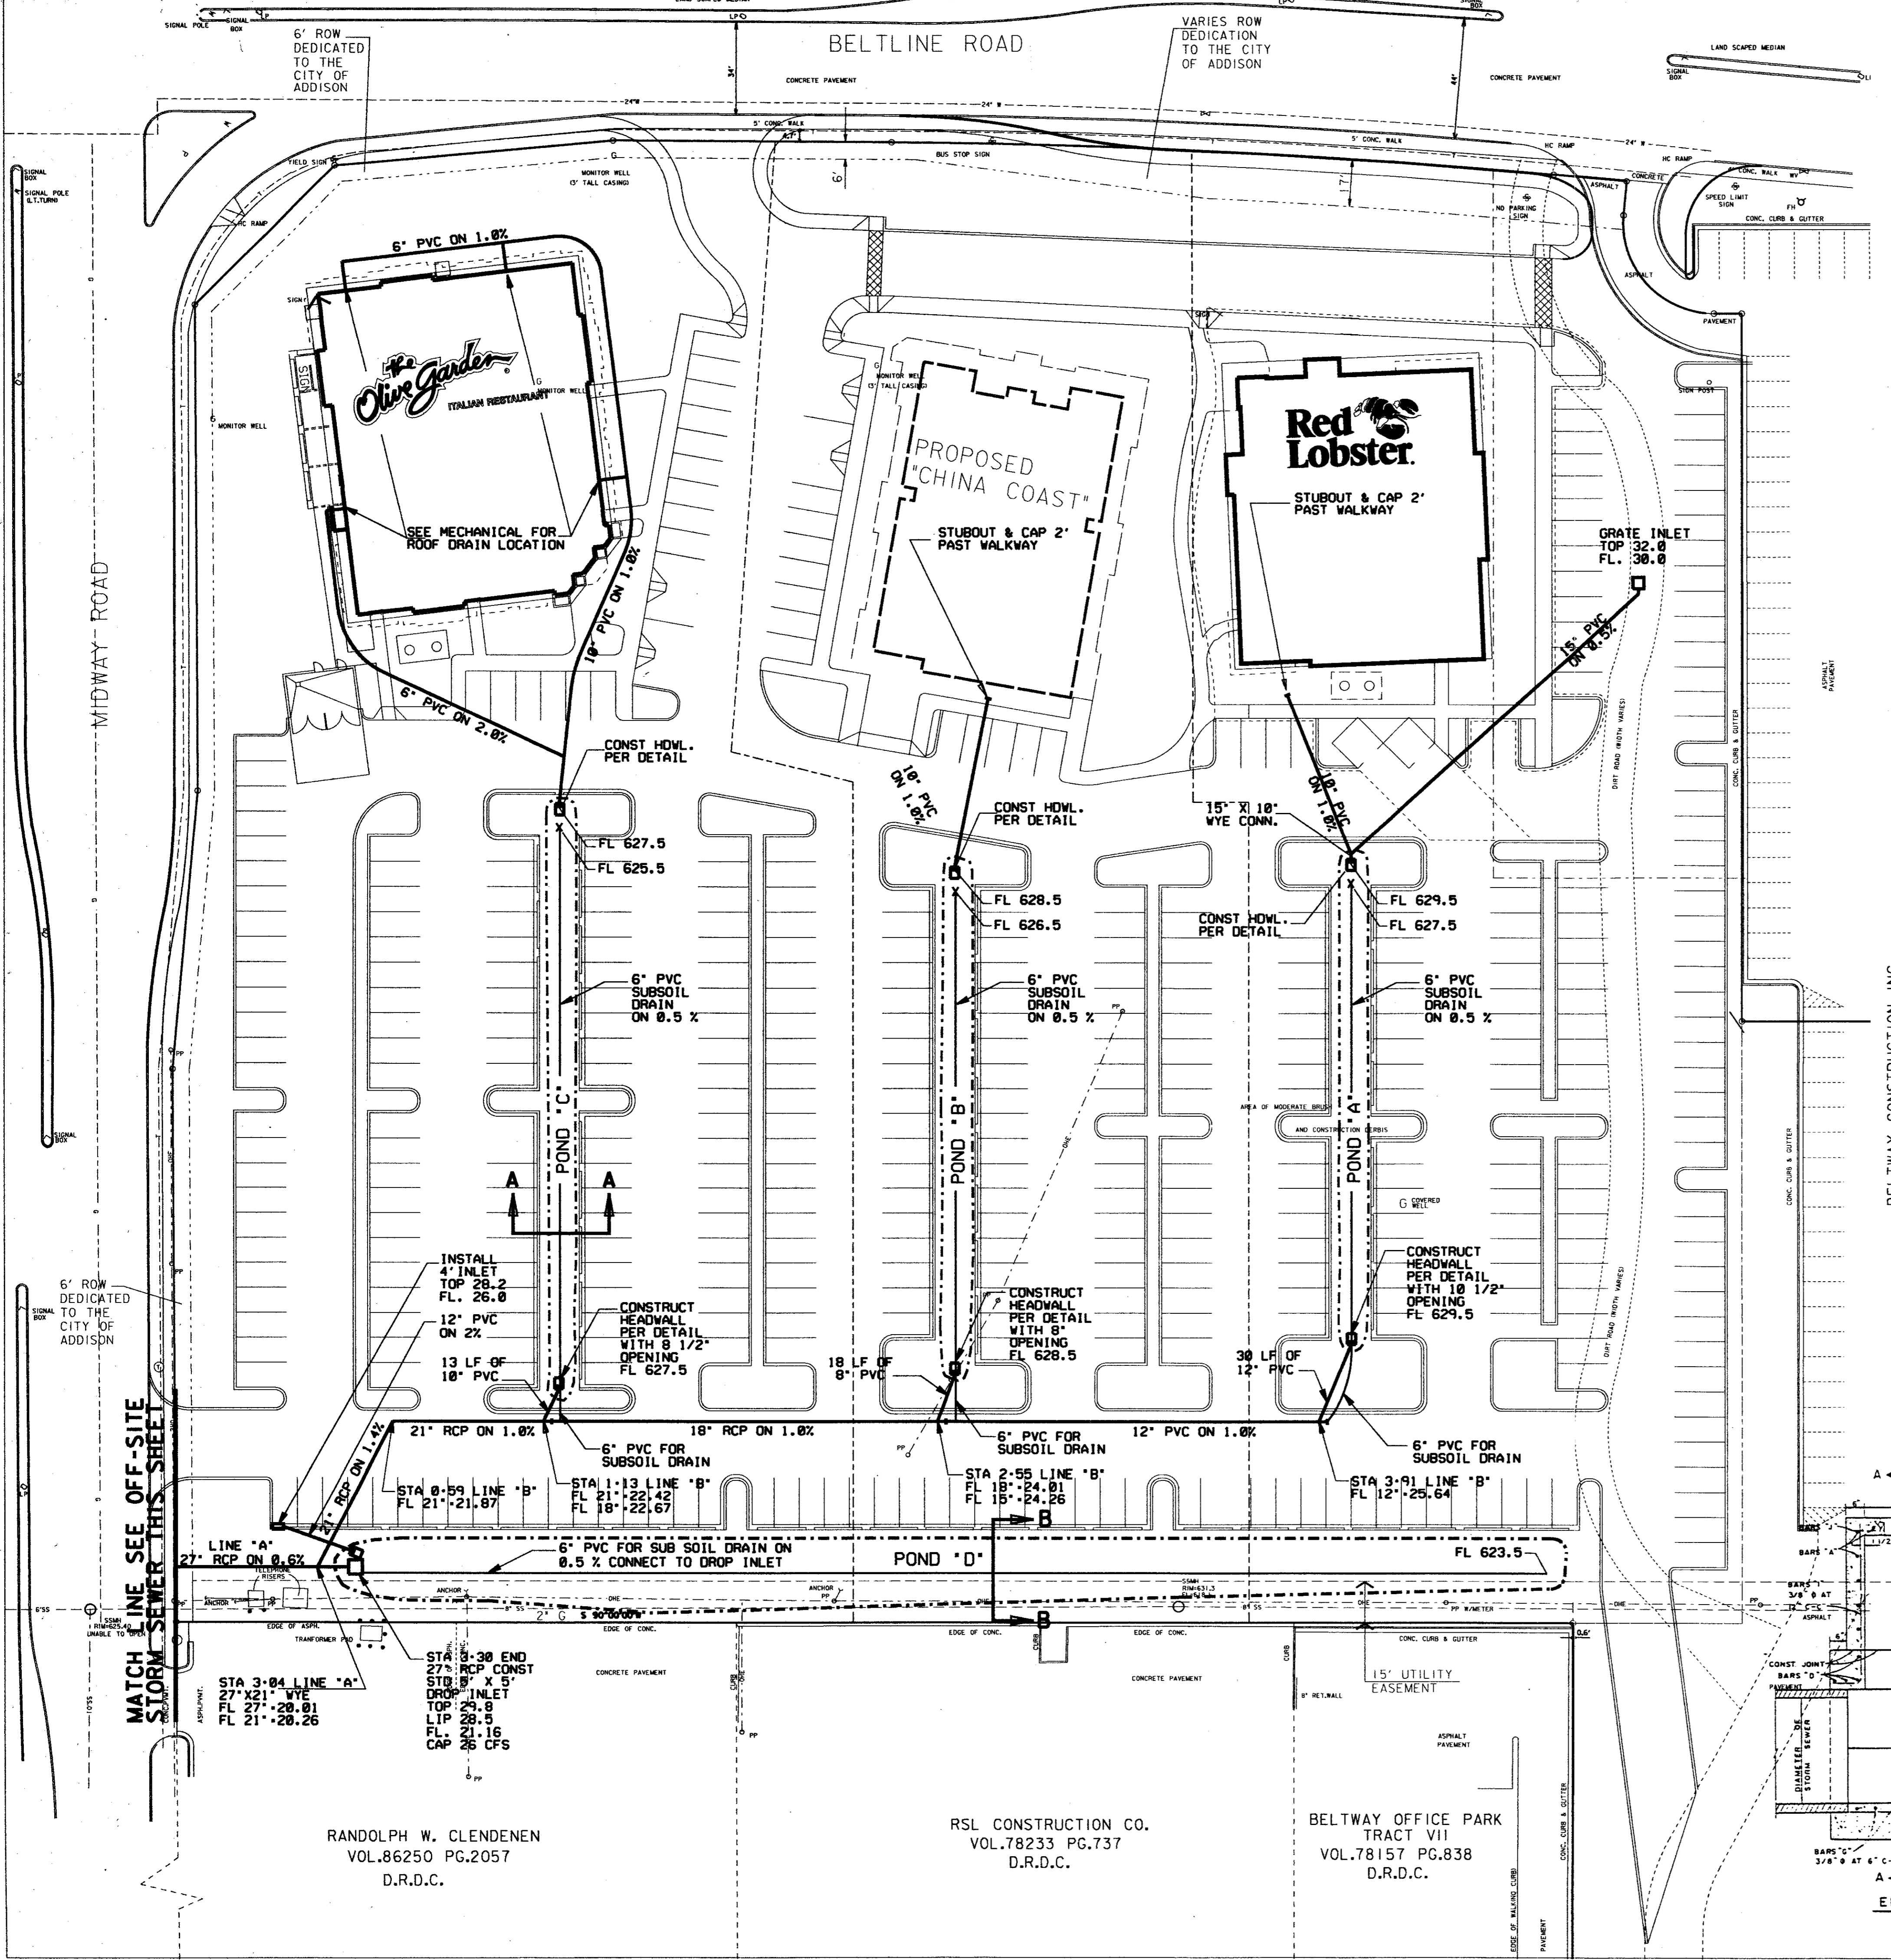

RANDOLPH W. CLENDENEN
 VOL. 86250 PG. 2057
 D.R.D.C.

RSL CONSTRUCTION CO.
 VOL. 78233 PG. 737
 D.R.D.C.

BELTWAY OFFICE PARK
 TRACT VII
 VOL. 78157 PG. 838
 D.R.D.C.

TYPE B STORM SEWER MANHOLE @ 100 L.S.