


AS BUILT

PROFILE SHEET						
THE OLIVE GARDEN - ITALIAN RESTAURANT						
WATER UTILITIES DEPARTMENT						
HUITT - ZOLLARS, INC./ CONSULTING ENGINEERS 3131 MCKINNEY AVE./SUITE 600/DALLAS, TEXAS 75204 (214) 871-3311						
CITY OF ADDISON, TEXAS						
DESIGN	DRAWN	CHECKED	SCALE	DATE	FILE	NUMBER
M.M.	A.B.		H 1"=40' V 1"=6'	JULY 92		C9

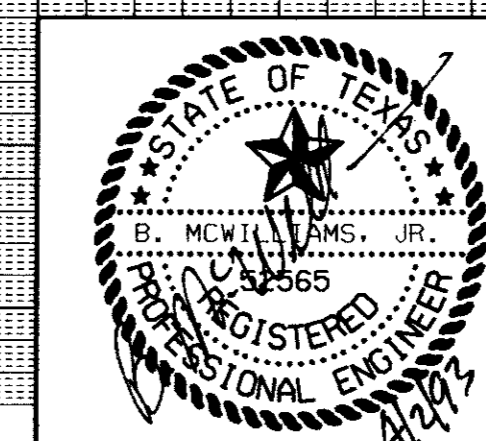

The construction of this Plan was completed according to the design.