


TOWN OF ADDISON  
DALLAS COUNTY, TEXAS  
PRIVATE IMPROVEMENTS OF  
WATER, SANITARY SEWER, PAVING AND DRAINAGE FACILITIES TO SERVE  
VICTORIA STATION  
LOT 1R

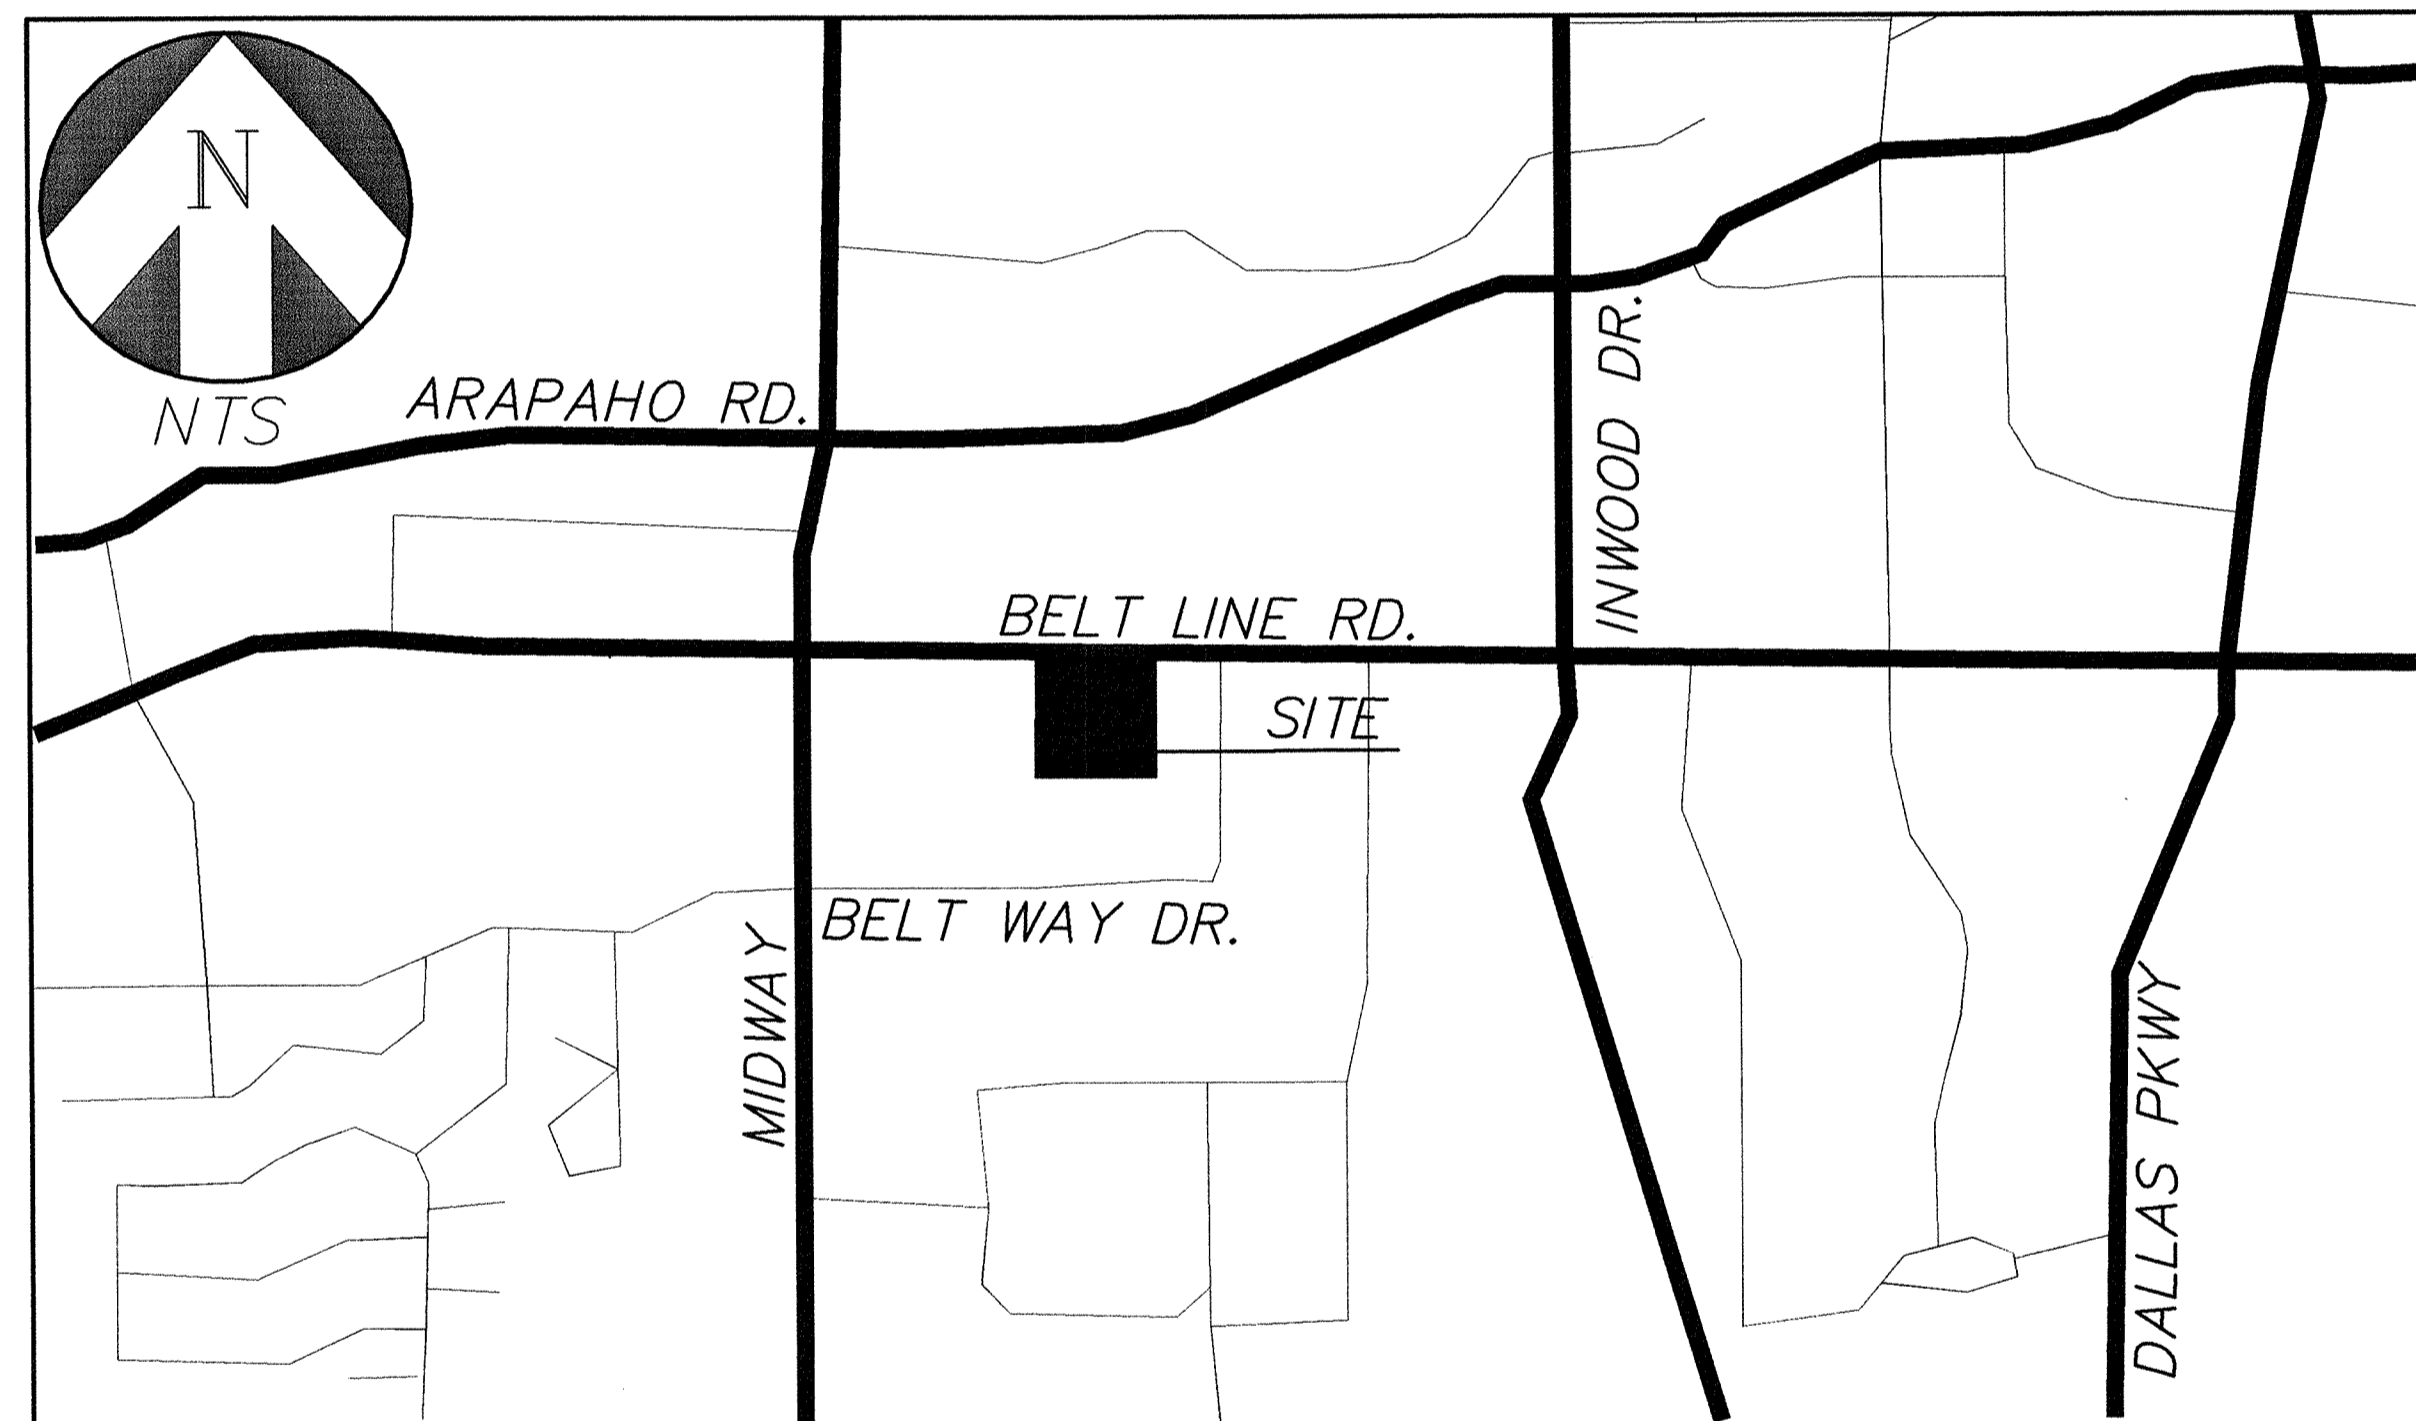


LOCATION MAP  
OCTOBER 2007

ADDISON PUBLIC WORKS FILE = PW# 2007-006

INDEX OF SHEETS

SHT NO.	DESCRIPTION
--	COVER SHEET
--	FINAL PLAT
C1.	DEMO PLAN
C2.	SITE AND DIMENSIONAL CONTROL PLAN
C3.	UTILITY PLAN
C4.	GRADING PLAN
C5.	EROSION CONTROL PLAN
C6.	DRAINAGE PLAN & DRAINAGE CALCULATIONS
C7.	PAVING PLAN
C8.	TRAFFIC CONTROL PLAN
L1.	LANDSCAPE PLAN
L2.	IRRIGATION PLAN

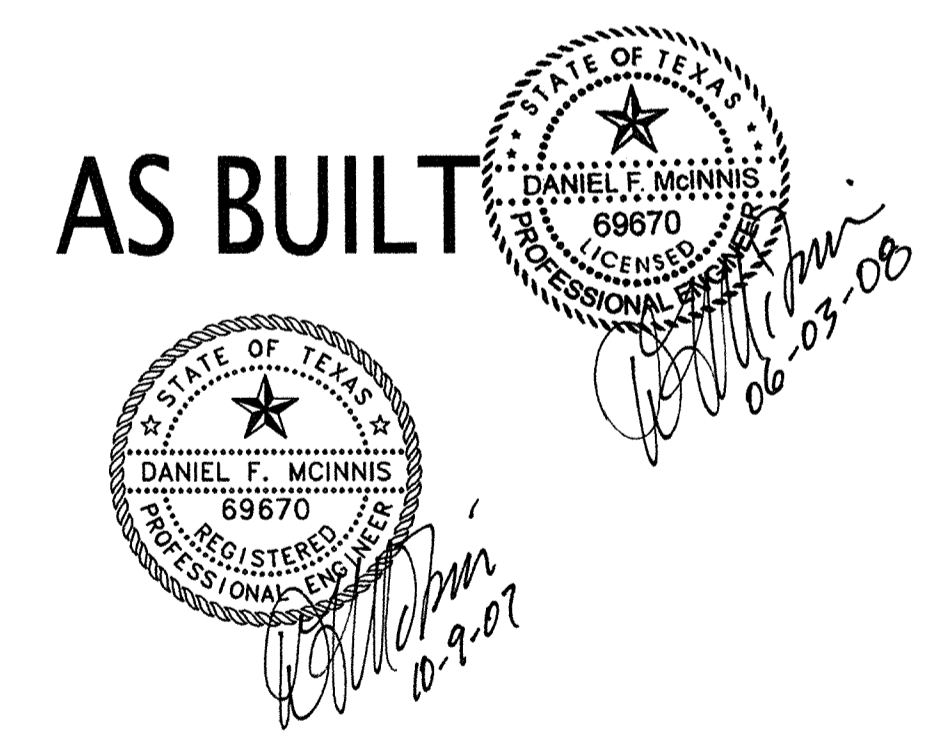

**McInnis Land Consultants L.L.C.**  
108 W EIGHTH STREET, SUITE 300  
FORT WORTH, TEXAS 76102  
OFFICE: 817-877-4200 FAX: 817-877-4201

**DEVELOPER / OWNER**  
OTB PARTNERS, LTD.  
15280 ADDISON RD., SUITE 301  
ADDISON, TX 75001  
OFFICE: 972-661-1011  
FAX: 972-385-8039

**STAPLES®**  
The Office Superstore  
4400 BELT LINE ROAD  
ADDISON, TEXAS 75244