


NOTE: All Trenching shall be in accordance with O.S.H.A. Trenching Safety Standards.

NOTE: All construction shall be in accordance with City of Dallas Standard Specifications. Contractors shall verify locations of existing Utilities prior to start of Construction.

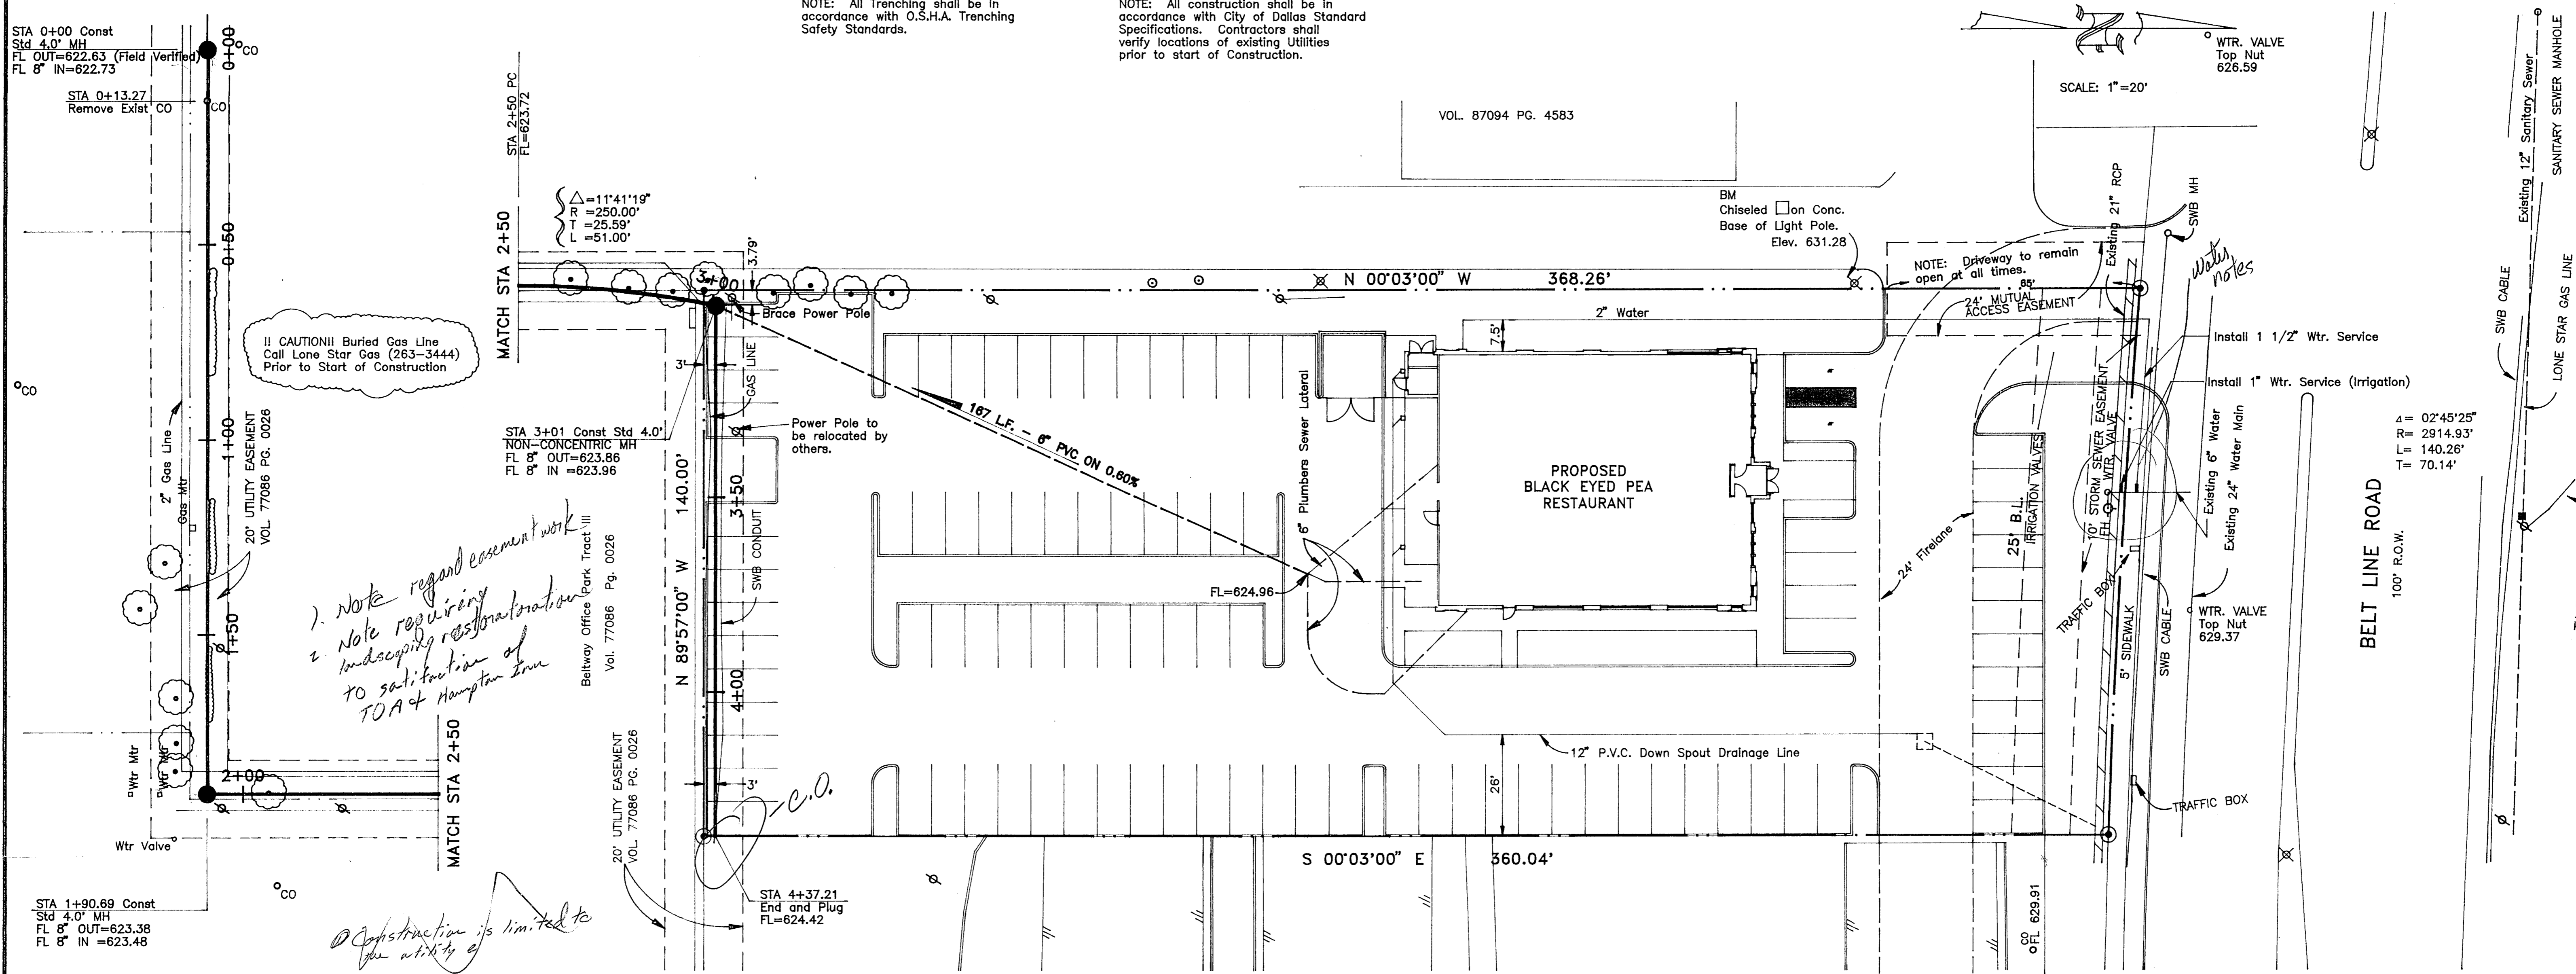

CAUTION!! Buried Gas Line  
Call Lone Star Gas (263-3444)  
Prior to Start of Construction

1. Note regard easement work  
2. Note regarding landscaping restoration to satisfaction of TOA & Hampton Inn

Construction is limited to the utility

SCALE: 1"=20'

Δ = 02°45'25"  
R = 2914.93'  
L = 140.26'  
T = 70.14'

STA 1+90.69 Const  
Std 4.0' MH  
FL 8" OUT=623.38  
FL 8" IN=623.48

STA 0+00 Const  
Std 4.0' MH  
FL OUT=622.83 (Field Verified)  
FL 8" IN=622.73

STA 3+01 Const Std 4.0'  
NON-CONCENTRIC MH  
FL 8" OUT=623.86  
FL 8" IN=623.96

STA 4+37.21  
End and Plug  
FL=624.42

WATER & SANITARY SEWER PLAN					
BLACK-EYED PEA RESTAURANT					
ADDISON, TEXAS					
VILBIG & ASSOCIATES, INC.—CONSULTING ENGINEERS & SURVEYORS					
DESIGN	DRAWN	DATE	SCALE	NOTES	FILE NO.
RB		8/2/91	HOR 1"=20' VER 1"=6'		C-5 C-

PRELIMINARY  
SUBMITTAL  
FOR REVIEW  
DAVID A. VILBIG  
P.E.# 67207