# ADDISON MARKETPLACE ACCESSIBILITY IMPROVEMENTS

### 4530 BELTLINE ROAD, ADDISON, TX.

# ABBREVIATIONS 1.D. - INSIDE DIAMET INSUL. - INSULATION INT. - INTERIOR & - AND JAN. - JANITOR JAN. - JOINT O - AT C - CENTERLINE O - DIAMETER OR AROUND JAN. - JANITOR KIT. - KITCHEN K.O. - KNOCK OUT JAM. - LAMINATE LAWATORY

- ANGLE
- AT
- CENTERLINE
- DIAMETER OR AROUND
- NUMBER OR POUND
- PLATE OR PROPERTY LINE
- SQUARE FOOT
- ACOUSTICAL
- AREA DRAIN
- ADJUSTABLE
- ABOVE FINISH FLOOR

ACOUS. — ACOUSTICAL
A.D. — AREA DRAIN
ADJ. — ADJUSTABLE
A.F.F. — ABOVE FINISH FLOOR
AGGR. — AGGREGATE
ALUM. — ALUMINUM
APPROX. — APPROXIMATELY
ARCH. — ARCHITECTURAL
BD. — BOARD
BLDG. — BUILDING
BM. — BEAM, BENCH MARK
B.O.H. — BOTTOM OF HEADER

BM. - BEAM, BENCH MARK
B.O.H. - BOTTOM OF HEADER

CAB. - CABINET
CER. - CERAMIC
C.J. - CONTROL JOINT
C.I. - CAST IRON
CLG. - CEILING
CLO. - CLOSET
C.M.U. - CONCRETE MASONRY UNIT
COL. - COLUMN
CONC. - CONCRETE
CONN. - CONCRETE
CONN. - CONTRUCTION
CONSTR. - CONSTRUCTION
CONT. - CONTINUOUS
CORR. - CORRIDOR
C.T. - CERAMIC TILE

CONT. — CONTINUOUS
CORR. — CORRIDOR
C.T. — CERAMIC TILE

DBL. — DOUBLE
DEPT. — DEPARTMENT
DET. — DETAIL
DIA. — DIAMETER
DIM. — DIMENSION
DN. — DOWN
DR. — DOOR
DWR. — DOOR
DWR. — DRAWER
DS. — DOWNSPOUT
DWG. — DRAWING

EA. — EACH
E.J. — EXPANSION JOINT
EL. — ELEVATION
ELEC. — ELECTRICAL
ELEV. — ELEVATOR

ELEC. Elev. EMER. EMERGENCY encl. – Enclosure E.P. – ELECTRICAL PANELBOARD EQ. – EQUAL FOUR. - FOURMENT E.W.C. -ELECTRIC WATER COOLER EXIST. — EXISTING
EXPO. — EXPOSED
EXP. — EXPANSION EXT. - EXTERIOR F.A. - FIRE ALARM F.C. - FIRE CODE F.D. - FLOOR DRAIN FIRE EXTINGUISHER FIRE EXTINGUISHER CABINET FINISH GRADE F.H.C. - FIRE HOSE CABINET

F.E. - FIRE EXTINGUISHER
F.E.C. - FIRE EXTINGUISHER CABINET
F.G. - FINISH GRADE
F.H.C. - FIRE HOSE CABINET
FIN. - FINISH
FL - FLOOR
FLASH. - FLASHING
FLUOR. - FLUORESCENT
F.O.C. - FACE OF CONCRETE
F.O.S. - FACE OF STUD
F.P. - FIRE PROTECTION
FT. - FEET OR FOOT
FURR. - FURRING

GA. - GAGE
GALV. - GALVANIZED
G.C. - GENERAL CONTRACTOR
GL. - GLASS
GR. - GRADE
GYP.BD. - GYPSUM BOARD

H.B. - HOSE BIBB
H.C. - HOLLOW CORE
HDWR. - HARDWARE

HDWD. - HARDWOOD

HORIZ. – HORIZONTAL

HR. – HOUR

HT. - HEIGHT

H.M. - HOLLOW METAL

HVAC - HEATING VENTILATION & AIR CONDITIONING

MFR. - MANUFACTURER MISCELLANEOUS MASONRY OPENING MOUNTED MTL. – METAL MULL. - MULLION N.I.C. - NOT IN CONTRACT NO. - NUMBER N.T.S. - NOT TO SCALE ON CENTER OUTSIDE DIAMETER OFFICE OPNG. – OPENING OPP. – OPPOSITE PART. - PARTITION PL. – PLATE PLAS. – PLASTER PLYWD. - PLYWOOD PT. – POINT Q.T. - QUARRY TILE r. – Riser RAD. – RADIUS R.C. – RISILIENT RISILIENT CHANNEL R.D. - ROOF DRAIN R.D.L. – ROOF DRAIN LEADER
REF. – REFER OR REFERENCE
RFGR. – REFRIGERATOR REINF. - REINFORCED REQ'D. -REQUIRED ROOM SOLID CORE SCHED. SECT. SCHEDULE SECTION SQUARE FEET SHEET SPECIFICATION

LIGHT

MECHANICAL

MECHANICAL, ELECTRICAL &

MAX. – MAXIMUM

STD. – STANDARD STOR. STORAGE STRUCT. - STRUCTURAL SUSP. - SUSPENDED OR SUSPENSION T.&G. - TONGUE & GROOVE THK. - THICK
T.O.C. - TOP OF CURB T.O.J. - TOP OF JOIST T.O.P. - TOP OF PLATE T.O.W. - TOP OF WAL TYP. - TYPICAL UNF. - UNFINISHED U.N.O. - UNLESS NOTED OTHERWISE ur. – urinal V. – VINYL VERT. - VERTICAL vest. - vestibule W/ - WITH W.C. - WATER CLOSET

SQUARE

STAINLESS STEEL

W.C. - WATER CLOSET
WD. - WOOD
WDW. - WINDOW
W.I.C. - WALK IN CLOSET
W/O - WITHOUT
WP. - WATERPROOF
WSCT. - WAINSCOT
WT. - WEIGHT
W.W.F. - WELDED WIRE FABRIC
W.W.M. - WELDED WIRE MESH

# **GENERAL NOTES**

### GENERAL NOTES:

1. The contractor shall examine and become familiar with all contract documents, including all specifications in their entirety. The contractor shall survey the project & become familiar with all existing conditions and scope of work. All costs submitted shall be based on a thorough knowledge of work and materials required. Any discrepancy and or uncertainty as to what material or product is to be used shall be verified with the Owner and or Architect.

 All construction shall comply with the 2009 IBC and all applicable state & local codes.

3. Not Used.

4. The Contractor will be solely responsible for construction means, methods, techniques, sequences, and procedures required for safe execution and completion of work, and for initiating, maintaining and supervising all safety precautions and programs in connection with the work.

 Any errors, ommisions or inconsistencies on these drawings or any variations or ambiguities between these drawings and actual site and construction conditions and/or requirements shall be brought to the attention of the Architect, prior to construction.

 In the event a discrepancy is found in the contract documents, the Owner & Architect shall be notified immediately, prior to construction.

 Contractor shall verify all dimensions in the field and notify the Architect of any discrepancies, prior to construction.

 Contractor shall verify all measurements at site and be responsible for accuracy and correctness of same.

 Contractor shall coordinate his work with all other trades, and notify Owner & Architect of any discrepancies.

All work and equipment to be fully guaranteed for one (1)
year from the date of certificate of occupancy for each building.

11. Store materials in spaces designated by Owner.

12. Remove rubbish from premises as often as necessary

 All work and equipment shall be cleaned to the satisfaction of the Owner before turning same over to Owner.

14. Shop drawings shall be submitted to the Architect for approval prior to ordering and installation of any equipment.

15. The Contractor shall pay all fees, give all notices, file all necessary drawings and obtain all permits and certificates or approval required in connection with all work under these contract documents. The Contractor shall comply with all laws, ordinances, rules and regulations of all authorities having jurisdiction.

16. There shall be no deviation from specifications without the written approval of the Owner, Architect and/or Engineer.

 The Contractor shall employ an approved testing laboratory to make all tests for concrete, soil compaction, and welding of steel to insure compliance with plans, standards and codes.

18. Not used.

19. Not Used.

20. Not Used.

21. Not Used

22. Not Used.

23. Not Used.

24. Not Used.

25. Not used

26. Not Used.27. Not Used.

28. Conventional details shall apply where no special detail or section is shown. The Architect will review any detail

clarification submitted by the contractor.

29. Not Used

 Construction shall compy with the Texas Accessibility Standards Construction shall comply with the Americans with Disabilities Act.

31. Contractor shall not proceed with work over previously installed defective materials and/or workmanship.

32. Pipe leaks, construction caused drain and sewer cloggs, water supply stops, wiring fails to carry load, and ductwork separations shall be fully guaranteed for 2 years.

33. Do not scale drawings. Written dimensions take precedence. Also larger scale drawings take precedence over smaller scale drawings.

The G.C. shall see that all subcontractors recieve complete sets of working drawings.

35. The Contractor shall visit the site and verify all existing conditions above and below the ceiling prior to submission of bid.

36. No substitutions are allowed unless "or equal" is stated, then, the landlord/owner shall review and approve substitutions submitted by the G.C. prior to bid.

37. Prior to beginning work, the G.C. shall furnish a construction schedule showing the chronological phases of the work and all related work for the completion of the project.

38. The g.c. shall exercise strict dust control over the job to prevent dirt or dust leaving the job site. main return air ducts will be covered during construction w/ blanket filter material supplied by the contractor, dust & air contamination are to be controlled with temproary partitions which are sealed to prevent dust from entering adjacent leased areas.

39. During the construction period of existing exits, alarms emergency lighting and fire protective devices shall be maintained.

40. All existing items to remain shall be protected throughout construction and cleaned patched and repaired to a "like new" condition.

All existing fire rated assemblies shall be maintened and

All materials installed shall comply with the current

thier integrity shall be preserved.

edition of the local building code.

43. All materials installed shall comply with the current edition of the local building code.

44. Submit samples of all finishes to the owner for approval prior to construction and installation.

45. G.C. to provide owner with two sets of closout documents including: shop drawings, warrenties, owners manuals, submittals and as—built drawinas.


### CONSTRUCTION NOTES:

1. Extend cleanouts though new construction as needed.



Maintain and repair existing utilities during and after construction.

GC to notify Architect of time and date of preconstruction meeting.

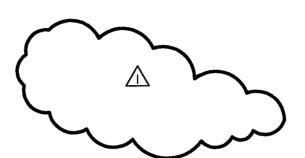

# **CONTACT INFO**

OWNERS REPRESENTATIVE:
CORNER REAL ESTATE SERVICES INC.
4300 N. CENTRAL EXPRESSWAY, SUITE 255
Dallas, Texas 75206
(214) 219-5620
Judy Davis

ARCHITECT:
LESTER YOUNG ARCHITECT
6304 Royal Lane
Dallas, Texas 75230

(214) 455-7878 Les Young lyoungarch@sbcglobal.net

### SHEET INDEX



AO COVER SHEET/GENERAL NOTES

A0.1 ACCESSIBILITY SHEET

A0.2 ACCESSIBILITY SHEET
A0.3 ACCESSIBILITY SHEET

A1 SITE PLAN

A2 ENLARGED PLANS / SECTIONS
A3 ENLARGED PLANS / SECTION

### **PROGRAM**

### PROJECT DATA:

A4 SECTION

1. PROJECT NAME: ADDISTON MARKET

2. PROJECT DESCRIPTION

4. ARCHITECT:

GOVERNING CODES

3. PROJECT LOCATION 4530 BELTLINE ROAD

ADDISON, TEXAS

LESTER YOUNG, ARCHITECT 6304 ROYAL LANE


DALLAS, TEXAS 75230


RETAIL/RESTAURANT

ALL WORK SHALL CONFORM TO ALL APPLICABLE GOVERNING

CODES BUT NOT LIMITED TO THE LATEST EDITION OF THE FOLLOWING: 2009 IBC WITH CITY AMMEND.

2009 IBC WITH CITY AMMEND.
2009 IPC WITH CITY AMMEND.
2006 ICC ELECTRIC CODE
TEXAS ACCESSIBILITY STANDARDS
AMERICANS WITH DISABILITIES ACT

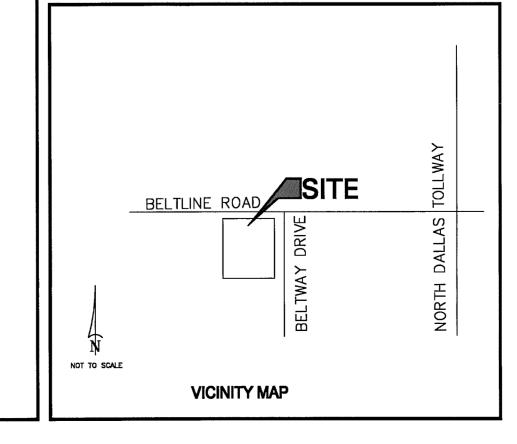

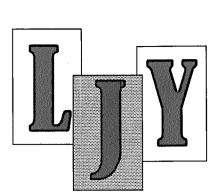

lester j young, architect 6304 royal lane dallas, texas 75230 214.455.7878

No.	Date	Revision
	11.19.12	Revision



NARKET /Floyds Barbar Shop Addison, Texas

**COVER SHEET** 

30 Be

 Project
 |203

 Date
 |0.22.12

 Drawn by
 LY

 Checked by
 LY

## 2010 ADA Standards for Accessible Design for Public Accommodations and Commercial Facilities: Title III

### **CHAPTER 3: BUILDING BLOCKS**

301.1 Scope. The provisions of Chapter 3 shall apply where required by Chapter 2 or where referenced by a requirement in this document.

302 Floor or Ground Surfaces 302.1 General. Floor and ground surfaces shall be stable, firm, and slip resistant and shall comply with

1. Within animal containment areas, floor and ground surfaces shall not be required to be stable, firm, and slip resistant. 2. Areas of sport activity shall not be required to comply with 302.

302.2 Carpet. Carpet or carpet tile shall be securely attached and shall have a firm cushion, pad, or backing or no cushion or pad. Carpet or carpet tile shall have a level loop, textured loop, level cut pile, or level cut/uncut pile texture. Pile height shall be 1/2 inch (13 mm) maximum. Exposed edges of carpet shall be fastened to floor surfaces and shall have trim on the entire length of the exposed edge. Carpet edge trim shall comply with 303.

302.3 Openings. Openings in floor or ground surfaces shall not allow passage of a sphere more than 1/2 inch (13 mm) diameter except as allowed in 407.4.3, 409.4.3, 410.4, 810.5.3 and 810.10. Elongated openings shall be placed so that the long Figure 302.2 Carpet Pile Height dimension is perpendicular to the dominant direction of travel.

dominant direction of travel ---303.1 General. Where changes in level are permitted in floor or ground surfaces, they shall comply with 303. **EXCEPTIONS:** 1. Animal containment areas long dimension perpendicular to shall not be required to comply dominant direction of travel with 303. 2. Areas of sport activity shall not be required to comply with 303.2 Vertical. Changes in level of 1/4 inch (6.4 mm) high maximum shall be permitted to be vertical. Figure 302.3 Elongated Openings in Floor or Ground Surfaces

303.3 Beveled. Changes in level between 1/4 inch (6.4 mm) high minimum and 1/2 inch (13 mm) high maximum shall be beveled with a slope not steeper than 1:2. 303.4 Ramps, Changes in level greater than 1/2 inch (13 mm) high shall be ramped, and shall comply with 405 or 406.

304 Turning Space

304.1 General. Turning space shall comply with 304.

304.2 Floor or Ground Surfaces. Floor or ground surfaces of a turning space shall comply with 302 Changes in level are not permitted. EXCEPTION: Slopes not steeper than 1:48 shall be permitted.

304.3 Size. Turning space shall comply with 304.3.1 or 304.3.2.

304.3.1 Circular Space. The turning space shall be a space of 60 inches (1525 mm) diameter minimum The space shall be permitted to include knee and toe clearance complying with 306.

304.3.2 T-Shaped Space. The turning space shall be a T-shaped space within a 60 inch (1525 mm) square minimum with arms and base 36 inches (915 mm) wide minimum. Fach arm of the T shall be clear of obstructions 12 inches (305 mm) minimum in each direction and the base shall be clear of obstructions 24 inches (610 mm) minimum. The space shall be permitted to include knee and toe

clearance complying with 306 only at the end of either the base or one arm. 304.4 Door Swing. Doors shall be permitted to swing into turning spaces. 305 Clear Floor or Ground Space 305.1 General. Clear floor or ground space shall comply with 305. 24 min 305.2 Floor or Ground Surfaces. Floor or ground surfaces of a clear floor or ground space shall comply with 302. Changes in level are not permitted. 36 min EXCEPTION: Slopes not steeper than 1:48 shall be permitted. 305.3 Size. The clear floor or ground space shall be Figure 304.3.2 T-Shaped Turning Space 30 inches (760 mm) minimum by 48 inches (1220

floor or around space shall be permitted to include knee and toe clearance complying with 306. 305.5 Position. Unless otherwise specified, clear floor or ground

305.4 Knee and Toe Clearance. Unless otherwise specified, clear


mm) minimum.

space shall be positioned for either forward or parallel approach to Figure 305.3 Clear Floor or Ground Space

provided in accordance with 305.7.1 and

305.6 Approach. One full unobstructed side of the clear floor or ground space shall adjoin an accessible route or adjoin another clear floor or ground space. 305.7 Maneuvering Clearance. Where a clear floor or ground space is located in an alcove or otherwise confined on all or part of three sides, additional maneuvering clearance shall be 30 min

parallel 305.7.1 Forward Approach. Alcoves shall be 36 Figure 305.5 Position of Clear Floor or Ground Space 308.3 Side Reach inches (915 mm)wide minimum where the depth exceeds 24 inches (610 mm).

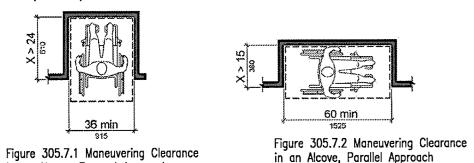

in an Alcove, Forward Approach 305.7.2 Parallel Approach. Alcoves shall be 60 inches (1525 mm) wide minimum where the depth exceeds 15 inches (380 mm).

306.1 General. Where space beneath an element is included as part of clear floor or ground space or turning space, the space shall comply with 306. Additional space shall not be prohibited beneath an element but shall not be considered as part of the clear floor or ground space or turning space.

306.2.1 General. Space under an element between the finish floor or ground and 9 inches (230 mm) above the finish floor or ground shall be considered toe clearance and shall comply with 306.2.

306.2.2 Maximum Depth. Toe clearance shall extend 25 inches (635 mm) maximum under an element. 306.2.3 Minimum Required Depth. Where toe clearance is required at an element as part of a clear floor space, the toe clearance shall extend 17 inches (430 mm) minimum under the element.

306.2.4 Additional Clearance. Space extending greater than 6 inches (150 mm) beyond the available knee clearance at 9 inches (230 mm) above the finish floor or ground shall not be considered toe clearance.

306.2.5 Width. Toe clearance shall be 30 inches (760 mm) wide minimum.

306.3.1 General. Space under an element between 9 inches (230 mm) and 27 inches (685 mm) above the finish floor or ground shall be considered knee clearance and shall comply with 306.3.

306.3.2 Maximum Depth. Knee clearance shall extend 25 inches (635 mm) maximum under an element at 9 inches (230 mm) above the Figure 306.2 Toe Clearance

25 max /

Figure 307.2 Limits of Protruding Objects

X > 12

Figure 307.3 Post-Mounted Protruding Objects

Figure 306.3 Knee Clearance

306.3.3 Minimum Required Depth. Where knee clearance is required under an element as part of a clea floor space, the knee clearance shall be 11 inches (280 mm) deep minimum at 9 inches (230 mm) above the finish floor or ground, and 8 inches (205 mm) deep minimum at 27 inches (685 mm) above

306.3.4 Clearance Reduction. Between 9 inches (230 mm) and 27 inches (685 mm) above the finish or ground, the knee clearance shall be permitted to reduce at a rate of 1 inch (25 mm) in depth for each 6 inches (150 mm) in height.

306.3.5 Width. Knee clearance shall be 30 inches (760 mm) wide minimum.

307 Protruding Objects 307.1 General. Protruding objects shall comply with 307. 307.2 Protrusion Limits. Objects with leading edges more than 27 inches (685 mm) and not more than 80 inches (2030 mm) above the finish floor or ground shall protrude 4

inches (100 mm) maximum horizontally into 11 min EXCEPTION: Handrails shall be permitted to protrude 4 1/2 inches (115 mm) maximum.

307.3 Post-Mounted Objects. Free-standing objects mounted on posts or pylons shall overhang circulation paths 12 inches (305 mm) maximum when located 27 inches (685 mm) minimum and 80 inches (2030 mm) maximum above the finish floor or ground. Where a sign or other obstruction is mounted between posts or pylons and the clear distance between the posts or pylons is greater than 12 inches (305 mm), the lowest edge of such sign or obstruction shall be 27 inches (685 mm) maximum or 80 inches (2030 mm) minimum above the finish floor or ground. EXCEPTION: The sloping portions of handrails serving stairs and ramps shall not be required to comply with 307.3.

307.4 Vertical Clearance. Vertical clearance shall be 80 inches (2030 mm) high minimum. Guardrails or other barriers shall be provided where the vertical clearance is less than 80 inches (2030 mm) high. The leading edge of such guardrail or barrier shall be located 27 inches (685 mm) maximum above the finish floor or

EXCEPTION: Door closers and door stops shall be permitted to be 78 inches (1980 mm) minimum above the finish floor or ground.

307.5 Required Clear Width. Protruding objects shall not reduce the clear width required for accessible routes. 308 Reach Ranges 308.1 General. Reach

ranges shall comply with 308. 308.2 Forward Reach. 308.2.1 Unobstructed. Where a forward reach is unobstructed, the high forward reach shall be 48 inches [ Children's Reach Ranges (1220 mm) maximum and the low Forward or Side Reach High (maximum) Low (minimum) forward reach shall be 15 inches (380 mm) minimum above the finish floor or ground.

Ages 3 and 4 40 in (1015 mm) 18 in (455 mm) | part of an accessible route. Ages 5 through 8 44 in (1120 mm) 16 in (405 mm) Ages 9 through 12

Figure 307.4 Vertical Clearance

Figure 308.2.1 Unobstructed Forward Reach Figure 308.2.2 Obstructed High Forward Reach 308.2.2 Obstructed High Reach. Where a high forward reach is over an obstruction, the clear floor space shall extend beneath the element for a distance not less than the required reach depth over the obstruction. The high forward reach shall be 48 inches (1220 mm) maximum where the reach depth is 20 inches (510 mm) maximum. Where the reach depth exceeds 20 inches (510 mm), the high forward reach

Minimum maneuvering clearances at shall be 44 inches (1120 mm) maximum and the reach depth shall be 25 inches (635 mm) maximum.

308.3.1 Unobstructed. Where a clear floor or ground space allows a parallel approach to an element and the side reach is unobstructed, the high side reach shall be 48 inches (1220 mm) maximum and the low side clearance. side reach shall be 15 inches (380 mm) minimum above the finish floor or ground.

1. An obstruction shall be permitted between the clear floor or ground space and the element where the depth of the obstruction is 10 inches (255 mm) maximum. 2. Operable parts of fuel dispensers shall be permitted to be 54 inches (1370 mm) maximum measured from the surface of the vehicular way where fuel dispensers are installed on existing curbs.

> 10-24 max / \_10 max\_/

Figure 308.3.2 Obstructed High Side Reach Figure 308.3.1 Unobstructed Side Reach

308.3.2 Obstructed High Reach. Where a clear floor or ground space allows a parallel approach to an element and the high side reach is over an obstruction, the height of the obstruction shall be 34 inches (865 mm) maximum and the depth of the obstruction shall be 24 inches (610 mm) maximum. The high side reach shall be 48 inches (1220 mm) maximum for a reach depth of 10 inches (255 mm) maximum. Where the reach depth exceeds 10 inches (255 mm), the high side reach shall be 46 inches (1170 mm) maximum for a reach depth of 24 inches (610 mm) maximum.

1. The top of washing machines and clothes dryers shall be permitted to be 36 inches (915 mm) 2. Operable parts of fuel dispensers shall be permitted to be 54 inches (1370 mm) maximum measured from the surface of the vehicular way where fuel dispensers are installed on existing curbs.

309.1 General. Operable parts shall comply with 309.

309.2 Clear Floor Space. A clear floor or ground space complying with 305 shall be provided.

309.3 Height. Operable parts shall be placed within one or more of the reach ranges specified in 308.

309.4 Operation. Operable parts shall be operable with one hand and shall not require tight grasping pinching, or twisting of the wrist. The force required to activate operable parts shall be 5 pounds (22.2 N) EXCEPTION: Gas pump nozzles shall not be required to provide operable parts that have an activating force of 5 pounds (22.2 N) maximum.

**CHAPTER 4: ACCESSIBLE ROUTES** 

401.1 Scope. The provisions of Chapter 4 shall apply where required by Chapter 2 or where referenced by a requirement in this document.

402.1 General. Accessible routes shall comply with 402.

192.2 Components. Accessible routes shall consist of one or more of the following components: walking surfaces with a running slope not steeper than 1:20, doorways, ramps, curb ramps excluding the flared sides, elevators, and platform lifts. All components of an accessible route shall comply with the applicable requirements of Chapter 4.

403 Walking Surfaces 403.1 General. Walking surfaces that are a part of an accessible route shall comply with 403.

403.2 Floor or Ground Surface. Floor or ground surfaces shall comply with 302. 403.3 Slope. The running slope of walking surfaces shall not be steeper than 1:20. The cross slope of walking surfaces shall not be steeper than 1:48. 403.4 Changes in Level. Changes in level shall comply with 303.

403.5 Clearances. Walking surfaces shall provide clearances complying with 403.5. EXCEPTION: Within employee work greas, clearances on common use circulation paths shall be permitted to be decreased by work area equipment provided that the decrease is essential to the function of the work being performed.

403.5.1 Clear Width. Except as provided in 403.5.2 and 403.5.3, the clear width of walking surfaces shall be 36 inches (915 mm) minimum. EXCEPTION: The clear width shall be permitted to be reduced to 32 inches (815 mm) minimum for a length of 24 inches (610 mm) maximum provided that reduced width segments are separated by segments the latch side of a doorway

that are 48 inches (1220 mm) long minimum and 36 inches (915 mm) wide minimum. 403.5.2 Clear Width at Turn. Where the accessible route makes a 180 degree turn around an element which is less than 48 inches (1220 mm) wide, clear width shall be 42 inches (1065 mm) minimum approaching the turn, 48 inches (1220 mm) minimum at the turn and 42 inches (1065 mm) minimum leaving the turn. EXCEPTION: Where the clear width at the turn is 60 inches (1525 mm) minimum compliance with Figure 403.5.1 Clear Width of an Accessible Route 403.5.2 shall not be required.

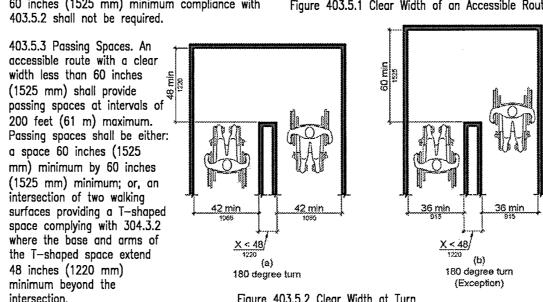


Figure 403.5.2 Clear Width at Turn 403.6 Handrails. Where handrails are provided along walking surfaces with running slopes not steeper than 1:20 they shall comply with 505.

404 Doors, Doorways, and Gates 404.1 General. Doors, doorways, and gates that are part of an accessible route shall comply with 404. EXCEPTION: Doors, doorways, and gates designed to be operated only by security personnel shall not be required to comply with 404.2.7, 404.2.8, 404.2.9, 404.3.2 and 404.3.4 through 404.3.7. 404.2 Manual Doors, Doorways, and Manual Gates, Manual doors and doorways and manual gates intended for user passage shall comply with 404.2.

36 in (915 mm) 20 in (510 mm) 404.2.1 Revolving Doors, Gates, and Turnstiles. Revolving doors, revolving gates, and turnstiles shall not be

404.2.2 Double-Leaf Doors and Gates. At least one of the active leaves of doorways with two leaves shall comply with 404.2.3 and 404.2.4.

404.2.3 Clear Width. Door openings shall provide a clear width of 32 inches (815 mm) minimum. Clear openings of doorways with swinging doors shall be measured between the face of the door and the stop, with the door open 90 degrees. Openings more than 24 inches (610 mm) deep shall provide a clear opening of 36 inches (915 mm) minimum. There shall be no projections into the required clear opening width lower than 34 inches (865 mm) above the finish floor or ground. Projections into the clear opening width between 34 inches (865 mm) and 80 inches (2030 mm) above the finish floor or ground shall not Where sliding doors are in the fully exceed 4 inches (100 mm).

EXCEPTIONS: 1. In alterations, a projection of 5/8 inch (16 mm) maximum into the required clear width shall be exposed and usable from shall be permitted for the latch side stop.

2. Door closers and door stops shall be permitted to be 78 inches (1980 mm) minimum above the finish floor or ground. 404.2.4 Maneuvering Clearances. doors and gates shall comply with 404.2.4. Maneuvering clearances shall extend the full width of the doorway and the required latch side or hinge Figure 404.2.3 Clear Width of Doorways patient rooms shall not be required to provide the clearance beyond the latch side of the door. 404.2.4.1 Swinging Doors and Gates. Swinging doors and gates shall have maneuvering clearances

complying with Table 404.2.4.1. (as illustrated on Figures 404.2.4.1)



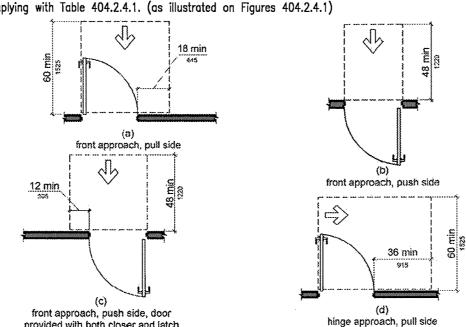


Figure 404.2.4.1 Maneuvering Clearances at Manual Swinging Doors and Gates

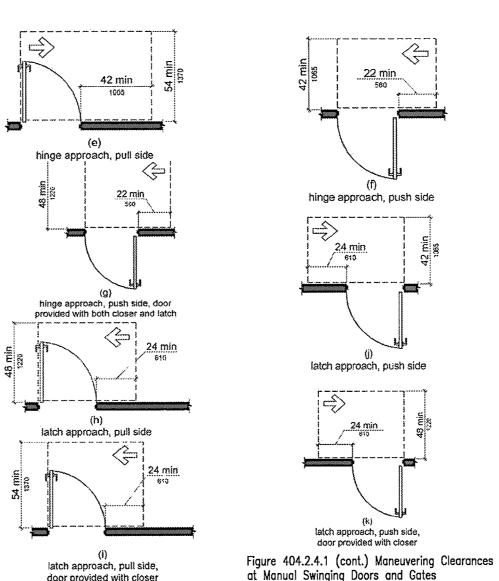

404.2.4.2 Doorways without Doors or Gates, Sliding Doors, and Folding Doors. Doorways less than 36 inches (915 mm) wide without doors or gates, sliding doors, or folding doors shall have maneuvering

clearances complying with Table 404.2.4.2. (as illustrated on Figure 404.2.4.2) Gates, Maneuverina clearances for forward approach shall be provided when any obstruction within 18 inches (455 mm) of projects more than 8 inches side approach front approach (205 mm) beyond the face of the door, measured perpendicular to the face of 22 min the door or gate. 24 min pocket or hinge approach stop or latch approach

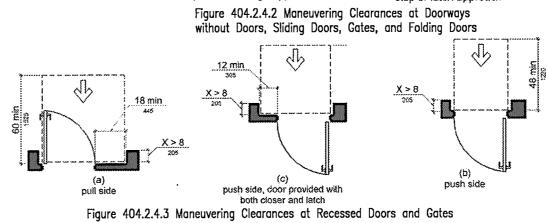


404.2.4.4 Floor or Ground Surface. Floor or ground surface within required maneuvering clearances shall comply with 302. Changes in level are not permitted. EXCEPTIONS:

1. Slopes not steeper than 1:48 shall be permitted. 2. Changes in level at thresholds complying with 404.2.5 shall be permitted.

404.2.5 Thresholds. Thresholds, if provided at doorways, shall be 1/2 inch (13 mm) high maximum. Raised thresholds and changes in level at doorways shall comply with 302 and 303. EXCEPTION: Existing or altered thresholds 3/4 inch (19 mm) high maximum that have a beveled edge on each side with a slope not steeper than 1:2 shall not be required to comply with 404.2.5.

404.2.6 Doors in Series and Gates in Series. The distance between two hinged or pivoted doors in series and gates in series shall be 48 inches (1220 mm) minimum plus the width of doors or gates swinging

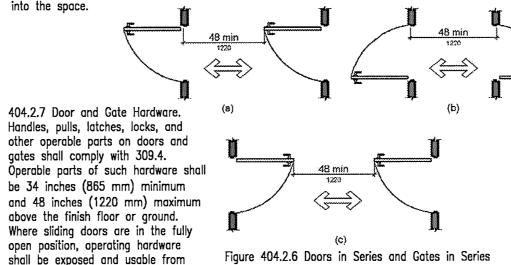

1. Existing locks shall be permitted in any location at existing glazed doors without stiles, existing overhead rolling doors or grilles, and similar existing doors or grilles that are designed with locks that are

activated only at the top or bottom rail. 2. Access gates in barrier walls and fences protecting pools, spas, and hot tubs shall be permitted to have operable parts of the release of latch on self-latching devices at 54 inches (1370 mm) maximum above the finish floor or ground provided the self-latching devices are not also self-locking devices and operated by means of a key, electronic opener, or integral combination lock.

404.2.8 Closing Speed. Door and gate closing speed shall comply with 404.2.8.

404.2.8.1 Door Closers and Gate Closers. Door closers and gate closers shall be adjusted so that from an open position of 90 degrees, the time required to move the door to a position of 12 degrees from the latch is 5 seconds minimum.

70 degrees, the door or gate shall move to the closed position in 1.5 seconds minimum. 404.2.9 Door and Gate Opening Force. Fire doors shall have a minimum opening force allowable by the appropriate administrative authority. The force for pushing or pulling open a door or gate other than fire

404.2.8.2 Spring Hinges. Door and gate spring hinges shall be adjusted so that from the open position of

doors shall be as follows: 1. Interior hinged doors and gates: 5 pounds (22.2 N) maximum. 2. Sliding or folding doors: 5 pounds (22.2 N) maximum. These forces do not apply to the force required to retract latch bolts or disengage other devices that

hold the door or gate in a closed position. 404.2.10 Door and Gate Surfaces. Swinging door and gate surfaces within 10 inches (255 mm) of the finish floor or ground measured vertically shall have a smooth surface on the push side extending the full width of the door or gate. Parts creating horizontal or vertical joints in these surfaces shall be within 1/16 inch (1.6 mm) of the same plane as the other. Cavities created by added kick plates shall be

. Sliding doors shall not be required to comply with 404.2.10. 2. Tempered glass doors without stiles and having a bottom rail or shoe with the top leading edge tapered at 60 degrees minimum from the horizontal shall not be required to meet the 10 inch (255 mm) bottom smooth surface height requirement.

**EXCEPTIONS:** 

3. Doors and gates that do not extend to within 10 inches (255 mm) of the finish floor or ground shall not be required to comply with 404.2.10. 4. Existing doors and gates without smooth surfaces within 10 inches (255 mm) of the finish floor or ground shall not be required to provide smooth surfaces complying with 404.2.10 provided that if added kick plates are installed, cavities created by such kick plates are capped

404.2.11 Vision Lights. Doors, gates, and side lights adjacent to doors or gates, containing one or more glazing panels that permit viewing through the panels shall have the bottom of at least one glazed panel located 43 inches (1090 mm) maximum above the finish floor. EXCEPTION: Vision lights with the lowest part more than 66 inches (1675 mm) from the finish floor or ground shall not be required to comply with 404.2.11.

404.3 Automatic and Power-Assisted Doors and Gates. Automatic doors and automatic gates shall comply with 404.3. Full-powered automatic doors shall comply with ANSI/BHMA A156.10 (incorporated by reference, see "Referenced Standards" in Chapter 1). Low-energy and power-assisted doors shall comply with ANSI/BHMA A156.19 (1997 or 2002 edition) (incorporated by reference, see "Referenced Standards" in Chapter 1).

power-on and power-off mode. The minimum clear width for automatic door systems in a doorway shall be based on the clear opening provided by all leaves in the open position.

404.3.1 Clear Width. Doorways shall provide a clear opening of 32 inches (815 mm) minimum in

404.3.2 Maneuvering Clearance. Clearances at power-assisted doors and gates shall comply with 404.2.4. Clearances at automatic doors and gates without standby power and serving an accessible means of egress shall comply with 404.2.4.

EXCEPTION: Where automatic doors and gates remain open in the power-off condition, compliance with 404.2.4 shall not be required.

404.3.3 Thresholds. Thresholds and changes in level at doorways shall comply with 404.2.5. 404.3.4 Doors in Series and Gates in Series. Doors in series and gates in series shall comply with 404.2

404.3.5 Controls. Manually operated controls shall comply with 309. The clear floor space adjacent to t control shall be located beyond the arc of the door swing.

404.3.6 Break Out Opening. Where doors and gates without standby power are a part of a means of egress, the clear break out opening at swinging or sliding doors and gates shall be 32 inches (815 mm minimum when operated in emergency mode. EXCEPTION: Where manual swinging doors and gates comply with 404.2 and serve the same means of egress compliance with 404.3.6 shall not be required.

404.3.7 Revolving Doors, Revolving Gates, and Turnstiles. Revolving doors, revolving gates, and turnstiles shall not be part of an accessible route.

405.1 General. Ramps on accessible routes shall comply with 405. EXCEPTION: In assembly areas, aisle ramps adjacent to seating and not serving elements required to be a an accessible route shall not be required to comply with 405.

405.2 Slope. Ramp runs shall have a running slope not steeper than 1:12. EXCEPTION: In existing sites, buildings, and facilities, ramps shall be permitted to have running slopes steeper than 1:12 complying with Table 405.2 where such slopes are necessary due to space limitations.

Table 405.2 Maximum Ramp Slope and Rise for Ex	kisting Sites, Buildings, and Facilitie
Slope (A slope steeper than 1:8 is prohibited.)	Maximum Rise
Steeper than 1:10 but not steeper than 1:8	3 inches (75 mm)
Steeper than 1:12 but not steeper than 1:10	6 inches (150 mm)


405.3 Cross Slope. Cross slope of ramp runs shall not be steeper than 1:48.

405.4 Floor or Ground Surfaces. Floor or ground surfaces of ramp runs shall comply with 302. Changes in level other than the running slope and cross slope are not permitted on ramp runs.

405.5 Clear Width. The clear width of a ramp run and, where handrails are provided, the clear width between handrails shall be 36 inches (915 mm) minimum. EXCEPTION: Within employee work greas, the required clear width of ramps that are a part of common use circulation paths shall be permitted to be decreased by work area equipment provided that the decrease is essential to the function of the work being performed

405.6 Rise. The rise for any ramp run shall be 30 inches (760 mm) maximum.

405.7 Landings. Ramps shall have landings at the top and the bottom of each ramp run. Landings shall

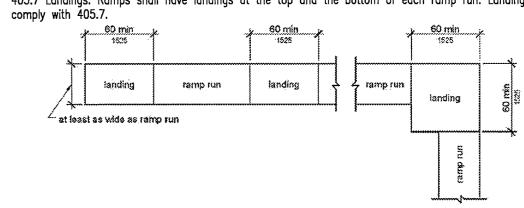

405.7.1 Slope. Landings shall comply with 302. Changes in level are not permitted.

405.7.2 Width. The landing clear width shall be at least as wide as the widest ramp run leading to the

405.7.3 Length. The landing clear length shall be 60 inches (1525 mm) long minimum.

EXCEPTION: Slopes not steeper than 1:48 shall be permitted.

405.7.4 Change in Direction. Ramps that change directi on between runs at landings shall have a clear landing 60 inches (1525 mm) minimum by 60 inches (1525 mm) minimum.

405.7.5 Doorways. Where doorways are located adjacent to a ramp landing, maneuvering clearances required by 404.2.4 and 404.3.2 shall be permitted to overlap the required landing area.


405.8 Handrails. Ramp runs with a rise greater than 6 inches (150 mm) shall have handrails complying EXCEPTION: Within employee work areas, handrails shall not be required where ramps that are part of common use circulation paths are designed to permit the installation of handrails complying with 505. Ramps not subject to the exception to 405.5 shall be designed to maintain a 36 inch (915 mm) minimum clear width when handrails are installed.


405.9 Edge Protection. Edge protection complying with 405.9.1 or 405.9.2 shall be provided on each side of ramp runs and at each side of ramp landings. EXCEPTIO1. Edge protection shall not be required on ramps that are not required to have handrails and have sides complying with 406.3. 2. Edge protection shall not be required on the sides of ramp landings serving an adjoining ramp run or 3. Edge protection shall not be required on the sides of ramp landings having a vertical drop-off of 1

405.9.1 Extended Floor or Ground Surface. The floor or ground surface of the ramp run or landing shall extend 12 inches (305 mm) minimum beyond the inside face of a handrail complying with 505.

inch (13 mm) maximum within 10 inches (255 mm) horizontally of the minimum landing area specified i


405.9.2 Curb or Barrier. A curb or barrier shall be provided that prevents the passage of a 4 inch (100 mm) diameter sphere, where any portion of the sphere is within 4 inches (100 mm) of the finish floor or ground surface.

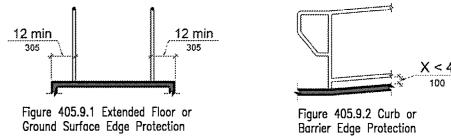

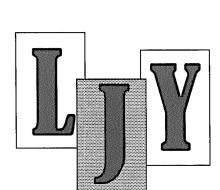

lester j young, architect 6304 royal lane dallas, texas 75230 214.455.7878

Revision 11.19.12 Revision

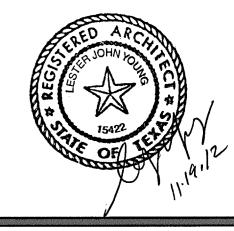



Drawn by Checked by LY

# 2010 ADA Standards for Accessible Design

for Public Accommodations and Commercial Facilities: Title III

CHAPTER 4: ACCESSIBLE ROUTES (cont.) 405.10 Wet Conditions. Landings subject to wet conditions shall be designed to prevent the accumulation of water.

406.1 General. Curb ramps on accessible routes shall comply with 406, 405.2 through 405.5, and 405.10.

406.2 Counter Slope. Counter slopes of adjoining gutters and road surfaces immediately adjacent to the curb ramp shall not be steeper than 1:20. The adjacent surfaces at transitions at curb ramps to walks. gutters, and streets shall be at the same level. 406.3 Sides of Curb Ramps. Where

provided, curb ramp flares shall not be steeper than 1:10. 406.4 Landings. Landings shall be provided at the tops of curb ramps. Figure 406.2 Counter Slope of Surfaces Adjacent to Curb Ramps The landing clear length shall be 36 - flared sides 1:10 max slope inches (915 mm) minimum. The landing clear width shall be at least as wide as the curb ramp, excluding flared sides,

leading to the landing. EXCEPTION: In alterations, where there is no landing at the top of curb ramps. curb ramp flares shall be provided and shall not be steeper than 1:12.


406.5 Location. Curb ramps and the flared sides of curb ramps shall be located so that they do not project into vehicular traffic lanes, parking spaces, or parking access gisles. Curb ramps at marked crossings shall be wholly contained within the markings, excluding any flared sides.

406.6 Diagonal Curb Ramps. Diagonal or corner type curb ramps with returned curbs Figure 406.4 Landings at the Top of Curb Ramps or other well-defined edges shall have the edges parallel to the direction of pedestrian flow. The bottom of diagonal curb ramps shall have a clear space 48 inches (1220 mm) minimum outside active traffic lanes of the roadway. Diagonal curb ramps provided at marked crossings shall provide the 48 inches (1220 mm) minimum clear space within the markings. Diagonal curb ramps with flared sides shall have a segment of curb 24 inches (610 mm) long minimum located on each side of the curb ramp and within the marked crossing.

Figure 406.3 Sides of Curb Ramps


---- et least as wide as

406.7 Islands. Raised islands in crossings shall be cut through level with the street or have curb ramps at both sides. Each curb ramp shall have a level area 48 inches (1220 mm) long minimum by 36 inches (915 mm) wide minimum at the top of 48 min the curb ramp in the part of the island intersected by the crossings. Each 48 inch (1220 mm) minimum by 36 inch (915 mm) minimum area shall be oriented so that the 48 inch (1220 mm) minimum length is in the direction of the running slope of the curb ramp it serves. The 48 inch (1220 mm) minimum by 36 inch (915 mm) minimum areas and the accessible route shall be permitted to overlap.

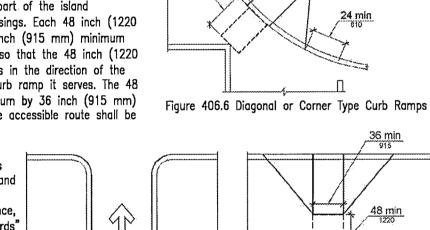

407.1 General. Elevators shall comply with 407 and with ASME A17.1 (incorporated by reference, see "Referenced Standards' in Chapter 1). They shall be passenger elevators as classified by ASME A17.1. Elevator operation shall be automatic. 407.2 Elevator Landing Requirements. Elevator

407 Elevators

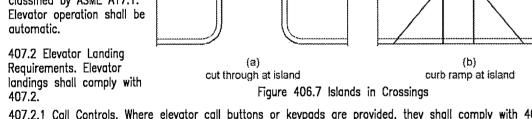

407.2.1 Call Controls. Where elevator call buttons or keypads are provided, they shall comply with 407.2.1 and 309.4. Call buttons shall be raised or flush. EXCEPTION: Existing elevators shall be permitted to have recessed call buttons.

407.2.1.1 Height. Call buttons and keypads shall be located within one of the reach ranges specified in 308, measured to the centerline of the highest operable part. EXCEPTION: Existing call buttons and existing keypads shall be permitted to be located at 54 inches (1370 mm) maximum above the finish floor, measured to the centerline of the highest operable part.

407.2.1.2 Size. Call buttons shall be 3/4 inch (19 mm) minimum in the smallest dimension. EXCEPTION: Existing elevator call buttons shall not be required to comply with 407.2.1.2.

407.2.1.3 Clear Floor or Ground Space. A clear floor or ground space complying with 305 shall be provided at call controls.

407.2.1.4 Location. The call button that designates the up direction shall be located c that designates the down direction.

EXCEPTION: Destination-oriented elevators shall not be required to comply with 407.2.1 407.2.1.5 Signals. Call buttons shall have visible signals to indicate when each call is registered and when each call is answered.

1. Destination—oriented elevators shall not be required to comply with 407.2.1.5 provided that visible and audible signals complying with 407.2.2 indicating which elevator car to enter are provided. 2. Existing elevators shall not be required to comply with 407.2.1.5.

407.2.1.6 Keypads. Where keypads are provided, keypads shall be in a standard telephone keypad arrangement and shall comply with 407.4.7.2.

407.2.2 Hall Signals. Hall signals, including in-car signals, shall comply with 407.2.2.

407.2.2.1 Visible and Audible Signals. A visible and audible signal shall be provided at each hoistway entrance to indicate which car is answering a call and the car's direction of travel. Where in-car signals are provided, they shall be visible from the floor area adjacent to the hall call buttons. 1. Visible and audible signals shall not be required at each destination—oriented elevator where a visible

and audible signal complying with 407.2.2 is provided indicating the elevator car designation information. 2. In existing elevators, a signal indicating the direction of car travel shall not be required.

407.2.2.2 Visible Signals. Visible signal fixtures shall be centered at 72 inches (1830 mm) minimum above the finish floor or ground. The visible signal elements shall be 2 1/2 inches (64 mm) minimum measured along the vertical centerline of the element. Signals shall be visible from the floor area adjacent to the hall call button.

1. Destination—oriented elevators shall be permitted to have signals visible from the floor area adiacent to the hoistway entrance. 2. Existing elevators shall not be required to comply with 407.2.2.2.

407.2.2.3 Audible Signals. Audible signals shall sound once for the up direction and twice for the down direction, or shall have verbal annunciators that indicate the direction of elevator car travel. Audible signals shall have a frequency of 1500 Hz maximum. Verbal annunciators shall have a frequency of 300 Hz minimum and 3000 Hz maximum. The audible signal and verbal annunciator shall be 10 dB minimum above ambient, but shall not exceed 80 dB. measured at the hall call button. **FXCEPTIONS:** 

of audible signals.

1. Destination—oriented elevators shall not be required to comply with 407.2.2.3 provided that the audible tone and verbal announcement is the same as those given at the call button or Figure 407.2.2.2 Visible Hall Signals call button keypad.

2. Existing elevators shall not be required to comply with the requirements for frequency and dB range

407.2.2.4 Differentiation. Each destination—oriented elevator in a bank of elevators shall have audible and

visible means for differentiation.

407.2.3 Hoistway Signs. Signs at elevator hoistways shall comply with 407.2.3.

407.2.3.1 Floor Designation. Floor designations complying with 703.2 and 703.4.1 shall be provided on both jambs of elevator hoistway entrances. Floor designations shall be provided in both tactile characters and braille. Tactile characters shall be 2 inches (51 mm) high minimum. A tactile star shall be provided

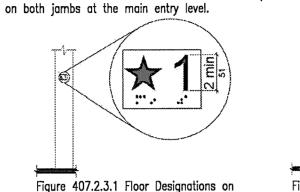


Figure 407.2.3.2 Car Designations on Jambs of Destination-Oriented Elevator Hoistway Entrances Jambs of Elevator Hoistway Entrances 407.2.3.2 Car Designations. Destination—oriented elevators shall provide tactile car identification complying with 703.2 on both jambs of the hoistway immediately below the floor designation. Car designations shall be provided in both tactile characters and braille. Tactile characters shall be 2 inches (51 mm) high

407.3 Elevator Door Requirements. Hoistway and car doors shall comply with 407.3.

407.3.1 Type. Elevator doors shall be the horizontal sliding type. Car gates shall be prohibited.

407.3.2 Operation. Elevator hoistway and car doors shall open and close automatically. EXCEPTION: Existing manually operated hoistway swing doors shall be permitted provided that they comply 407.4.8 Car Position Indicators. Audible and visible car position indicators shall be provided in elevator with 404.2.3 and 404.2.9. Car door closing shall not be initiated until the hoistway door is closed.

407.3.3 Reopening Device. Elevator doors shall be provided with a reopening device complying with 407.3.3 407.4.8.1 Visible Indicators. Visible indicators shall comply with 407.4.8.1. that shall stop and reopen a car door and hoistway door automatically if the door becomes obstructed by an object or person.

EXCEPTION: Existing elevators with manually operated doors shall not be required to comply with 407.3.3. 407.3.3.1 Height. The device shall be activated by sensing an obstruction passing through the opening at 5 inches (125 mm) nominal and 29 inches (735 mm) nominal above the finish floor.

407.3.3.2 Contact. The device shall not require physical contact to be activated, although contact is permitted to occur before the door reverses.

407.3.3.3 Duration. Door reopening devices shall remain effective for 20 seconds minimum.

407.3.4 Door and Signal Timing. The minimum acceptable time from notification that a car is answering a call or notification of the car assigned at the means for the entry of destination information until the doors of that car start to close shall be calculated from the following equation:

and D equals the distance (in feet or millimeters) from the point in the lobby or corridor 60 inches (1525 per minute (1 m/s) or less, a non-verbal audible signal with a frequency of 1500 Hz maximum which mm) directly in front of the farthest call button controlling that car to the centerline of its hoistway door. sounds as the car passes or is about to stop at a floor served by the elevator shall be permitted. 1. For cars with in-car lanterns, T shall be permitted to begin when the signal is visible from the point


60 inches (1525 mm) directly in front of the farthest hall call button and the audible signal is sounded. 2. Destination—oriented elevators shall not be required to comply with 407.3.4.


407.3.5 Door Delay. Elevator doors shall remain fully open in response to a car call for 3 seconds minimum.


407.3.6 Width. The width of elevator doors shall comply with Table 407.4.1. EXCEPTION: In existing elevators, a power-operated car door complying with 404.2.3 shall be permitted.


407.4 Elevator Car Requirements. Elevator cars shall comply with 407.4.

407.4.1 Car Dimensions. Inside dimensions of elevator cars and clear width of elevator doors shall comply classified by ASME A17.1. Elevator operation shall be automatic. with Figure 407.4.1 (Table 407.4.1.). EXCEPTION: Existing elevator car configurations that provide a clear floor area of 16 square feet (1.5 m2) 408.2 Elevator Landings serving limited—use/limited—application elevators shall comply with 408.2. minimum. minimum and also provide an inside clear depth 54 inches (1370 mm) minimum and a clear width 36

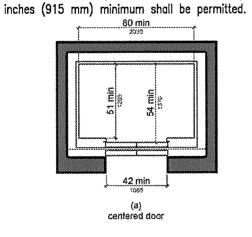


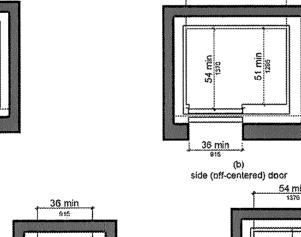


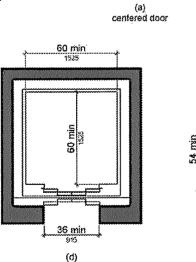

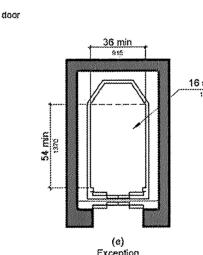

407.4.2 Floor Surfaces. Floor surfaces in elevator cars shall comply with 302 and 303.

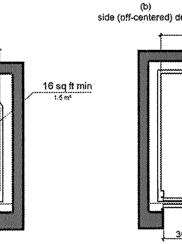

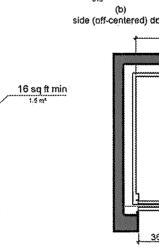

existing elevator car configuration

any door location Figure 407.4.1 Elevator Car Dimensions

407.4.3 Platform to Hoistway Clearance. The clearance between the car platform sill and the edge of any hoistway landing shall be 1 1/4 inch (32 mm) maximum.

407.4.4 Leveling. Each car shall be equipped with a self—leveling feature that will automatically bring and maintain the car at floor landings within a tolerance of 1/2 inch (13 mm) under rated loading to zero

407.4.5 Illumination. The level of illumination at the car controls, platform, car threshold and car landing comply with 407.4.7. sill shall be 5 foot candles (54 lux) minimum. 407.4.6 Elevator Car Controls. Where provided, elevator car controls shall comply with 407.4.6 and 309.4.

EXCEPTION: In existing elevators, where a new car operating panel complying with 407.4.6 is provided, existing car operating panels shall not be required to comply with 407.4.6.

407.4.6.1 Location. Controls shall be located within one of the reach ranges specified in 308.

1. Where the elevator panel serves more than 16 openings and a parallel approach is provided, buttons with floor designations shall be permitted to be 54 inches (1370 mm) maximum above the finish floor. 2. In existing elevators, car control buttons with floor designations shall be permitted to be located 54 inches (1370 mm) maximum above the finish floor where a parallel approach is provided.

407.4.6.2 Buttons. Car control buttons with floor designations shall comply with 407.4.6.2 and shall be raised EXCEPTION: In existing elevators, buttons shall be permitted to be recessed.

407.4.6.2.1 Size. Buttons shall be 3/4 inch (19 mm) minimum in their smallest dimension. 407.4.6.2.2 Arrangement. Buttons shall be arranged with numbers in ascending order. When two or more columns of buttons are provided they shall read from left to right.

407.4.6.3 Keypads. Car control keypads shall be in a standard telephone keypad arrangement and shall comply with 407.4.7.2.

407.4.6.4 Emergency Controls. Emergency controls shall comply with 407.4.6.4.

407.4.6.4.1 Height. Emergency control buttons shall have their centerlines 35 inches (890 mm) minimum above the finish floor.

407.4.6.4.2 Location, Emergency controls, including the emergency glarm, shall be grouped at the bottom 407.4.7 Designations and Indicators of Car Controls. Designations and indicators of car controls shall comply with 407.4.7.

EXCEPTION: In existing elevators, where a new car operating panel complying with 407.4.7 is provided, existing car operating panels shall not be required to comply with 407.4.7.

407.4.7.1 Buttons. Car control buttons shall comply with 407.4.7.1.

(refer to 2010 ADA for table).

407.4.7.1.1 Type. Control buttons shall be identified by tactile characters complying with 703.2. 407.4.7.1.2 Location. Raised character and braille designations shall be placed immediately to the left of the control button to which the designations apply.

EXCEPTION: Where space on an existing car operating panel precludes tactile markings to the left of the

controls, markings shall be placed as near to the control as possible. 407.4.7.1.3 Symbols. The control button for the emergency stop, alarm, door open, door close, main entry CHAPTER 5: GENERAL SITE AND BUILDING ELEMENTS floor, and phone, shall be identified with tactile symbols as shown in Table 407.4.7.1.3

407.4.7.1.4 Visible Indicators. Buttons with floor designations shall be provided with visible indicators to show that a call has been registered. The visible indication shall extinguish when the car arrives at the 407.4.7.2 Keypads. Keypads shall be identified by characters complying with 703.5 and shall be centered on the corresponding keypad button. The number five key shall have a single raised dot. The dot shall be 502.1 General. Car and van parking spaces shall comply with 502. Where parking spaces are marked with bottom of the handrail gripping surface. 0.118 inch (3 mm) to 0.120 inch (3.05 mm) base diameter and in other aspects comply with Table

407.4.8.1.1 Size. Characters shall be 1/2 inch (13 mm) high minimum. 407.4.8.1.2 Location. Indicators shall be located above the car control panel or above the door.

407.4.8.1.3 Floor Arrival. As the car passes a floor and when a car stops at a floor served by the elevator, the corresponding character shall illuminate. EXCEPTION: Destination-oriented elevators shall not be required to comply with 407.4.8.1.3 provided that the visible indicators extinguish when the call has been answered. 407.4.8.1.4 Destination Indicator. In destination-oriented elevators, a display shall be provided in the car with visible indicators to show car destinations.

407.4.8.2 Audible Indicators. Audible indicators shall comply with 407.4.8.2.

407.4.8.2.1 Signal Type. The signal shall be an automatic verbal annunciator which announces the floor which the car is about to stop. T = D/(1.5 ft/s) or T = D/(455 mm/s) = 5 seconds minimum where T equals the total time in seconds EXCEPTION: For elevators other than destination—oriented elevators that have a rated speed of 200 feet 407.4.8.2.2 Signal Level. The verbal annunciator shall be 10 dB minimum above ambient, but shall not exceed 80 dB, measured at the annunciator.

407.4.8.2.3 Frequency. The verbal annunciator shall have a frequency of 300 Hz minimum to 3000 Hz

407.4.9 Emergency Communication. Emergency two-way communication systems shall comply with 308. Tactile symbols and characters shall be provided adjacent to the device and shall comply with 703.2.

408 Limited-Use/Limited-Application Elevators

404, 407.3.2 and 408.3.2.

Exception 1

408.1 General, Limited-use/limited-application elevators shall comply with 408 and with ASME A17.1 (incorporated by reference, see "Referenced Standards" in Chapter 1). They shall be passenger elevators as 502.5 Vertical Clearance. Parking spaces for vans and

408.2.1 Call Buttons. Elevator call buttons and keypods shall comply with 407.2.1.

408.2.2 Hall Signals. Hall signals shall comply with 407.2.2.

408.3 Elevator Doors. Elevator hoistway doors shall comply with 408.3.

408.2.3 Hoistway Signs. Signs at elevator hoistways shall comply with 407.2.3.1.

408.3.1 Sliding Doors, Sliding hoistway and car doors shall comply with 407.3.1 through 407.3.3 and

408.3.2 Swinging Doors. Swinging hoistway doors shall open and close automatically and shall comply with

408.3.2.1 Power Operation. Swinging doors shall be power-operated and shall comply with ANSI/BHMA A156.19 (1997 or 2002 edition) (incorporated by reference, see "Referenced Standards" in Chapter 1). 408.3.2.2 Duration. Power-operated swinging doors shall remain open for 20 seconds minimum when

activated. 408.4 Elevator Cars. Elevator cars shall comply with 408.4. 408.4.1 Car Dimensions and Doors. Elevator cars shall provide a clear width 42 inches (1065 mm) minimum and a clear depth 54 inches (1370 mm) minimum. Car doors shall be positioned at the narrow

ends of cars and shall provide 32 inches (815 mm) minimum clear width. 1. Cars that provide a clear width 51 inches (1295 mm) minimum shall be permitted to provide a clear depth 51 inches (1295 mm) minimum provided that car doors provide a clear opening 36 inches (915

2. Existing elevator cars shall be permitted to provide a clear width 36 inches (915 mm) minimum, clear depth 54 inches (1370 mm) minimum, and a net clear platform area 15 square feet (1.4 m2) minimum. pull—up space they serve. 408.4.2 Floor Surfaces. Floor surfaces in elevator cars shall comply with 302 and 303.


408.4.3 Platform to Hoistway Clearance. The platform to hoistway clearance shall comply with 407.4.3.

408.4.4 Leveling. Elevator car leveling shall comply with 407.4.4. 408.4.5 Illumination. Elevator car illumination shall comply with 407.4.5.

408.4.6 Car Controls. Elevator car controls shall comply with 407.4.6. Control panels shall be centered

408.4.7 Designations and Indicators of Car Controls. Designations and indicators of car controls shall

408.4.8 Emergency Communications. Car emergency signaling devices complying with 407.4.9 shall be

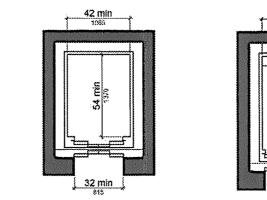

new construction

Figure 408.4.1 Limited-Use/Limited-Application (LULA) Elevator Car Dimensions

410 Platform Lifts 410.1 General. Platform lifts shall comply with ASME A18.1 (1999 edition or 2003 edition) (incorporated by 504.6 Handrails. Stairs shall have handrails complying with 505. reference, see "Referenced Standards" in Chapter 1). Platform lifts shall not be attendant-operated and

shall provide unassisted entry and exit from the lift. 410.2 Floor Surfaces, Floor surfaces in platform lifts shall comply with 302 and 303.

410.3 Clear Floor Space. Clear floor space in platform lifts shall comply with 305. 410.4 Platform to Runway Clearance. The clearance between the platform sill and the edge of any runway landing shall be 1 inch (32 mm) maximum.

410.5 Operable Parts. Controls for platform lifts shall comply

410.6 Doors and Gates. Platform lifts shall have low-energy power-operated doors or gates complying with 404.3. Doors Figure 410.6 Platform Lift Doors and shall remain open for 20 seconds minimum. End doors and gates shall provide a clear width 32 inches (815 mm) minimum. Side doors and gates shall provide a clear width 42 inches (1065 mm) minimum.

EXCEPTION: Platform lifts serving two landings maximum and having doors or gates on opposite sides shall

platform

Figure 502.2 Vehicle Parking Spaces

be permitted to have self-closing manual doors or gates.

501.1 Scope. The provisions of Chapter 5 shall apply where required by Chapter 2 or where referenced by a requirement in this document.

lines, width measurements of parking spaces and access aisles shall be made from the centerline of the EXCEPTIONS: EXCEPTION: Where parking spaces or access aisles are not adjacent to another parking space or access gisle, measurements shall be permitted to include the full width of the line defining the parking space or permitted to be obstructed along their entire length where they are

502.2 Vehicle Spaces. Car parking spaces shall be 96 inches (2440 mm) wide minimum and van parking spaces shall be 132 inches (3350 mm) wide minimum, shall be marked to define the width, and shall have an adjacent access aisle complying with 502.3. EXCEPTION: Van parking spaces shall be permitted to be 96 inches (2440 mm) wide minimum where the access aisle is 96 inches (2440 mm) wide minimum.

shall comply with 502.3. Access aisles shall adjoin an accessible route. Two parking spaces shall be permitted to share a common access aisle.

502.3 Access Aisle. Access aisles serving parking spaces

502.3.1 Width. Access aisles serving car and van parking spaces shall be 60 inches (1525 mm) wide minimum. 502.3.2 Length. Access aisles shall extend the full length of the parking spaces they serve.

discourage parking in them. 502.3.4 Location. Access aisles shall not overlap the vehicular way. Access aisles shall be permitted to be placed on either side of the parking space except for angled van parking spaces which shall have access aisles

502.3.3 Marking. Access aisles shall be marked so as to

located on the passenger side of the parking spaces. 502.4 Floor or Ground Surfaces. Parking spaces and access aisles serving them shall comply with 302. Access aisles shall be at the same level as the parking spaces they serve. Changes in level are not permitted. EXCEPTION: Slopes not steeper than 1:48 shall be permitted.

access aisles and vehicular routes serving them shall provide a vertical clearance of 98 inches (2490 mm) 502.6 Identification. Parking space identification signs shall

include the International Symbol of Accessibility complying with 703.7.2.1. Signs identifying van parking spaces shall contain the designation "van accessible." Signs shall be 60 inches (1525 mm) minimum above the finish floor or ground surface Figure 502.3 Parking Space Access Aisle measured to the bottom of the sign.

502.7 Relationship to Accessible Routes. Parking spaces and access gisles shall be designed so that cars and vans, when parked, cannot obstruct the required clear width of adjacent accessible routes.

503 Passenger Loading Zones 503.1 General. Passenger loading zones shall comply with 503.

503.2 Vehicle Pull-Up Space. Passenger loading zones shall provide a vehicular pull-up space 96 inches (2440 mm) wide minimum and 20 feet (6100 mm) long minimum.

503.3 Access Aisle. Passenger loading zones shall provide access aisles complying with 503 adjacent to the vehicle pull-up space. Access aisles shall adjoin an accessible route and shall not overlap the vehicular way. 503.3.1 Width. Access aisles serving vehicle pull-up spaces shall be 60 inches (1525 mm) wide minimum.

503.3.2 Length, Access gisles shall extend the full length of the vehicle pull-up spaces they serve 503.3.3 Marking. Access aisles shall be marked so as to discourage parking in them.

503.4 Floor and Ground vehicle pull-up space Surfaces. Vehicle pull-up curb line ..... spaces and access aisles serving them shall comply with 302. Access aisles shall be at the same level as the vehicle area to be --Changes in level are not EXCEPTION: Slopes not steeper than 1:48 shall be permitted. Figure 503.3 Passenger Loading Zone Access Aisle

503.5 Vertical Clearance. Vehicle pull-up spaces, access aisles serving them, and a vehicular route from an entrance to the passenger loading zone, and from the passenger loading zone to a vehicular exit shall 602.4 Spout Height. Spout outlets shall be 36 inches (915 mm) maximum above the finish floor or ground. provide a vertical clearance of 114 inches (2895 mm) minimum.

504.1 General. Stairs shall comply with 504.

504.2 Treads and Risers. All steps on a flight of stairs shall have uniform riser heights and uniform tread 602.6 Water Flow. The spout shall provide a flow of water 4 inches (100 depths. Risers shall be 4 inches (100 mm) high minimum and 7 inches (180 mm) high maximum. Treads shall be 11 inches (280 mm) deep minimum.

504.3 Open Risers. Open risers are not permitted

504.4 Tread Surface. Stair treads shall comply with 302.

over the tread below.

Changes in level are not permitted. EXCEPTION: Treads shall be permitted to have a slope not steeper than 1:48. 504.5 Nosings. The radius of curvature at the leading edge (typical for all profiles) of the tread shall be 1/2 inch (13 mm) maximum. Nosings that project beyond risers shall have the underside of the leading edge curved or beveled. Risers shall be permitted to slope under the tread at an angle of 30

angled riser radius of tread edge degrees maximum from vertical. The permitted projection of the nosing shall extend 1 1/2 inches (38 mm) maximum curved nosing beveled nosing Figure 504.5 Stair Nosings

30° max -

tadius 1/2

504.7 Wet Conditions. Stair treads and landings subject to wet conditions shall be designed to prevent the accumulation of water.

505 Handrails 505.1 General. Handrails provided along walking surfaces complying with 403, required at ramps complying with 405, and required at stairs complying with 504 shall comply with 505.

505.2 Where Required. Handrails shall be provided on both sides of stairs and ramps. EXCEPTION: In assembly areas, handrails shall not be required on both sides of aisle ramps where a handrail is provided at either side or within the aisle width.

505.3 Continuity. Handrails shall be continuous within the full length of each stair flight or ramp run. Inside handrails on switchback or dogleg stairs and ramps shall be continuous between flights or runs. EXCEPTION: In assembly greas, handrails on ramps shall not be required to be continuous in aisles serving

505.4 Height. Top of gripping surfaces of handrails shall be 34 inches (865 mm) minimum and 38 inches (965 mm) maximum vertically above walking surfaces. stair nosings, and ramp surfaces. Handrails shall be at a consistent height above walking surfaces, stair nosings, and ramp surfaces. walking surfaces

505.5 Clearance. Clearance between handrail gripping surfaces Figure 505.4 Handrail and adjacent surfaces shall be 1 1/2 inches (38 mm)

505.6 Gripping Surface. Handrail gripping surfaces shall be continuous along their length and shall not be obstructed along their tops or sides. The bottoms of handrail gripping surfaces shall not be obstructed for more than 20 percent of their length. Where provided, horizontal Figure 505.5 Handrail Clearance projections shall occur 1 1/2 inches (38 mm) minimum below the Where handrails are provided along walking surfaces with slopes not steeper than 1:20, the bottoms of handrail gripping surfaces shall be

Figure 505.6 Horizontal Project Below Gripping Surface integral to crash rails or bumper quards. 2. The distance between horizontal projections and the bottom of the gripping surface shall be permitted to be reduced by 1/8 inch (3.2 mm) for each 1/2 inch (13 mm) of additional handrail perimeter

dimension that exceeds 4 inches (100 mm). 505.7 Cross Section. Handrail gripping surfaces shall have a cross section complying with 505.7.1 or

505.7.1 Circular Cross Section. Handrail gripping surfaces with a circular cross section shall have an outside diameter of 1 1/4 inches (32 mm) minimum and 2 inches (51 mm) maximum. 505.7.2 Non-Circular Cross Sections. Handrail gripping

surfaces with a non-circular cross section shall have a

505.9 Fittings. Handrails shall not rotate within their fittings.

**FXCEPTIONS:** 

adjacent stair flight.

hazardous due to plan configuration.

perimeter dimension of 4 inches (100 mm) minimum and 6 1/4 inches (160 mm) maximum, and a cross-section dimension of 2 1/4 inches (57 mm) Figure 505.7.2 Handrail Non-Circular Cross Section

505.8 Surfaces. Handrail gripping surfaces and any surfaces adjacent to them shall be free of sharp or abrasive elements and shall have rounded edges.

505.10 Handrail Extensions. Handrail gripping surfaces shall extend beyond and in the same direction of stair flights and ramp runs in accordance with 505.10.

1. Extensions shall not be required for continuous handrails at the inside turn of switchback or dogleg 2. In assembly areas, extensions shall not be required for ramp handrails in aisles serving seating where the handrails are discontinuous to provide access to seating and to permit crossovers within gisles. 3. In alterations, full extensions of handrails shall not be required where such extensions would be

505.10.1 Top and Bottom Extension at Ramps. Ramp handrails shall extend horizontally above the landing for 12 inches (305 mm) minimum beyond the top and bottom of ramp runs. Extensions shall return to a wall, guard, or the landing surface, or shall be continuous to the handrail of an adjacent ramp run.

505.10.2 Top Extension at Stairs. At the top of a stair flight, handrails shall extend horizontally above the landing for 12 inches (305 mm) minimum beginning directly above the first riser nosing. Extensions shall return to a wall, guard, or the landing surface, or shall be continuous to the handrail of an adjacent stair flight. Figure 505.10.1 Top and Bottom Handrail 505.10.3 Bottom Extension at Stairs. Extension at Ramps At the bottom of a stair flight. handrails shall extend at the slope of the stair flight for a horizontal distance at least equal to one tread depth beyond the last riser nosing. Extension shall return to a wall, guard, or the landing surface, or shall be continuous to the handrail of an

### Figure 505.10.3 Bottom Handrail Figure 505.10.2 Top Handrail Extension at Stairs Extension at Stairs CHAPTER 6: PLUMBING ELEMENTS & FACILITIES

Note: X = tread depth

601.1 Scope. The provisions of Chapter 6 shall apply where required by Chapter 2 or where referenced by a requirement in this document.

602 Drinking Fountains 602.1 General. Drinking fountains shall comply with 307 and 602.

602.2 Clear Floor Space. Units shall have a clear floor or ground space complying with 305 positioned for a forward approach and centered on the unit. Knee and toe clearance complying with 306 shall be EXCEPTION: A parallel approach complying with 305 shall be permitted at units for children's use where the

spout is 30 inches (760 mm) maximum above the finish floor or ground and is 3 1/2 inches (90 mm)

maximum from the front edge of the unit, including bumpers. 602.3 Operable Parts. Operable parts shall comply with 309.


602.5 Spout Location. The spout shall be located 15 inches (380 mm) minimum from the vertical support

and 5 inches (125 mm) maximum from the front edge of the unit, including bumpers. mm) high minimum and shall be located 5 inches (125 mm) maximum from the front of the unit. The angle of the water stream shall be measured horizontally relative to the front face of the unit. Where spouts are located less than 3 inches (75 mm) of the front of the unit, the angle of the water stream shall be 30 degrees maximum. Where spouts are located between 3

Figure 602.5 Drinking inches (75 mm) and 5 inches (125 mm) maximum from the front of the unit, the angle of the water stream shall be 15 degrees maximum 602.7 Drinking Fountains for Standing Persons. Spout outlets of drinking fountains for standing persons shall be 38 inches (965 mm) minimum and 43 inches (1090 mm) maximum above the finish floor or


603 Toilet and Bathing Rooms 603.1 General. Toilet and bathing rooms shall comply with 603.

603.2 Clearances. Clearances shall comply with 603.2 603.2.1 Turning Space. Turning space complying with 304 shall be provided within the room.

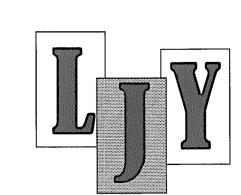

lester j young, architect 6304 royal lane dallas, texas 75230 214.455.7878

Date Revision 11.19.12 Revision

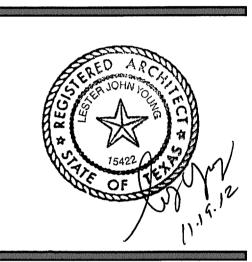

0



Checked by LY Drawing Number

Drawn by LY

### 2010 ADA Standards for Accessible Design for Public Accommodations and Commercial Facilities: Title III

### **CHAPTER 7: COMMUNICATION ELEMENTS AND FEATURES**

701.1 Scope. The provisions of Chapter 7 shall apply where required by Chapter 2 or where referenced by a requirement in this document. 702 Fire Alarm Systems

702.1 General. Fire alarm systems shall have permanently installed audible and visible alarms complying with NFPA 72 (1999 or 2002 edition) (incorporated by reference, see "Referenced Standards" in Chapter 1), except that the maximum allowable sound level of audible notification appliances complying with section 4-3.2.1 of NFPA 72 (1999 edition) shall have a sound level no more than 110 dB at the minimum hearing distance from the audible appliance. In addition, alarms in quest rooms required to provide communication features shall comply with sections 4-3 and 4-4 of NFPA 72 (1999 edition) or sections

7.4 and 7.5 of NFPA 72 (2002 edition). EXCEPTION: Fire alarm systems in medical care facilities shall be permitted to be provided in accordance with industry practice.

703.1 General. Signs shall comply with 703. Where both visual and tactile characters are required, either one sign with both visual and tactile characters, or two separate signs, one with visual, and one with tactile characters, shall be provided.

703.2 Raised Characters. Raised characters shall comply with 703.2 and shall be duplicated in braille complying with 703.3. Raised characters shall be installed in accordance with 703.4.

703.2.1 Depth. Raised characters shall be 1/32 inch (0.8 mm) minimum above their background. 703.2.2 Case. Characters shall be uppercase.

703.2.3 Style. Characters shall be sans serif. Characters shall not be italic, oblique, script, highly decorative, or of other unusual forms.

703.2.4 Character Proportions. Characters shall be selected from fonts where the width of the uppercase letter "0" is 55 percent minimum and 110 percent maximum of the height of the uppercase letter "1".

703.2.5 Character Height. Character height measured vertically from the baseline of the character shall be 5/8 inch (16 mm) minimum and 2 inches (51 mm) maximum based on the height of the uppercase EXCEPTION: Where separate raised and visual characters with the same information are provided, raised character height shall be permitted to be 1/2 inch (13 mm) minimum.

	distance between corresponding dots	distance between dots
(**************************************	in adjacent cells	in the same cell
LIBRARY		single braille cell
	distance between dots 🔭 🗘 🌑	• (• ()
	in the same cell	0 0 0 0 0 0 0 0 0 0 0 0 0 0 0 0 0 0 0
5/8-2 16-51	<b>†•</b> ○	blank cell space between words
	distance between corresponding dots	raised dot
×	noni one cen anceay actor	y base dismester
Figure 703.2.5 Height of Raised	1 1	VIVI WWW.
Characters	<b>₩•</b> ○ \	no reised dot
GIIGI GCICIO	Figure 703.3.1 Braille M	Measurement

703.2.6 Stroke Thickness. Stroke thickness of the uppercase letter "1" shall be 15 percent maximum of the height of the character.

703.2.7 Character Spacing. Character spacing shall be measured between the two closest points of adjacent raised characters within a message, excluding word spaces. Where characters have rectangular cross sections, spacing between individual raised characters shall be 1/8 inch (3.2 mm) minimum and 4 times the raised character stroke width maximum. Where characters have other cross sections, spacing between individual raised characters shall be 1/16 inch (1.6 mm) minimum and 4 times the raised character stroke width maximum at the base of the cross sections, and 1/8 inch (3.2 mm) minimum and 4 times the raised character stroke width maximum at the top of the cross sections. Characters shall be separated from raised borders and decorative elements 3/8 inch (9.5 mm) minimum.


703.2.8 Line Spacing. Spacing between the baselines of separate lines of raised characters within a message shall be 135 percent minimum and 170 percent maximum of the raised character height.


### 703.3 Braille. Braille shall be contracted (Grade 2) and shall comply with 703.3 and 703.4.

703.3.1 Dimensions and Capitalization. Braille dots shall have a domed or rounded shape and shall comply with Table 703.3.1. The indication of an uppercase letter or letters shall only be used before the first word of sentences, proper nouns and names, individual letters of the alphabet, initials, and

Table 703.3.1 Braille Dimensions		
Measurement Range	Minimum in Inches to Maximum in Inches	
Dot base diameter	0.059 (1.5 mm) to 0.063 (1.6 mm)	
Distance between two dots in the same cell	0.090 (2.3 mm) to 0.100 (2.5 mm) measured center to center	
Distance between corresponding dots in adjacent cells	0.241 (6.1 mm) to 0.300 (7.6 mm)measured center to center	
Dot height	0.025 (0.6 mm) to 0.037 (0.9 mm)	
Distance between corresponding dotsfrom one cell directly below	0.395 (10 mm) to 0.400 (10.2 mm)measured center to center	

703.3.2 Position. Braille shall be positioned below the corresponding text. If text is multi-lined, braille shall be placed below the entire text. Braille shall be separated 3/8 inch (9.5 mm) minimum from any other tactile characters and 3/8 inch (9.5 mm) minimum from raised borders and decorative elements. EXCEPTION: Braille provided on elevator car controls shall be separated 3/16 inch (4.8 mm) minimum and shall be located either directly below or adjacent to the corresponding raised characters or symbols.

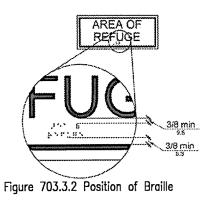

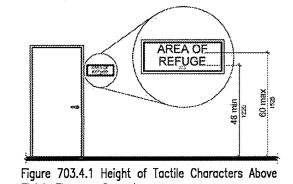

703.4 Installation Height and Location. Signs with tactile characters shall comply with 703.4.

703.4.1 Height Above Finish Floor or Ground. Tactile characters on signs shall be located 48 inches (1220 mm) minimum above the finish floor or ground surface, measured from the baseline of the lowest tactile character and 60 inches (1525 mm) maximum above the finish floor or ground surface, measured from the baseline of the highest tactile character. EXCEPTION: Tactile characters for elevator car controls shall not be required to comply with 703.4.1.

703.4.2 Location. Where a tactile sign is provided at a door, the sign shall be located alongside the door at the latch side. Where a tactile sign is provided at double doors with one active leaf, centered on tactile characters the sign shall be located on the inactive leaf. Where a tactile sign is provided at double doors with two active leafs, the sign shall be located to the right of the right hand door. Where there Figure 703.4.2 Location of is no wall space at the latch side of a single door or at the right side of double doors, signs shall be located on the nearest Tactile Signs at Doors

adjacent wall. Signs containing tactile characters shall be located so that a clear floor space of 18 inches (455 mm) minimum by 18 inches (455 mm) minimum, centered on the tactile characters, is provided beyond the arc of any door swing between the closed position and 45 degree open position. EXCEPTION: Signs with tactile characters shall be permitted on the push side of doors with closers and without hold-open devices.

703.5 Visual Characters. Visual characters shall comply with 703.5. EXCEPTION: Where visual characters comply with 703.2 and are accompanied by braille complying with 703.3, they shall not be required to comply with 703.5.2 through 703.5.9.

703.5.1 Finish and Contrast. Characters and their background shall have a non-glare finish. Characters shall contrast with their background with either light characters on a dark background or dark characters on a light background.

703.5.2 Case. Characters shall be uppercase or lowercase or a combination of both.

703.5.3 Style. Characters shall be conventional in form. Characters shall not be italic, oblique, script, highly 705.1 General. Detectable warnings shall consist of a surface of truncated domes and shall comply with decorative, or of other unusual forms.

703.5.4 Character Proportions. Characters shall be selected from fonts where the width of the uppercase letter "0" is 55 percent minimum and 110 percent maximum of the height of the uppercase letter "1".

703.5.5 Character Height. Minimum character height shall comply with Table 703.5.5. Viewing distance shall be measured as the horizontal distance between the character and an obstruction preventing further approach towards the sign. Character height shall be based on the uppercase letter "1".

ble 703.5.5 Visual Char	acter Height
-------------------------	--------------

Height to Finish Floor or Ground From Baseline of Character	Horizontal Viewing Distance	Minimum Character Height
40 inches (1015 mm) to less	less than 72 inches (1830 mm)	5/8 inch (16 mm)
than or equal to 70 inches (1780 mm)	72 inches (1830 mm) and greater	5/8 inch (16 mm), plus 1/8 inch (3.2 mm) per foot (305 mm) of viewing distance above 72 inches (1830 mm)
Greater than 70 inches (1780	less than 180 inches (4570 mm)	2 inch (51 mm)
mm) to less than or equal to 120 inches (3050 mm)	180 inches (4570 mm) and greater	2 inches (51 mm), plus 1/8 inch (3.2 mm) per foot (305 mm) of viewing distance above 180 inches (4570 mm)
Greater than 120 inches	less than 20 feet (6400 mm)	3 inch (75 mm)
(3050 mm)	21 feet (6400 mm) and greater	3 inches (75 mm), plus 1/8 inch (3.2 mm) per foot (305 mm) of viewing distance above 21 feet (6400 mm)

703.5.6 Height From Finish Floor or Ground, Visual characters shall be 40 inches (1015 mm) minimum above the finish floor or ground.

EXCEPTION: Visual characters indicating elevator car controls shall not be required to comply with 703.5.6 703.5.7 Stroke Thickness, Stroke thickness of the uppercase letter "I" shall be 10 percent minimum and percent maximum of the height of the character.

703.5.8 Character Spacing. Character spacing shall be measured between the two closest points of adjacent characters, excluding word spaces. Spacing between individual characters shall be 10 percent minimum and 706.6 Peak Clipping Level. Peak clipping shall not exceed 18 dB of clipping relative to the peaks of 35 percent maximum of character height.

703.5.9 Line Spacing. Spacing between the baselines of separate lines of characters within a message shall 707 Automatic Teller Machines and Fare Machines be 135 percent minimum and 170 percent maximum of the character height.

703.6 Pictograms. Pictograms shall comply with 703.6 703.6.1 Pictogram Field. Pictograms shall have a field height of 6

inches (150 mm) minimum. Characters and braille shall not be located in the pictogram field. 703.6.2 Finish and Contrast. Pictograms and their field shall have a non-glare finish. Pictograms shall contrast with their field with either

a light pictogram on a dark field or a dark pictogram on a light 703.6.3 Text Descriptors. Pictograms shall have text descriptors

background or a dark symbol on a light background.

located directly below the pictogram field. Text descriptors shall comply with 703.2, 703.3 and 703.4. 703.7 Symbols of Accessibility. Symbols of accessibility shall comply with 703.7.


703.7.1 Finish and Contrast. Symbols of accessibility and their background shall have a non-glare finish. lymbols of accessibility shall contrast with their background with either a light symbol on a dark

703.7.2.1 International Symbol of Accessibility. The International Symbol of Accessibility shall comply with

703.7.2.2 International Symbol of TTY. The International Symbol of TTY shall comply with Figure 703.7.2.2. 703.7.2.3 Volume Control Telephones. Telephones with a volume control shall be identified by a pictogram of a telephone handset with radiating sound waves on a square field such as shown in Figure 703.7.2.3.

703.7.2.4 Assistive Listening Systems. Assistive listening systems shall be identified by the International Symbol of Access for Hearing Loss complying with Figure 703.7.2.4.



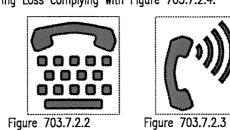





International Symbol of

Access for Hearing Loss

Figure 703.6.1 Pictogram Field

International Symbol of International Symbol of

### 704.1 General. Public telephones shall comply with 704.

704.2 Wheelchair Accessible Telephones. Wheelchair accessible telephones shall comply with 704.2.

704.2.1 Clear Floor or Ground Space. A clear floor or ground space complying with 305 shall be provided

The clear floor or ground space shall not be obstructed by bases, enclosures, or seats. 704.2.1.1 Parallel Approach. Where a parallel approach is provided, the distance from the edge of the telephone enclosure to the face of the telephone unit shall be 10 inches (255 mm) maximum. 704.2.1.2 Forward Approach. Where a forward approach is provided, the distance from the front edge of a counter within Figure 704.2.1.1 Parallel Figure 704.2.1.2 Forward the telephone enclosure to the face of the Approach to Telephone Approach to Telephone telephone unit shall be 20 inches (510

704.2.2 Operable Parts. Operable parts shall comply with 309. Telephones shall have push-button controls where such service is available.

704.2.3 Telephone Directories. Telephone directories, where provided, shall be located in accordance with

704.2.4 Cord Length. The cord from the telephone to the handset shall be 29 inches (735 mm) long

704.3 Volume Control Telephones. Public telephones required to have volume controls shall be equipped with a receive volume control that provides a gain adjustable up to 20 dB minimum. For incremental volume control, provide at least one intermediate step of 12 dB of gain minimum. An automatic reset

704.4 TTYs. TTYs required at a public pay telephone shall be permanently affixed within, or adjacent to, the telephone enclosure. Where an acoustic coupler is used, the telephone cord shall be sufficiently long to allow connection of the TTY and the telephone receiver.

704.4.1 Height. When in use, the touch surface of TTY keypads shall be 34 inches (865 mm) minimum EXCEPTION: Where seats are provided, TTYs shall not be required to comply with 704.4.1

704.5 TTY Shelf. Public pay telephones required to accommodate portable TTYs shall be equipped with a shelf and an electrical outlet within or adjacent to the telephone enclosure. The telephone handset shall be capable of being placed flush on the surface of the shelf. The shelf shall be capable of accommodating a 801 General TTY and shall have 6 inches (150 mm) minimum vertical clearance above the area where the TTY is to be

### 705 Detectable Warnings

systems shall be 18 dB minimum.

705.1.1 Dome Size. Truncated domes in a detectable warning surface shall have a base diameter of 0.9 inch (23 mm) minimum and 1.4 inches (36 mm) maximum, a top diameter of 50 percent of the base diameter minimum to 65 percent of the base diameter maximum, and a height of 0.2 inch (5.1 mm).

705.1.2 Dome Spacing. Truncated domes in a detectable warning surface shall have a center-to-center spacing of 1.6 inches (41 mm) minimum and 2.4 inches (61 mm) maximum, and a base-to-base spacing of 0.65 inch (17 mm) minimum, measured between the most adjacent domes on a square grid. 705.1.3 Contrast. Detectable warning surfaces shall contrast visually with adjacent walking surfaces either

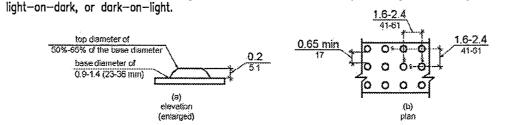


Figure 705.1 Size and Spacing of Truncated Domes 705.2 Platform Edges. Detectable warning surfaces at platform boarding edges shall be 24 inches (610 mm) wide and shall extend the full length of the public use areas of the platform.

706.1 General. Assistive listening systems required in assembly areas shall comply with 706.

706.2 Receiver Jacks. Receivers required for use with an assistive listening system shall include a 1/8 inch (3.2 mm) standard mono jack.

706.3 Receiver Hearing-Aid Compatibility. Receivers required to be hearing-aid compatible shall interface with telecoils in hearing aids through the provision of neckloops.

706.4 Sound Pressure Level. Assistive listening systems shall be capable of providing a sound pressure level of 110 dB minimum and 118 dB maximum with a dynamic range on the volume control of 50 dB.

707.1 General. Automatic teller machines and fare machines shall comply with 707.

707.2 Clear Floor or Ground Space. A clear floor or ground space complying with 305 shall be provided. EXCEPTION: Clear floor or ground space shall not be required at drive-up only automatic teller machines and fare machines.

707.3 Operable Parts. Operable parts shall comply with 309. Unless a clear or correct key is provided, each operable part shall be able to be differentiated by sound or touch, without activation. EXCEPTION: Drive-up only automatic teller machines and fare machines shall not be required to comply with 309.2 and 309.3.

707.4 Privacy. Automatic teller machines shall provide the opportunity for the same degree of privacy of input and output available to all individuals.

707.5 Speech Output. Machines shall be speech enabled. Operating instructions and orientation, visible be accessible to and independently usable by individuals with vision impairments. Speech shall be delivered afforded lines of sight over the heads of standing spectators in the first row in front of wheelchair spaces. through a mechanism that is readily available to all users, including but not limited to, an industry standard connector or a telephone handset. Speech shall be recorded or digitized human, or synthesized. 1. Audible tones shall be permitted instead of speech for visible output that is not displayed for security purposes, including but not limited to, asterisks representing personal identification numbers.

2. Advertisements and other similar information shall not be required to be audible unless they convey information that can be used in the transaction being conducted.

3. Where speech synthesis cannot be supported, dynamic alphabetic output shall not be required to be

707.5.1 User Control. Speech shall be capable of being repeated or interrupted. Volume control shall be provided for the speech function. EXCEPTION: Speech output for any single function shall be permitted to be automatically interrupted when a transaction is selected.

707.5.2 Receipts. Where receipts are provided, speech output devices shall provide audible balance inquiry information, error messages, and all other information on the printed receipt necessary to complete or verify the transaction. **FXCFPTIONS** 

1. Machine location, date and time of transaction, customer account number, and the machine identifier 802.3 Companion Seats. Companion seats shall comply with 802.3. shall not be required to be audible. 2. Information on printed receipts that duplicates information available on-screen shall not be required to be presented in the form of an audible receipt.

3. Printed copies of bank statements and checks shall not be required to be audible.

### 707.6 Input. Input devices shall comply with 707.6.

control shall be provided for each function. Where provided, key surfaces not on active areas of display screens, shall be raised above surrounding surfaces. Where membrane keys are the only method of input, each shall be tactilely discernable from surrounding surfaces and adjacent keys. 12-key 707.6.2 Numeric Keys. Numeric keys shall be arranged in a descending ascending

12-key ascending or descending telephone keypad layout. The number five key shall be tactilely distinct from the other keys.

707.6.1 Input Controls. At least one tactilely discernible input

Figure 707.6.2 Numeric Key Layout

707.6.3 Function Keys. Function keys shall comply with 707.6.3.

707.6.3.1 Contrast. Function keys shall contrast visually from background surfaces. Characters and symbols 803.2 Turning Space. Turning space complying with 304 shall be provided within the room. on key surfaces shall contrast visually from key surfaces. Visual contrast shall be either light-on-dark or EXCEPTION: Tactile symbols required by 707.6.3.2 shall not be required to comply with 707.6.3.1.

707.6.3.2 Tactile Symbols. Function key surfaces shall have tactile symbols as follows: Enter or Proceed kev: raised circle: Clear or Correct key: raised left arrow; Cancel key: raised letter ex; Add Value key: raised plus sign; Decrease Value key: raised minus sign.

707.7 Display Screen. The display screen shall comply with 707.7. EXCEPTION: Drive-up only automatic teller machines and fare machines shall not be required to comply

707.7.1 Visibility. The display screen shall be visible from a point located 40 inches (1015 mm) above the center of the clear floor space in front of the machine. 707.7.2 Characters. Characters displayed on the screen shall be in a sans serif font. Characters shall be

3/16 inch (4.8 mm) high minimum based on the uppercase letter "I". Characters shall contrast with their background with either light characters on a dark background or dark characters on a light background. 707.8 Braille Instructions. Braille instructions for initiating the speech mode shall be provided. Braille shall

708 Two-Way Communication Systems 708.1 General. Two-way communication systems shall comply with 708.

708.2 Audible and Visual Indicators. The system shall provide both audible and visual signals.

708.3 Handsets. Handset cords, if provided, shall be 29 inches (735 mm) long minimum.

### **CHAPTER 8: SPECIAL ROOMS. SPACES AND ELEMENTS**

comply with 802.2.

801.1 Scope. The provisions of Chapter 8 shall apply where required by Chapter 2 or where referenced by a requirement in this document.

802 Wheelchair Spaces, Companion Seats, and Designated Aisle Seats

802.1 Wheelchair Spaces. Wheelchair spaces shall comply with 802.1.

802.1.1 Floor or Ground Surface. The floor or ground surface of wheelchair spaces shall comply with 302. Changes in level are not permitted. EXCEPTION: Slopes not steeper than 1:48 shall be permitted.

33 min \_ 33 min 802,1.2 Width. A single wheelchair space shall be 36 inches (915 mm) wide minimum Where two adjacent wheelchair spaces are provided, each wheelchair space shall be 33 inches (840 mm) wide minimum. 802.1.3 Depth. Where a wheelchair space can be entered from the front or rear, the wheelchair space shall be 48 inches (1220 two spaces single space mm) deep minimum. Where a wheelchair Figure 802.1.2 Width of Wheelchair Spaces in Assembly Areas space can be entered only from the side,


the wheelchair space shall be 60 inches (1525 mm) deep minimum. 802.1.4 Approach. Wheelchair spaces shall adjoin accessible routes. Accessible routes shall not overlap wheelchair spaces. 802.1.5 Overlap. Wheelchair spaces shall not overlap circulation paths.

802.2 Lines of Sight. Lines of sight to the front or rear screen, performance area, or playing field for spectators in wheelchair spaces shall

Figure 802.1.3 Depth of Wheelchair Spaces in Assembly Areas spectators in wheelchair spaces shall be afforded lines of sight complying with 802.2.1.

802.2.1.1 Lines of Sight Over Heads. Where spectators are provided lines of sight over the heads of spectators seated in the first row in front of their seats, spectators seated in wheelchair spaces shall be afforded lines of sight over the heads of seated spectators in the first row in front of wheelchair spaces.


706.5 Signal-to-Noise Ratio. The signal-to-noise ratio for internally generated noise in assistive listening 802.2.1.2 Lines of Sight Between Heads. Where spectators are provided lines of sight over the shoulders and between the heads of spectators seated in the first row in front of their seats, spectators seated in wheelchair spaces shall be afforded lines of sight over the shoulders and between the heads of seated

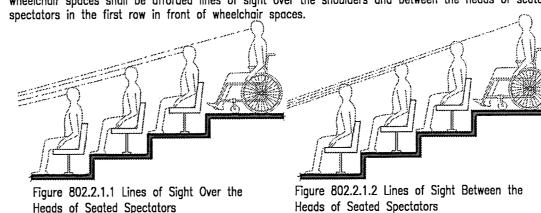

802.2.2 Lines of Sight Over Standing Spectators. Where spectators are expected to stand during events, spectators in wheelchair spaces shall be afforded lines of sight complying with 802.2.2.

802.2.2.1 Lines of Sight Over Heads. Where standing spectators are provided lines of sight over the heads transaction prompts, user input verification, error messages, and all displayed information for full use shall spectators standing in the first row in front of their seats, spectators seated in wheelchair spaces shall be

802.2.2.2 Lines of Sight Between Heads. Where standing spectators are provided lines of sight over the shoulders and between the heads of spectators standing in the first row in front of their seats, spectators seated in wheelchair spaces shall be afforded lines of sight over the shoulders and between the heads of 804.3.2 Height. The kitchen work surface shall be 34 inches (865 mm) maximum above the finish floor

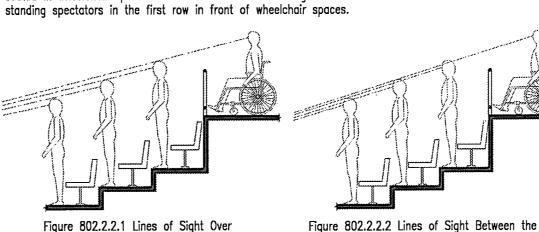

the Heads of Standing Spectators Heads of Standing Spectators

802.3.1 Alignment. In row seating, companion seats shall be located to provide shoulder alignment with adjacent wheelchair spaces. The shoulder alignment point of the wheelchair space shall be measured 36 inches (915 mm) from the front of the wheelchair space. The floor surface of the companion seat shall be at the same elevation as the floor surface of the wheelchair space.

802.3.2 Type. Companion seats shall be equivalent in size, quality, comfort, and amenities to the seating in the immediate area. Companion seats shall be permitted to be movable.

802.4 Designated Aisle Seats. Designated aisle seats shall comply with 802.4. 802.4.1 Armrests. Where armrests are provided on the seating in the immediate area, folding or

802.4.2 Identification. Each designated aisle seat shall be identified by a sign or marker. 803 Dressing, Fitting, and Locker Rooms

retractable armrests shall be provided on the aisle side of the seat.

803.1 General. Dressing, fitting, and locker rooms shall comply with 803.

803.4 Benches. A bench complying with 903 shall be provided within the room.

803.3 Door Swing. Doors shall not swing into the room unless a clear floor or ground space complying with 305.3 is provided beyond the arc of the door swing.

803.5 Coat Hooks and Shelves. Coat hooks provided within the room shall be located within one of the reach ranges specified in 308. Shelves shall be 40 inches (1015 mm) minimum and 48 inches (1220 mm) maximum above the finish floor or ground.

804 Kitchens and Kitchenettes

804.1 General. Kitchens and kitchenettes shall comply with 804.

804.2 Clearance. Where a pass through kitchen is provided, clearances shall comply with 804.2.1. Where a U-shaped kitchen is provided, clearances shall comply with 804.2.2. EXCEPTION: Spaces that do not provide a cooktop or conventional range shall not be required to comply

Advisory 804.2 Clearance. Clearances are measured from the furthest projecting face of all opposing base cabinets, counter tops, appliances, or walls, excluding hardware.

804.2.1 Pass Through Kitchen. In pass through kitchens where counters, appliances or cabinets are on tw opposing sides, or where counters, appliances or cabinets are opposite a parallel wall, clearance between all opposing base cabinets, counter tops, appliances, or walls within kitchen work areas shall be 40 inches (1015 mm) minimum. Pass through kitchens shall have two entries.


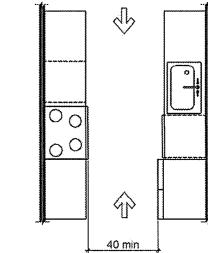


Figure 804.2.1 Pass Through Kitchens

,804.2.2 U-Shaped. In U-shaped kitchens enclosed on three contiguous sides, clearance between all 802.2.1 Lines of Sight Over Seated Spectators. Where spectators are expected to remain seated during events apposing base cabinets, counter tops, appliances, or walls within kitchen work areas shall be 60 inches (1525 mm) minimum.

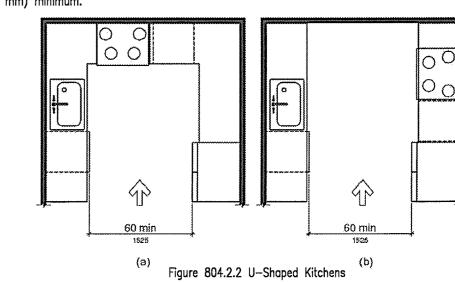

804.3 Kitchen Work Surface. In residential dwelling units required to comply with 809, at least one 30 inches (760 mm) wide minimum section of counter shall provide a kitchen work surface that complies 804.3.1 Clear Floor or Ground Space. A clear floor space complying with 305 positioned for a forward approach shall be provided. The clear floor or ground space shall be centered on the kitchen work surface and shall provide knee and toe clearance complying with 306. EXCEPTION: Cabinetry shall be permitted under the kitchen work surface provided that all of the following

(a) the cabinetry can be removed without removal or replacement of the kitchen work surface; b) the finish floor extends under the cabinetry; and

EXCEPTION: A counter that is adjustable to provide a kitchen work surface at variable heights, 29 inches

(735 mm) minimum and 36 inches (915 mm) maximum, shall be permitted. 804.3.3 Exposed Surfaces. There shall be no sharp or abrasive surfaces under the work surface

804.4 Sinks. Sinks shall comply with 606. 804.5 Storage. At least 50 percent of shelf space in storage facilities shall comply with 811.

804.6 Appliances. Where provided, kitchen appliances shall comply with 804.6.

804.6.1 Clear Floor or Ground Space. A clear floor or ground space complying with 305 shall be provided at each kitchen appliance. Clear floor or ground spaces shall be permitted to overlap.

804.6.2 Operable Parts. All appliance controls shall comply with 309. 1. Appliance doors and door latching devices shall not be required to comply with 309.4.

or electrical shock. The location of controls shall not require reaching across burners.

2. Bottom-hinged appliance doors, when in the open position, shall not be required to comply with

dishwasher door, in the open position, shall not obstruct the clear floor or ground space for the 804.6.4 Range or Cooktop. Where a forward approach is provided, the clear floor or ground space shall provide knee and toe clearance complying with 306. Where knee and toe space is provided, the underside of the range or cooktop shall be insulated or otherwise configured to prevent burns, abrasions,

804.6.3 Dishwasher. Clear floor or ground space shall be positioned adjacent to the dishwasher door. The

804.6.5 Oven. Ovens shall comply with 804.6.5.

804.6.5.1 Side-Hinged Door Ovens. Side-hinged door ovens shall have the work surface required by 804.3 positioned adjacent to the latch side of the oven door.

804.6.5.2 Bottom-Hinged Door Ovens. Bottom-hinged door ovens shall have the work surface required by 804.3 positioned adjacent to one side of the door.

804.6.5.3 Controls. Ovens shall have controls on front panels.


804.6.6 Refrigerator/Freezer. Combination refrigerators and freezers shall have at least 50 percent of the freezer space 54 inches (1370 mm) maximum above the finish floor or ground. The clear floor or ground space shall be positioned for a parallel approach to the space dedicated to a refrigerator/freezer with the centerline of the clear floor or ground space offset 24 inches (610 mm) maximum from the centerline of the dedicated space.

805 Medical Care and Long-Term Care Facilities 805.1 General. Medical care facility and long—term care facility patient or resident sleeping rooms required to provide mobility features shall comply with 805.


805.2 Turning Space. Turning space complying with 304 shall be provided within the room.

805.3 Clear Floor or Ground Space. A clear floor space complying with 305 shall be provided on each side of the bed. The clear floor space shall be positioned for parallel approach to the side of the bed.

805.4 Toilet and Bathing Rooms. Toilet and bathing rooms that are provided as part of a patient or resident sleeping room shall comply with 603. Where provided, no fewer than one water closet, one lavatory, and one bathtub or shower shall comply with the applicable requirements of 603 through 610.

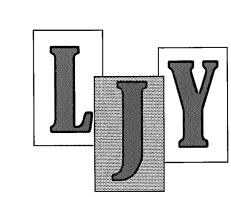

lester j young, architect 6304 royal lane dallas, texas 75230 214.455.7878

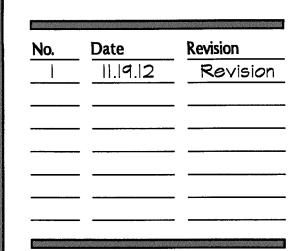



30 Be



10.22.12 Drawn by

Drawing Numbe

Checked by LY

### GENERAL PLAN NOTES:

I. GENERAL CONTRACTOR TO VERIFY ALL DIMENSIONS PRIOR TO CONSTRUCTION, ARCHITECT SHALL BE NOTIFIED OF ANY DISCREPANCY PRIOR TO PROCEEDING.

2. GENERAL CONTRACTOR SHALL VERIFY ALL MFR. INSTALLATION REQUIREMENTS, DIMENSIONS OF ALL FIXTURES AND APPLICANCES PRIOR TO CONSTRUCTION.


3. DRAWINGS DEPICT ARCHITECT'S UNDERSTANDING OF EXISTING CONDITIONS, NOTIFY ARCHITECT OF ANY DISCREPANCY BETWEEN DRAWINGS AND EXISTING CONDITIONS PRIOR TO CONSTRUCTION.

4. REFER TO ACCESSIBILITY NOTES ON SHEET AO.I AND AO.2

5. IF ANY TREE ROOTS NEED TO BE REMOVED, MAKE CLEAN CUTS TO ROOT. 6. REWORK IRRIGATION SYSTEM AS NEEDED, PROVIDE SLEEVES UNDER NEW CONCRETE.

I. CONCRETE FOR HANDICAP RAMP SLABS AND BEAMS SHALL BE F'C = 3,000 PSI NORMAL WEIGHT CONCRETE


- 2. PROVIDE A 3/4" CHAMFER AT ALL EXPOSED EDGES OF THE HANDICAP RAMP.
- 3. PROVIDE GRADE 60 REINFORCEMENT FOR ALL HANDICAP RAMP SLABS AND BEAMS.
- 4. CLEAN ALL FORMS WITH A WIRE BRUSH BEFORE PLACING CONCRETE

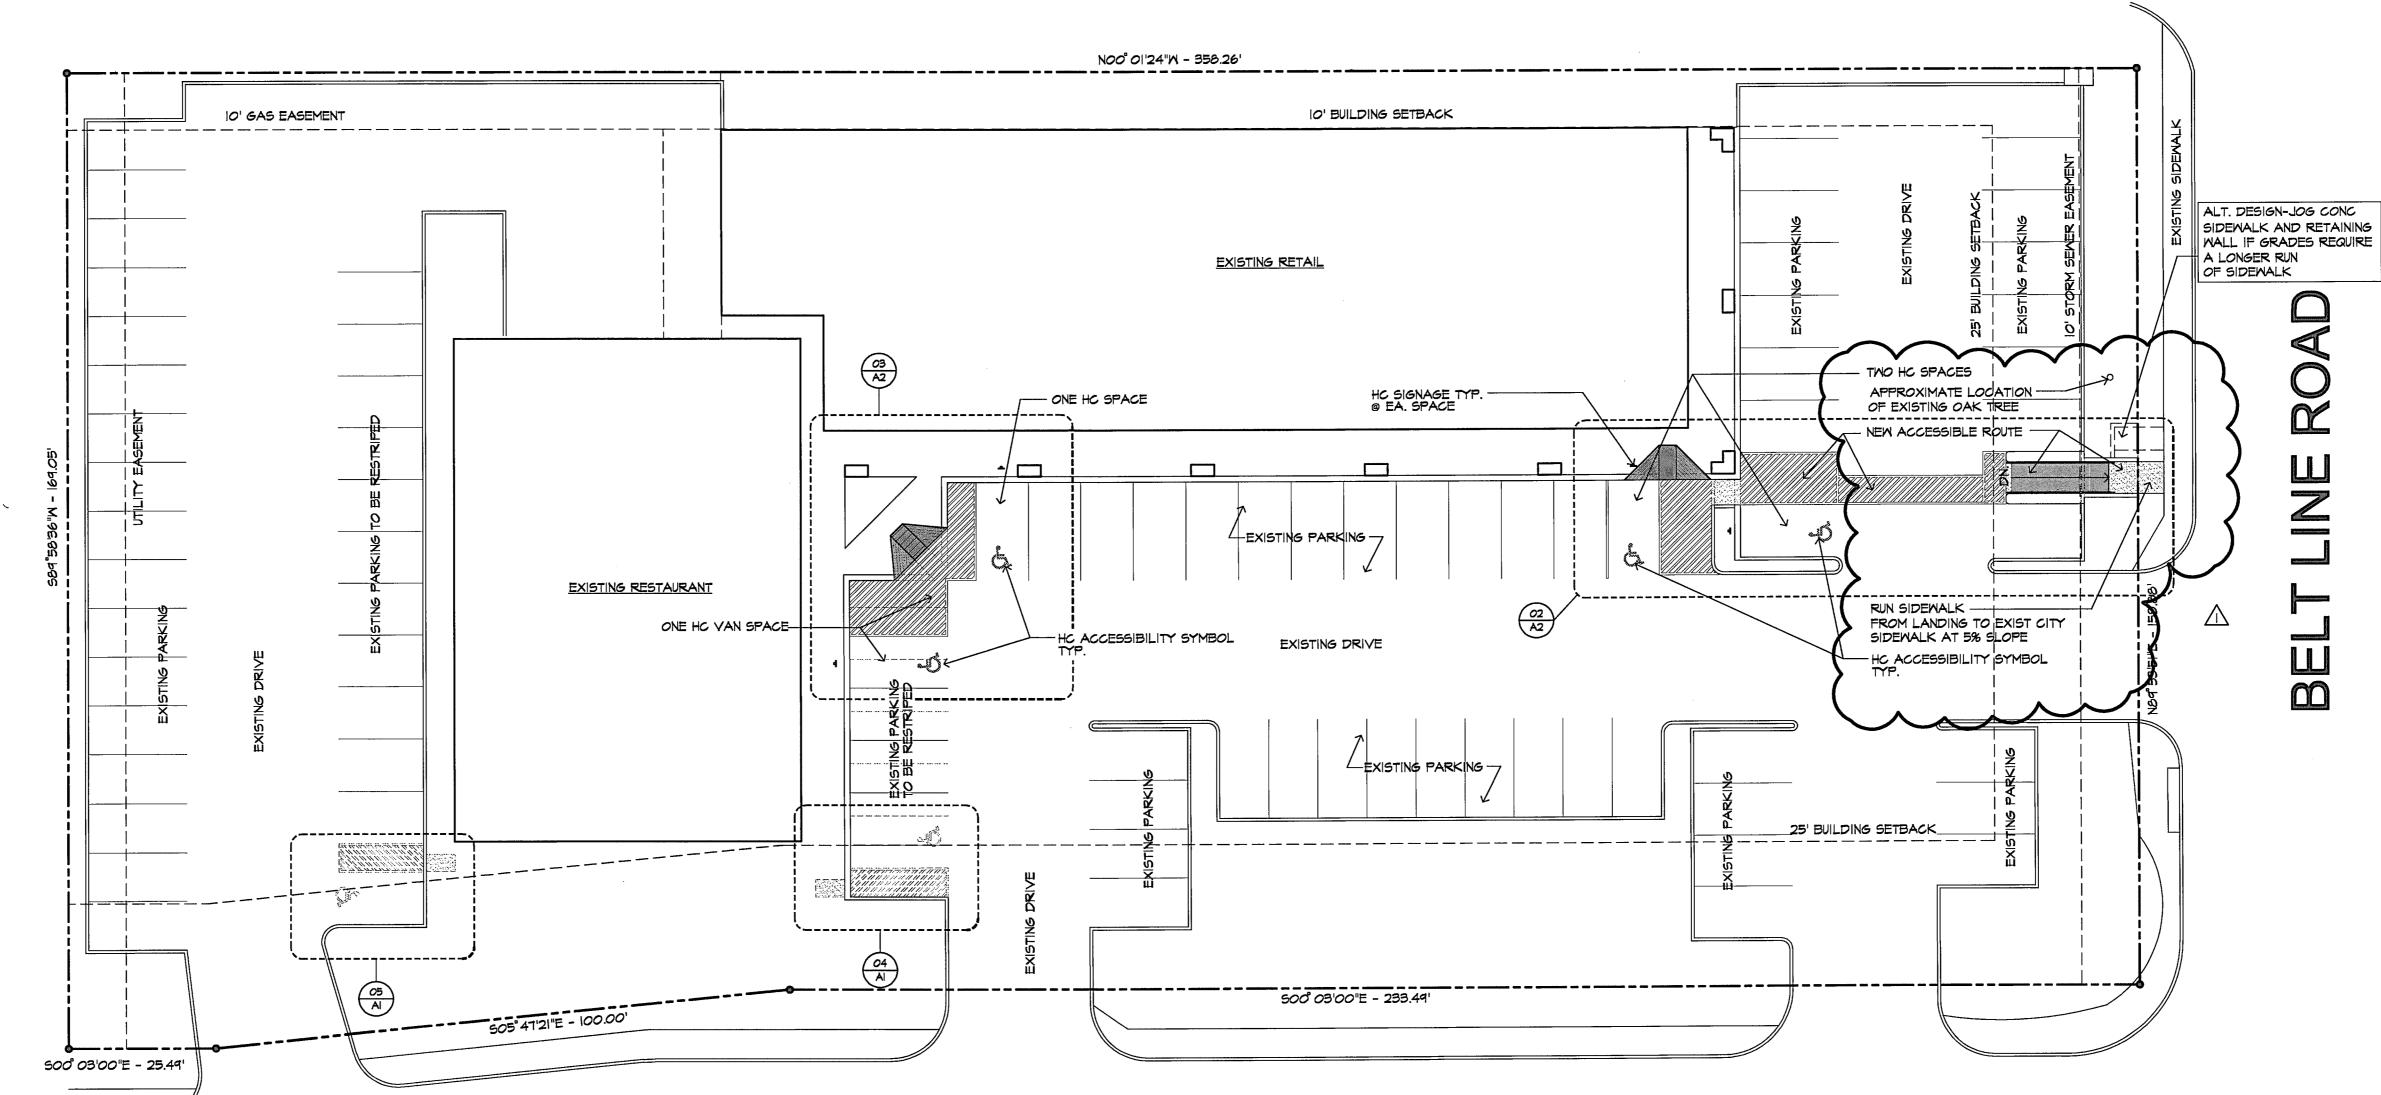

I. GROUND AND FLOOR SURFACES ALONG ACCESSIBLE ROUTES AND IN ACCESSIBLE ROOMS AND SPACES INCLUDING FLOORS, WALKS, RAMPS, AND CURB RAMPS, SHALL BE STABLE, FIRM, SLIP-RESISTANT, AND SHALL COMPLY WITH 4.5

2. OBJECTS PROJECTING FROM WALLS WITH THIER LEADING EDGES BETWEEN 27" AND 80" ABOVE FINISHED FLOOR SHALL PROTRUDE NO MORE THAN 4" INTO WALKS, HALLS, CORRIDORS, PASSAGEWAYS, OR AISLES. OBJECTS MOUNTED WITH THIER LEADING EDGEES AT OR BELOW 27" ABOVE THE FINISHED FLOOR MAY PROTRUDE ANY AMOUNT. SEE SECTION 4.4.1 ON SHEET TOOS AND TOO4.


BELTWAY DRIVE

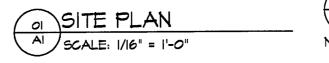




OWNER OR OWNER'S REP TO CONFIRM ALLOWABLE DEVIATIONS IN EXISTING CONCRETE SLOPE - NOTIFY ARCHITECT

AND CONTRACTOR

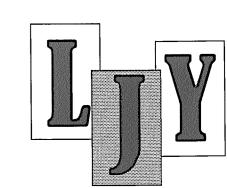


lester j young, architect 6304 royal lane dallas, texas 75230 214.455.7878


lo.	Date	Revision
	11.19.12	Revision

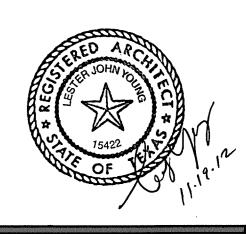


SITE


Checked by LY

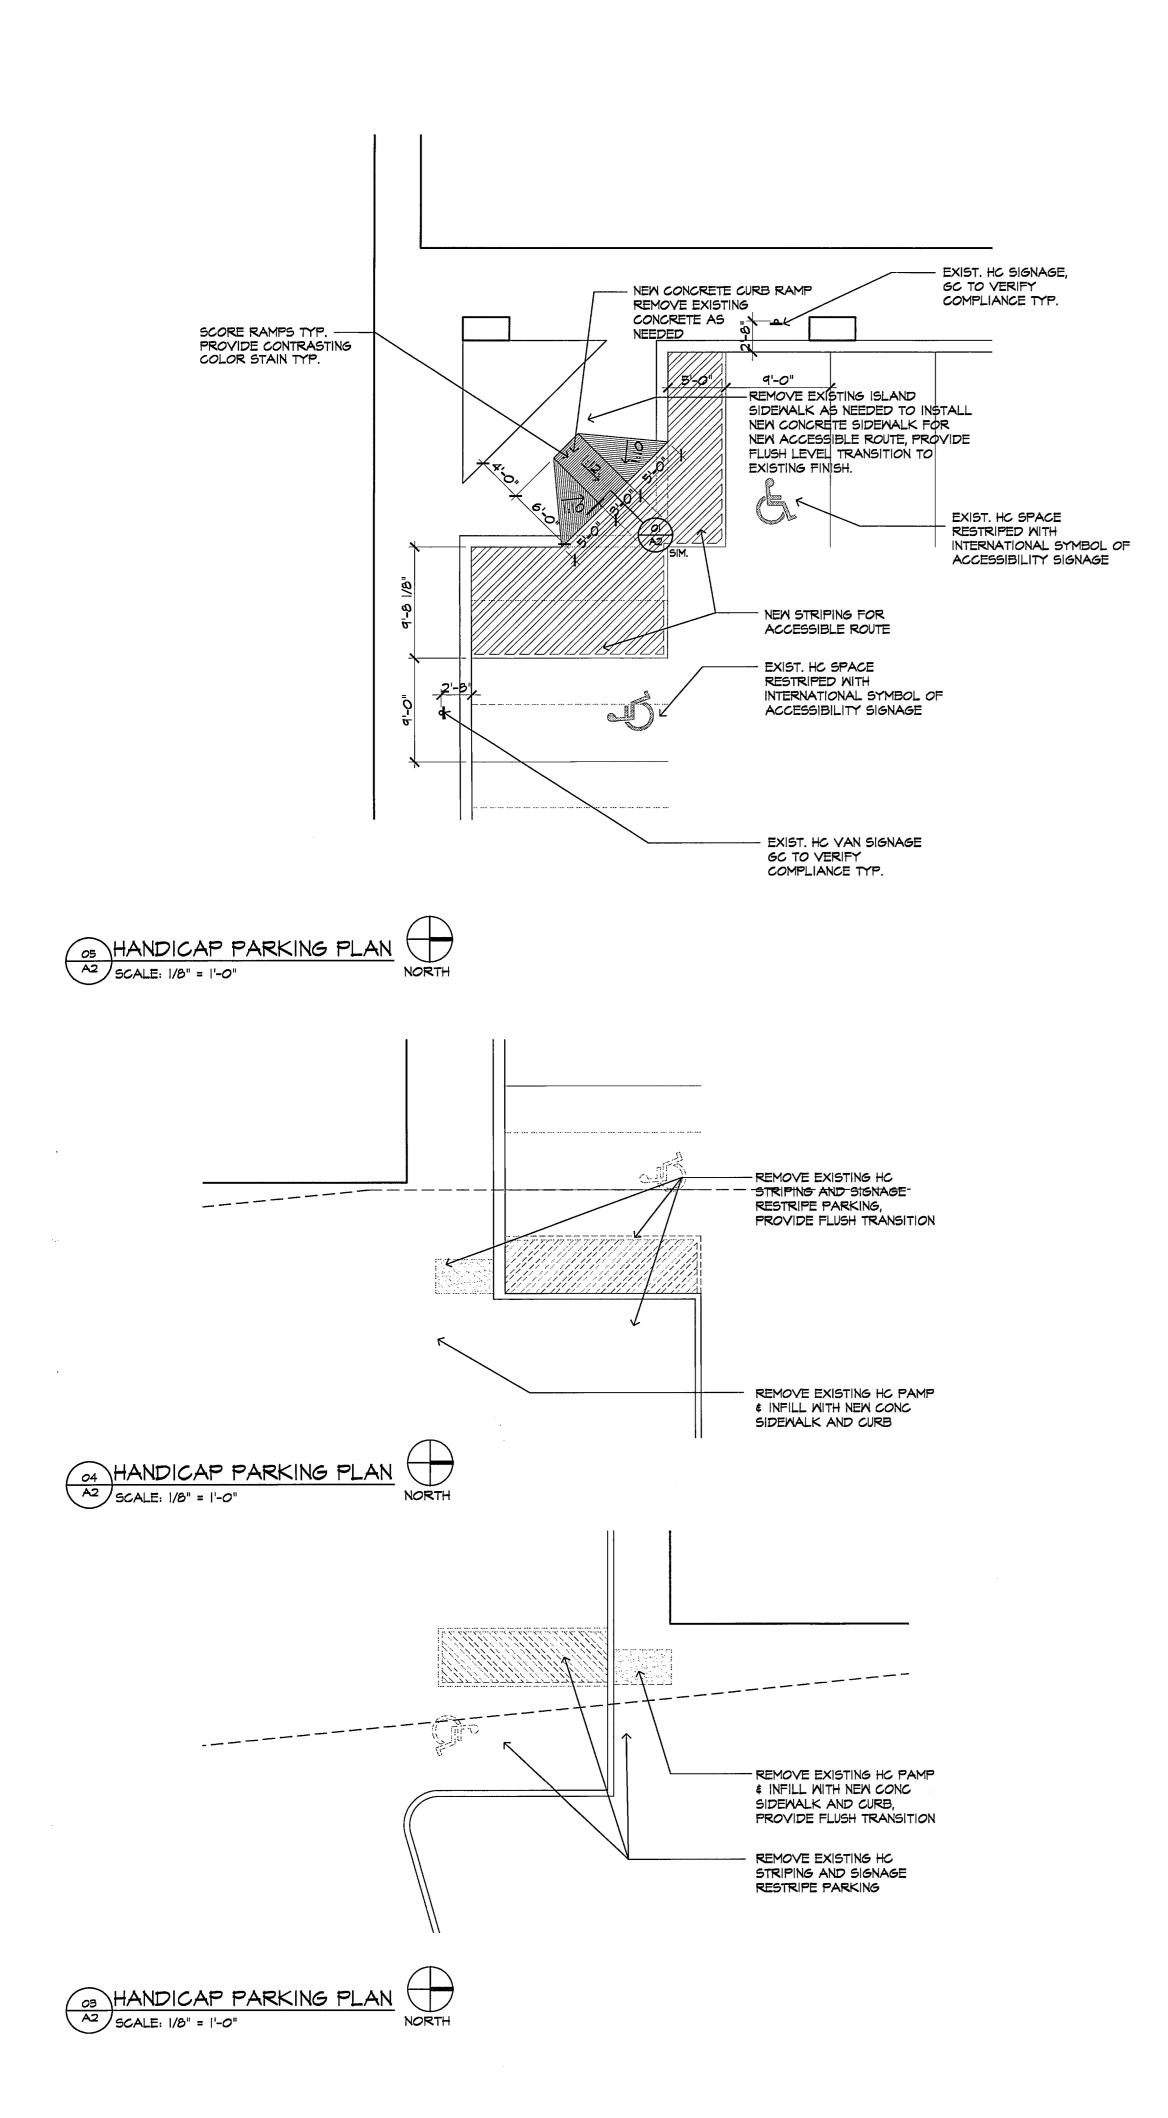

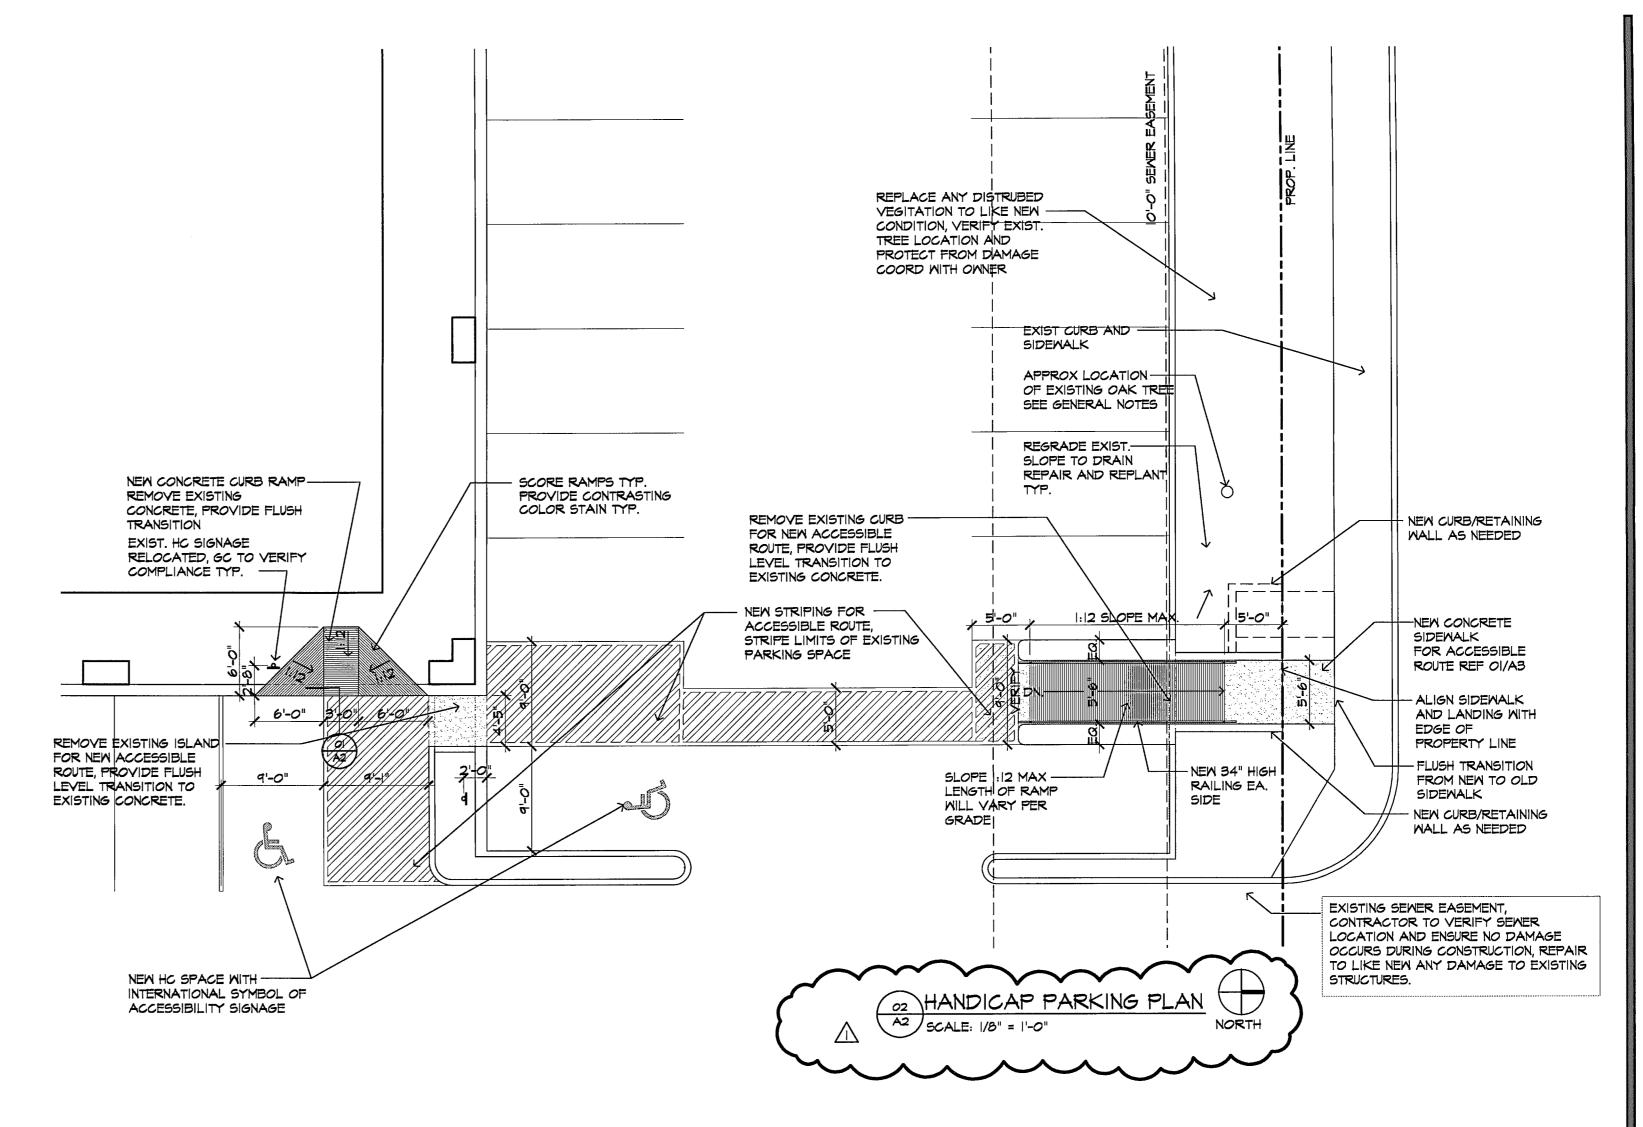

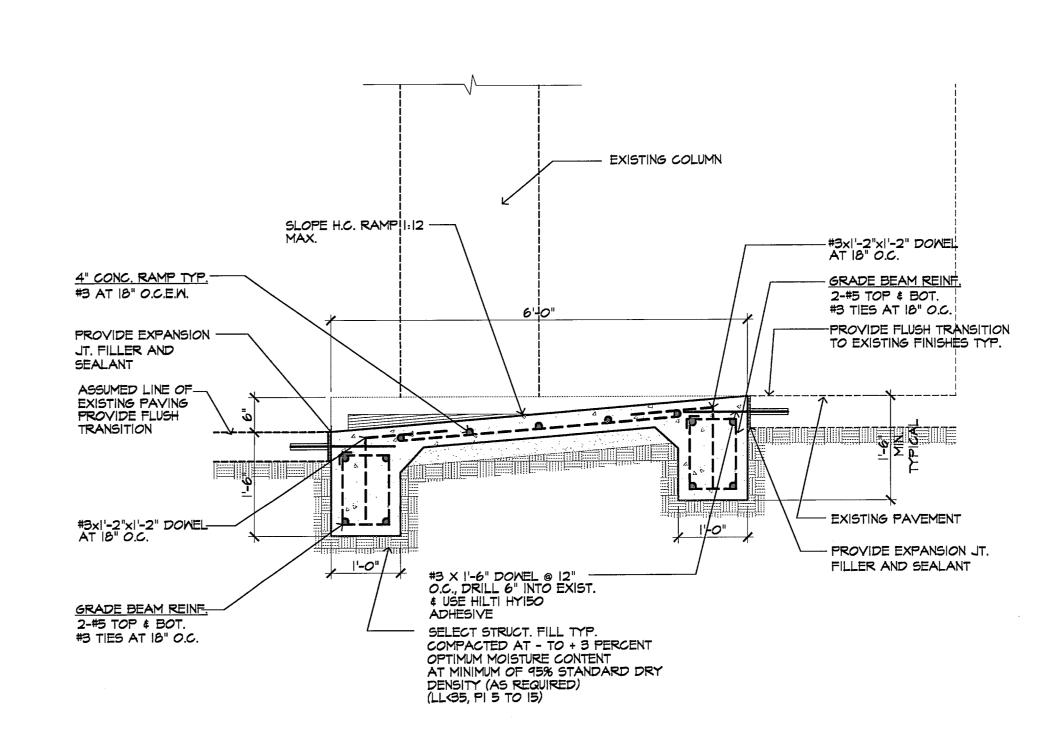


OI HANDICAP RAMP SECTION
A2 SCALE: 3/4" = 1'-0"

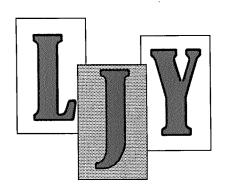


lester j young, architect 6304 royal lane dallas, texas 75230 214.455.7878


No.	Date	Revision
	11.19.12	Revision
		-

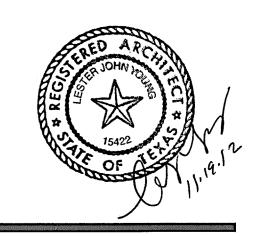

LARGE **PLANS** 


Project 10.22.12 Date Drawn by Checked by LY

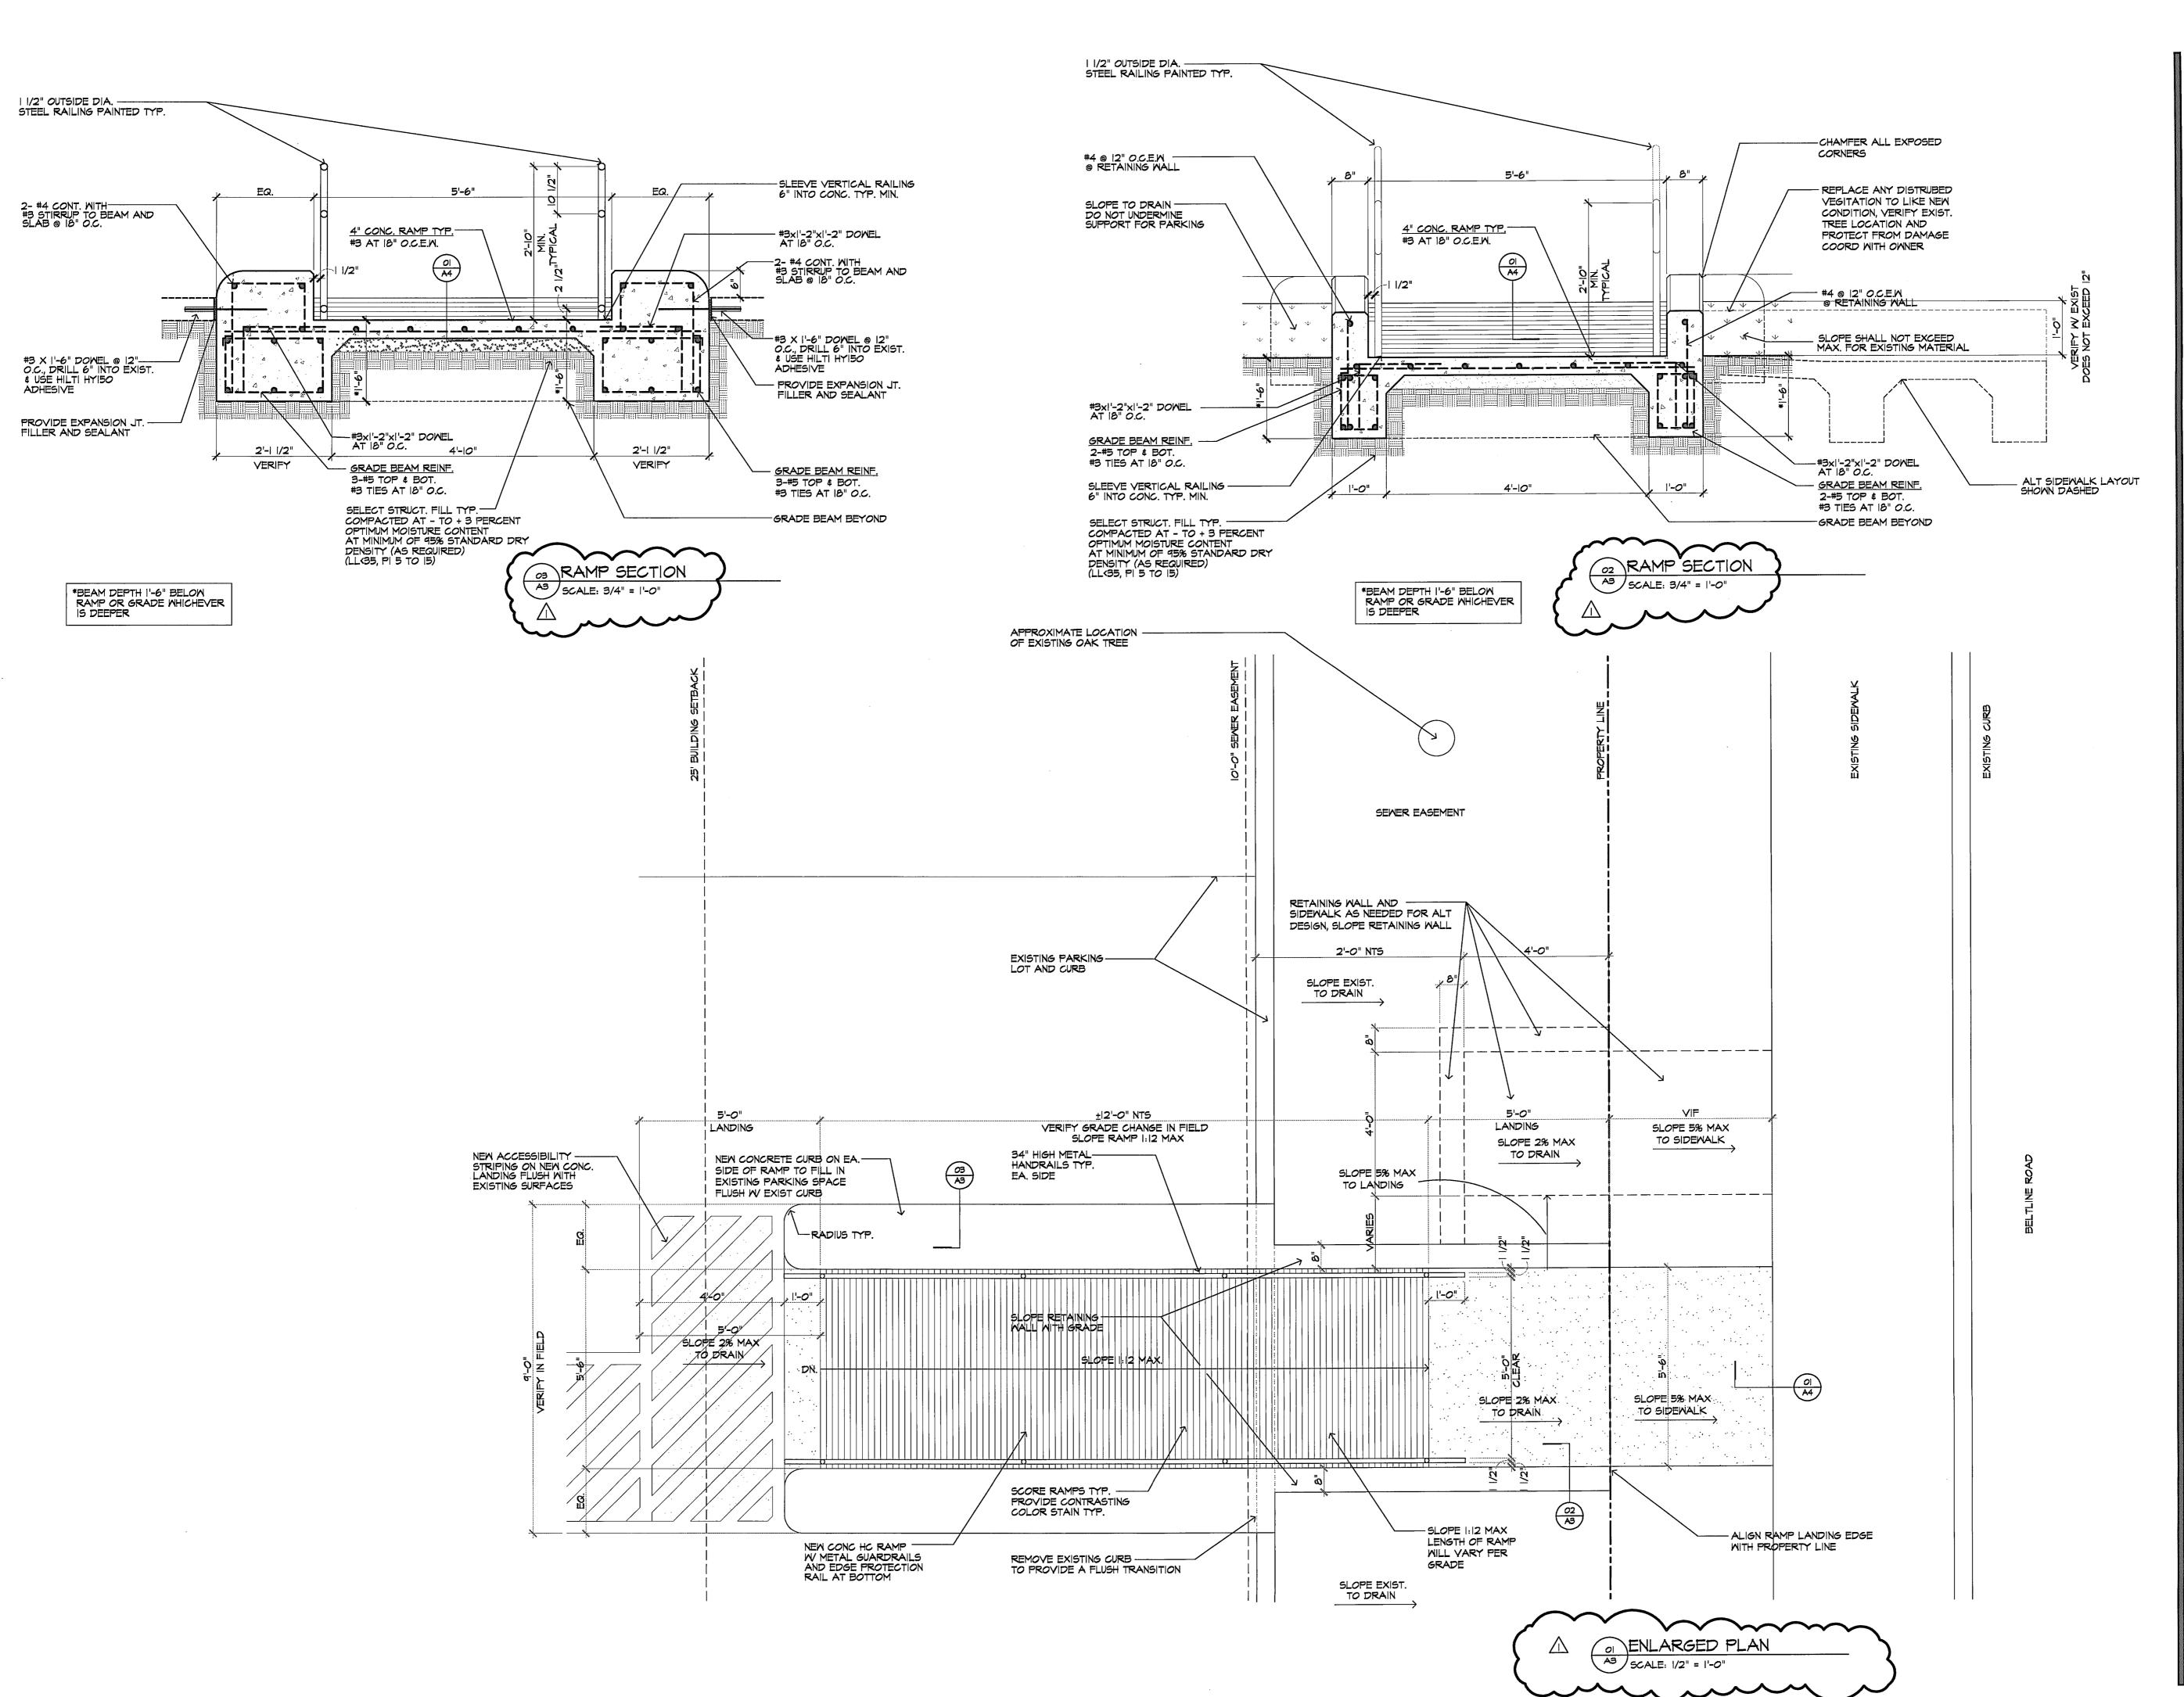

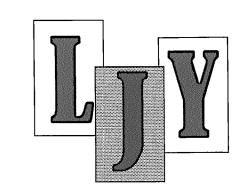

lester j young, architect 6304 royal lane dallas, texas 75230 214.455.7878


No.	Date	Revision
	11.19.12	Revision
	<del></del>	<u> </u>
	<u></u>	_ <del></del>
		<u> </u>

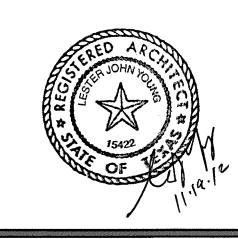

ACCESSIBILITY Improvements for ADDISON MARKET


LARGE PLAN SECTIONS

Project	120
Date	0.22.
Drawn by	L
Checked by	·

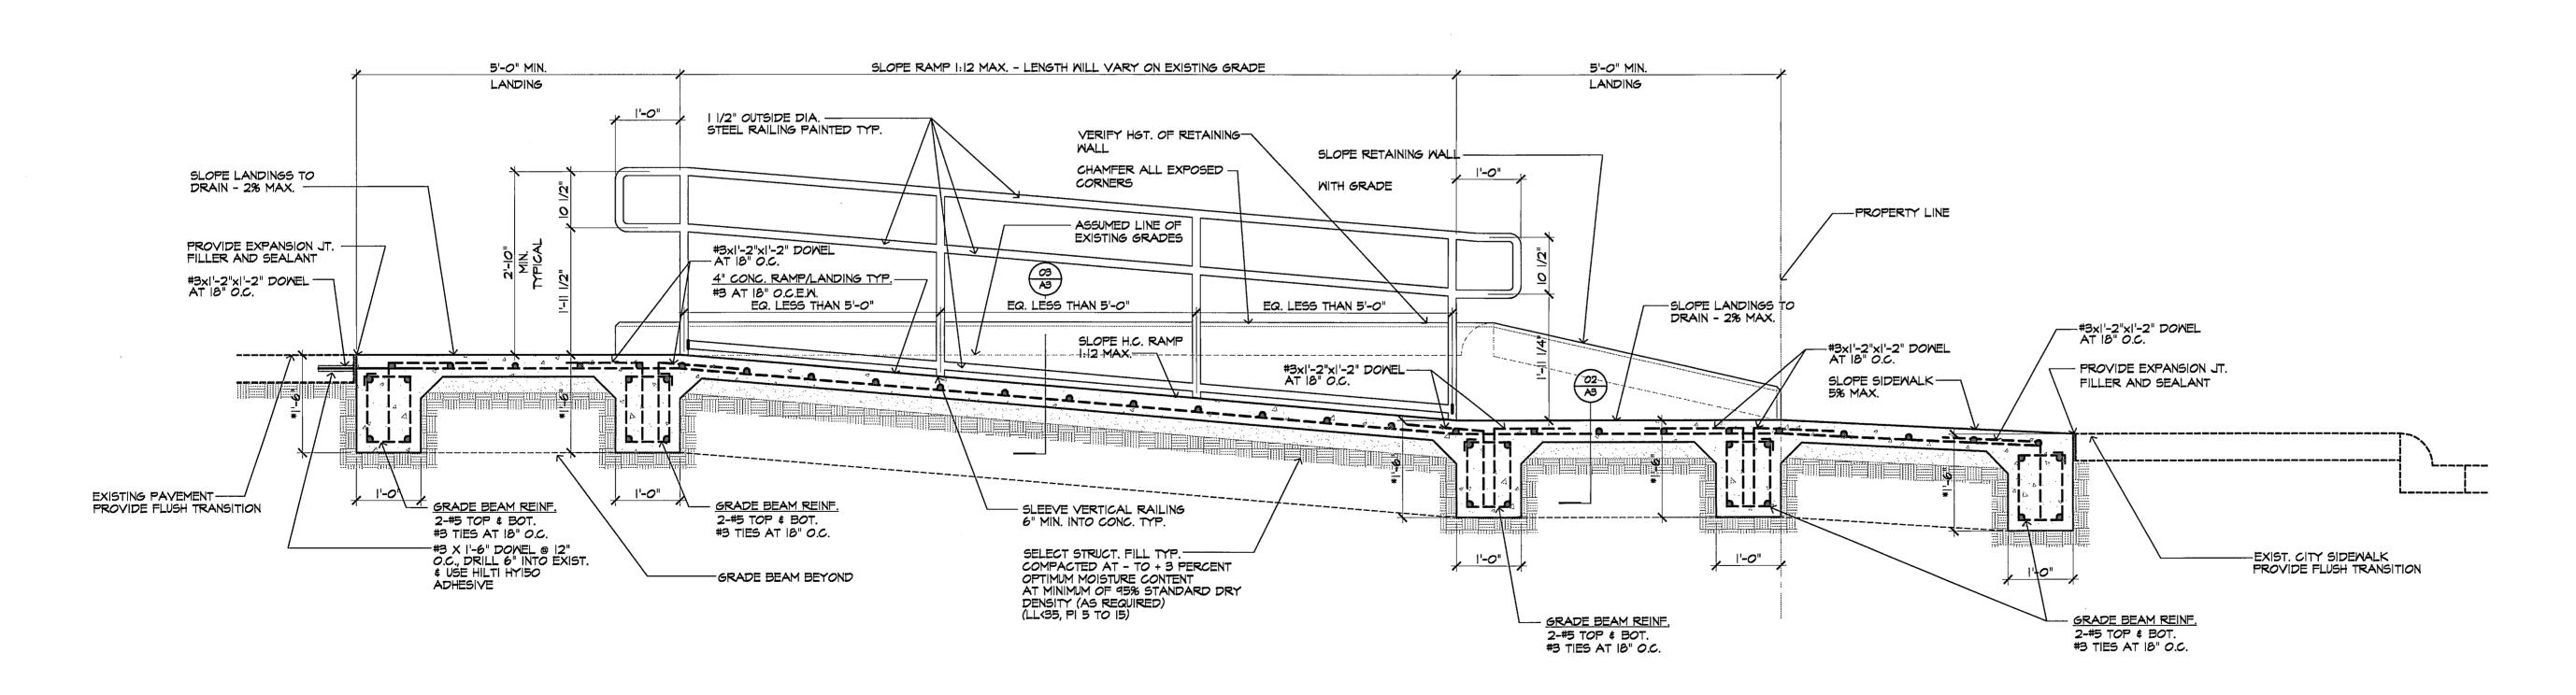


\*BEAM DEPTH I'-6" BELOW RAMP OR GRADE WHICHEVER IS DEEPER



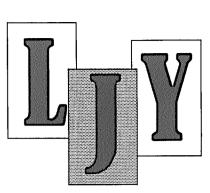

lester j young, architect 6304 royal lane dallas, texas 75230 214.455.7878

No.	Date	Revision
	11.19.12	Revision
		<del></del>
		-

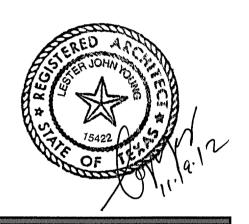

# ACCESSIBILITY Improvements for ADDISON MARKET

**SECTION** 

 Project
 |203

 Date
 |0.22.|2

 Drawn by
 LY

 Checked by
 LY