

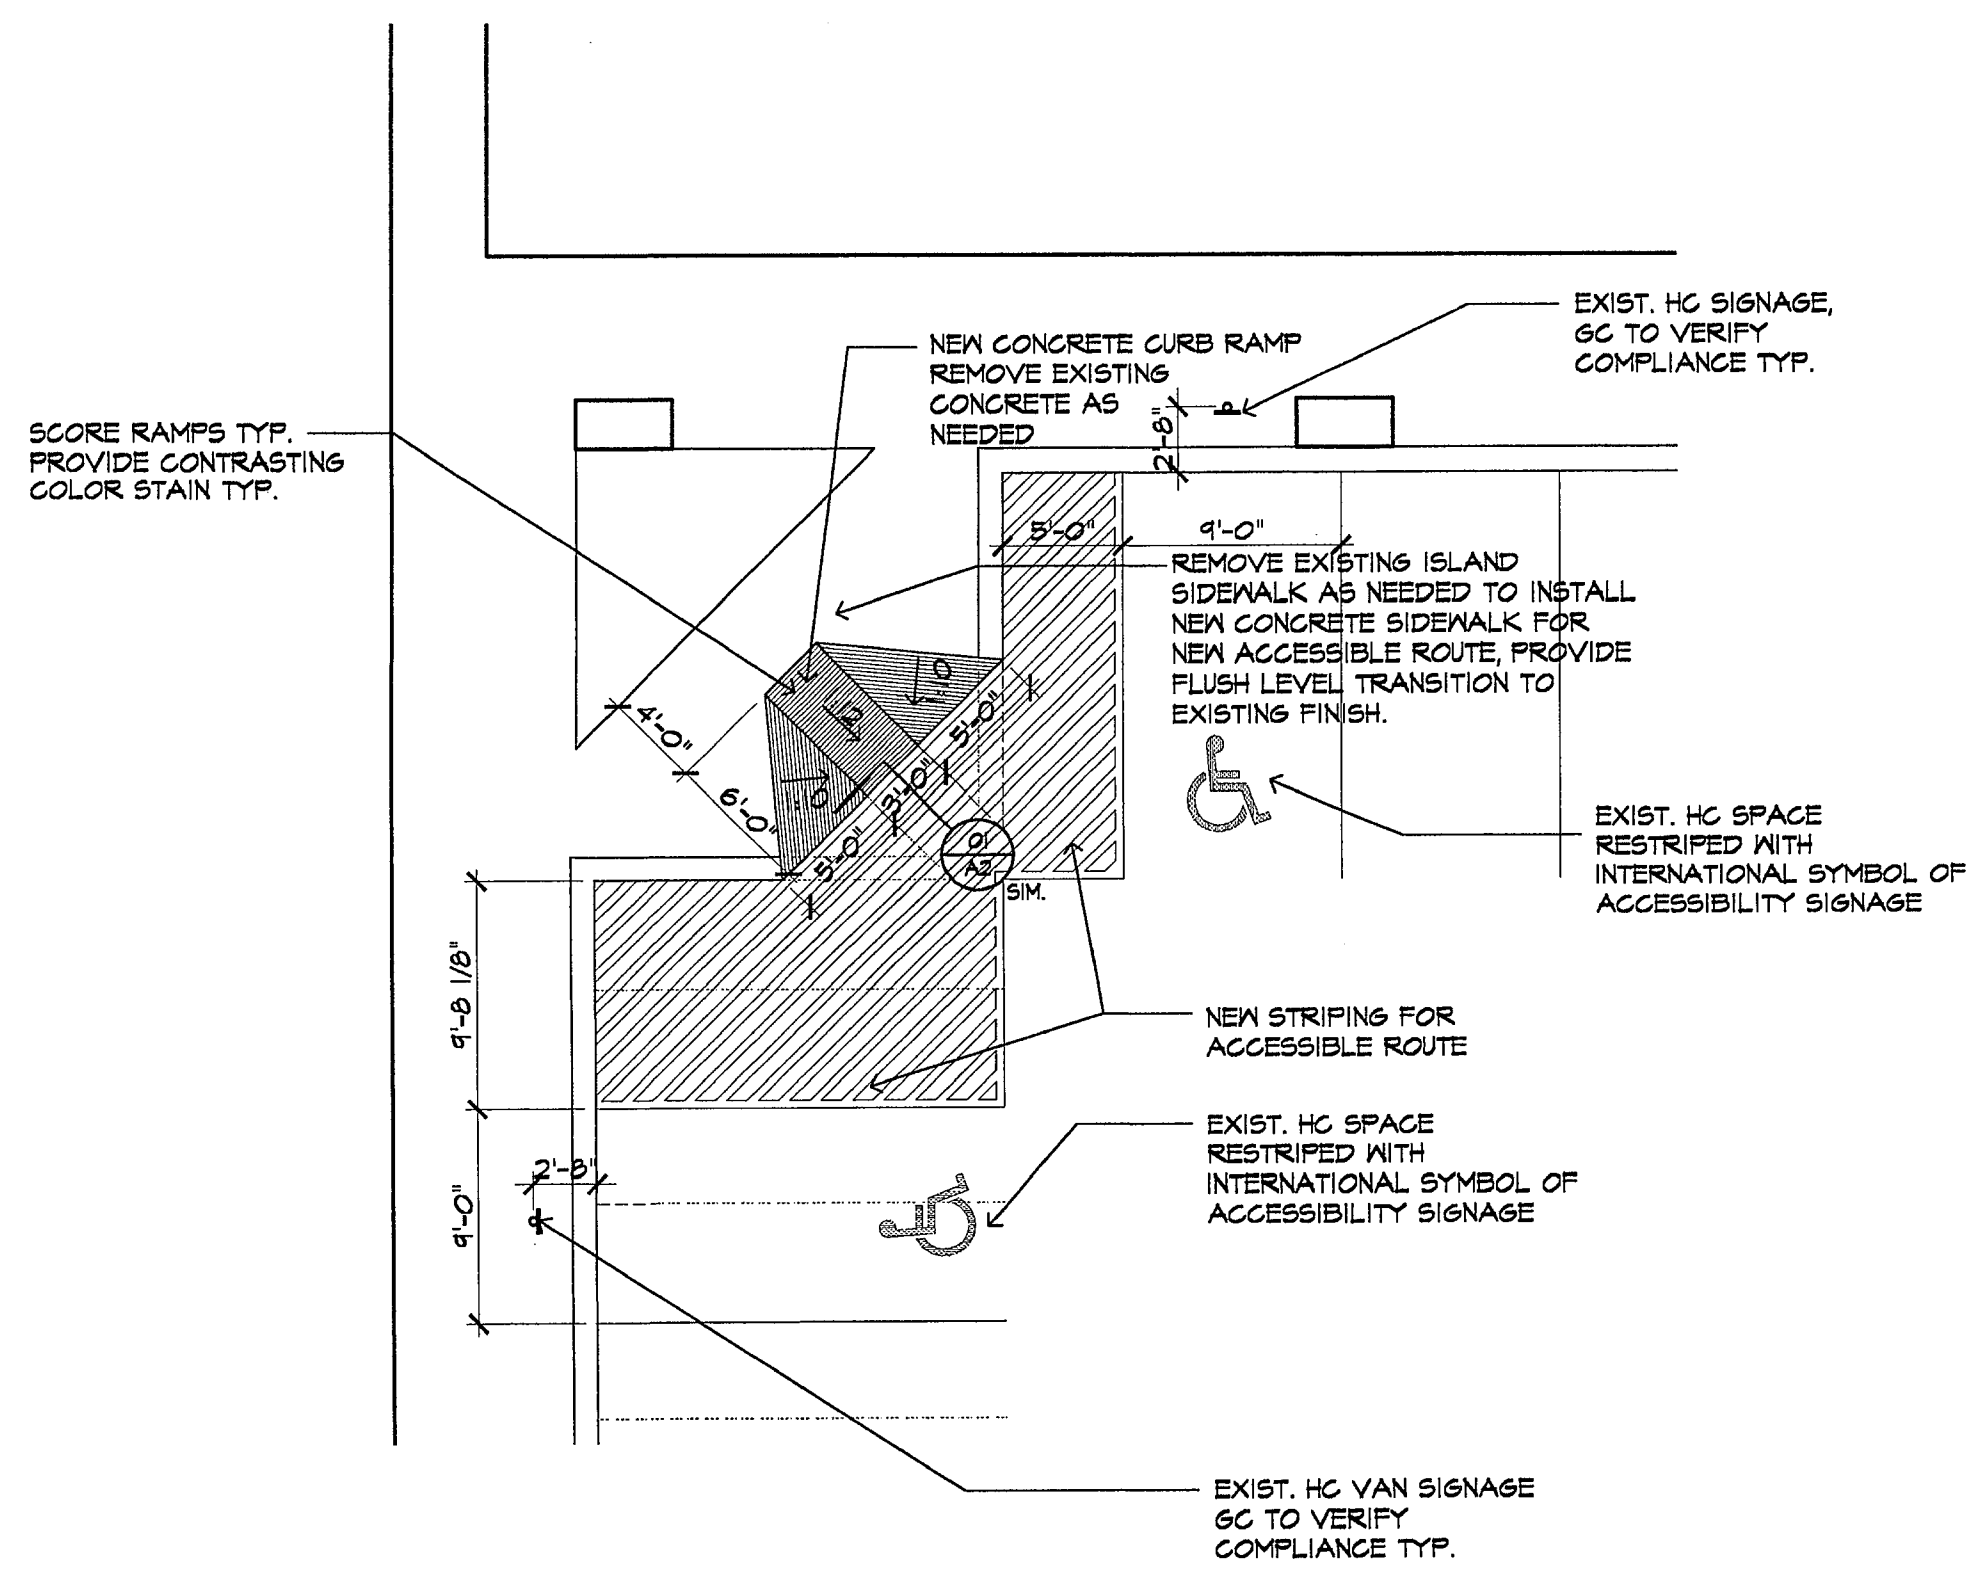


lester j young, architect
 6304 royal lane
 dallas, texas 75230
 214.455.7878


No.	Date	Revision
1	11.19.12	Revision

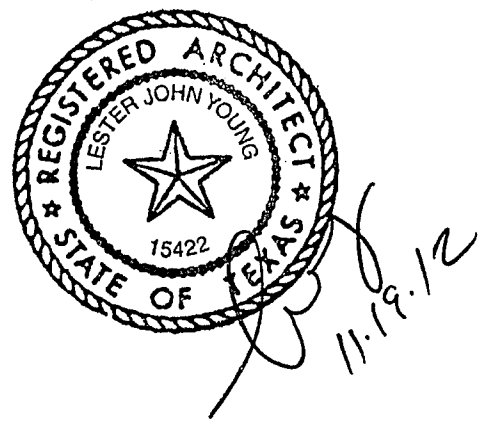


05
A2
HANDICAP PARKING PLAN
SCALE: 1/8" = 1'-0"
NORTH

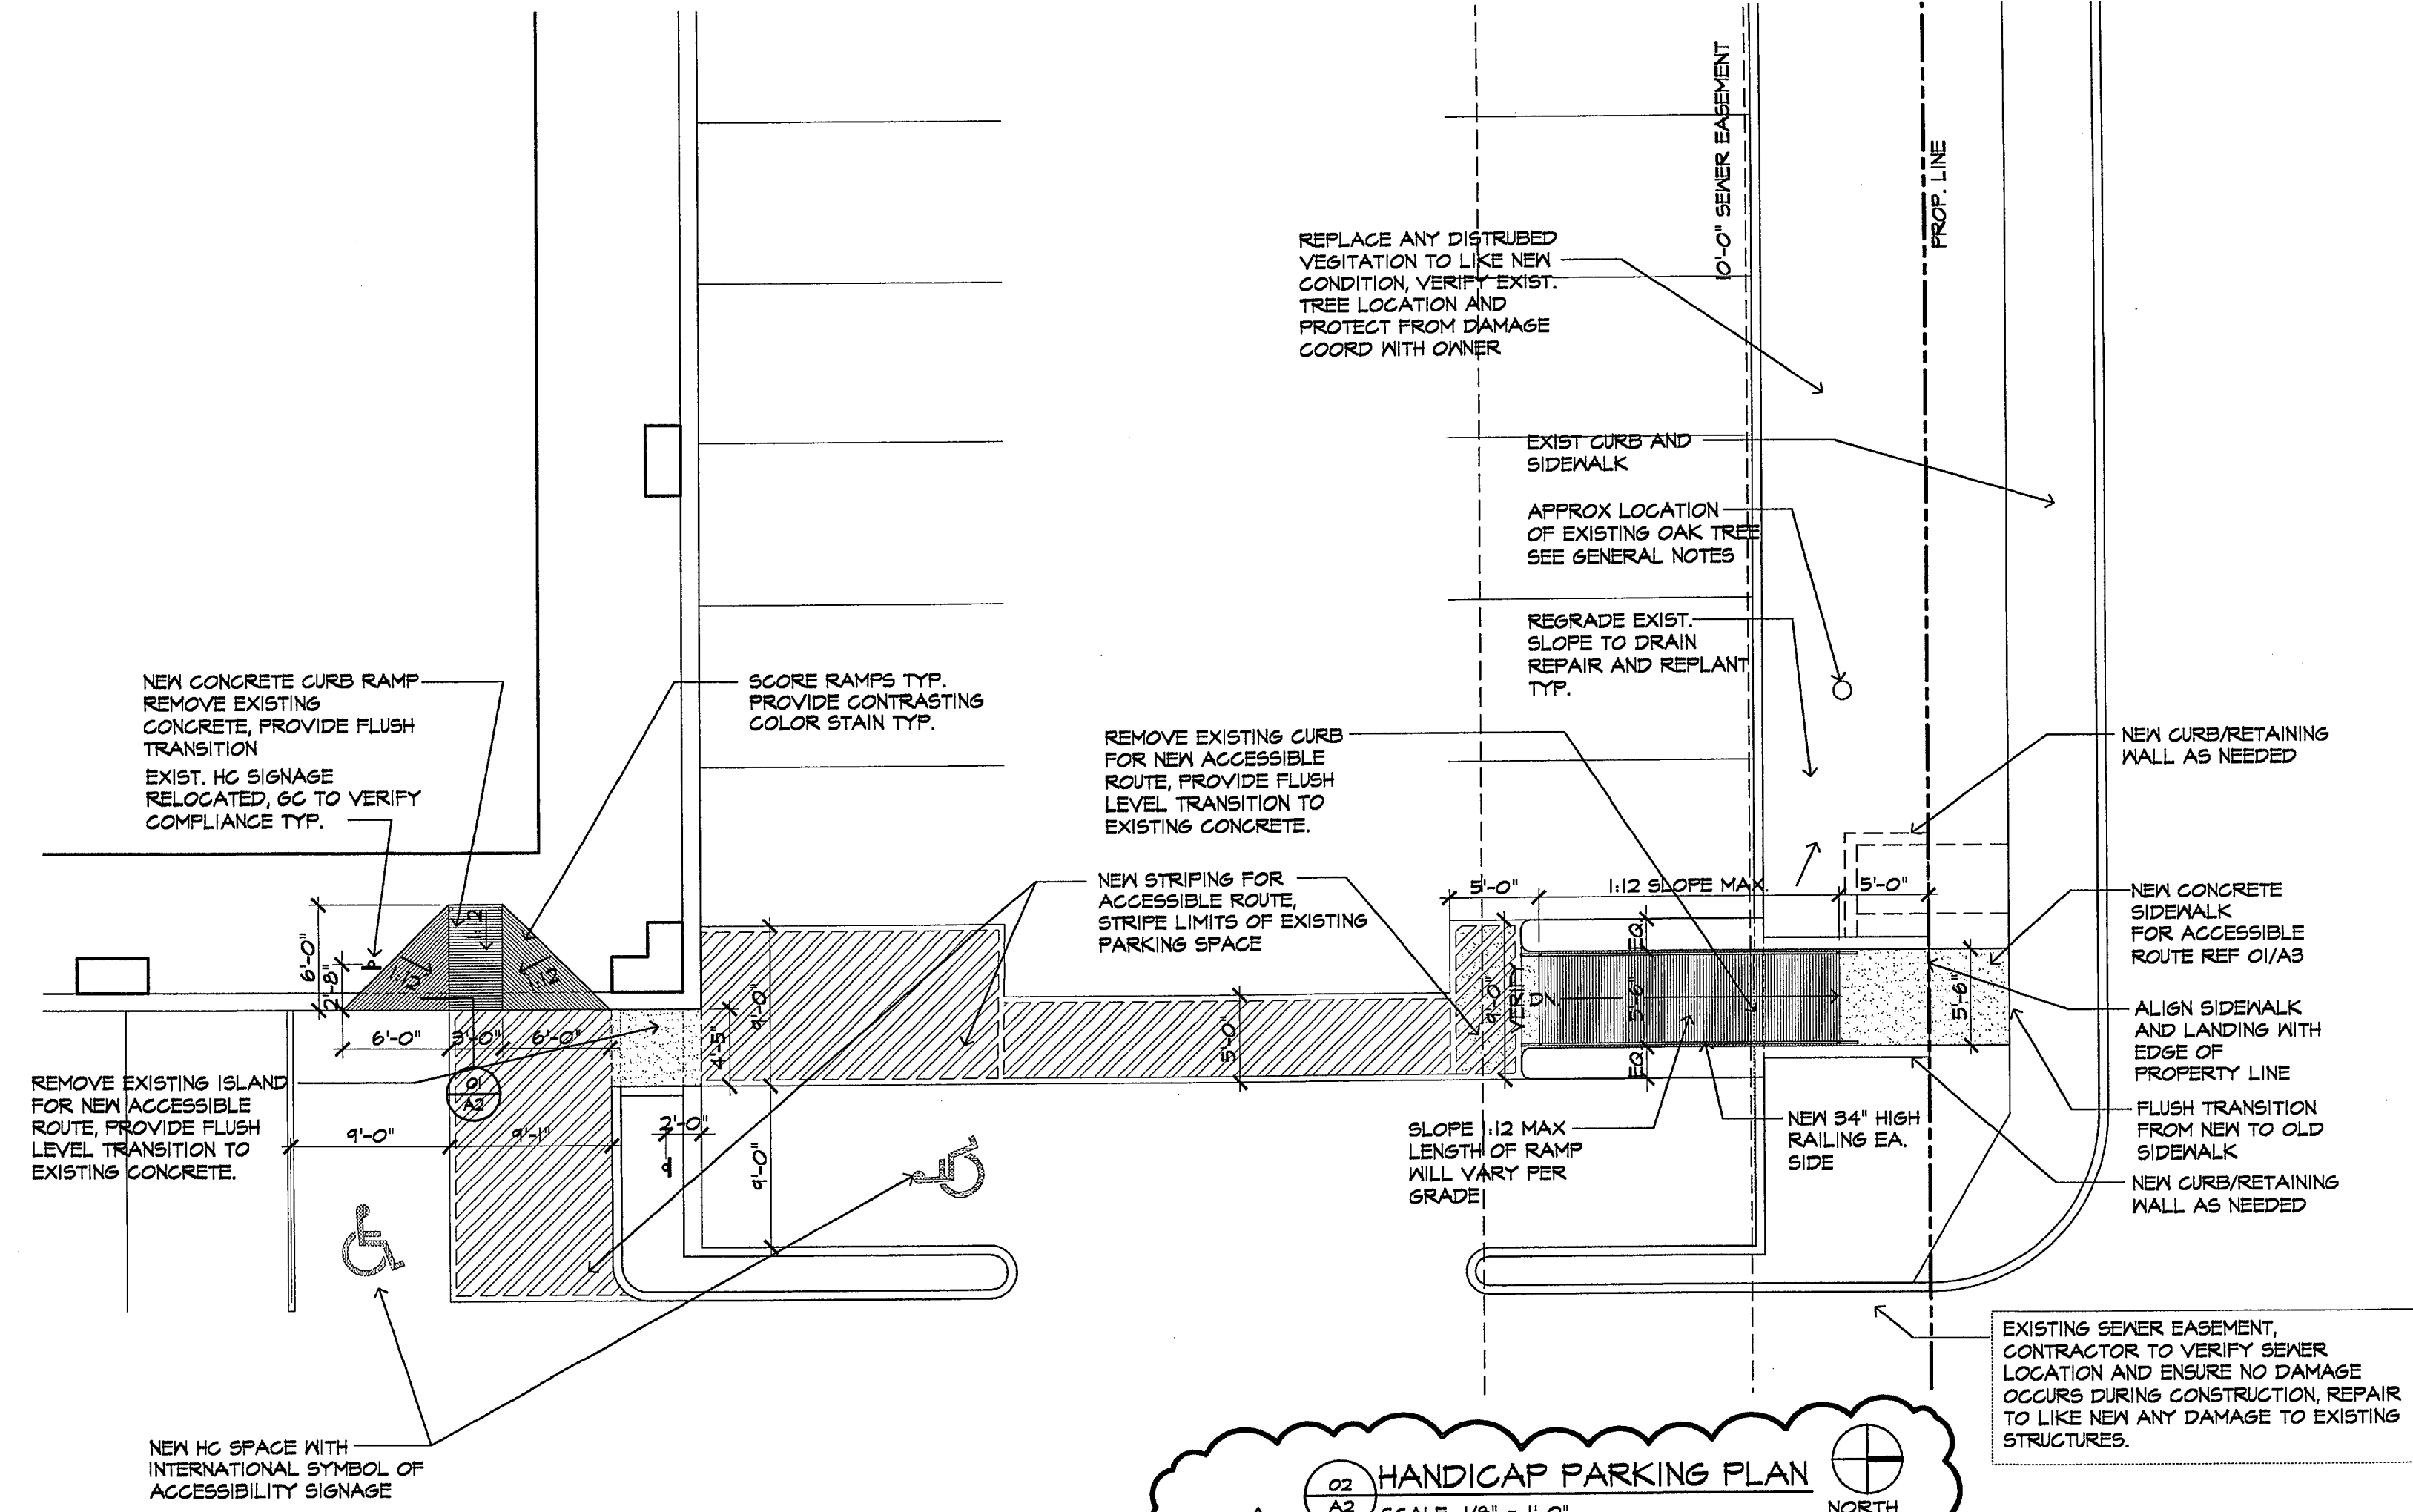


02
A2
HANDICAP PARKING PLAN
SCALE: 1/8" = 1'-0"
NORTH

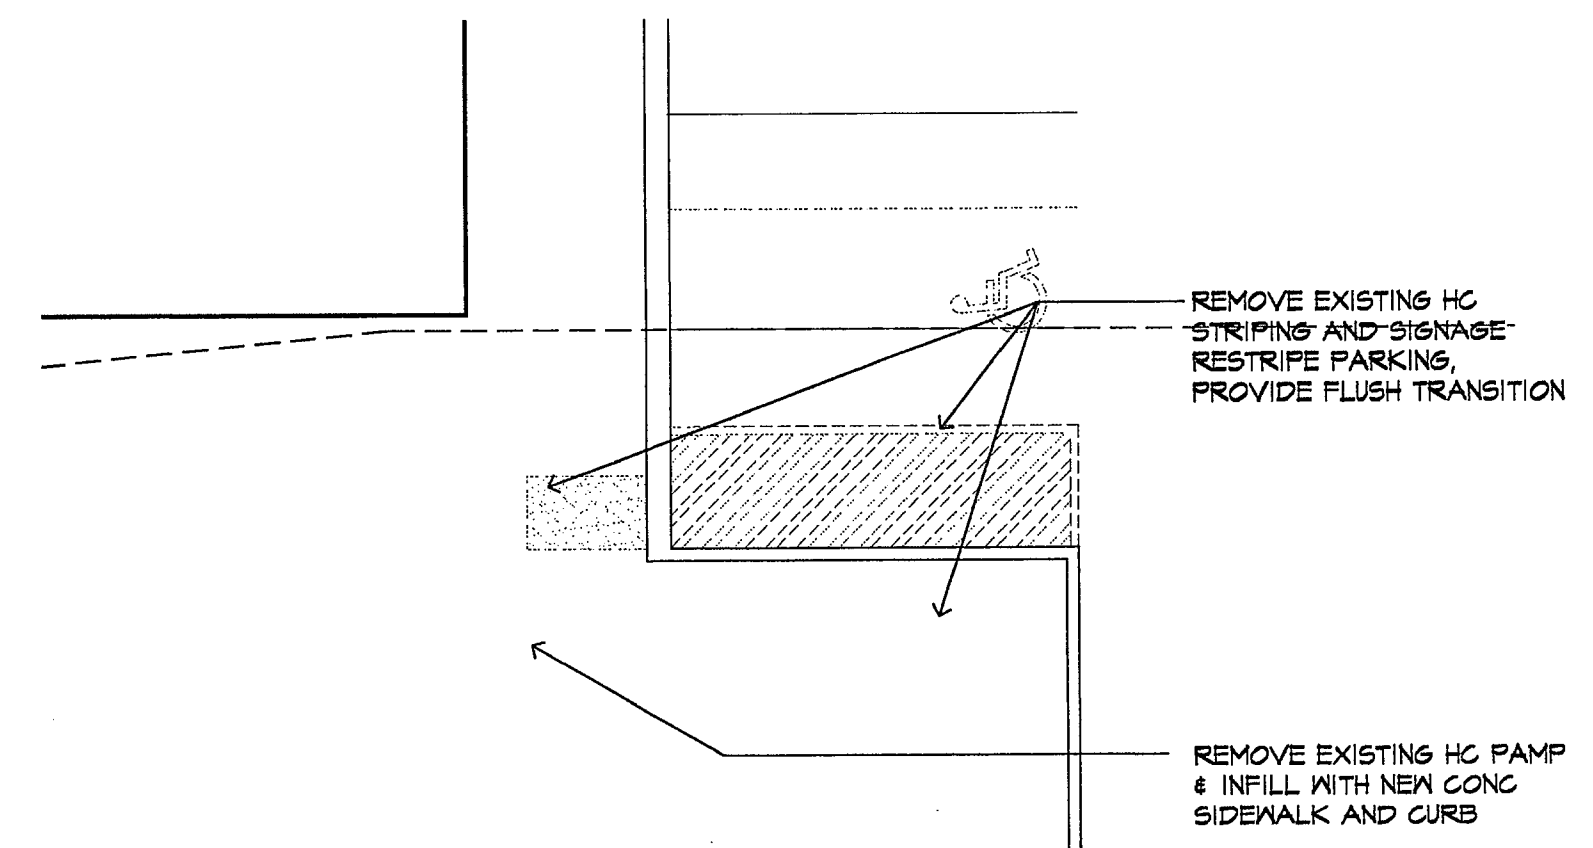

04
A2
HANDICAP PARKING PLAN
SCALE: 1/8" = 1'-0"
NORTH

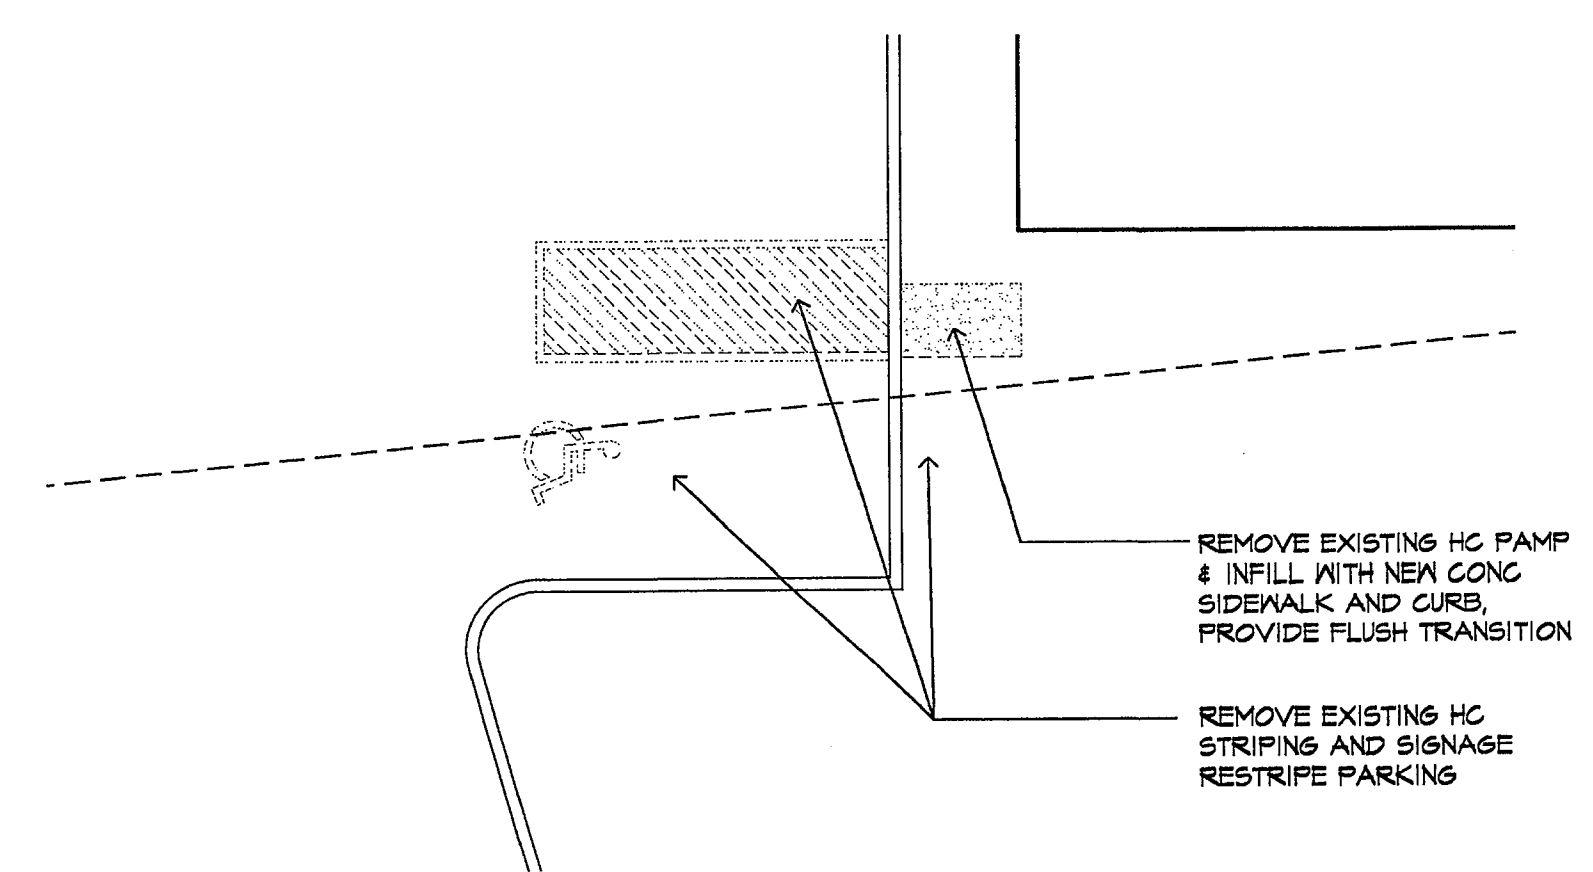

03
A2
HANDICAP PARKING PLAN
SCALE: 1/8" = 1'-0"
NORTH

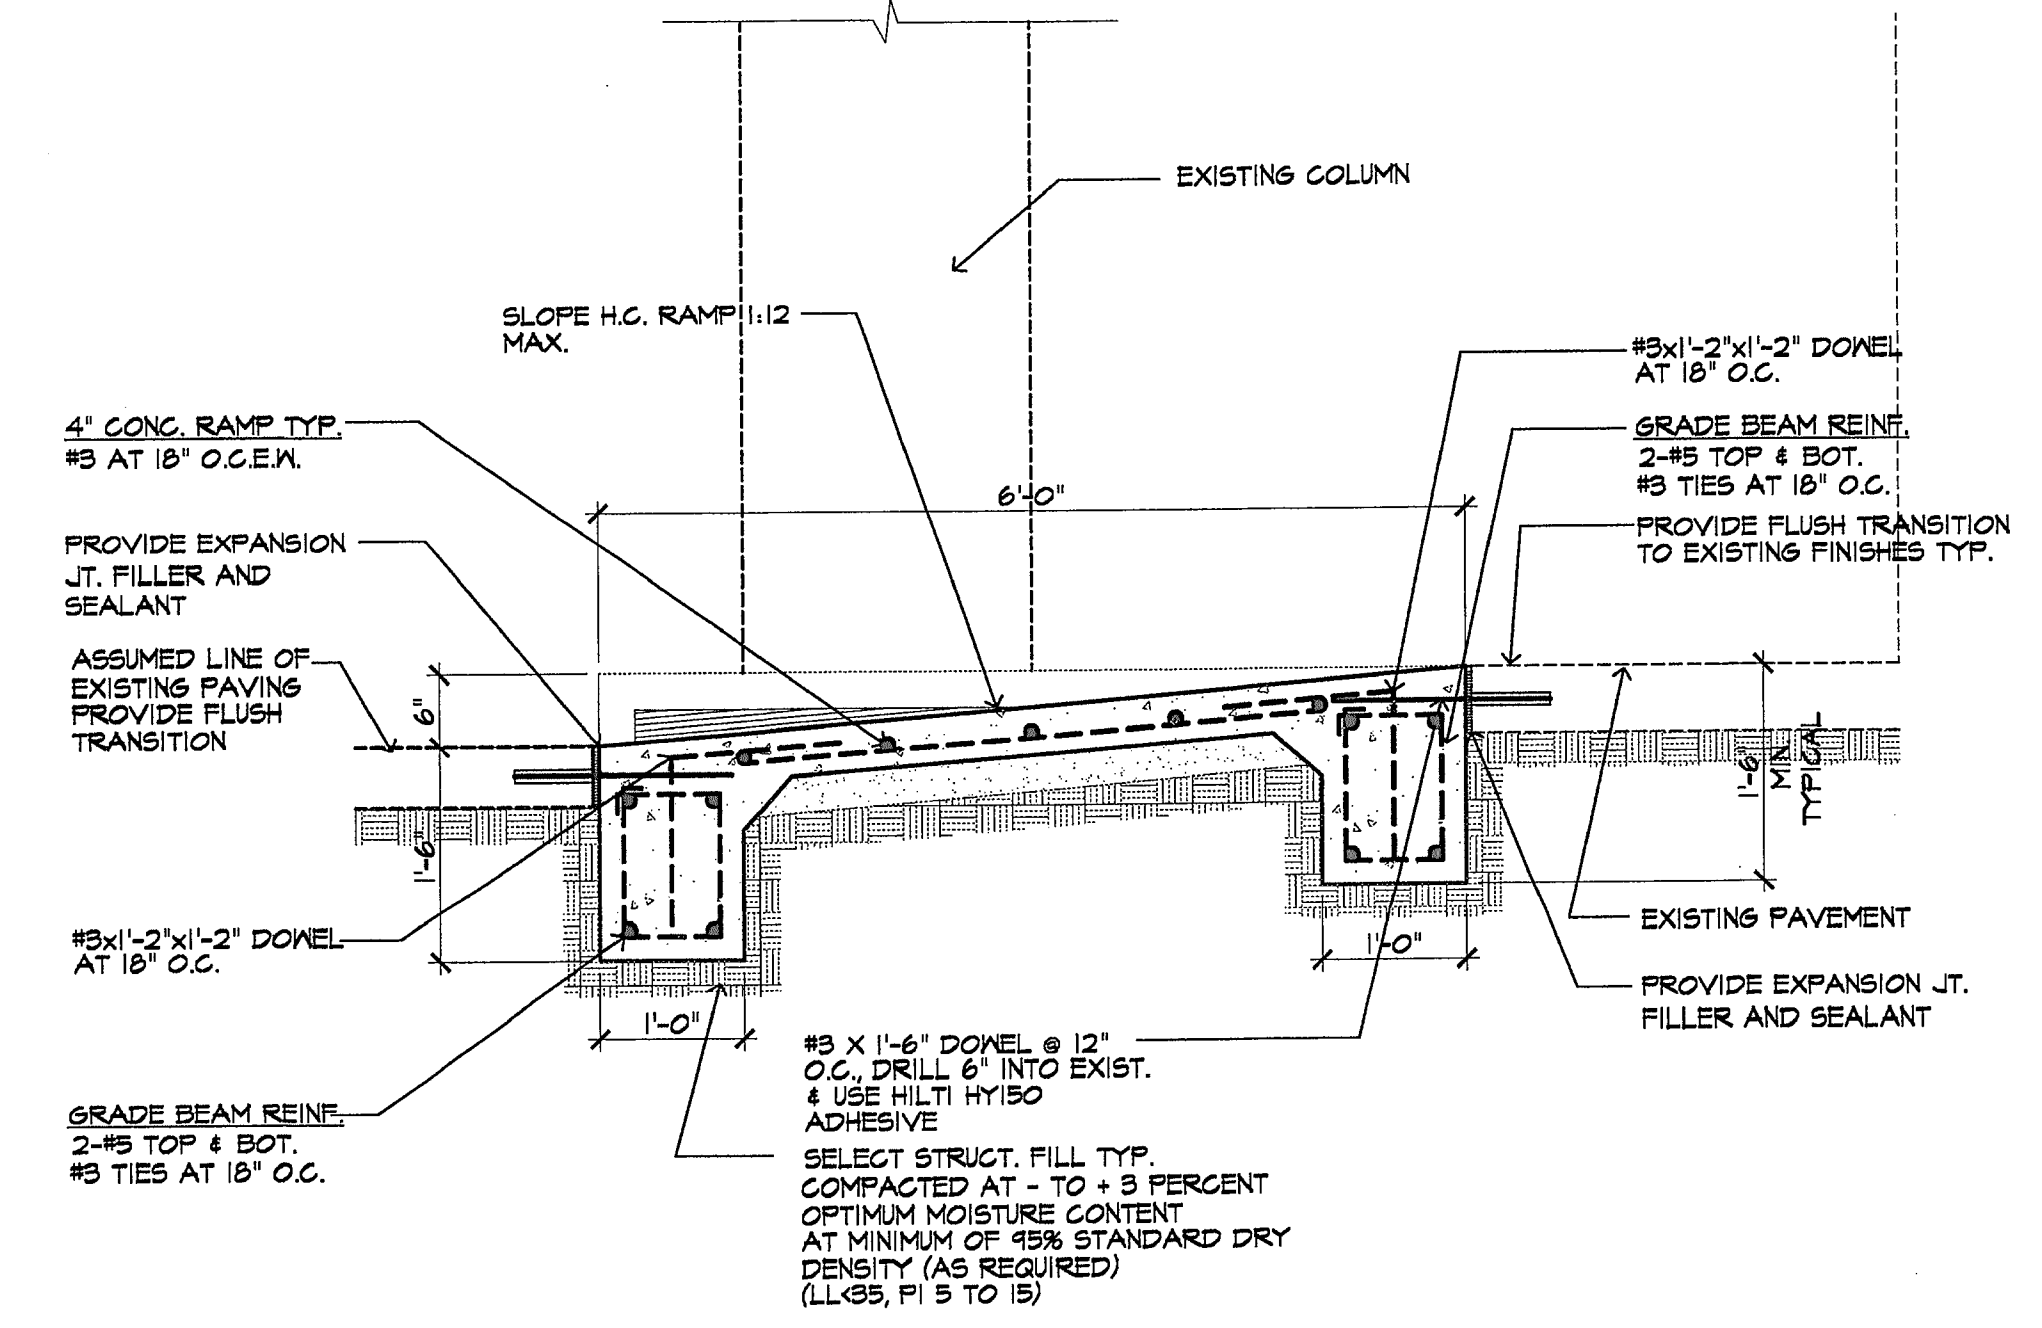

01
A2
HANDICAP RAMP SECTION
SCALE: 3/4" = 1'-0"

Accessibility Improvements for
ADDISON MARKET
 4530 Beltline Road Addison, Texas

LARGE PLANS

Project 1203
 Date 10.22.12
 Drawn by LY
 Checked by LY

Drawing Number
A2