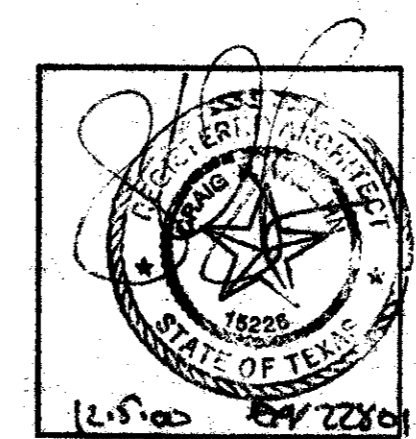

**ROOF PLAN**  
 SCALE: 1/4" = 1'-0"



**R-F**  
 ROGERS - FORD  
 ARCHITECTURE - INTERIOR DESIGN  
 2616 THOMAS AVENUE  
 DALLAS, TEXAS 75204  
 TELEPHONE (214) 871-9388  
 FAX (214) 871-3155

LONE STAR BANK  
 4650 BELTLINE ROAD  
 at Beltwood Parkway East  
 ADDISON, TX  
 Project # 1804

7-25-2000 PERMIT ISSUE  
 8-17-2000 ISSUE FOR BID  
 12-05-00 CONST. ISSUE

**A2.03**

**ROOF PLAN**