


1 WALL SECTION @ PARAPET  
 A4.02 SCALE: 1" = 1'-0"

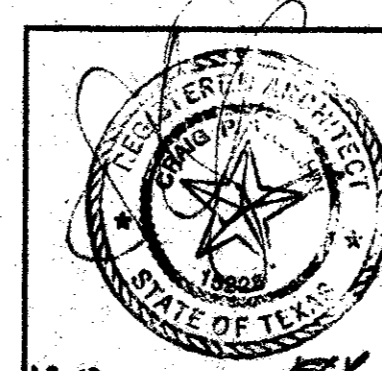

**R-F**  
 ROGERS - FORD  
 ARCHITECTURE - INTERIOR DESIGN  
 2616 THOMAS AVENUE  
 DALLAS, TEXAS 75204  
 TELEPHONE (214) 871-9388  
 FAX (214) 871-3155

LONE STAR BANK  
 4650 BELTLINE ROAD  
 at Beltwood Parkway East  
 ADDISON, TX  
 Project # 1804

7-25-2000 PERMIT ISSUE  
 8-17-2000 ISSUE FOR BID  
 12-05-00 CONST. ISSUE  
 12-05-00 P.R. #1

A4.02

WALL SECTIONS

Copyright 2000 by Rogers-Ford, L.P.  
 Drawn by: J. L. S. - Addison Architectural Services, Inc.  
 Date: 05/11/00  
 Title: A4.02 - Wall Section @ Parapet  
 Project: Lone Star Bank at Beltwood Parkway East, Addison, TX