



1 ENTRY SECTION/ELEVATION
 A4.03 SCALE: 1" = 1'-0"

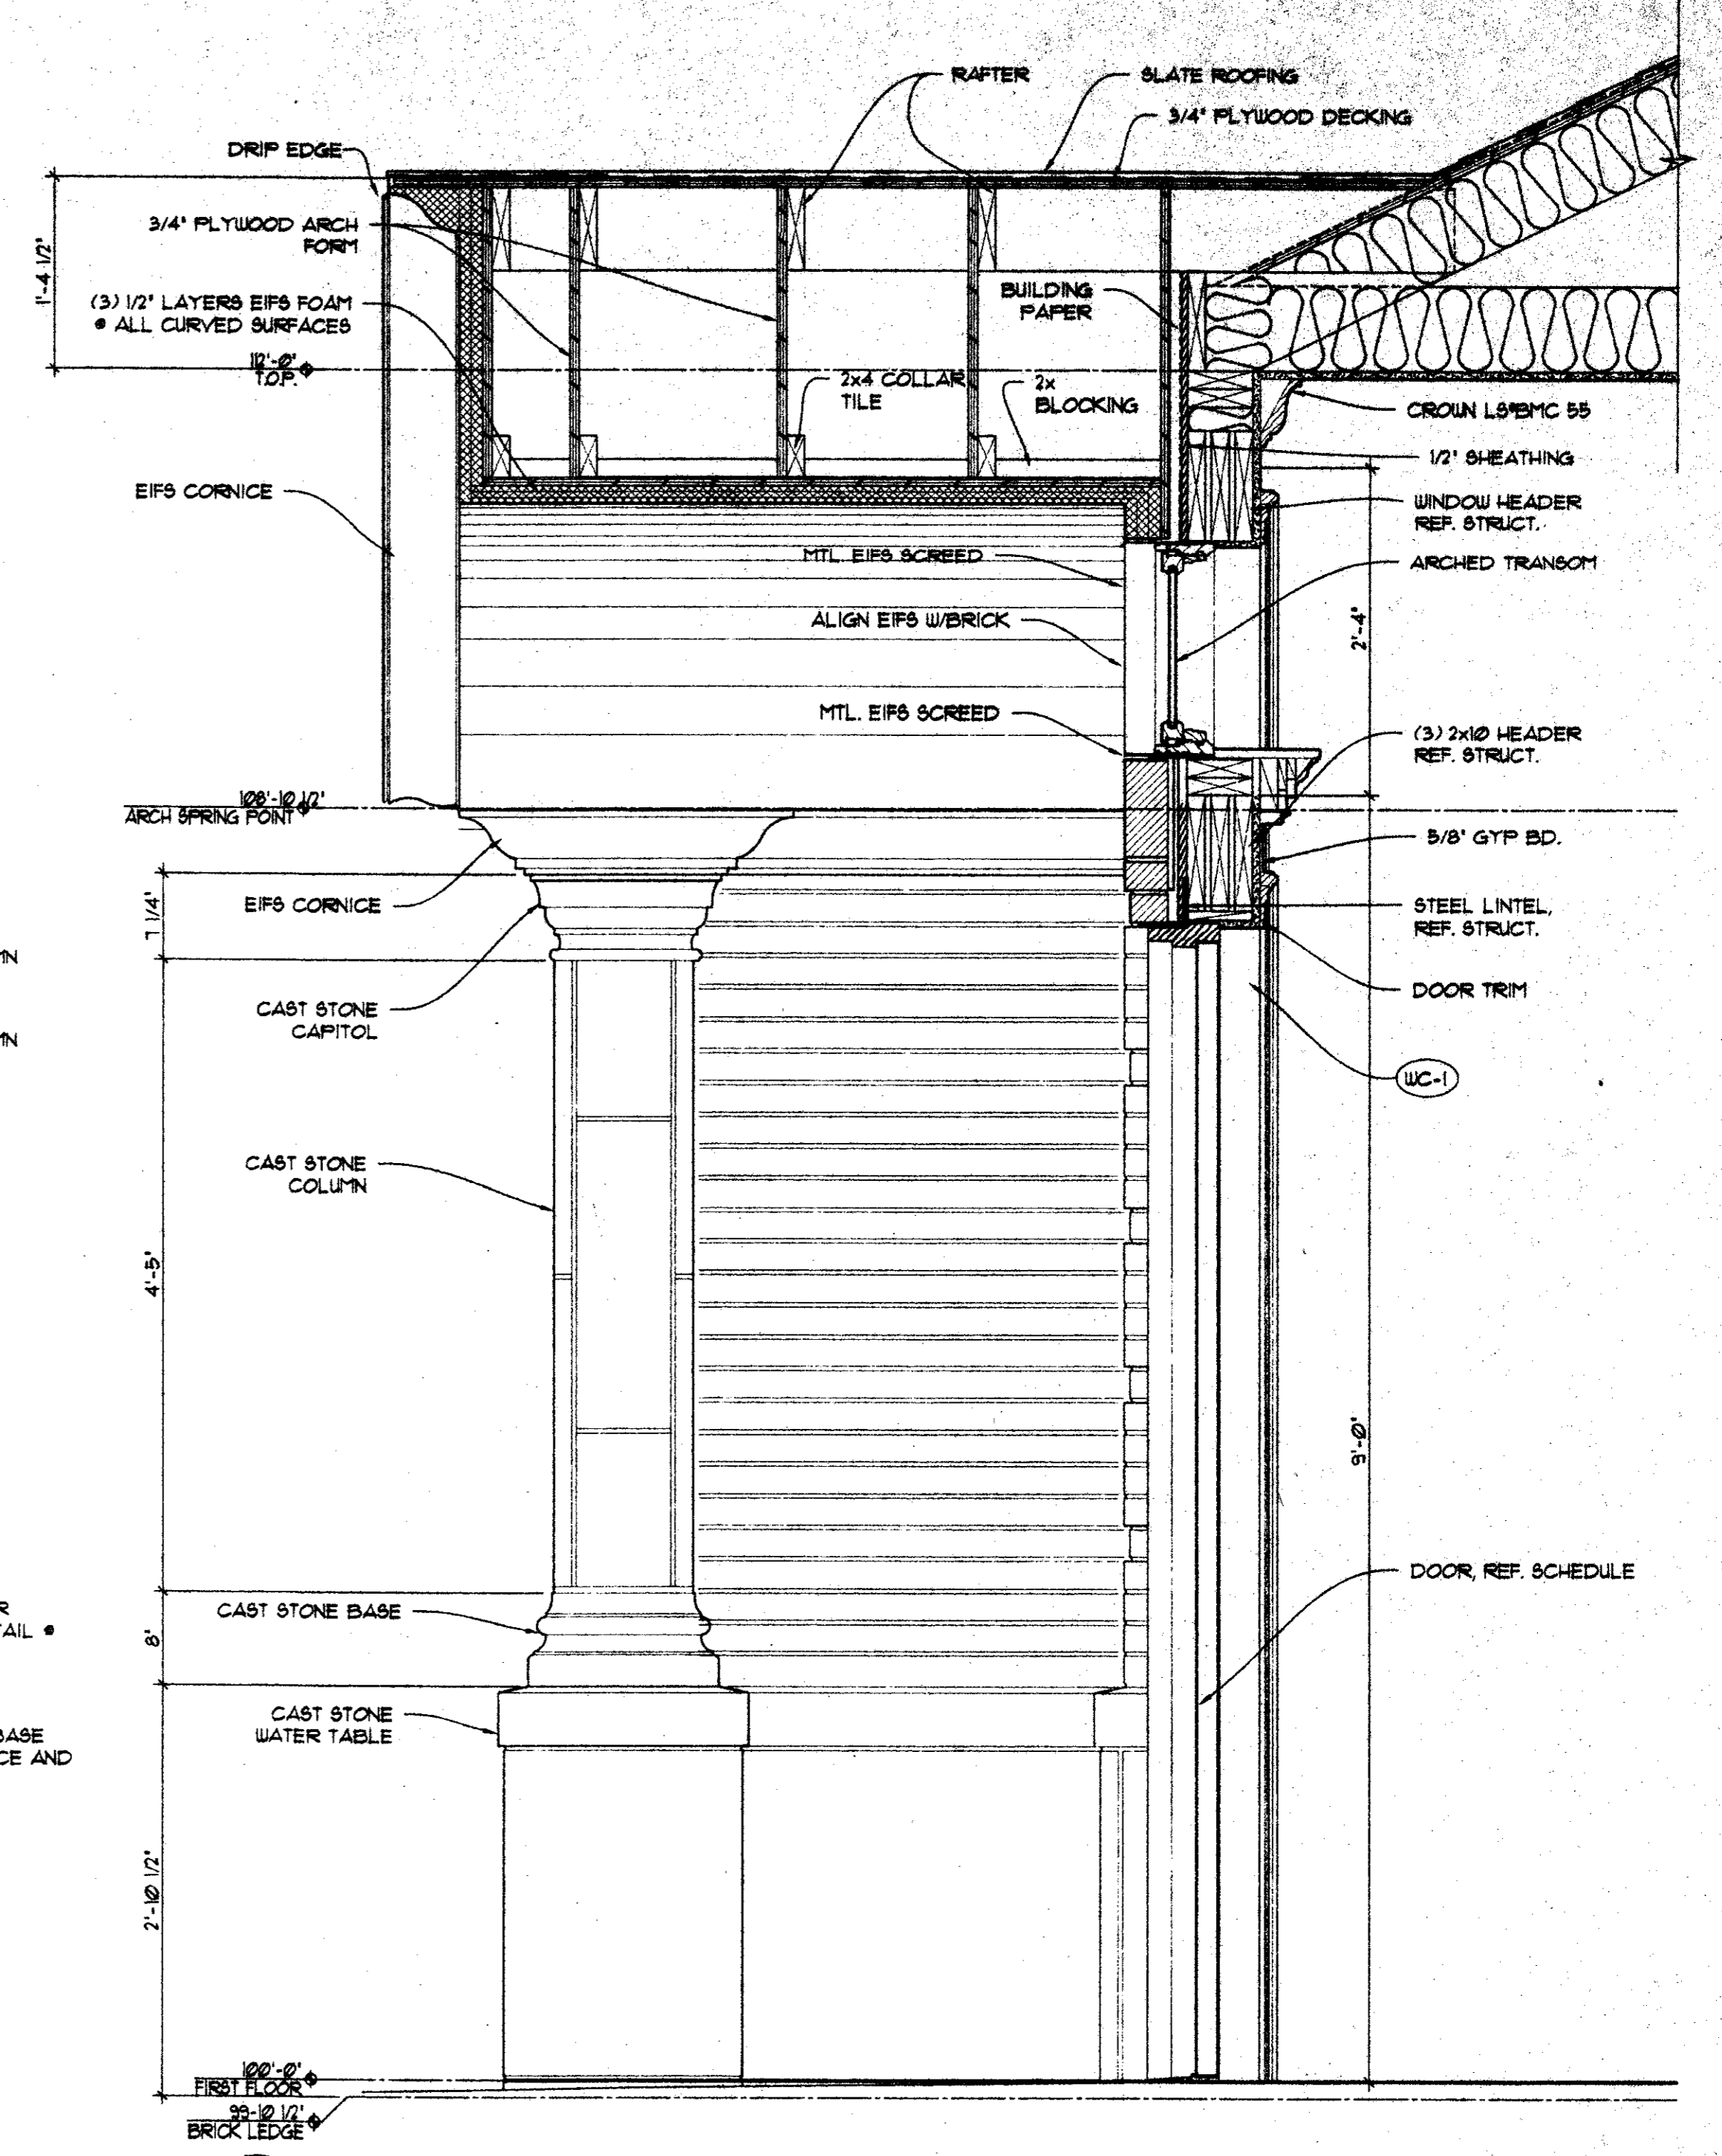

2 ENTRY SECTION
 A4.03 SCALE: 1" = 1'-0"

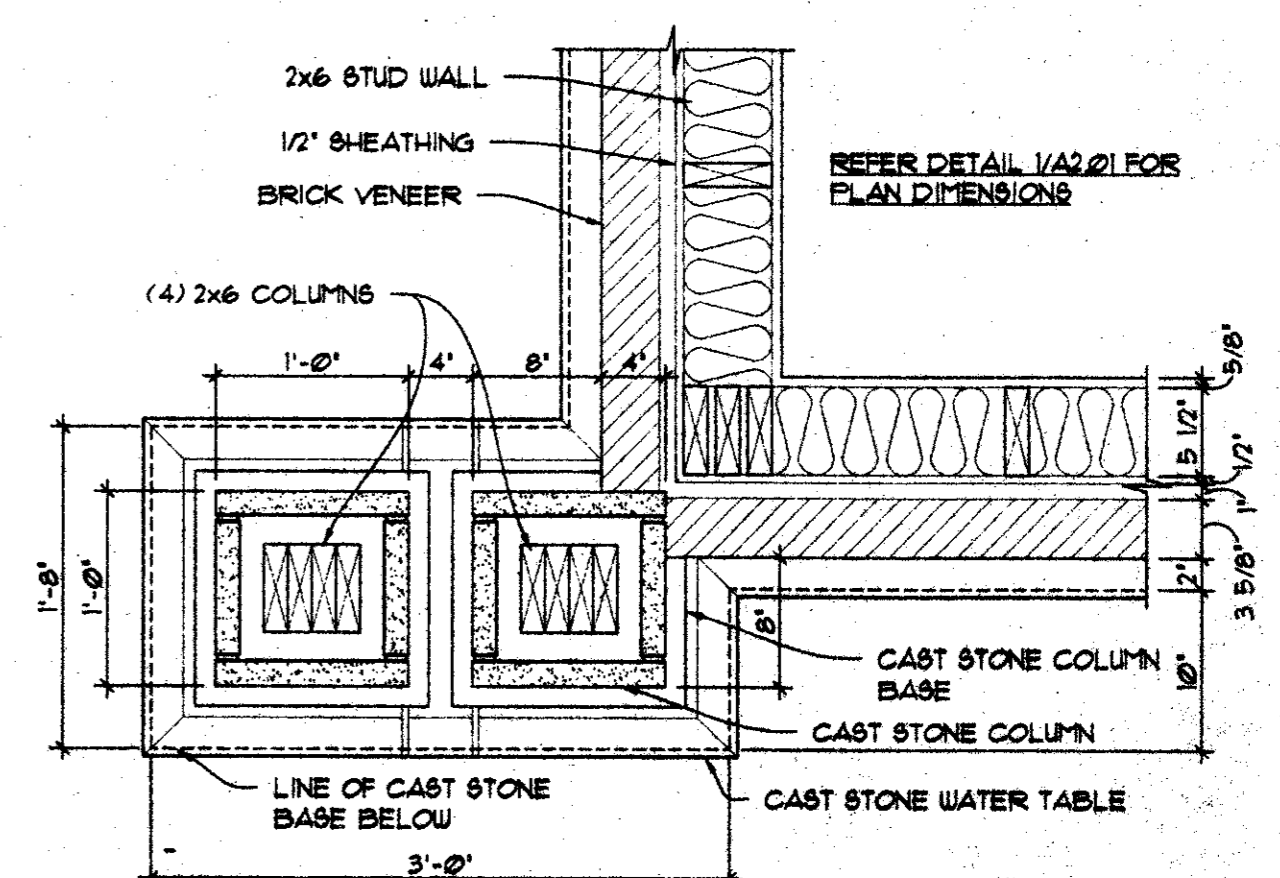

3 PLAN DETAIL
 A4.03 SCALE: 1" = 1'-0"

Copyright © 2004 R-FORD, L.P. All rights reserved. This drawing is the property of R-FORD, L.P. and is not to be reproduced, stored in a retrieval system, or transmitted in any form or by any means, electronic, mechanical, photocopying, recording, or by any information storage and retrieval system, without the prior written permission of R-FORD, L.P.

	R-F R-FORD ARCHITECTURE - INTERIOR DESIGN 2616 THOMAS AVENUE DALLAS, TEXAS 75204 TELEPHONE (214) 871-9388 FAX (214) 871-3155	LONE STAR BANK Belwood Parkway East at Beltline Road Addison, TX Project # 1804	7-25-00 ISSUED FOR PERMIT 8-17-00 ISSUE FOR BID 12-05-00 CONST. ISSUE 12-05-00 P.R. #1	A4.03
	ENTRY SECTIONS AND DETAILS			