



2 AB304
SCALE: FULL SCALE




3 LS DM22
SCALE: FULL SCALE

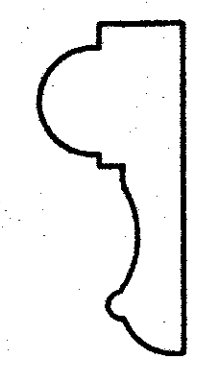


4 CA364
SCALE: FULL SCALE

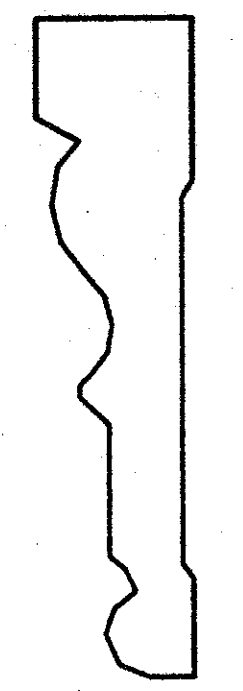


5 CA364
SCALE: FULL SCALE

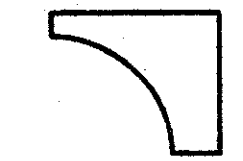


6 AB023
SCALE: FULL SCALE

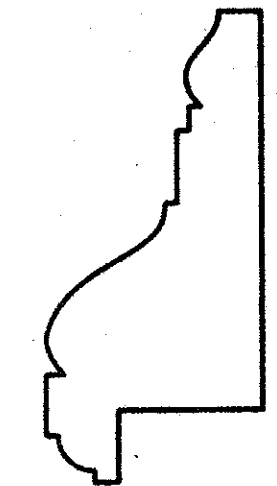


7 LS B12 (LB11)
SCALE: FULL SCALE

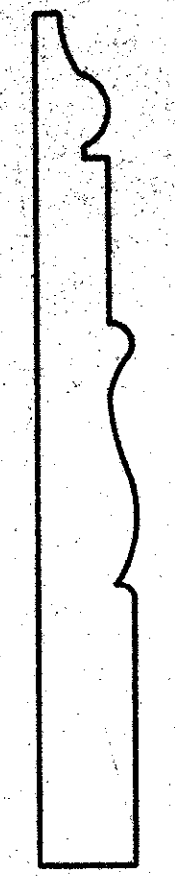


8 BB153
SCALE: FULL SCALE

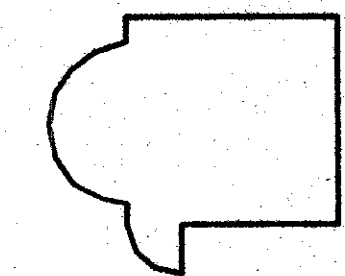

9 LS BMC 205
SCALE: FULL SCALE

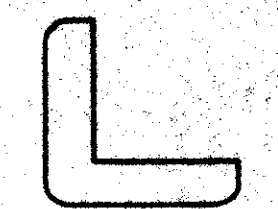

1 LS BMC 55
SCALE: FULL SCALE

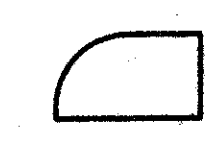


10 LS BMC 127
SCALE: FULL SCALE


11 LS BMC 109
SCALE: FULL SCALE

12 LS FLUTED PILASTER
SCALE: FULL SCALE


13 LS C214
SCALE: FULL SCALE

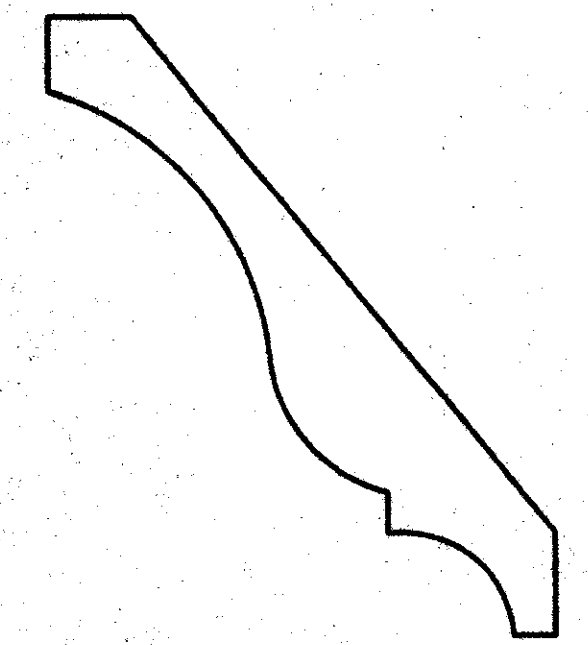


17 LS 48
SCALE: FULL SCALE

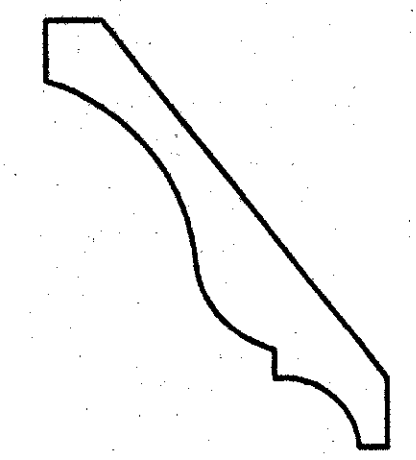


18 LS 52
SCALE: FULL SCALE

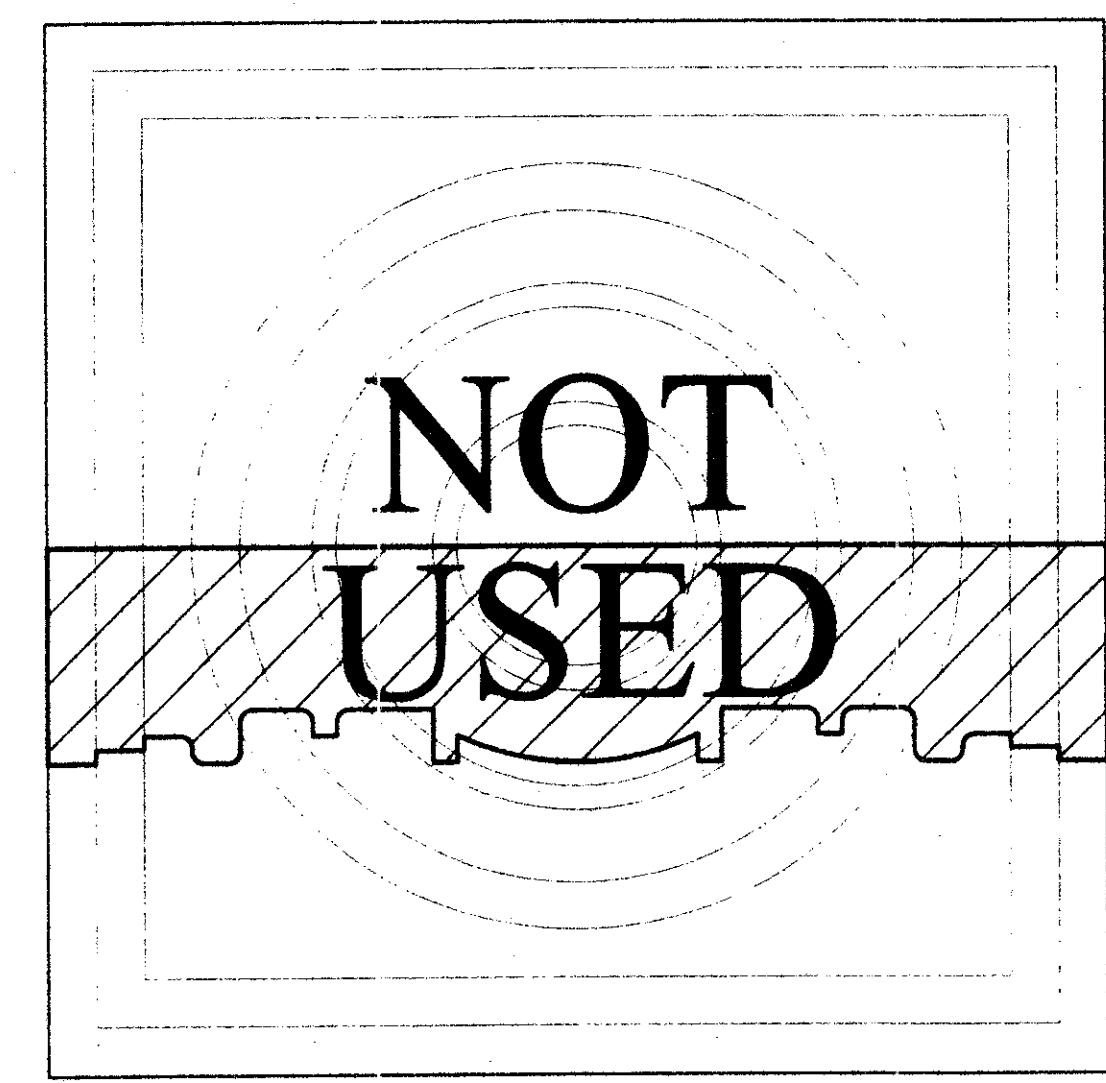

14 LS ROSETTE (5 1/2x5 1/2)
SCALE: FULL SCALE

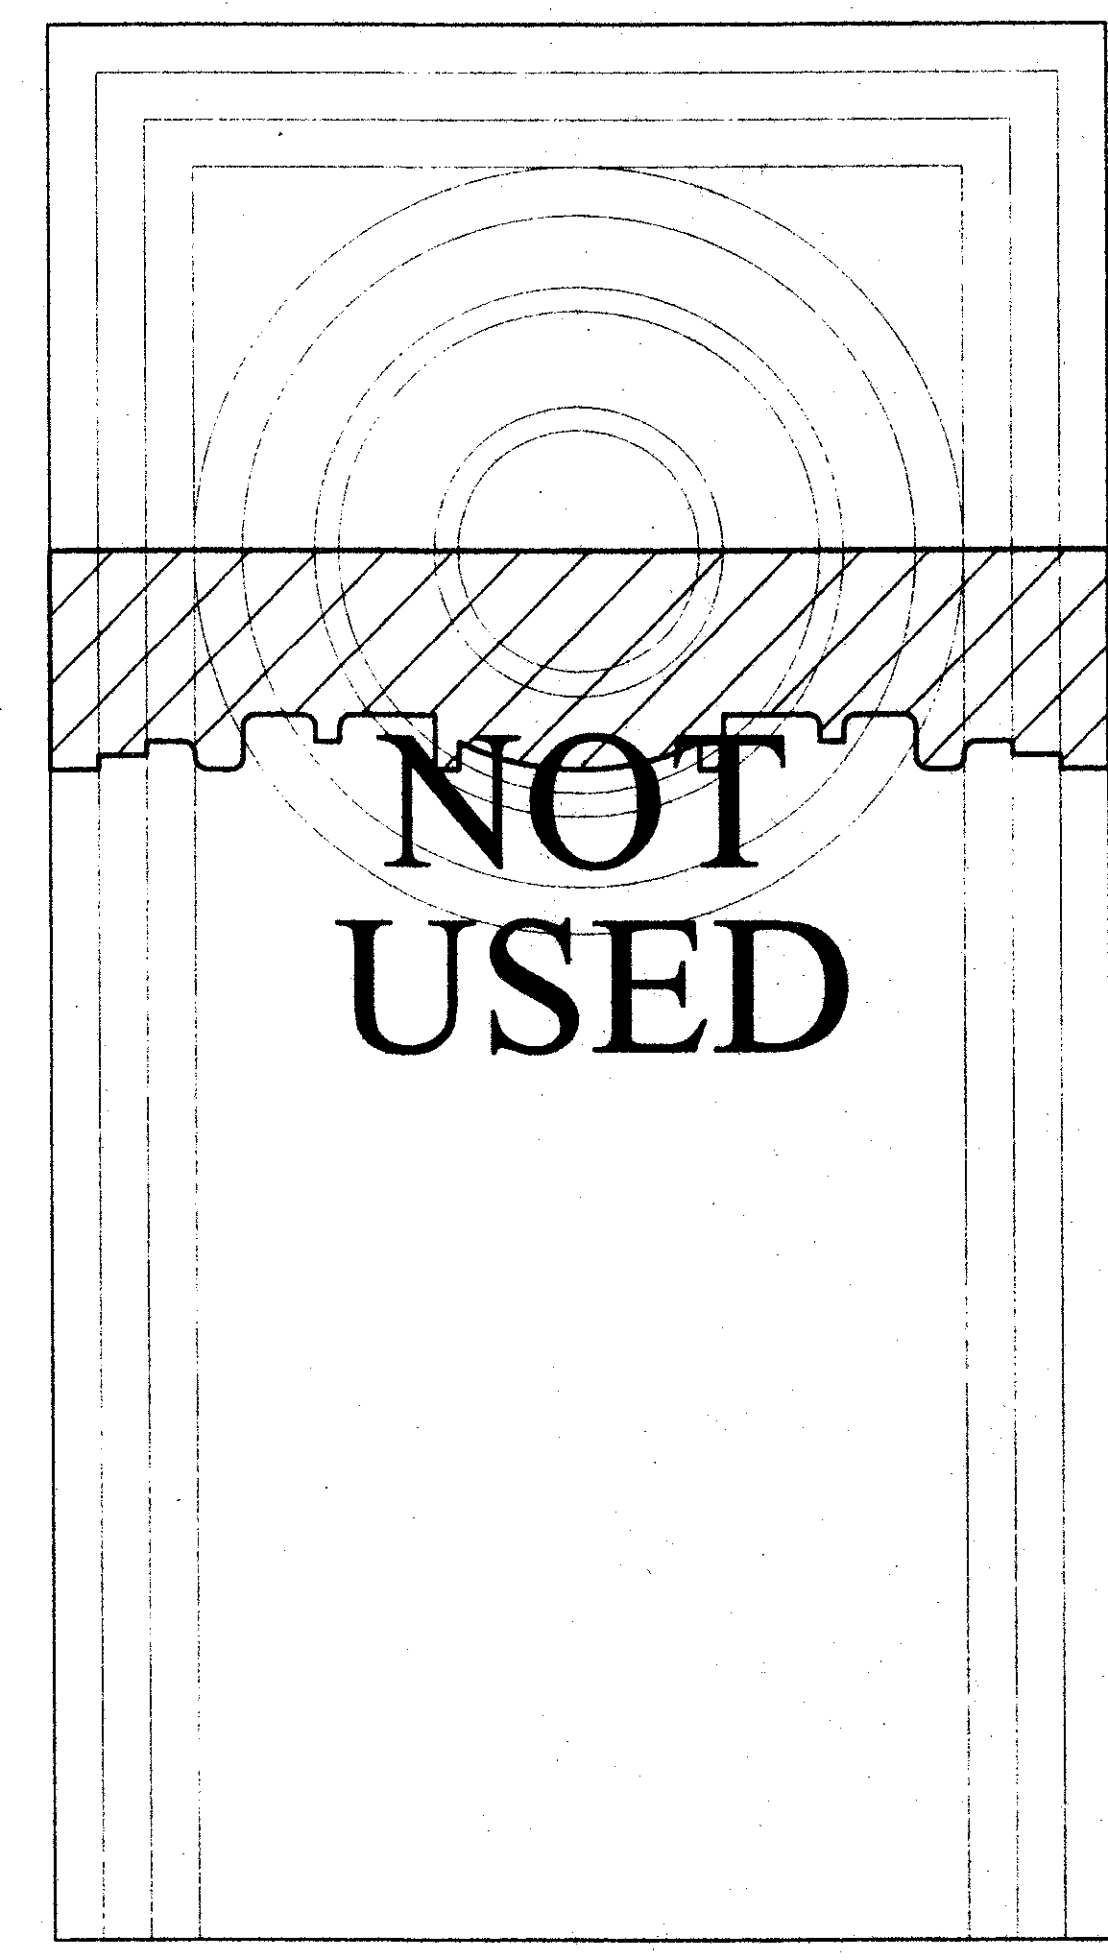


15 LS FLUTED PILASTER (5 1/2x10)
SCALE: FULL SCALE

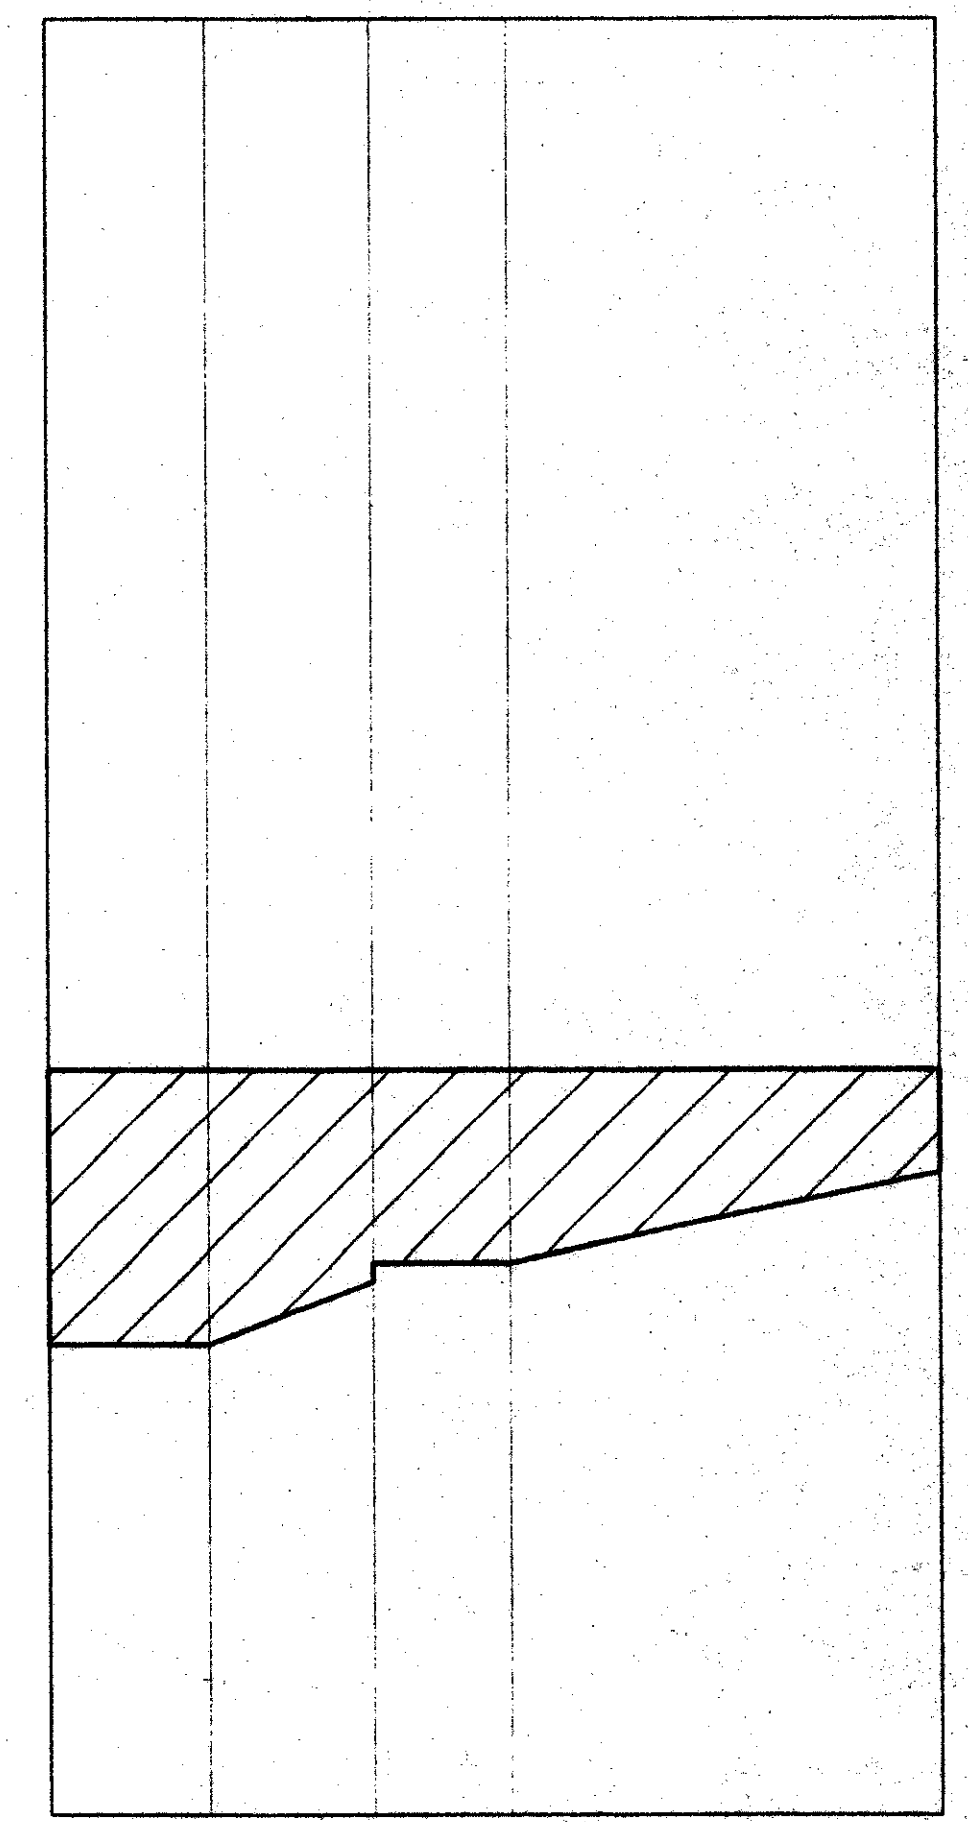

16 AB68
SCALE: FULL SCALE

Copyright 2000 ROGERS-FORD, L.P. All rights reserved. This drawing is the property of ROGERS-FORD, L.P. and is not to be reproduced without the written consent of ROGERS-FORD, L.P. 12-05-00

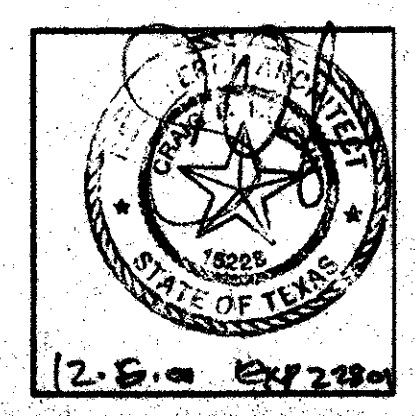

R-F
ROGERS-FORD
ARCHITECTURE - INTERIOR DESIGN
2516 THOMAS AVENUE
DALLAS, TEXAS 75204
TELEPHONE (214) 871-9988
FAX (214) 871-3155

LONE STAR BANK
Belwood Parkway East
at Beltline Road
Addison, TX
Project # 1804

7-25-00 ISSUED FOR PERMIT
8-17-00 ISSUE FOR BID
12-05-00 CONST. ISSUE
12-05-00 P.R. #1

A5.08

FULL SIZE DETAILS