

**LONE STAR BANK ADDISON**  
 4650 Beltline Road  
 at Beltwood Parkway East  
 Addison, TX  
 Project #1805

**FINISH LEGEND**  
 08-18-00

**GENERAL NOTES:** Rogers-Ford is to see samples of all items called out on the finish legend for approval prior to installation. Reference specifications.  
 See drawings in context to all material dimensions and quantities. See architectural specification for further clarification.  
 All painted walls and ceilings to have lightly knocked down (orange peel) texture.  
 All flooring material are to run wall to wall and into recesses.  
 All installation procedures must be approved by manufacturer and according to specifications.

**ACOUSTICAL CEILING TILE**

ACT-1 Armstrong Cirrus 24" x 24" x 3/4" Angled Tegular tiles with 584 Prelude .5/16" exposed Tee Grid. See arch. specs.  
 ACT-2 Armstrong, 24" x 24" x 3/4" square edge vinyl covered exterior grade, painted and galvanized grid.

**PAINT**

All paints to be Benjamin Moore  
 All wall paint to be eggshell finish unless noted otherwise.  
 All trim paint to be semi-gloss finish unless noted otherwise.  
 All ceiling paint to be flat finish unless noted otherwise.  
 All areas to receive wallcovering to be primed.

PT-1 (ceilings) Benjamin Moore, color TBD  
 PT-2 (restrooms) Benjamin Moore, color TBD  
 PT-3 (refer to alternates) Benjamin Moore, semi-gloss finish, color TBD

**CARPET**

Owner supplied contractor installed.  
 CPT-1 Monterey Tribeca Color: 6030-5525 Riverdale, 12" width, with "Enhance or Back #3" attached pad. See section 09680.

**WOOD**

WD-1 3" width Brazilian Cherry. \$10.50 sq. ft. allowance, material only, stained to match designer's supplied sample. Refer to alternates.  
 WD-2 (all trim) Medium finish, stained to match designer's supplied sample. Refer to alternates.  
 WD-3 (desktops) Medium finish, stained to match designer's supplied sample. Refer to alternates.

**GRANITE**

G-1 Silver sea green 3/4" thick slab, polished finish, edge as detailed in architectural specifications. Available through Kerry @ IGM 214-631-2202.  
 G-2 Silver sea green granite tiles, size: 12" X 12" X 3/8" thick, honed finish. Available through Kerry @ IGM 214-631-2202.

**SHEET VINYL**

SV-1 Armstrong Medintech #86495 Carthamus Champagne

**VINYL COMPOSITION TILE**

VCT-1 Mannington Commercial, Essentials, 12" x 12" x 1/8" thick, color TBD.

**WALLCOVERING**

Owner supplied, contractor installed.  
 Contractor to provide all wallcovering quantities.

WC-1 (main areas/lobby): Maharam, Style: Tek-wall Environ #395250, Color 007 Turf, 54" width. 55% Polyolefin, 42% Polyester, 3% Nylon, Teflon acrylic backing  
 WC-2 (offices & conference): Maharam, Style: Tek-wall Vista #395390, color 006 Seedling, 54" width. 100% Polyolefin, Teflon acrylic backing  
 WC-3 NOT USED

WC-4 (workroom): Maharam, Style: Milieu #395015 Relativity Series, Color 066 Dust, 54" width, Type II, 20 oz., 100% Vinyl, Polyester/cotton osnaburg backing

**SPECIAL FINISH**

SF-1 Multi-step process, special finish paint @ window frame and mullions, to match WD-2. Submit sample to designer for approval. Refer to section 09900.

**RUBBER BASE**

All rubber base to be continuous roll.  
 RB-1 Johnsonite wall base, 4" cove base, color TBD  
 RB-2 Johnsonite wall base, 4" straight base, color TBD  
 RB-3 Johnsonite wall base, 4" cove base, color TBD

**LAMINATE**

L-1 Nevamar ARP Surface, matrix, textured, 1 1/2" square edge, all colors TBD.  
 L-2 Nevamar ARP Surface, matrix, textured, 1 1/2" square edge, all colors TBD.

**LEATHER INSERT**

Contractor to supply substrate, owner will supply and mount leather, contractor install.  
 LTH-1 Leather inset, tanned, size: 48" x 30" h. Standard desk-top leather series, color: TBD, with one border of gold tooling, pattern TBD, and one border of blind tooling, pattern TBD. Available through Marci @ Larro leathers 214-760-7003. See arch. drawings.

**PEDIMAT**


PD-1 Pedimat tread inset, Pawling Corp., Rigid Back Nylon Carpet (SNC) color #595 Truffle or #596 Winter Slate. Submit samples to designer for approval.

**LONE STAR BANK ADDISON**  
 4650 Beltline Road  
 at Beltwood Parkway East  
 Addison, TX  
 Project #1805

**FINISH SCHEDULE**  
 08-18-00

ROOM	ROOM #	FLOOR	WALLS	BASE	TRIM	CEILING	REMARKS
Vestibule	101	WD-1/PD-1*	WC-1	WD-2	WD-2/SF-1	PT-1	*See arch drawing for layout
Entry	102	WD-1*	WC-1	WD-2	WD-2/SF-1	PT-1	*Special pattern/design see arch drawing for layout
Waiting	103	WD-1*	WC-1	WD-2	WD-2/SF-1	ACT-1	*See arch drawing for layout
Waiting	104	CPT-1	WC-1	WD-2	WD-2	PT-1	
Hall	105	CPT-1	WC-1	WD-2	WD-2	ACT-1	
ATM	106	VCT-1	PT-1	RB-1		ACT-1	
Enclosed Office #4	107	CPT-1	WC-2	WD-2	WD-2/SF-1*	ACT-1	*SF-1 @ windows
Enclosed office #1	108	CPT-1	WC-2	WD-2	SF-1	ACT-1	
Enclosed office #2	109	CPT-1	WC-2	WD-2	SF-1	ACT-1	
Enclosed office #3	110	CPT-1	WC-2	WD-2	SF-1	ACT-1	
Lobby	111	CPT-1	WC-1	WD-2	WD-2	PT-1	

ROOM	ROOM #	FLOOR	WALLS	BASE	TRIM	CEILING	REMARKS
Teller area	112	CPT-1	WC-1	WD-2	WD-2/SF-1 L-1/WC-1**	ACT-1/PT-1***	*L-1 @ window wall countertop & cabinetry **WC-1 below 3'-3" h counter surfaces. see attached drawing for locations ***PT-1 @ ceiling furdawn WD-3 @ teller line desk tops, see attached drawing LTH-1 @ desk tops inserts, see arch. details
Safe	113	CPT-1	PT-1	RB-2		ACT-1	
Vault	114	CPT-1	PT-1	RB-2		ACT-1	
Cash	115	CPT-1	PT-1	RB-2	L-3	ACT-1	L-3 @ countertop and backsplash
Conference	116	CPT-1	WC-2	WD-2	SF-1	ACT-1	
Workroom	117	SV-1	WC-4	RB-3	L-1/L-2*/SF-1	ACT-1	*L-1 @ countertop and backsplash L-2 @ cabinetry
Hall	118	SV-1	WC-4	RB-3		ACT-1	
Restroom-Men's	119	G-2	G-2/PT-2*	G-2	WD-2	PT-1	*PT-2 above granite tiles
Restroom-Women's	120	G-2	G-2/PT-2*	G-2	WD-2	PT-1	*PT-2 above granite tiles
Electrical	121	CONCRETE	PT-1	RB-1		PT-1	

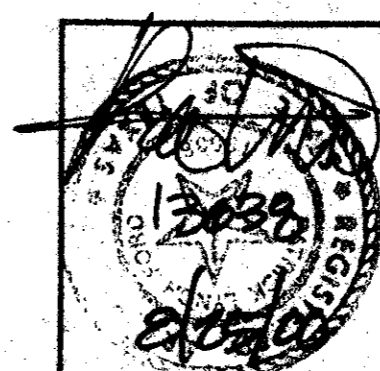

**R-F**  
 ROGERS - FORD  
 ARCHITECTURE - INTERIOR DESIGN  
 2616 THOMAS AVENUE  
 DALLAS, TEXAS 75204  
 TELEPHONE (214) 871-9388  
 FAX (214) 871-9155

LONE STAR BANK  
 4650 BELTLINE ROAD  
 at Beltwood Parkway East  
 ADDISON, TX  
 Project # 1804

8-25-2000 ADDENDUM #1  
 12-5-2000 CORRECT 16602

A7.02

**FINISH SCHEDULE**

Drawing P-1805-FS-1 - Addison Job - Drawings - 12/12/00 - Aug 25, 2000 1:27 pm by Craig Smith, R.F.D./JWG