

A New Banking Facility for  
**LONE STAR BANK**  
 4650 BELTLINE ROAD  
 ADDISON, TEXAS

LONE STAR BANK  
 4650 BELTLINE  
 B18-15

ASBUILTS



**ARCHITECT**

Rogers-Ford L.C.  
 2616 Thomas Avenue  
 Dallas, TX 75204  
 Phone: (214) 871-3300  
 Fax: (214) 871-3155

**STRUCTURAL ENGINEER**

Parkin - Perkins-Clean, Inc.  
 Consulting Engineering  
 12510 Pandora Drive, Suite 200  
 Dallas, TX 75238  
 Phone: (214) 221-2220  
 Fax: (214) 221-2252

**CIVIL ENGINEER**

Peoples Engineers  
 and Planners  
 2814 Tarpley Road, Suite 110  
 Carrollton, Texas 75006  
 Phone: (972) 416-1565  
 Fax: (972) 416-5285

**ELECTRICAL ENGINEER**

Strahn Engineering  
 4601 50th Street, Suite 22  
 Lubbock, Texas 79416  
 Phone: (806) 780-1475  
 Fax: (806) 780-8025

**MECH/PLUMBING ENGINEER**


Biddy Associates, Inc.  
 308 Horseshoe Bend Estates  
 Iowa Park, Texas 76367  
 Phone: (846) 767-1467  
 Fax: (846) 723-1325

**LANDSCAPE ARCHITECT**

Kendall Landscape Architecture  
 The Mosaic Building  
 5646 Milton, Suite 135  
 Dallas, TX 75206  
 Phone: (214) 398-3226  
 Fax: (214) 373-6882

**INTERIOR DESIGNER**

Rogers-Ford L.C.  
 2616 Thomas Avenue  
 Dallas, TX 75204  
 Phone: (214) 871-3300  
 Fax: (214) 871-3155

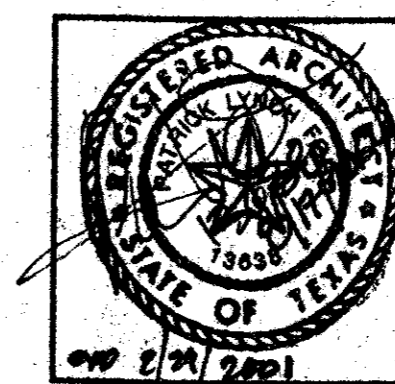

**R-F**  
 ROGERS-FORD  
 ARCHITECTURE - INTERIOR DESIGN  
 2616 THOMAS AVENUE  
 DALLAS, TEXAS 75204  
 TEL: (214) 871-3300  
 FAX: (214) 871-3155

LONE STAR BANK  
 4650 BELTLINE ROAD  
 at Beltwood Parkway East  
 ADDISON, TX  
 Project # 1804

7-25-2000 PERMIT ISSUE  
 8-17-2000 ISSUE FOR BID  
 12-05-00 CONST. ISSUE

CS0.00

ARCHITECTURAL RENDERING

3415B - Addison, Architecture/Interior Design at Aug 17, 2000 12:28pm by Ching