


FLOOR PLAN - LIGHTING
 SCALE: 1/4" = 1'-0"


GENERAL NOTES:

- A. REFER TO ARCHITECTURAL REFLECTED CEILING PLAN FOR EXACT LOCATION OF CEILING MOUNTED FIXTURES.
- B. VERIFY EXACT LOCATION AND MOUNTING HEIGHT OF ALL WALL MOUNTED LIGHTING FIXTURES WITH ARCHITECT PRIOR TO ROUGH-IN.
- C. WALL-BOX DIMMERS SHALL BE LUTRON VAREO SERIES OR AN APPROVED EQUAL.

KEYED NOTES:

- ① CONTROLLED BY PHOTOCELL ON ROOF.
- ② J-BOX FOR SIGNAGE. SIGNAGE TO BE OWNER FURNISHED AND CONTRACTOR INSTALLED. VERIFY MOUNTING HEIGHT WITH ARCHITECT PRIOR TO ROUGH-IN.
- ③ OWNER FURNISHED CONTRACTOR INSTALLED LANE LIGHT. VERIFY LOCATION MOUNTING AND SWITCHING REQUIREMENTS WITH OWNER.
- ④ OWNER FURNISHED CONTRACTOR INSTALLED PENDANT FIXTURE. VERIFY EXACT ELECTRICAL REQUIREMENTS ON SITE.
- ⑤ RECESS MOUNTED RETRACTABLE EMERGENCY LIGHT ABOVE EXIT LIGHT. WALL PANEL TO MATCH WALL FINISH. COORDINATE INSTALLATION ON SITE.

VOICE: 806.780.7475 CELL: 806.777.7775
 FAX: 806.780.0129 EMAIL: mtspe@door.net
STRAHAN ENGINEERING
 4601 50TH STREET SUITE 212
 LUBBOCK, TEXAS 79414

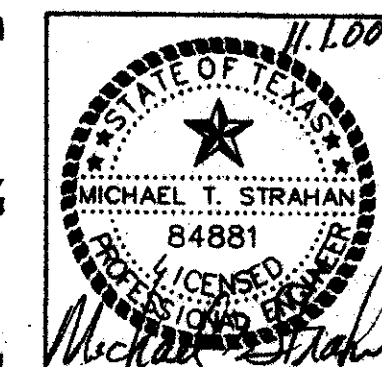

R-F
 ROGERS - FORD
 ARCHITECTURE - INTERIOR DESIGN
 2616 THOMAS AVENUE
 DALLAS, TEXAS 75204
 TELEPHONE (214) 871-9388
 FAX (214) 871-3155

LONE STAR BANK
 Belwood Parkway East
 at Beltline Road
 Addison, TX
 Project # 1804

12-5-2000 CONSTRUCTION
 11-5-2000 CONSTRUCTION

E1.01