

**NOTES:**

1. ALL ROOF TRUSSES ARE SPACED AT 24" O.C. U.N.O. COORDINATE HEIGHT AND CONFIGURATIONS WITH ARCHITECTURAL DRAWINGS.
2. ALL HORIZONTAL FRAMING LUMBER TO BE #2 KD SYP UNLESS NOTED OTHERWISE, OR LUMBER WITH EQUIVALENT OR BETTER STRUCTURAL PROPERTIES. OTHER LUMBER SPECIES MUST BE APPROVED IN WRITING BY THE ENGINEER.
3. ALL EXTERIOR WALLS SHALL BE LOAD BEARING.
4. ALL WOOD BEAMS ARE FLUSH BEAMS OR LOAD BEARING HEADERS UNLESS NOTED OTHERWISE (DB = DROP BEAM, PB = POCKET BEAM).
5. REFERENCE SHEET S1.01 FOR STRUCTURAL NOTES AND SCHEDULES.

**SHEARWALL NOTES**

1. ALL SHEARWALLS INDICATED ON PLAN ARE LOCATED AT FLOOR BELOW.
2. ALL SHEARWALLS INDICATED ON PLAN ARE TYPE A TYPICAL UNLESS NOTED OTHERWISE. REFERENCE SHEARWALL SCHEDULE 4/S1.01.


**LEGEND**

= SHEARWALL REFERENCE SHEARWALL NOTES THIS SHEET, AND SHEARWALL SCHEDULE 4/S1.01

1  
S2.02

ROOF FRAMING PLAN

SCALE: 1/4"=1'-0"

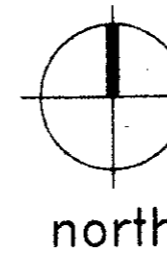

WOOD FRAMING SCHEDULE		
WOOD BEAM & HEADER		STUD / COLUMN SUPPORT
MARK	SIZE	MINIMUM SIZE
(A)	2-2x8	2-2x STUDS
(B)	2-2x10	2-2x STUDS
(C)	3-2x8	3-2x STUDS
(D)	3-2x10	3-2x STUDS
(E)	2-2x12	3-2x STUDS
(F)	3-2x12	3-2x STUDS



THE SEAL APPEARING ON THIS DOCUMENT WAS AUTHORIZED BY R. TRENT PERKINS, P.E. 04264 ON 27 JULY 00

THIS DOCUMENT IS THE RENDERING OF A PROFESSIONAL SERVICE, THE ESSENCE OF WHICH IS THE PROVIDING OF ADVICE, JUDGEMENT, OPINION, OR SIMILAR PROFESSIONAL SKILL.

**P P O**  
 Parkin • Perkins • Olsen  
 Consulting Engineering, Inc.  
 12970 Pandora Drive Suite 200  
 Dallas, Texas 75238  
 Tel 214.221.2220 - Fax 214.221.2252  
 Project No. 38018

**R-F**  
 ROGERS • FORD  
 ARCHITECTURE - INTERIOR DESIGN  
 2616 THOMAS AVENUE  
 DALLAS, TEXAS 75204  
 TELEPHONE (214) 871-9388  
 FAX (214) 871-3155

LONE STAR BANK  
 4650 Bellme Road  
 Addison, TX  
 Project # 1804

7-27-2000 PERMIT ISSUE  
 8-17-2000 ISSUE FOR BID  
 8-25-2000 ADDENDUM #1  
 12-5-2000 Change 1540E

S2.02

ROOF FRAMING PLAN

FILE INFO: 80185292.dwg 11:48:08/25/00 09:13