

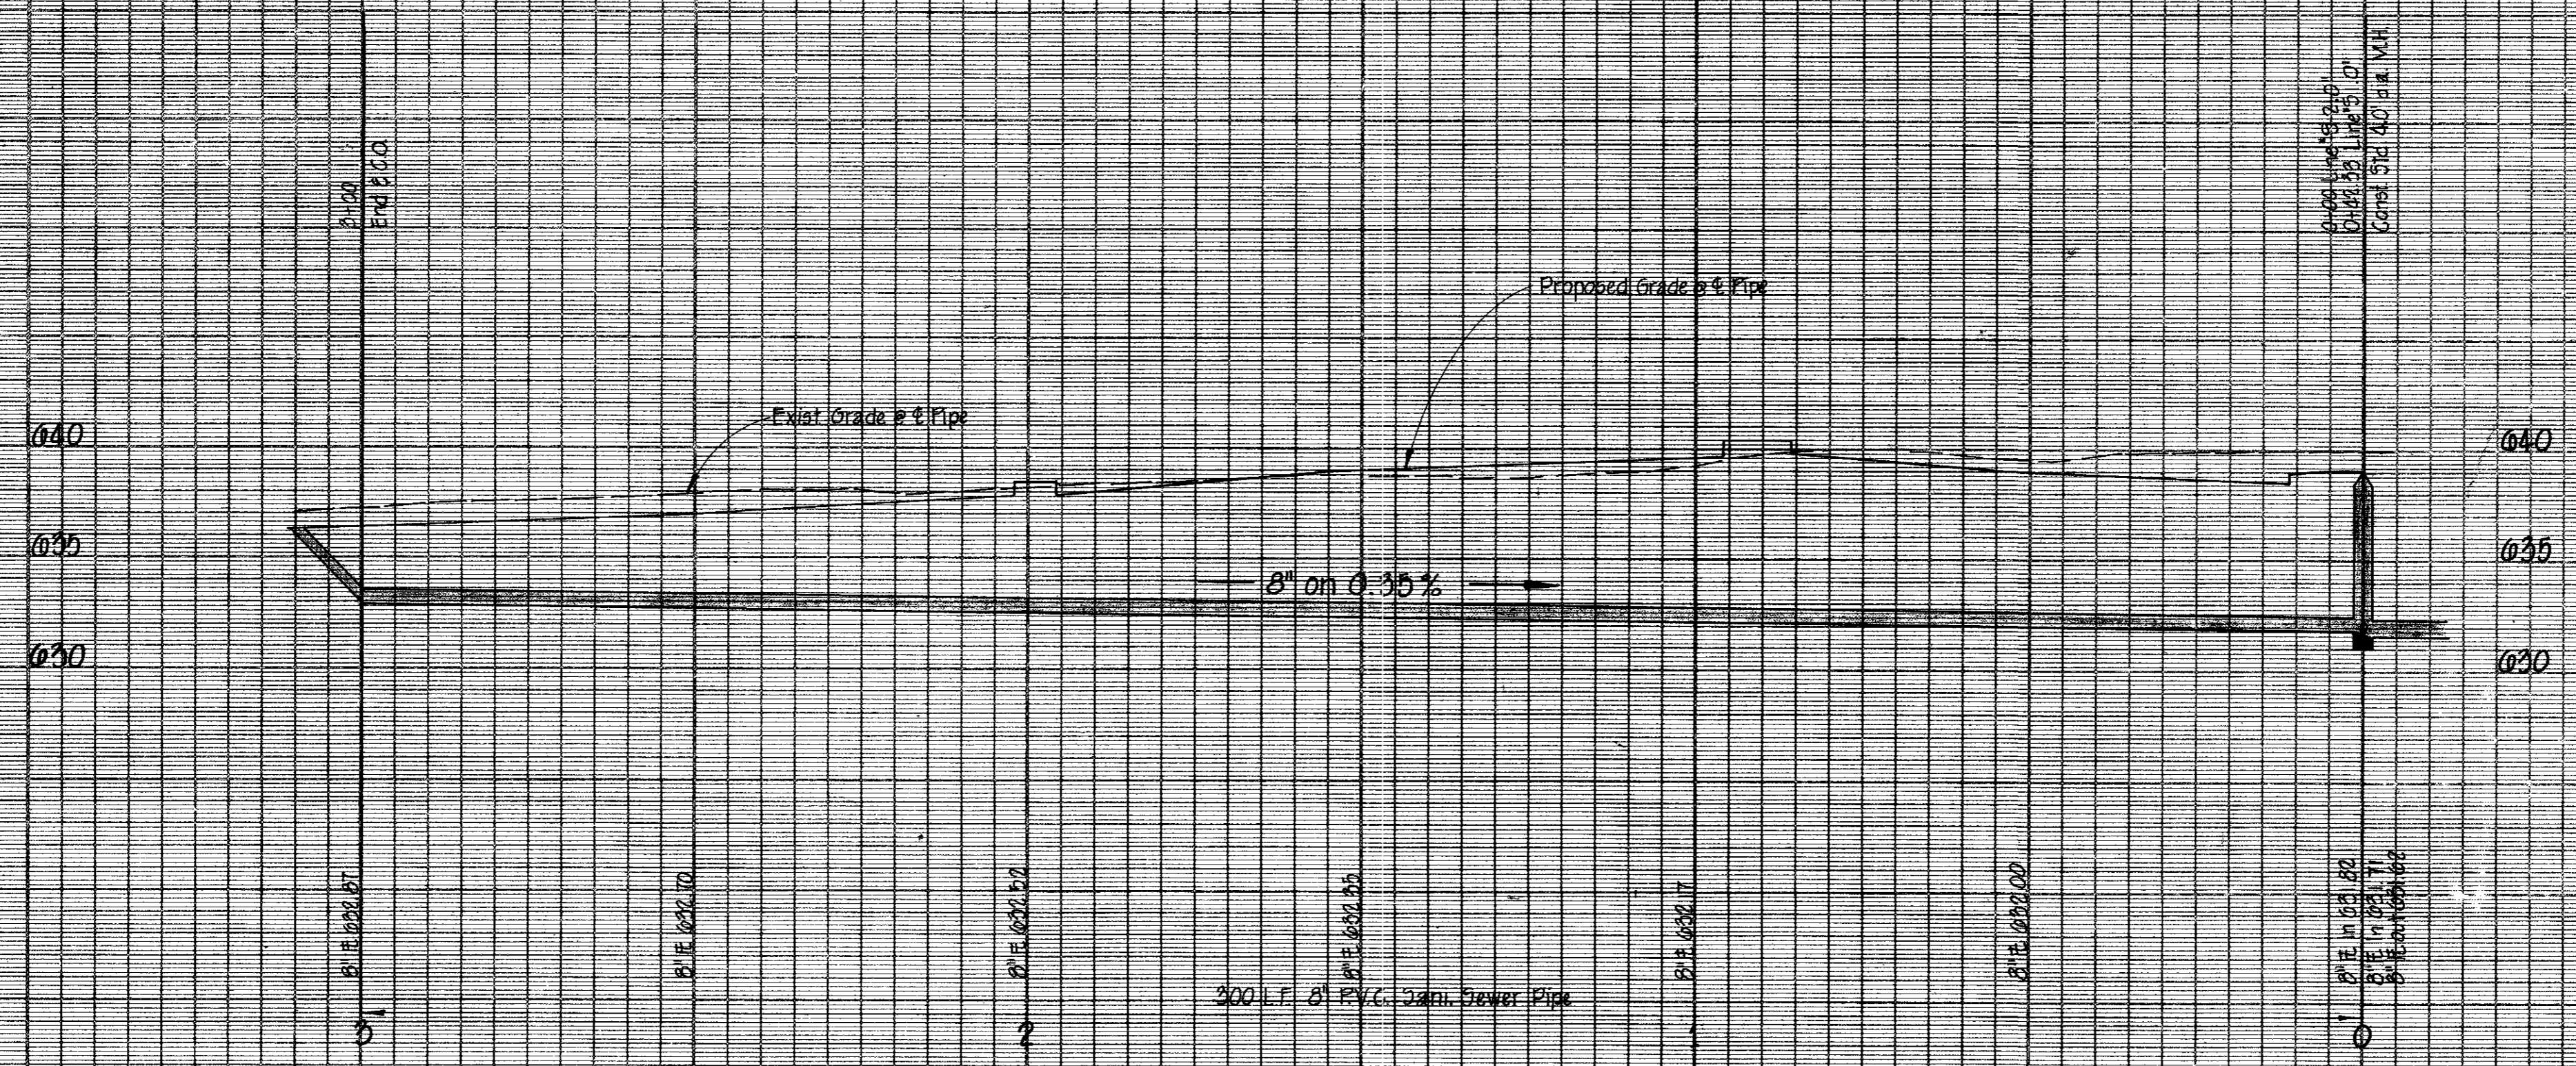


LINE "5-2.0"

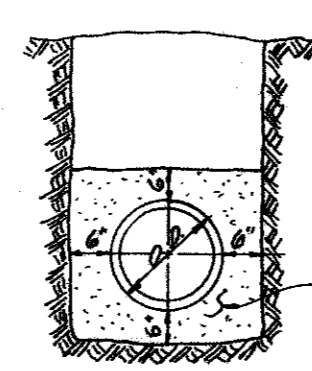

LINE "3-1.0"

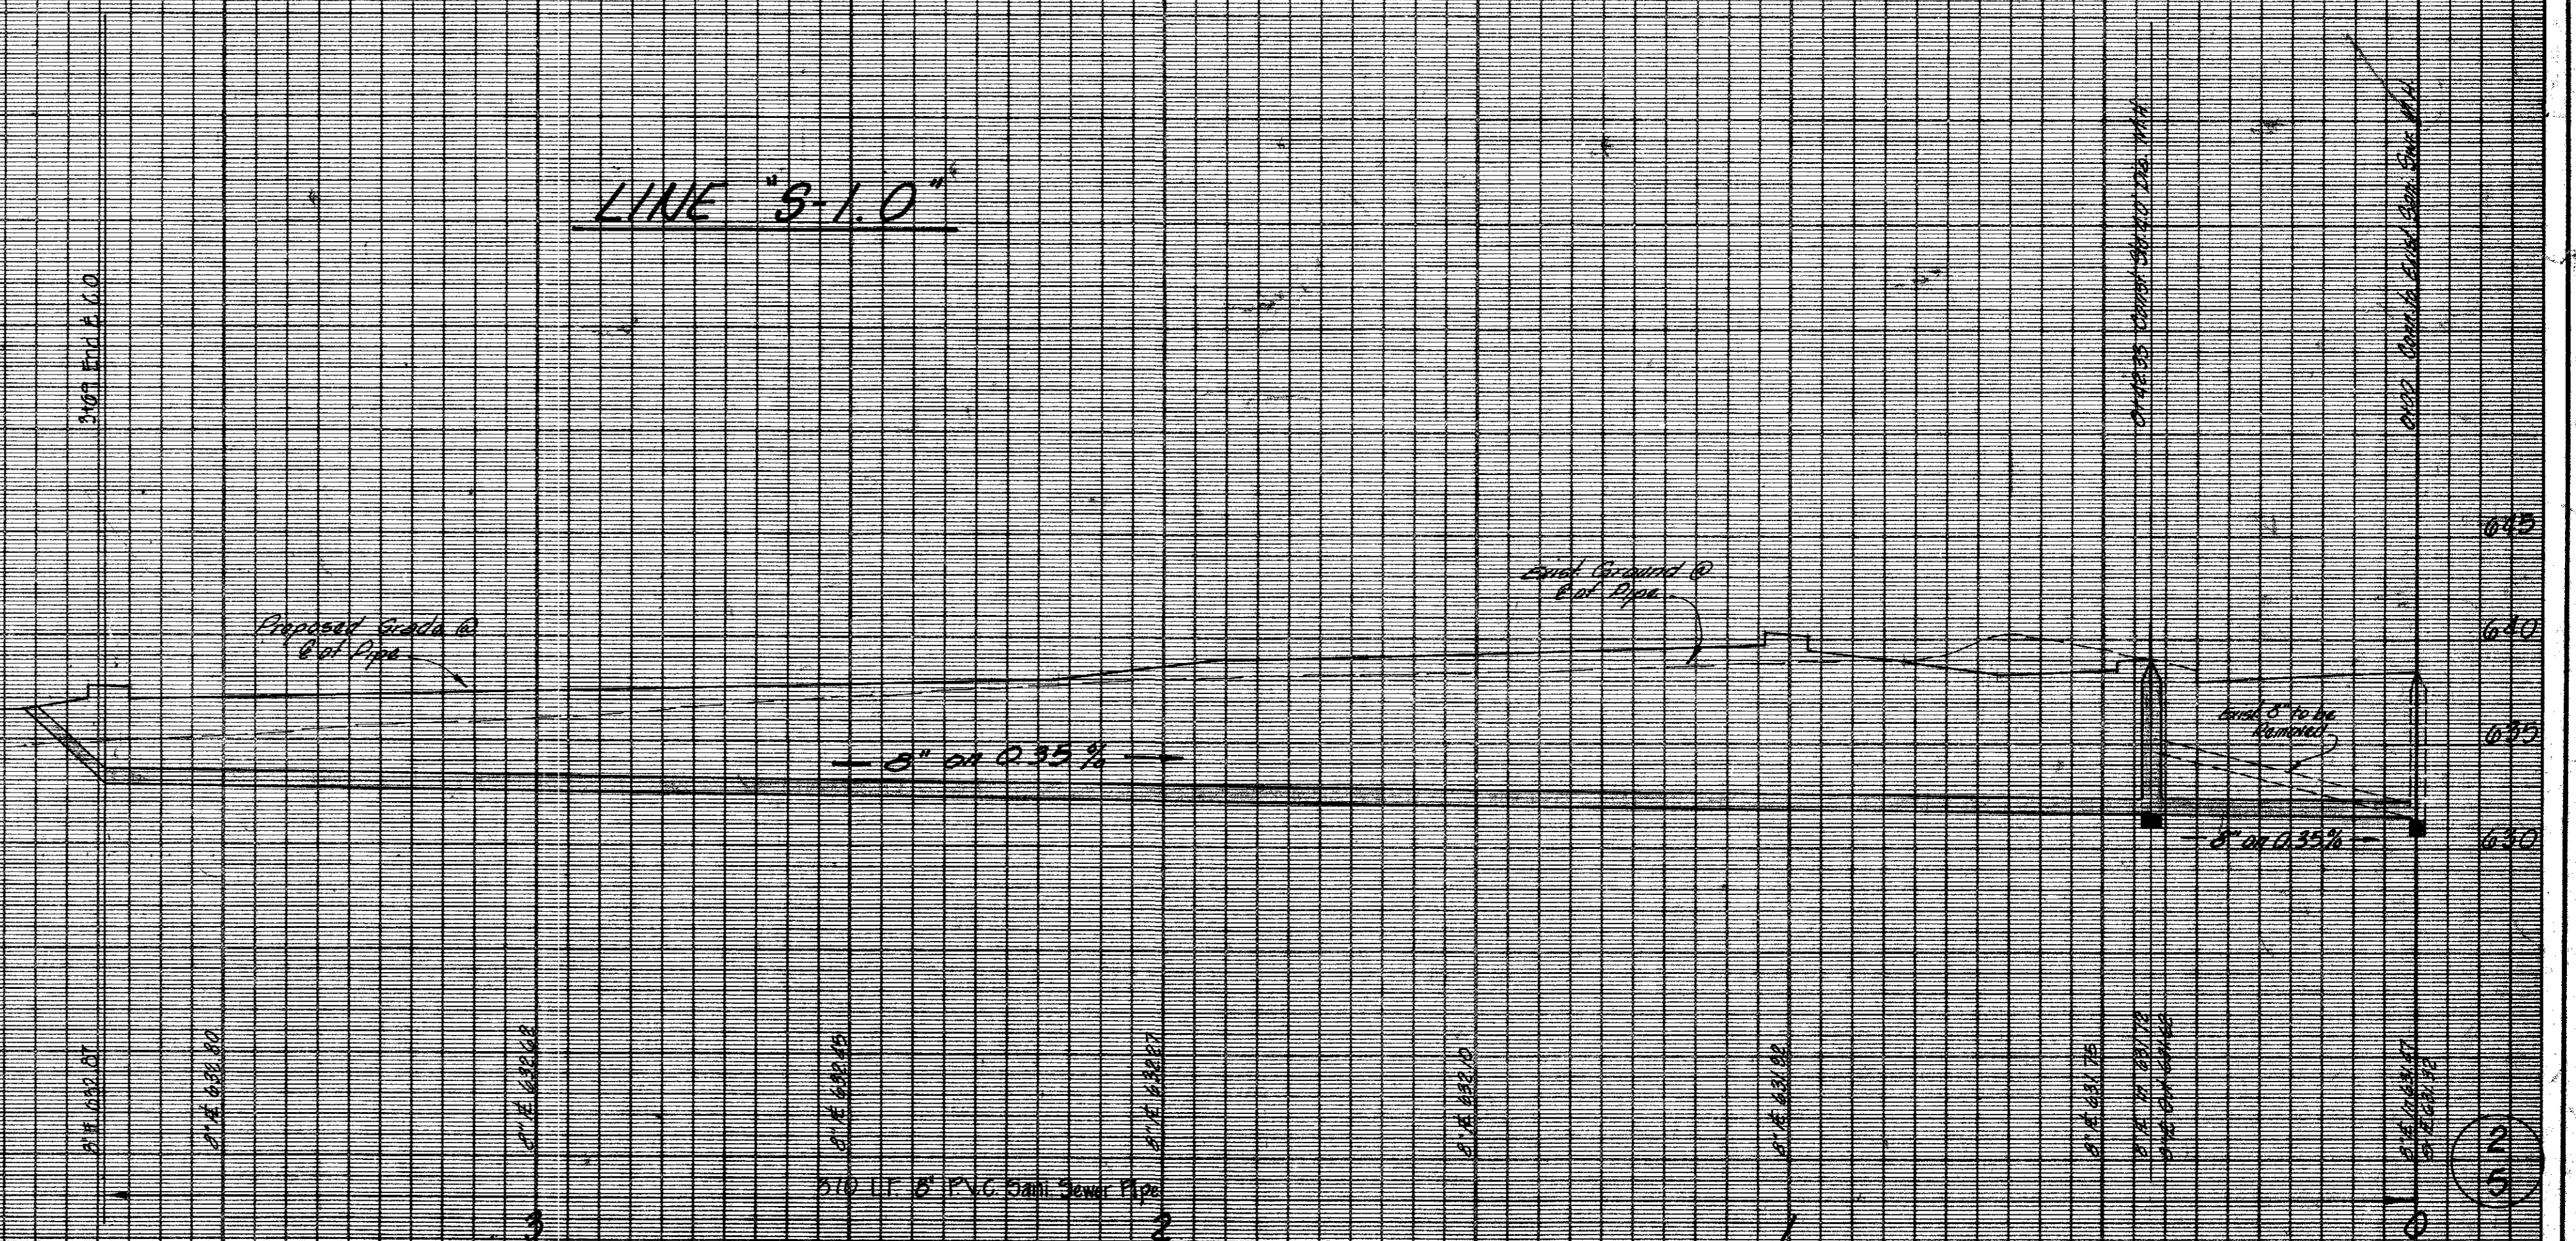

EMBEDMENT FOR WATER & SANITARY SEWER PIPE  
 Fine Granular Material, carefully compacted (90%)

BENCH MARK

1. 0" Top of curb at radius return on Inwood Road at southeast corner of intersection of Inwood Road & Bull Line Road. Elev. 635.49
2. 0" Top of curb 30' E south of radius return on Landmark Boulevard at southwest corner of intersection of Landmark Blvd & Bull Line Road. Elev. 639.64

AS BUILT  
 DATE 8-16-82

**SANITARY SEWER PROFILE**

SITE 6, BLOCK 1

QUORUM WEST

RAYMOND L. GOODSON JR. INC. ENGINEERS

CITY OF ADDISON, TEXAS

DESIGN	DRAWN	DATE	SCALE	NOTES	FILE	NO.
R.L. Goodson, Jr., Inc.		MARCH 1982	1"=20' H 1"=6' V	R.L.G.	82	20

17978 W.