


# CIVIL SITE DEVELOPMENT PLANS



## BELTLINE ROAD ADDISON, TEXAS

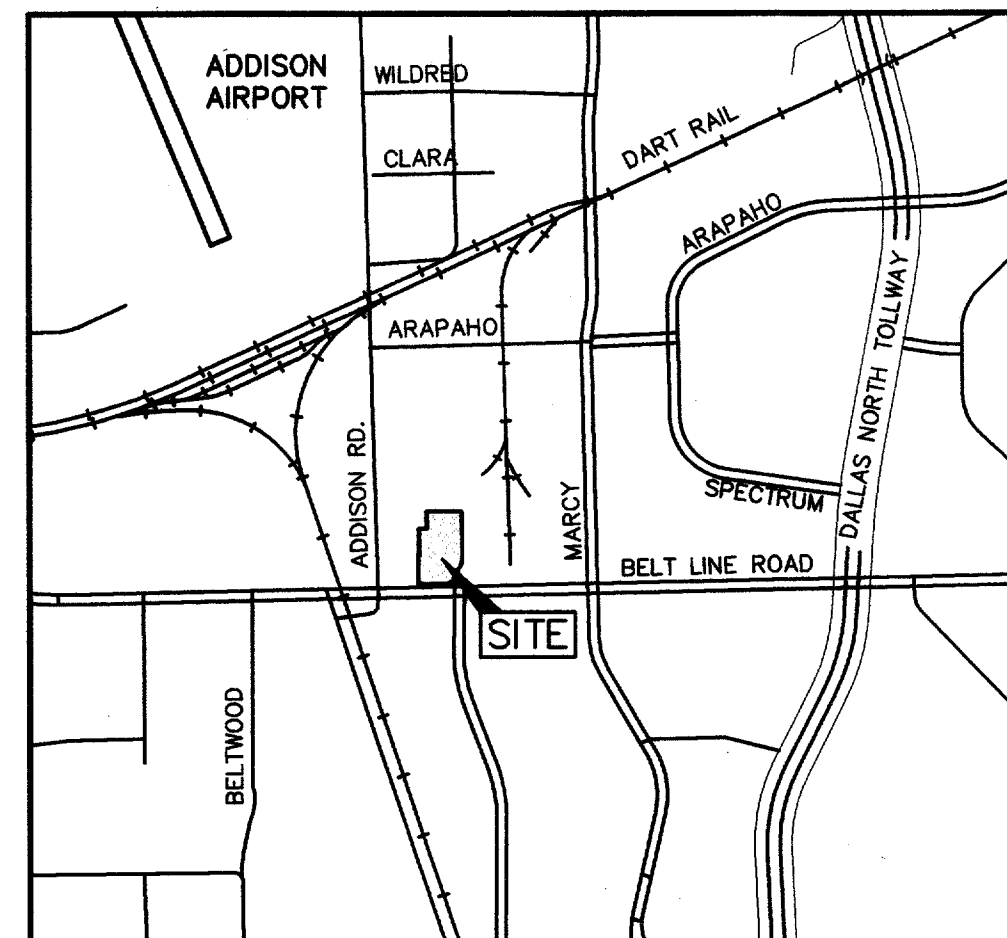

LOCATION MAP  
N.T.S.  
(MAPSCO: 14C)

### PLANS SUBMITTAL/REVIEW LOG

- SUBMITTAL TO TOWN OF ADDISON FOR INITIAL REVIEW - NOT FOR CONSTRUCTION. 03/01/05
- RESUBMITTAL TO TOWN OF ADDISON FOR PLAN APPROVAL. 04/21/05
- ISSUED FOR CONSTRUCTION. 05/02/05

### INDEX OF SHEETS

| SHEET NO. | DESCRIPTION                                | REVISION |
|-----------|--|----------|
| C-0       | COVER SHEET                                |          |
|           | REPLAT (TWO SHEETS)                        |          |
| C-1       | GENERAL CONSTRUCTION NOTES                 |          |
| C-2       | DEMOLITION PLAN                            |          |
| C-3       | SITE PLAN                                  | ▲▲       |
| C-4       | GRADING PLAN                               | ▲▲       |
| C-5       | DRAINAGE AREA MAP                          |          |
| C-6       | STORM SEWER PLAN                           |          |
| C-7       | UTILITY PLAN                               | ▲▲       |
| C-8       | EROSION CONTROL PLAN/SITE MAP (S.W.P.P.P.) |          |
| C-9       | EROSION CONTROL DETAILS (S.W.P.P.P.)       |          |
| C-10      | SITE PAVING AND STRIPING PLAN              | ▲        |
| C-11      | MISCELLANEOUS CONSTRUCTION DETAILS         | ▲        |
| C-12      | STORM SEWER AND SANITARY SEWER DETAILS     |          |

### PLAN REVISION LOG


| NO. | DATE     | COMMENT                                      |
|-----|----------|--|
| ▲   | 07/05/05 | ADDITIONAL TXJ ELECTRIC EASEMENT PER REQUEST |
| ▲   | 08/12/05 | REVISE PER CLIENT AND CONTRACTOR COMMENTS    |
| ▲   | 10/14/05 | REVISE LANGUAGE PER TXJ COMMENTS             |

## MAY 2005

### OWNER/DEVELOPER

BRINKER INTERNATIONAL  
PROPERTY DEVELOPMENT  
6820 LBJ FREEWAY  
DALLAS, TEXAS 75240  
PH. (972) 770-4156  
CONTACT: ANTHONY THOMPSON


### ENGINEER

 **Kimley-Horn  
and Associates, Inc.**  
12700 Park Central Drive, Suite 1800  
Dallas, Texas 75251  
Tel. No. (972) 770-1300  
Fax No. (972) 238-3820  
CONTACT: BRIAN J. PARKER, P.E.

### "RECORD DRAWING"

THIS DRAWING HAS BEEN REVISED TO SHOW THOSE CHANGES DURING THE CONSTRUCTION PROCESS REPORTED BY THE CONTRACTOR TO KIMLEY-HORN AND ASSOCIATES, INC. AND CONSIDERED TO BE SIGNIFICANT. THIS DRAWING IS NOT GUARANTEED TO BE "AS-BUILT" BUT IS BASED ON THE INFORMATION MADE AVAILABLE.

DATE: 11-17-05 BY: *B. J. Parker*

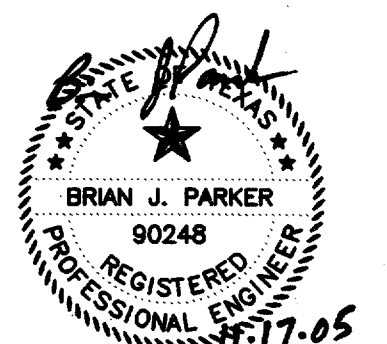

**STOP!**  
**CALL BEFORE YOU DIG**

DIG TESS  
1-800-DIG-TESS  
(@ least 72 hours prior to digging)