


CIVIL SITE DEVELOPMENT PLANS



BELTLINE ROAD ADDISON, TEXAS

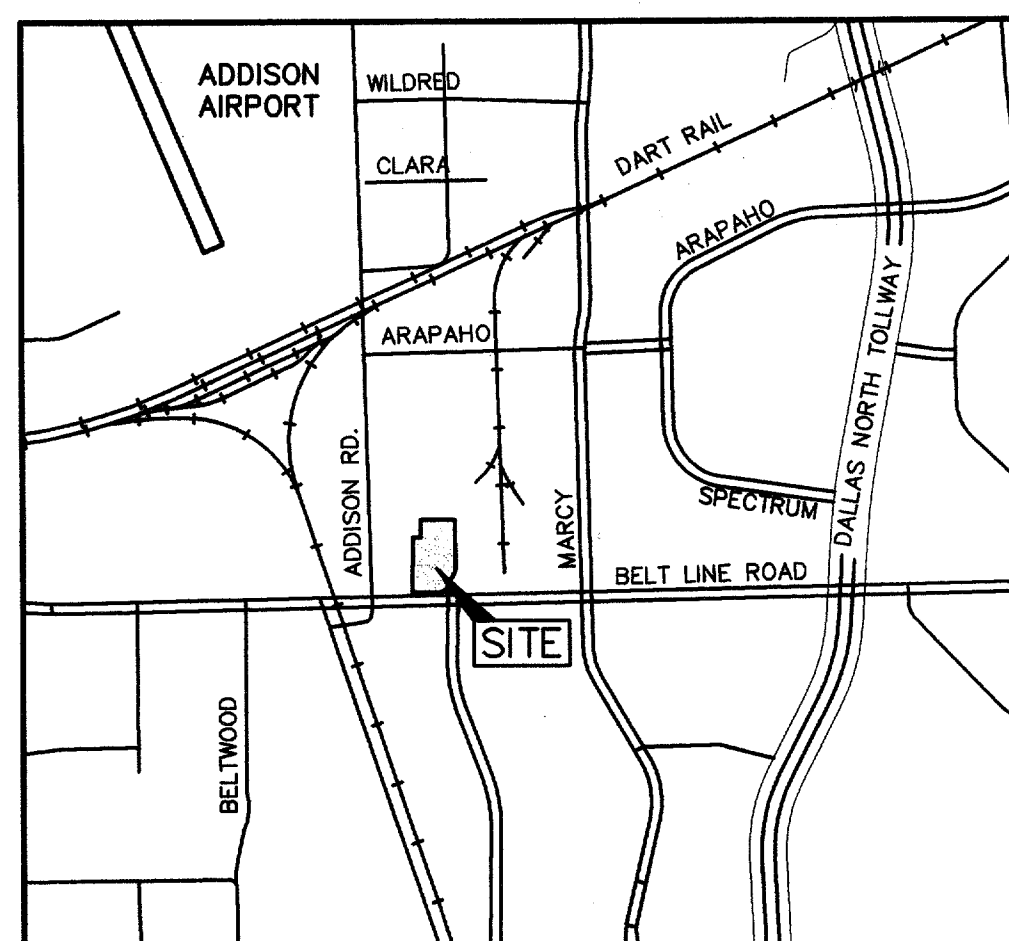

LOCATION MAP
N.T.S.
(MAPSCO: 14C)

MAY 2005

PLANS SUBMITTAL/REVIEW LOG

- SUBMITTAL TO TOWN OF ADDISON FOR INITIAL REVIEW - NOT FOR CONSTRUCTION. 03/01/05
- RESUBMITTAL TO TOWN OF ADDISON FOR PLAN APPROVAL 04/21/05
- ISSUED FOR CONSTRUCTION 05/02/05

INDEX OF SHEETS

| SHEET NO. | DESCRIPTION | REVISION |
|-----------|--|----------|
| C-0 | COVER SHEET | |
| | REPLAT (TWO SHEETS) | |
| C-1 | GENERAL CONSTRUCTION NOTES | |
| C-2 | DEMOLITION PLAN | |
| C-3 | SITE PLAN | ▲▲ |
| C-4 | GRADING PLAN | ▲ |
| C-5 | DRAINAGE AREA MAP | |
| C-6 | STORM SEWER PLAN | ▲▲ |
| C-7 | UTILITY PLAN | ▲▲▲ |
| C-8 | EROSION CONTROL PLAN/SITE MAP (S.W.P.P.) | |
| C-9 | EROSION CONTROL DETAILS (S.W.P.P.) | |
| C-10 | SITE PAVING AND STRIPING PLAN | ▲ |
| C-11 | MISCELLANEOUS CONSTRUCTION DETAILS | ▲ |
| C-12 | STORM SEWER AND SANITARY SEWER DETAILS | |


PLAN REVISION LOG

| NO. | DATE | COMMENT |
|-----|----------|--|
| ▲ | 07/05/05 | ADDITIONAL TXU ELECTRIC EASEMENT PER REQUEST |
| ▲ | 08/12/05 | REVISE PER CLIENT AND CONTRACTOR COMMENTS |
| ▲ | 10/14/05 | REVISE LANGUAGE PER TXU COMMENTS |
| ▲ | 11/17/05 | REVISE STM. SEW. LINE "SD1" PER ASBUILT |

OWNER/DEVELOPER

BRINKER INTERNATIONAL
PROPERTY DEVELOPMENT
6820 LBJ FREEWAY
DALLAS, TEXAS 75240
PH. (972) 770-4156
CONTACT: ANTHONY THOMPSON

ENGINEER

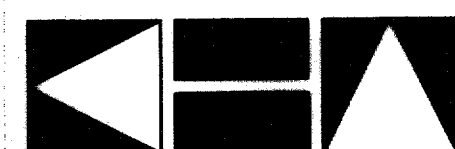


**Kimley-Horn
and Associates, Inc.**

12700 Park Central Drive, Suite 1800
Dallas, Texas 75251
CONTACT: BRIAN J. PARKER, P.E.

Tel. No. (972) 770-1300
Fax No. (972) 239-3820

"RECORD DRAWING"
THIS DRAWING HAS BEEN REVISED TO SHOW THOSE CHANGES DURING THE CONSTRUCTION PROCESS REPORTED BY THE CONTRACTOR TO KIMLEY-HORN AND ASSOCIATES, INC. AND CONSIDERED TO BE SIGNIFICANT. THIS DRAWING IS NOT GUARANTEED TO BE "AS-BUILT" BUT IS BASED ON THE INFORMATION MADE AVAILABLE.
DATE: 11-17-05 BY: *B. J. Parker*

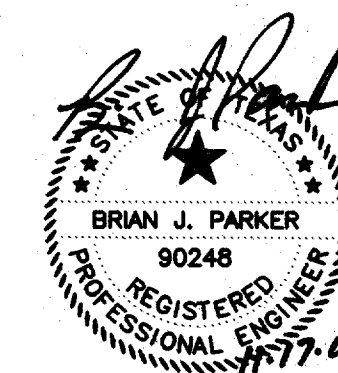

STOP!
CALL BEFORE YOU DIG

DIG TESS
1-800-DIG-TESS
(@ least 72 hours prior to digging)

SHEET
C-0
OF 12

FF-6

ON THE BORDER - ADDISON

3855 BELT LINE

File: C:\V\10\10384003\10384003.dwg [C-1] 11/17/2005 4:53pm