




GENERAL NOTES

1. THE OWNER AND CONTRACTOR SHALL EACH SUBMIT A NOTICE OF INTENT (NOI) TO TCEQ AT LEAST 48 HOURS PRIOR TO COMMENCING CONSTRUCTION ACTIVITIES. OWNER AND CONTRACTOR ARE RESPONSIBLE FOR OBTAINING AND MAINTAINING A CURRENT COPY OF THESE DOCUMENTS AT THE CONSTRUCTION SITE.
2. TCEQ TEXAS POLLUTANT DISCHARGE ELIMINATION SYSTEM (TPDES) CONSTRUCTION GENERAL PERMIT TXR150000, LANDSCAPE PLANS, GEOTECHNICAL INVESTIGATION, AND CIVIL ENGINEERING PLANS AND SPECIFICATIONS ARE HEREBY INCORPORATED INTO THIS SWPPP. CONTRACTOR SHALL OBTAIN AND KEEP A CURRENT COPY OF THESE DOCUMENTS AT THE CONSTRUCTION SITE.
3. ALL EROSION AND SEDIMENTATION CONTROLS MUST BE DESIGNED, INSTALLED AND MAINTAINED TO RETAIN SEDIMENT ON-SITE TO THE EXTENT PRACTICABLE.
4. ALL CONTROL MEASURES MUST BE SELECTED, INSTALLED, AND MAINTAINED IN ACCORDANCE WITH MANUFACTURERS SPECIFICATIONS AND GOOD ENGINEERING PRACTICES.
5. OFF-SITE ACCUMULATIONS OF SEDIMENT ESCAPING PROJECT SITE MUST BE REMOVED AT A FREQUENCY NECESSARY TO MINIMIZE OFF-SITE IMPACTS. FOR EXAMPLE, SEDIMENTATION WITHIN STREETS ADJACENT TO THE PROJECT SITE MUST BE REMOVED PRIOR TO RAINFALL EVENTS. ALL FINES IMPOSED FOR TRACKING ONTO PUBLIC ROADS SHALL BE PAID BY THE CONTRACTOR. IN ANY EVENT SILT SHALL ALWAYS BE REMOVED SUCH THAT PONDING IN A STREET IS PREVENTED.
6. CONTRACTOR MUST REMOVE SEDIMENT FROM ALL APPLICABLE CONTROLS WHEN DESIGN SILT STORAGE CAPACITY HAS BEEN REDUCED BY 50%.
7. CONTRACTOR SHALL ENSURE THAT ALL LITTER, CONSTRUCTION DEBRIS, AND CONSTRUCTION CHEMICALS ARE PREVENTED FROM BECOMING POLLUTANT SOURCES.
8. CONTRACTOR SHALL ENSURE THAT EXISTING VEGETATION IS PRESERVED WHERE ATTAINABLE.
9. OFF-SITE MATERIAL STORAGE AREAS USED SOLELY FOR THIS PROJECT, INCLUDING DIRT STOCKPILES AND BORROW AREAS (AS APPLICABLE), MUST BE PREVENTED FROM BECOMING POLLUTANT SOURCES BY INSTALLATION OF BMP'S.
10. DISTURBED PORTIONS OF SITE MUST BE STABILIZED. STABILIZATION PRACTICES MUST BE INITIATED WITHIN 14 DAYS IN PORTIONS OF THE SITE WHERE CONSTRUCTION HAS BEEN EITHER TEMPORARILY OR PERMANENTLY CEASED, UNLESS EXCEPTED WITHIN THE TPDES PERMIT.
11. CONTRACTOR MUST MAINTAIN RECORDS OF DATES IN THE SWPPP OF WHEN MAJOR GRADING ACTIVITIES OCCUR, WHEN CONSTRUCTION ACTIVITIES EITHER TEMPORARILY OR PERMANENTLY CEASE ON A PORTION OF THE SITE, AND WHEN STABILIZATION MEASURES ARE INITIATED.
12. CONTRACTOR SHALL ENSURE THAT SWPPP IS CONSISTENT WITH SEDIMENT AND EROSION SITE PLANS, STORM WATER PERMITS, AND STORM WATER MANAGEMENT PLANS APPROVED BY STATE, TRIBAL, OR LOCAL OFFICIALS. UPDATES TO SWPPP ARE REQUIRED UPON WRITTEN NOTICE TO PERMITTEE OF CHANGES APPLICABLE TO STORM WATER PERMITS, SEDIMENT AND EROSION CONTROL PLANS, OR STORM WATER MANAGEMENT PLANS BY SUCH OFFICIALS.
13. ALL EROSION AND SEDIMENTATION CONTROL MEASURES AND ANY OTHER PROTECTIVE MEASURES IDENTIFIED IN THE SWPPP MUST BE MAINTAINED IN EFFECTIVE OPERATING CONDITION. WHEN INSPECTIONS IDENTIFY CONTROLS OPERATING INEFFECTIVELY, THE CONTROLS SHALL BE MAINTAINED PRIOR TO THE NEXT RAINFALL EVENT OR AS NECESSARY TO MAINTAIN EFFECTIVENESS OF THE CONTROL, OR AS SOON AS PRACTICABLE.
14. CONTRACTOR SHALL INSPECT DISTURBED AREAS, MATERIAL STORAGE AREAS EXPOSED TO PRECIPITATION, STRUCTURAL CONTROL MEASURES, AND VEHICLE ENTRY AND EXIT AREAS AT LEAST ONCE EVERY 14 CALENDAR DAYS AND WITHIN 24 HOURS OF A STORM EVENT OF 0.5 INCHES OR GREATER.
15. CONTRACTOR SHALL INSPECT STABILIZED AREAS AND AREAS WHERE RUNOFF IS UNLIKELY DUE TO FROZEN OR ARID WEATHER CONDITIONS AT LEAST ONCE PER MONTH.
16. CONTRACTOR SHALL INSPECT ACCESSIBLE DISCHARGE LOCATIONS (OR NEARBY DOWNSTREAM LOCATIONS IF DISCHARGE POINT IS NOT ACCESSIBLE) IN ORDER TO ASCERTAIN WHETHER OR NOT EROSION CONTROL MEASURES ARE EFFECTIVE IN PREVENTING SIGNIFICANT IMPACTS TO RECEIVING WATERS.
17. STRUCTURAL BMP'S SHOULD NOT, TO THE DEGREE ATTAINABLE, BE PLACED WITHIN FLOODPLAINS.
18. BASED ON INSPECTION RESULTS, REVISIONS TO SWPPP MUST BE MADE WITHIN 7 CALENDAR DAYS OF THE INSPECTION. NEW OR MODIFIED CONTROL MEASURES MUST BE INSTALLED PRIOR TO THE NEXT RAINFALL EVENT, OR AS SOON AS PRACTICABLE.
19. REPORTS SUMMARIZING THE SCOPE OF ALL INSPECTIONS, INCLUDING NAME AND QUALIFICATIONS OF INSPECTOR, DATE OF INSPECTION, AND MAJOR OBSERVATIONS RELATING TO THE IMPLEMENTATION OF THE SWPPP (INCLUDING LOCATION OF DISCHARGES OF SEDIMENT OR OTHER POLLUTANTS, LOCATION OF CONTROLS THAT NEED TO BE MAINTAINED, LOCATIONS WHERE CONTROLS ARE INADEQUATE OR ARE OPERATING IMPROPERLY, AND LOCATIONS WHERE ADDITIONAL CONTROLS ARE NEEDED) MUST BE SIGNED BY THE INSPECTOR PER 30 TEXAS ADMINISTRATIVE CODE (TAC) SECTION 305.228, AND RETAINED WITHIN THE SWPPP FOR AT LEAST 3 YEARS FROM THE DATE THE SITE IS FINALLY STABILIZED. REPORTS THAT DO NOT IDENTIFY INCIDENTS OF NON-COMPLIANCE SHALL CONTAIN A CERTIFICATION STATING THAT THE SITE IS IN COMPLIANCE WITH THE SWPPP AND THE GENERAL PERMIT.
20. CONTRACTOR SHALL IDENTIFY ALL SOURCES OF NON-STORM WATER THAT WILL BE DRAINAGE WITH STORM WATER AT THE SITE (EXCEPT FIRE-FIGHTING ACTIVITIES) AND ENSURE IMPLEMENTATION OF APPROPRIATE POLLUTION PREVENTION MEASURES FOR NON-STORM WATER COMPONENT(S) OF DISCHARGE.
21. CONTRACTOR SHALL ENSURE THAT THE INDIVIDUAL SIGNING THE SWPPP MAKES THE CERTIFICATION UNDER PART VI.G.2.d OF THE GENERAL PERMIT. THIS CERTIFICATION MUST APPEAR WITHIN THE SWPPP.
22. CONTRACTOR SHALL SUBMIT A NOTICE OF TERMINATION (NOT) TO TCEQ AND A COPY OF THE N.O.T. TO THE OPERATOR IF ANY MS4 RECEIVING DISCHARGE WITHIN THIRTY (30) DAYS AFTER FINAL STABILIZATION, OR ANOTHER OPERATOR HAS ASSUMED CONTROL, OR ALL SILT FENCES AND OTHER TEMPORARY EROSION CONTROL, HAS BEEN REMOVED.
23. SUPPLEMENTARY INFORMATION BOOKLET (CONTAINING SAMPLE INSPECTION FORM AND A COPY OF THE TPDES GENERAL PERMIT NO. TXR 150077) IS TO BE KEPT ON-SITE AND WITH THESE SWPPP PLANS AT ALL TIMES.



- SILT FENCE GENERAL NOTES**
1. SILT FENCES WHICH SUPPORT THE SILT FENCE SHALL BE INSTALLED ON A SLIGHT ANGLE TOWARD THE ANTICIPATED RUNOFF SOURCE. FENCES MUST BE SPACED AT A MINIMUM OF 10 FEET.
 2. THE LINE OF THE SILT FENCE SHALL BE PERPENDICULAR TO THE LINE OF FLOW. SILT FENCES SHOULD BE TRENCHED IN (4-6" DEEP), NEARLY FLAT OR SPILLAGE TO PREVENT FLOW FROM BEING DIVERTED AROUND THE FENCE.
 3. SILT FENCES MUST BE SPACED BY 6 FEET MINIMUM AND 6 INCHES MORE TO ALLOW FOR THE SILT FENCE FACING TO BE LAD IN THE FUTURE.
 4. SILT FENCES SHOULD BE SECURELY FASTENED TO BARRIERS, SUPPORT POINTS OR TO WOODEN WIPES OR STAPLES OR STAPLES TO THE GROUND. AT TOP AND BOTTOM ENDS SILT FENCES SHOULD BE ATTACHED TO THE STEEL FENCE POST. THESE SHALL BE A 3 FOOT MINIMUM, SPACED AT 10 FOOT INTERVALS ALONG THE LINE OF FLOW.
 5. REPAIRS SHALL BE MADE EVERY TWO WEEKS AND AFTER EACH 1/2" RAINFALL. REPAIR OR REPLACEMENT SHALL BE MADE IMMEDIATELY AS NEEDED.
 6. SILT FENCES SHALL BE REMOVED WHEN THE SITE IS COMPLETELY STABILIZED SO AS NOT TO BLOCK OR IMPED STORM FLOW OR ACCUMULATE SILT. SILT SHALL BE REMOVED WHEN IT REACHES A HEIGHT OF HALF THE HEIGHT OF THE FENCE. THE SILT SHALL BE DISPOSED OF AT AN APPROVED SITE AND IN SUCH A MANNER AS TO NOT CONTRIBUTE TO ADDITIONAL EROSION.

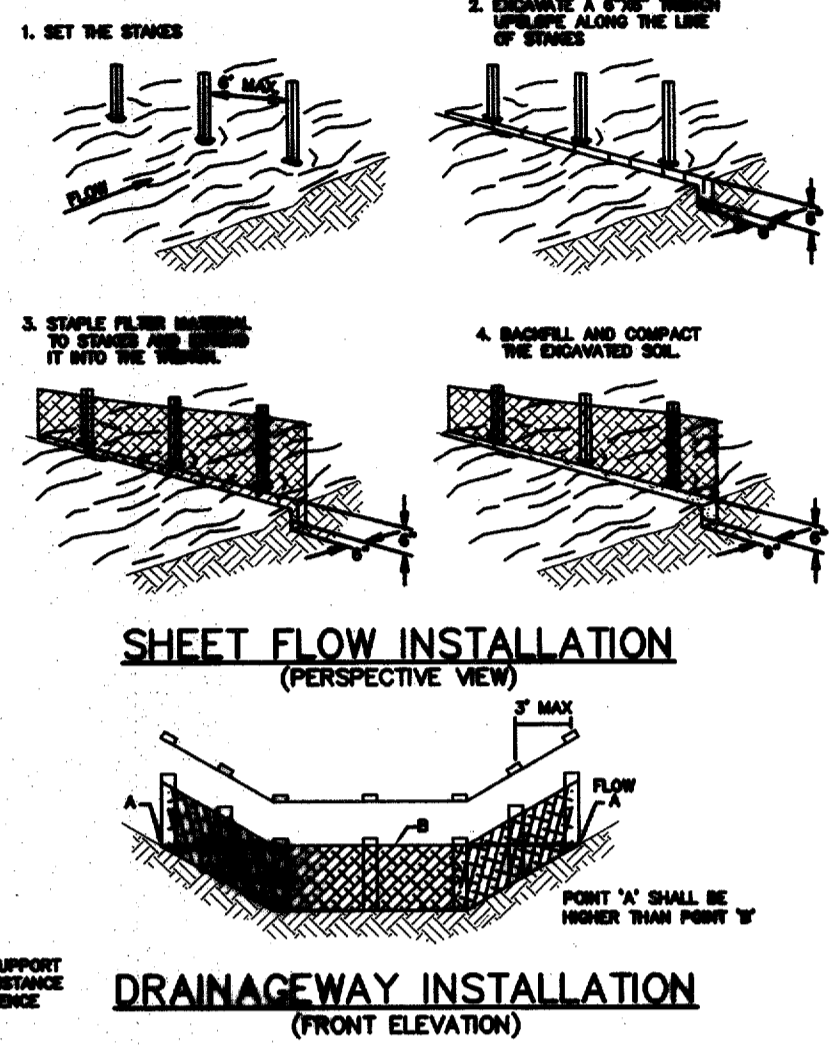

SEDIMENTATION/SILT FENCE WITHOUT WIRE SUPPORT
N.T.S.

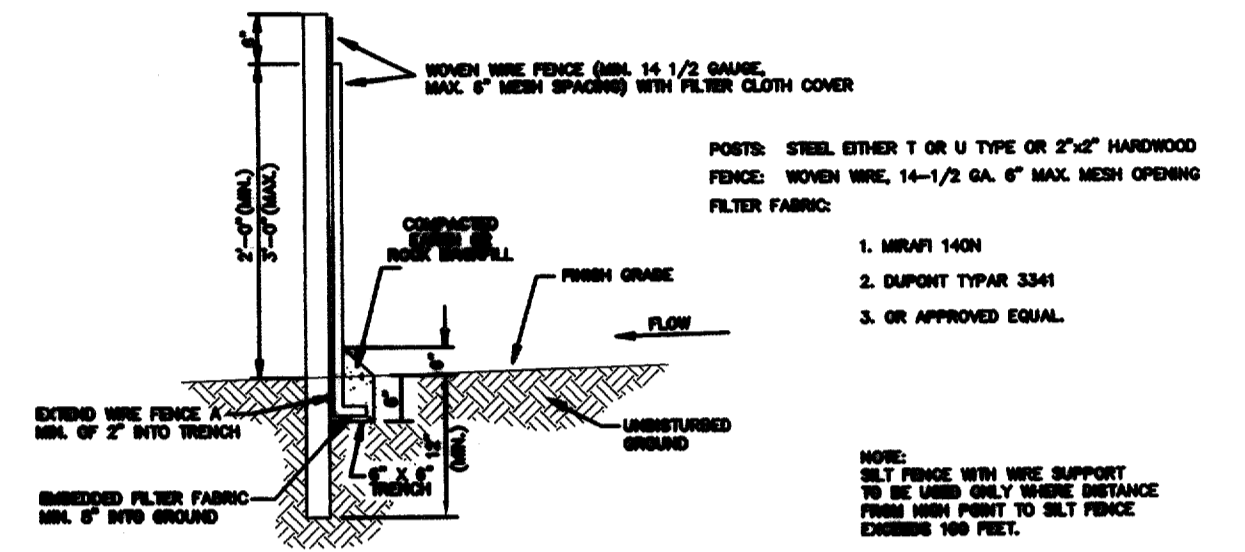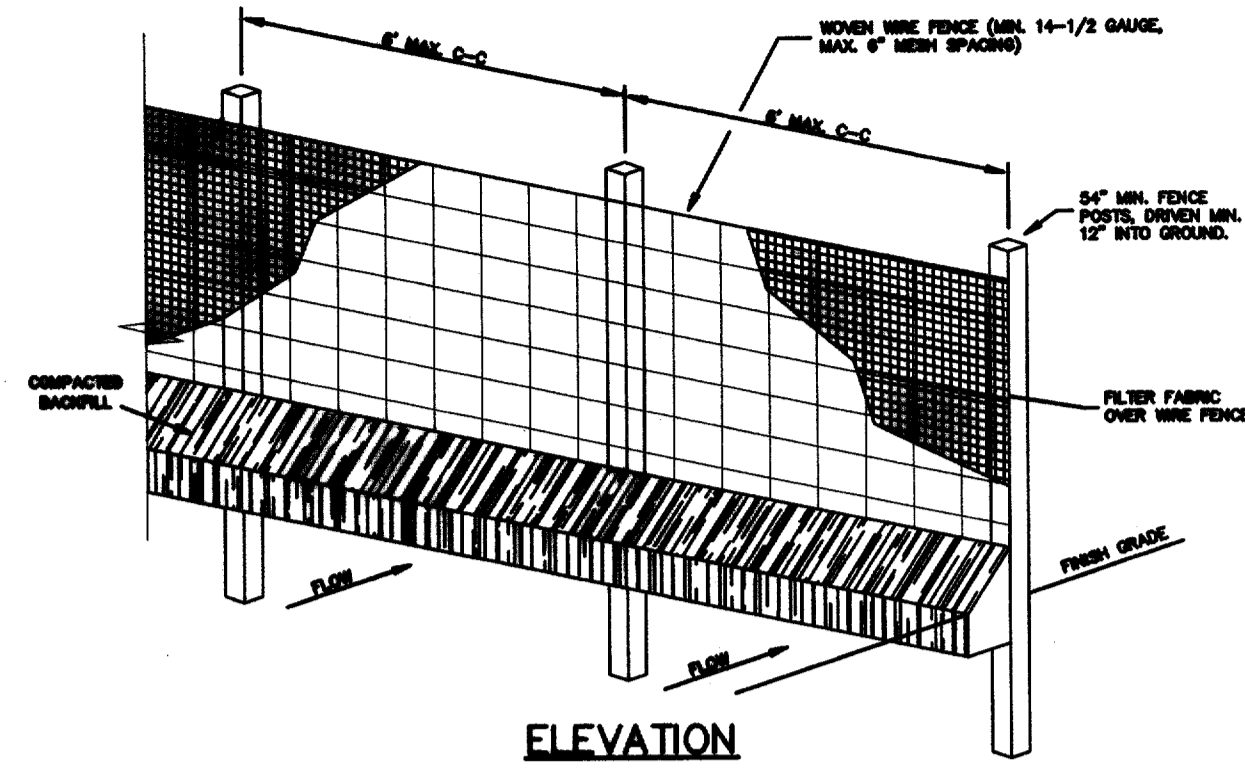




SEDIMENTATION/SILT FENCE WITH WIRE SUPPORT
N.T.S.

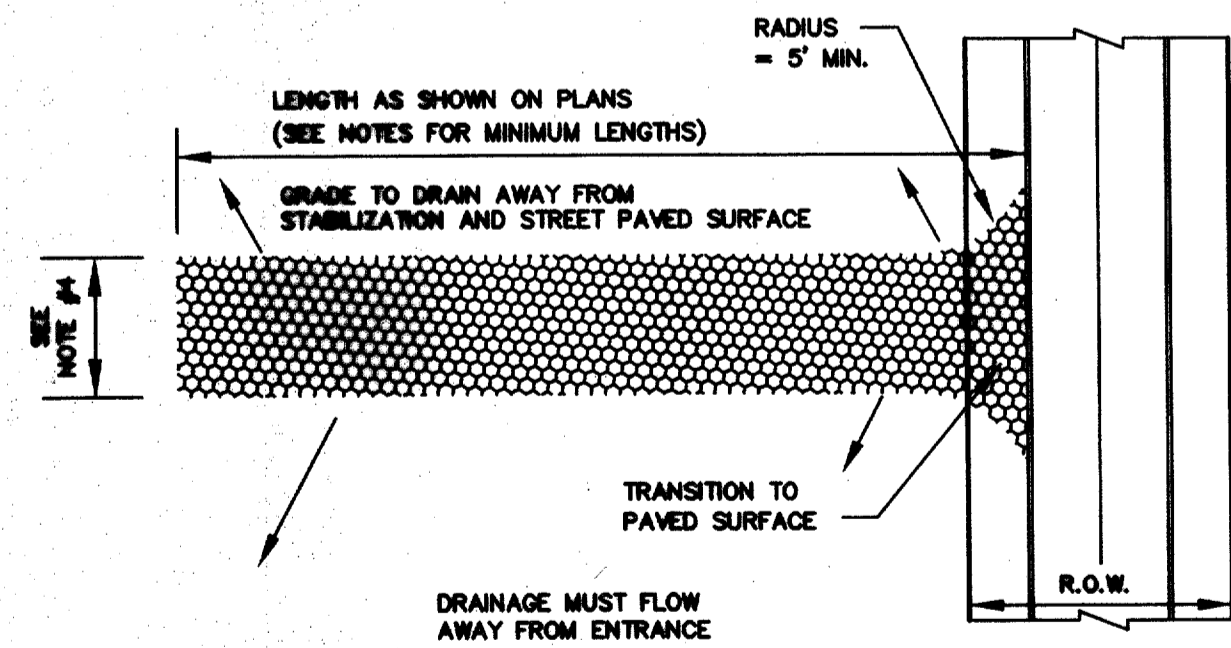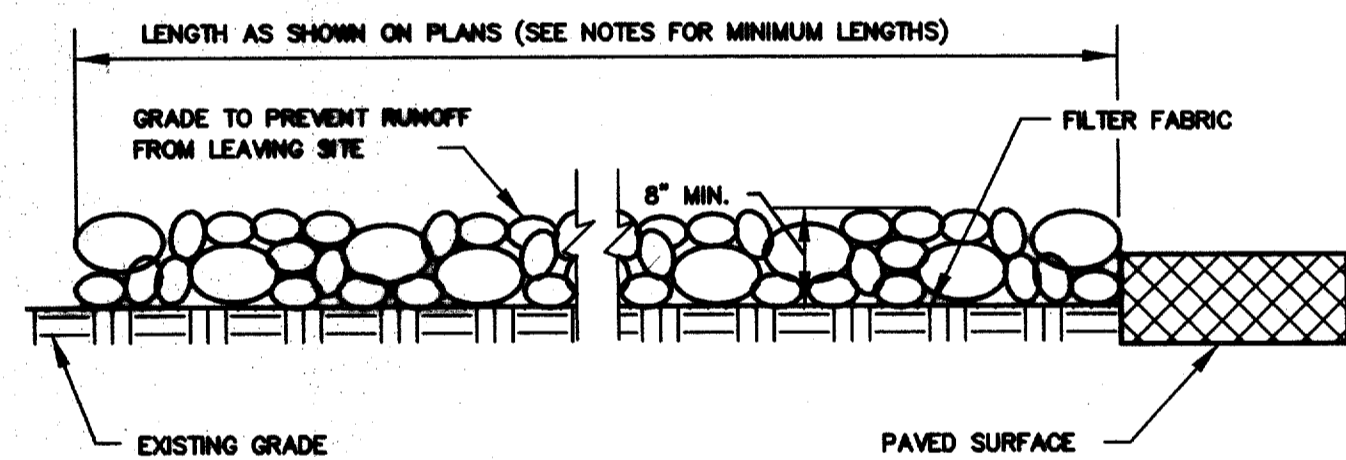

STABILIZED CONSTRUCTION ENTRANCE GENERAL NOTES:

1. STONE SHALL BE 4 TO 6 INCH DIAMETER CRUSHED ROCK OR ACCEPTABLE CRUSHED PORTLAND CEMENT CONCRETE.
2. LENGTH SHALL BE SHOWN ON PLANS, WITH A MINIMUM LENGTH OF 30 FEET FOR LOTS WHICH ARE LESS THAN 150 FEET FROM EDGE OF PAVEMENT. THE MINIMUM DEPTH IN ALL OTHER CASES SHALL BE 50 FEET.
3. STONE LAYER THICKNESS SHALL NOT BE LESS THAN 8".
4. THE WIDTH SHALL BE NO LESS THAN THE FULL WIDTH OF ALL POINTS OF INGRESS OR EGRESS.
5. WHEN NECESSARY, VEHICLES SHALL BE CLEANED TO REMOVE SEDIMENT PRIOR TO ENTRANCE ONTO A PUBLIC ROADWAY. WHEN WASHING IS REQUIRED, IT SHALL BE DONE ON AN AREA STABILIZED WITH CRUSHED STONE WITH DRAINAGE FLOWING AWAY FROM BOTH THE STREET AND THE STABILIZED ENTRANCE. ALL SEDIMENT SHALL BE PREVENTED FROM ENTERING ANY STORM DRAIN, DITCH OR WATERCOURSE USING APPROVED METHODS.
6. THE ENTRANCE SHALL BE MAINTAINED IN A CONDITION WHICH WILL PREVENT TRACKING OR FLOWING OF SEDIMENT ONTO PAVED SURFACES. THIS MAY REQUIRE PERIODIC TOP DRESSING WITH ADDITIONAL STONE AS CONDITIONS DEMAND. ALL SEDIMENT SPILLED, DROPPED, WASHED, OR TRACKED ONTO PAVED SURFACES MUST BE REMOVED IMMEDIATELY.
7. THE ENTRANCE MUST BE PROPERLY GRADED OR INCORPORATE A DRAINAGE SWALE TO PREVENT RUNOFF FROM LEAVING THE CONSTRUCTION SITE.

STABILIZED CONSTRUCTION ENTRANCE
N.T.S.

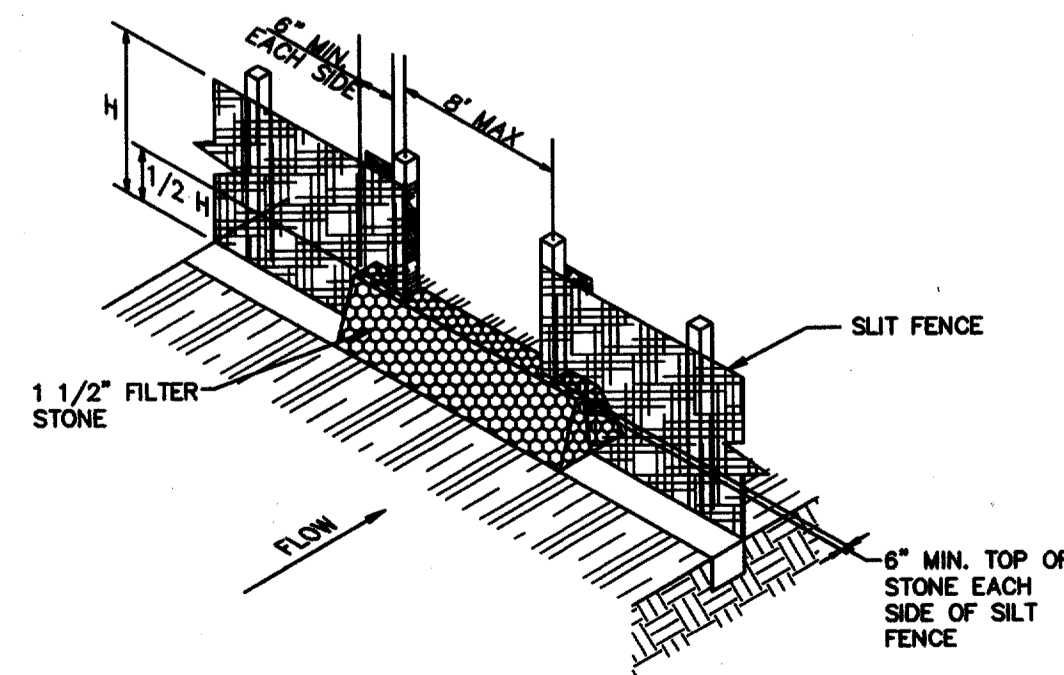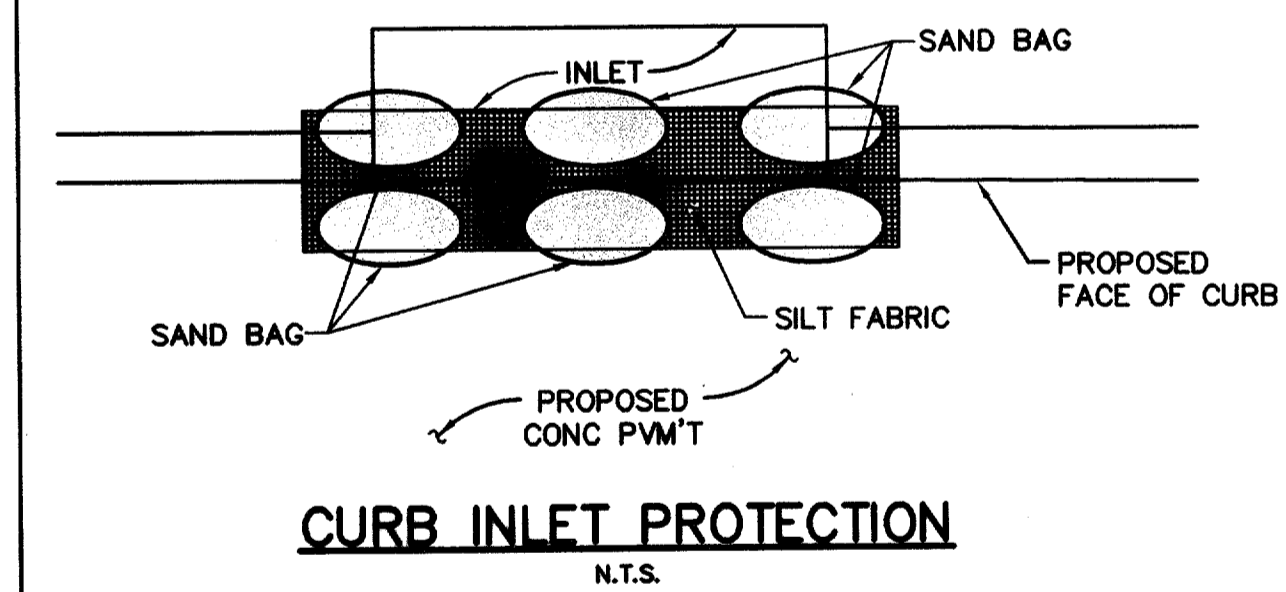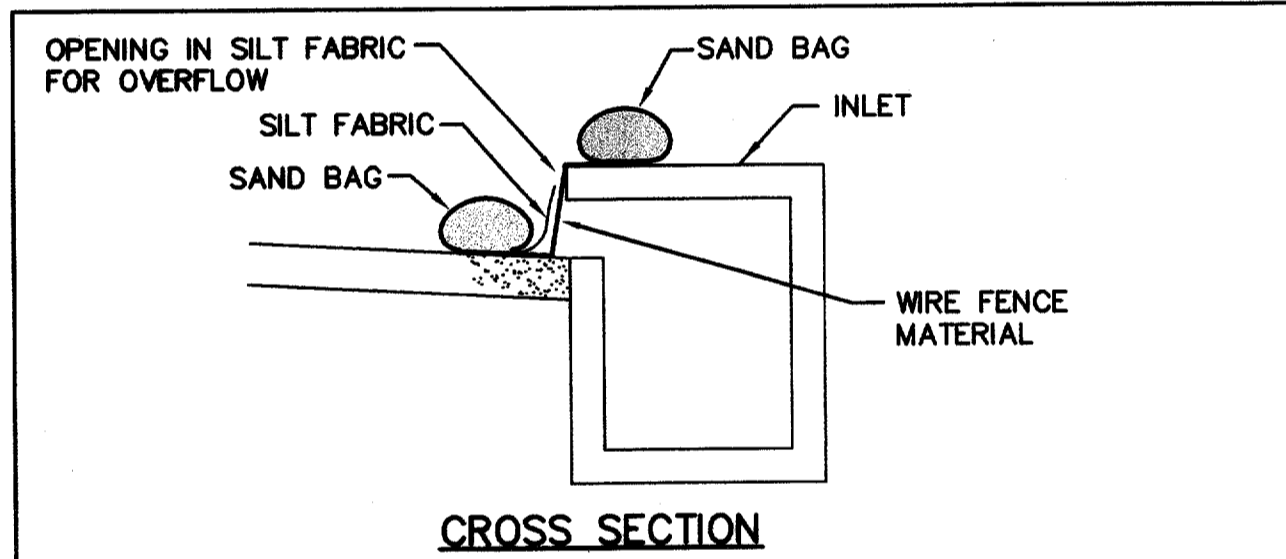

VEGETATIVE STABILIZATION REQUIREMENTS

TEMPORARY SEEDING

1. ALL DISTURBED AREAS WHICH WILL BE LEFT DORMANT FOR GREATER THAN 14 DAYS SHALL BE SEEDING WITH FAST-GERMINATING TEMPORARY VEGETATION IMMEDIATELY FOLLOWING GRADING OPERATIONS. SELECTION OF THE SEED WILL DEPEND ON THE TIME OF YEAR IT IS APPLIED (SEE DESCRIPTIONS IN TABLE 2). REFERENCE LANDSCAPE PLAN FOR PERMANENT STABILIZATION REQUIREMENTS.

TABLE 2
VEGETATION TABLE*

TEMPORARY SEEDING SPECIES	PLANTING RATE	PLANTING DATES
CRIMSON CLOVER	7#/ACRE	8/15 - 11/30
MILLET, FOXTAIL	30#/ACRE	5/1 - 8/31
RYEGRASS, ANNUAL	30#/ACRE	8/15 - 9/30
SPRANGLETOP, GREEN	2.5#/ACRE	2/1 - 5/1
TALL FESCUE	7-10#/1000 SF	9/1 - 10/15

*USE ONLY USDA CERTIFIED SEED.

SURFACE PREPARATION FOR TEMPORARY SEEDING

1. INSTALL EROSION STRUCTURES SUCH AS DIKES, DIVERSIONS, ETC. PRIOR TO SEEDING.
2. FURROW SLOPES STEEPER THAN 3:1 ON THE CONTOUR LINE BEFORE SEEDING.
3. ENSURE SEED BED IS PULVERIZED, LOOSE, AND UNIFORM.

APPLICATION

1. WHEN HYDROMULCHING IS USED, DO NOT MIX SEED AND FERTILIZER MORE THAN 30 MINUTES PRIOR TO APPLICATION.
2. APPLY SEED EVENLY USING PROPER EQUIPMENT AND WATER TO AID VEGETATION GROWTH.
3. EROSION CONTROL NETTING SHALL BE INSTALLED OVER FILL SLOPES WHICH HAVE BEEN BROUGHT TO FINAL GRADE AND HAVE BEEN SEEDING TO PROTECT AGAINST EROSION. MULCH (STRAW OR FIBER) SHALL BE USED ON RELATIVELY FLAT SLOPES.

"RECORD DRAWING"

THIS DRAWING HAS BEEN REVISED TO SHOW THOSE CHANGES DURING THE CONSTRUCTION PROCESS REPORTED BY THE CONTRACTOR TO KIMLEY-HORN AND ASSOCIATES, INC. AND CONSIDERED TO BE SIGNIFICANT. THIS DRAWING IS NOT GUARANTEED TO BE "AS-BUILT" BUT IS BASED ON THE INFORMATION MADE AVAILABLE.

DATE: 11-17-05 BY: *[Signature]*

App. _____
Revisions _____
No. _____ Date _____

Kimley-Horn and Associates, Inc.
Tel. No. (972) 770-3300
Fax No. (972) 239-3820
12700 Park Central Drive, Suite 1800
Dallas, Texas 75251

BRIAN J. PARKER
90248
REGISTERED PROFESSIONAL ENGINEER

PROTOTYPE 9.3
OTB RELOCATION
OTB ADDISON
BELTLINE ROAD
ADDISON, TEXAS

ON THE BORDER
MEXICAN ORIGIN & COUNTRY

EROSION CONTROL DETAILS AND NOTES (S.W.P.P.P.)

Scale: AS SHOWN
Designed by: SCG
Drawn by: ABC
Checked by: BCP
Date: MAY 2005
Project No. 063984003

SHEET C-9 OF 12