

LOT 1  
BELT LINE - QUORUM ADDITIO  
VOL. 91077, PG. 4068

TABULATIONS	BUILDING AREA	PARKING REQUIRED
BUILDING	7,376 S.F.	(1:70 S.F.) 140
PATIO	1,457 S.F.	
SERVICE YARD	954 S.F.	
<b>TOTAL SEATS</b>	<b>INDOORS - 316</b>	
	<b>PATIO - 104</b>	
<b>TOTAL</b>	<b>9,787 S.F.</b>	<b>(140)</b>
PARKING PROVIDED		136
HANDICAP PARKING PROVIDED		6
<b>TOTAL</b>		<b>142</b>
EXISTING ZONING	LR (Local Retail)	
PROPOSED ZONING	LR (Local Retail)	
SITE AREA	2.156 AC.	
TOTAL SITE AREA	±2.156 AC.	

**AS-BUILT**

NOTE:  
THESE PLANS HAVE BEEN REVISED  
TO CONFORM WITH CONSTRUCTION  
RECORDS PROVIDED BY CONTRACTOR.


BENCHMARK:  
TOP OF BRASS DISK FOUND ON SOUTHWEST  
CORNER OF 8" RECESSED CURB INLET ON EAST  
SIDE OF ADDISON ROAD, 275'± NORTH OF BELT  
LINE ROAD.  
ELEV.=631.82'

**SCHEMATIC SITE PLAN**  
**BJ'S RESTAURANT**  
**LOT 2, BLOCK A OF**  
**BELTWAY CENTRE ADDITION**  
**TOWN OF ADDISON**  
**DALLAS COUNTY, TEXAS**

**BROCKETTE • DAVIS • DRAKE, INC.**  
**DD consulting engineers**  
 Civil & Structural Engineering • Surveying  
 4144 North Central Expressway, Suite 1100 • Dallas, Texas 75204  
 (214) 824-3647 • fax (214) 824-7064

DESIGN	DRAWN	DATE	SCALE	NOTES	FILE	NO.
JAR	BLM	11/19/02	1"=30'	BDD	C02132	<b>C4</b>

STATE OF TEXAS  
 JAMES A. RILEY  
 73231  
 09.01.03

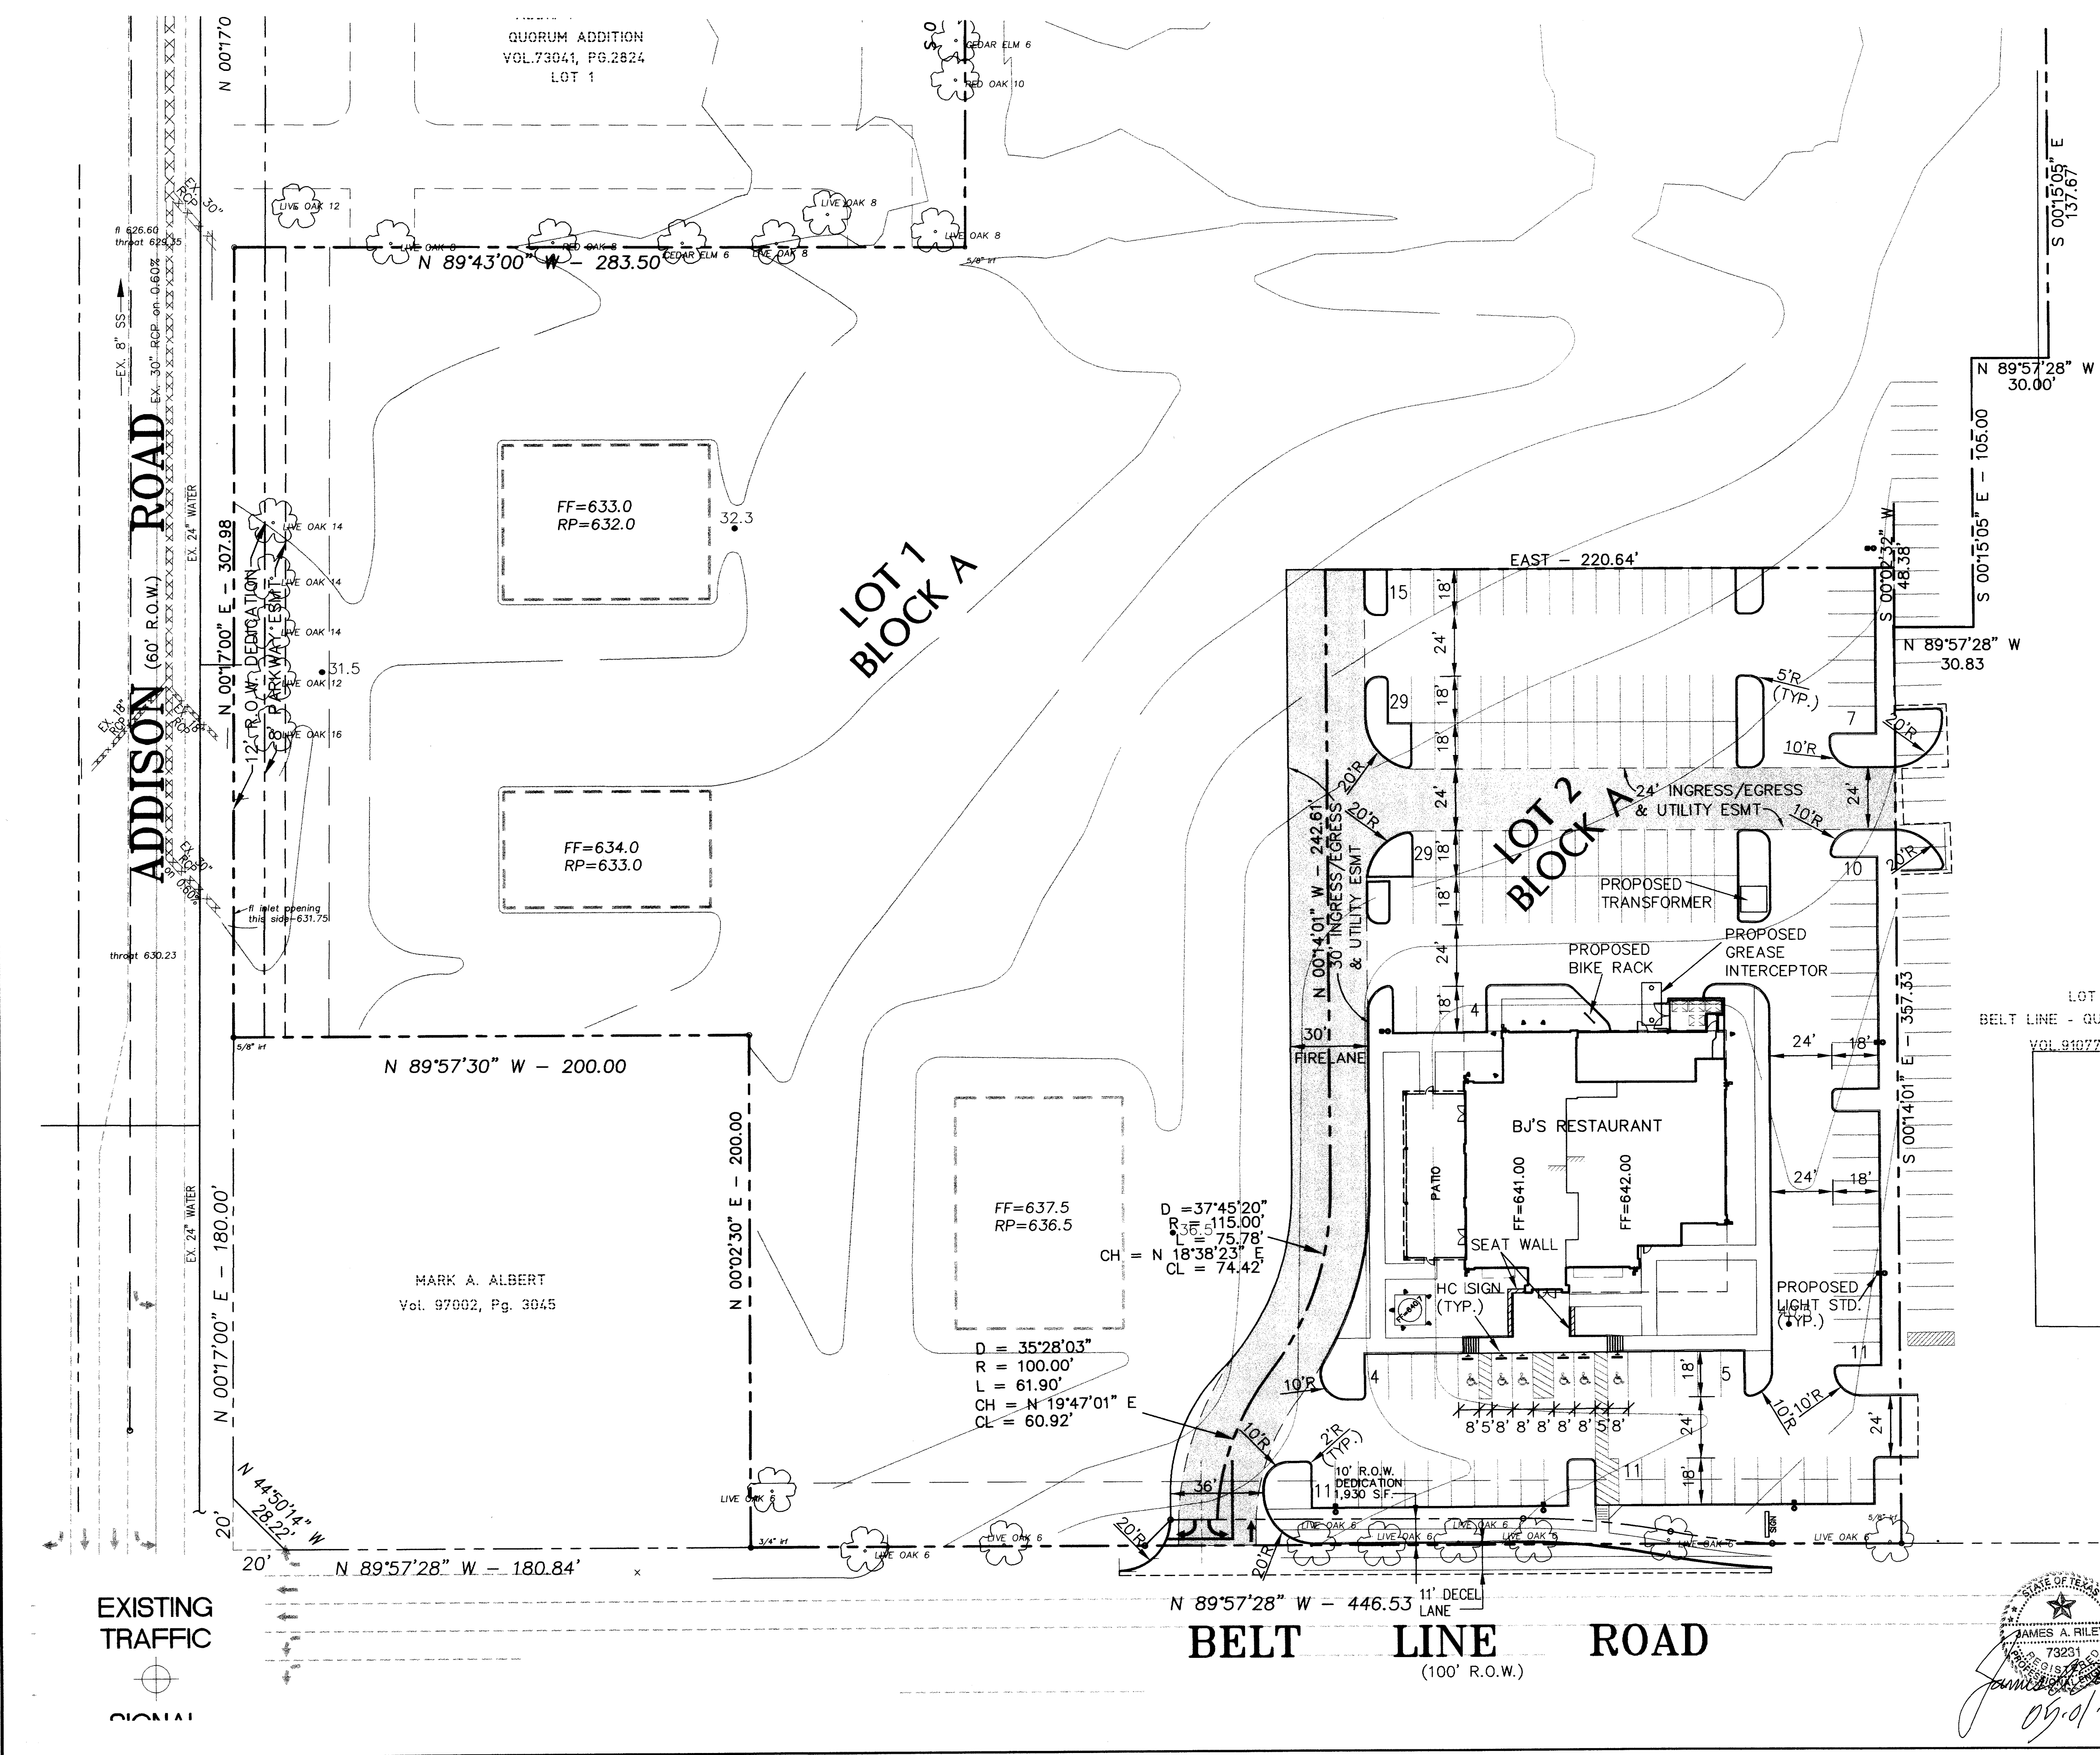

**ADDISON ROAD**  
(60' R.O.W.)

**BELT LINE ROAD**  
(100' R.O.W.)

EXISTING TRAFFIC  
 SIGNAL

QUORUM ADDITION  
VOL. 73041, PG. 2824  
LOT 1

N 89°57'28" W  
30.00'

S 00°15'05" E - 105.00  
S 00°15'05" E - 137.67

LOT 3  
BELT LINE - QUORUM ADDITION  
VOL. 91077, PG. 4068

N 00°17'00" E - 307.98  
N 00°17'00" E - 180.00'  
N 00°17'00" E - 200.00'  
N 00°17'00" E - 200.00'

N 89°57'30" W - 200.00

N 44°50'14" W  
28.22'

N 89°57'28" W - 180.84'

MARK A. ALBERT  
Vol. 97002, Pg. 3045

FF=633.0  
RP=632.0

FF=634.0  
RP=633.0

**LOT 1  
BLOCK A**

**LOT 2  
BLOCK A**

BJ'S RESTAURANT

D = 37°45'20"  
R = 115.00'  
L = 75.78'  
CH = N 18°38'23" E  
CL = 74.42'

D = 35°28'03"  
R = 100.00'  
L = 61.90'  
CH = N 19°47'01" E  
CL = 60.92'

10' R.O.W. DEDICATION  
11,930 S.F.

N 89°57'28" W - 446.53

11' DECEL LANE

(100' R.O.W.)

EAST - 220.64'

N 00°14'01" W - 242.61'  
30' INGRESS/EGRESS & UTILITY ESMT

N 89°57'28" W  
30.83

S 00°14'01" E - 357.33

FIRE LANE

10'R

20'R

10'R

10'R

