


© Copyright 2002 Brockette/Davis/Drake, Inc. All Rights Reserved.  
 No part of this drawing may be reproduced, stored in a retrieval system, or used in any form or by any means, without the express written authorization of Brockette/Davis/Drake, Inc. is prohibited.

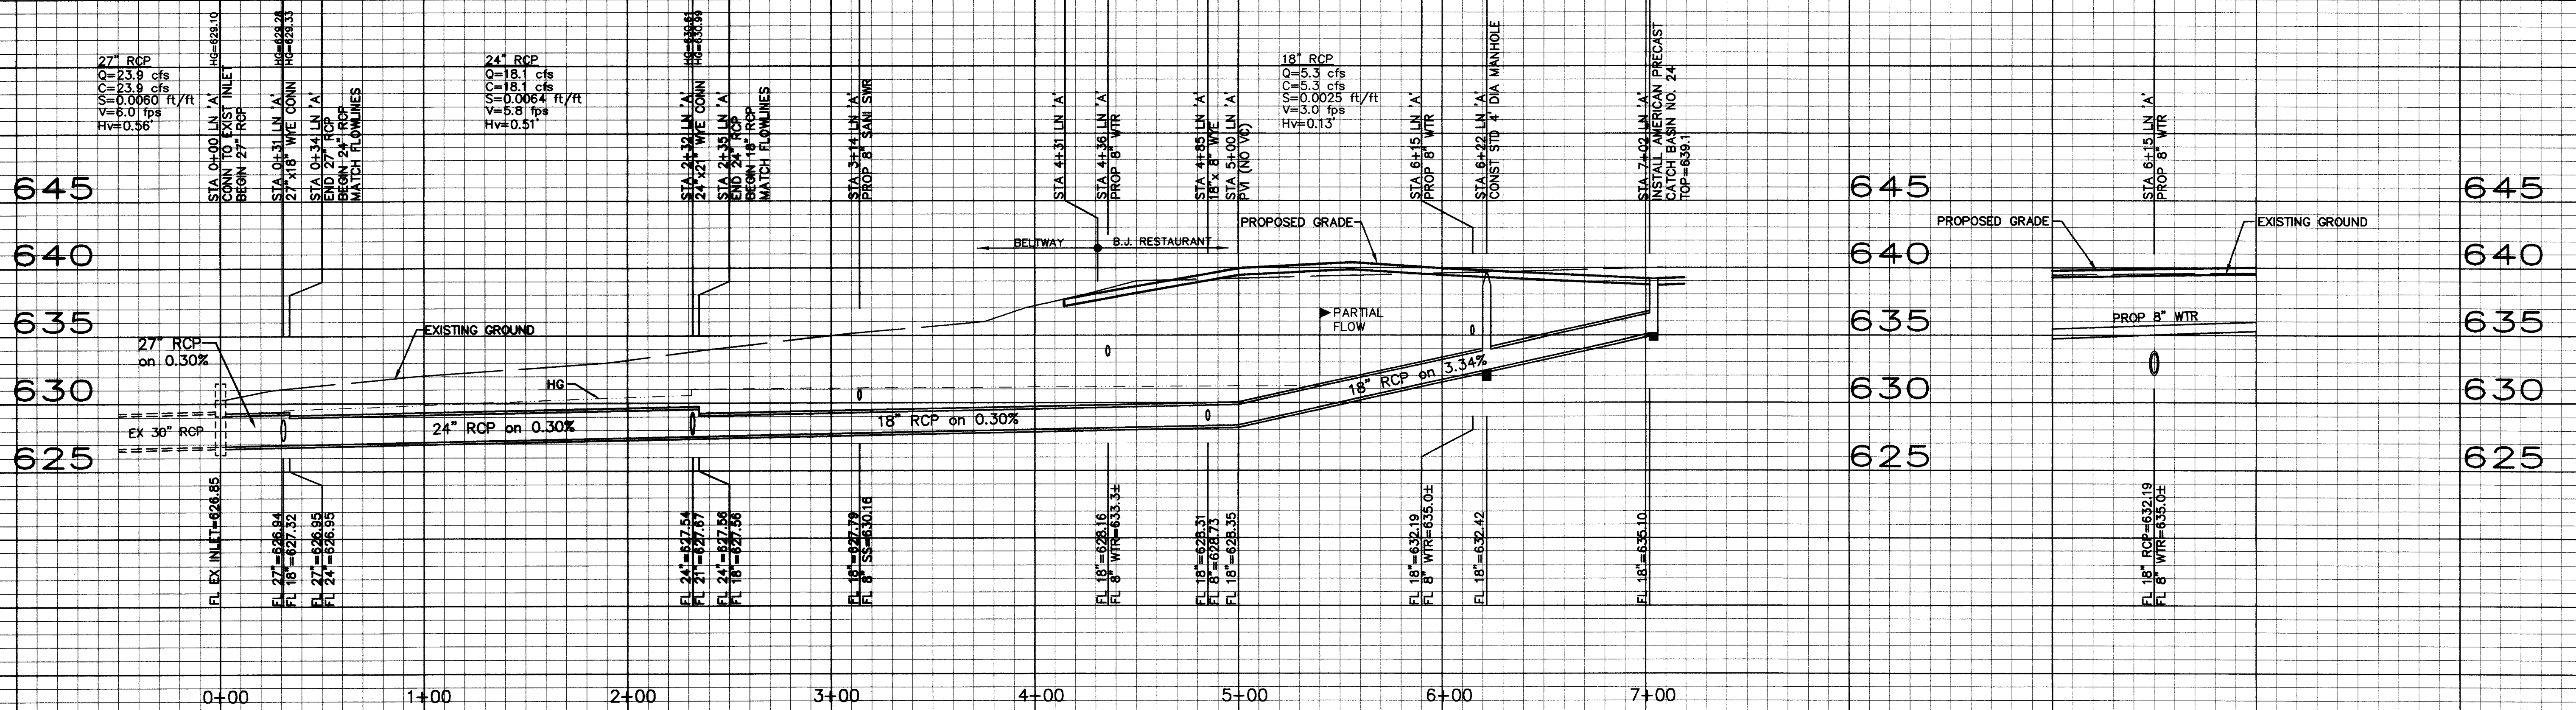

LINE 'A'

PROP 8" WTR X-ING

AS-BUILT

NOTE:  
 THESE PLANS HAVE BEEN REVISED  
 TO CONFORM WITH CONSTRUCTION  
 RECORDS PROVIDED BY CONTRACTOR.

BENCHMARK:  
 TOP OF BRASS DISK FOUND ON SOUTHWEST  
 CORNER OF 8" RECESSED CURB INLET ON EAST  
 SIDE OF ADDISON ROAD, 275± NORTH OF BELT  
 LINE ROAD.  
 ELEV.=631.82'

**STORM SEWER PROFILES**  
 BJ'S RESTAURANT  
 LOT 2, BLOCK A OF  
 BELTWAY CENTRE ADDITION  
 TOWN OF ADDISON  
 DALLAS COUNTY, TEXAS

**BROCKETTE • DAVIS • DRAKE, INC.**  
 consulting engineers  
 Civil & Structural Engineering • Surveying  
 4144 North Central Expressway, Suite 1100 • Dallas, Texas 75204  
 ( 214 ) 824-3647 • fax ( 214 ) 824-7064

STATE OF TEXAS  
 REGISTERED PROFESSIONAL ENGINEER  
 JAMES A. RILEY  
 73231  
 09/01/03

DESIGN	DRAWN	DATE	SCALE	NOTES	FILE	NO.
JAR	BLM	11/19/02	1"=40' H 1"=6" V	BDD	C02132	C9

STMPROF-BJADWG