

GENERAL NOTES

- All construction shall be in accordance with these plans and Town of Addison's ordinances and specifications.
- All materials and workmanship shall conform to "Standard Specifications for Public Works", published by the North Texas Council of Governments, except as modified by the Town of Addison.
- The location of all utilities located on these plans are taken from existing public records. The exact location and elevation of all public utilities shall be determined by the Contractor prior to construction. Contractor shall have a trench safety plan prepared for all excavation in excess of 5 feet deep. It shall be the duty of Contractor to ascertain whether any additional facilities other than those shown on the plans may be present.
- Contractor shall secure all necessary permits and contracts prior to commencing construction.
- It shall be the responsibility of the Contractor to protect all public utilities and other property in the construction of this project. Property damaged during this construction shall be repaired or replaced at the contractor's expense to the satisfaction of the owner.
- Concrete blocking shall be provided on water mains at all bends and fire hydrant per City Standards.
- Pavement affected by construction shall be replaced to match existing. Graded areas affected shall be re-sodded with like materials.
- All public water mains shall be PVC-C909 water pipe.
- The water line shall be constructed with a minimum of 48" of cover.
- All fire hydrants shall be Mueller Centurion, or approved equal. Set nozzle of fire hydrant at a height between 18" and 24" from finished ground elevation.
- The Certificate of Acceptance (COA) will not be issued until all water apertures have been adjusted to their final position.
- All water services shall have Town of Addison approved testable backflow prevention devices. These existing devices must be tested, and certified to be working prior to issuance of a certificate of occupancy.
- Upon installation of meters, the owner or agent shall go to 5350 Belt Line Road to pay the proper deposit and initiate service.
- All water apertures removed from the site shall be delivered to the Town of Addison Service, 16801 Westgrove Drive, Addison, TX. 75001-9010
- Refer to Mechanical Plan for exact location of building service points.


LEGEND

- Existing Pavement To Be Removed.
- Sawcut

REMOVE & REPLACE EXIST. FIRE DETECTOR CHECK W/DOUBLE CHECK DETECTOR ASSEMBLY


REPLACE EXISTING VAULT DOOR

NOTE: ALL METERS AND REGISTERS TO BE UPGRADED TO CURRENT SPECS. REQUIRING ELECTRONIC ENCODER W/TOUCH PADS

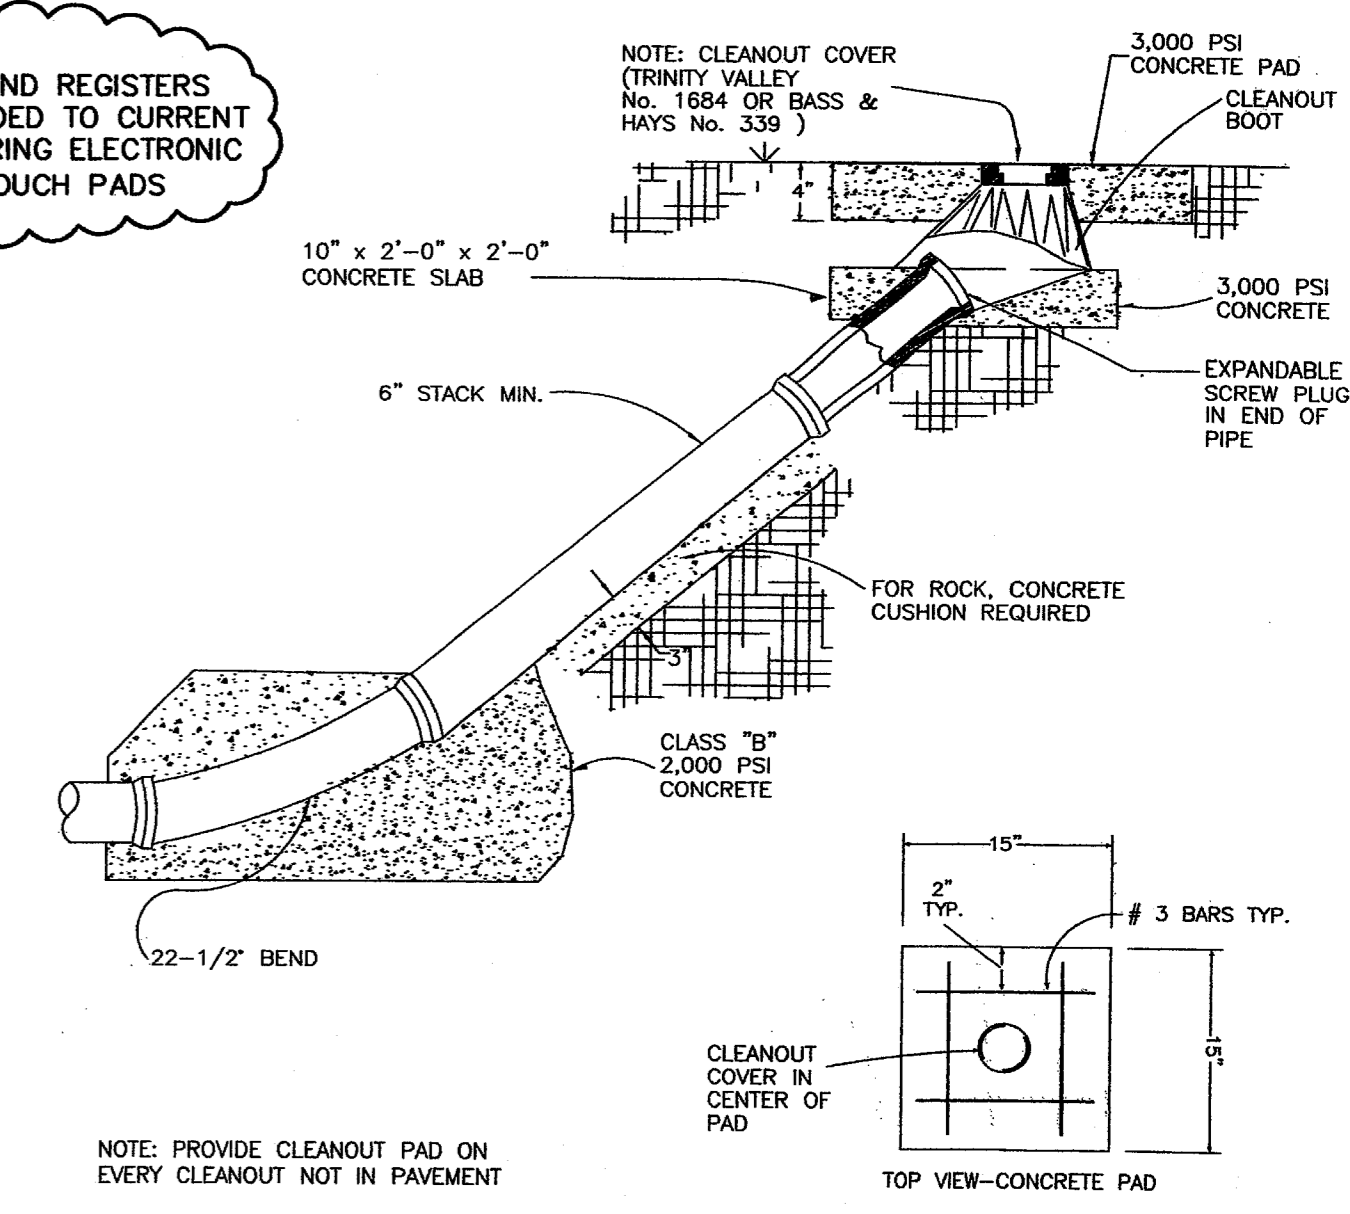

SANITARY SEWER CLEANOUT
N.T.S.

NOTE:
If one lane of Belt Line Road needs to be closed to install new watch services, this work shall be completed at night.

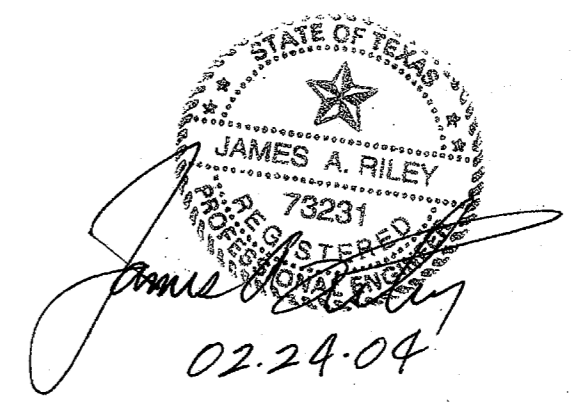

ELIMINATE PROP. WATER SERVICES

WATER/SANITARY SEWER PLAN
CONTAINER STORE
TOWN OF ADDISON, TEXAS

BROCKETTE • DAVIS • DRAKE, INC.
consulting engineers
Civil & Structural Engineering • Surveying
4144 North Central Expressway, Suite 1100 • Dallas, Texas 75204
(214) 824-3647 • fax (214) 824-7064

DESIGN	DRAWN	DATE	SCALE	NOTES	FILE	NO.
JAR	DJR	02/24/04	1"=40'	BDD	C03244	C7

© Copyright, 2002 Brockett/Davis/Drake, Inc. All Rights Reserved.
This drawing is the property of Brockett/Davis/Drake, Inc. and is not to be reproduced, stored in a retrieval system, or transmitted in any form or by any means, without the written authorization of Brockett/Davis/Drake, Inc. is prohibited.