

B4-5

REVISIONS	BY

Jacobs & Associates
 Architecture, Planning, Interiors
 13740 Midway Rd., Suite 528
 Dallas, Texas 75244
 214 490-1888

Office DEPOT
 ADDISON, TEXAS


15280 Addison Road Suite 300 Dallas, Texas 75248 (214) 861-2825

Construction Management Technology, Inc.

DRAWN
CHECKED
DATE 2-7-91
SCALE
JOB NO.
SHEET
COVER B4-5 SHEETS

Office DEPOT

ADDISON, TEXAS

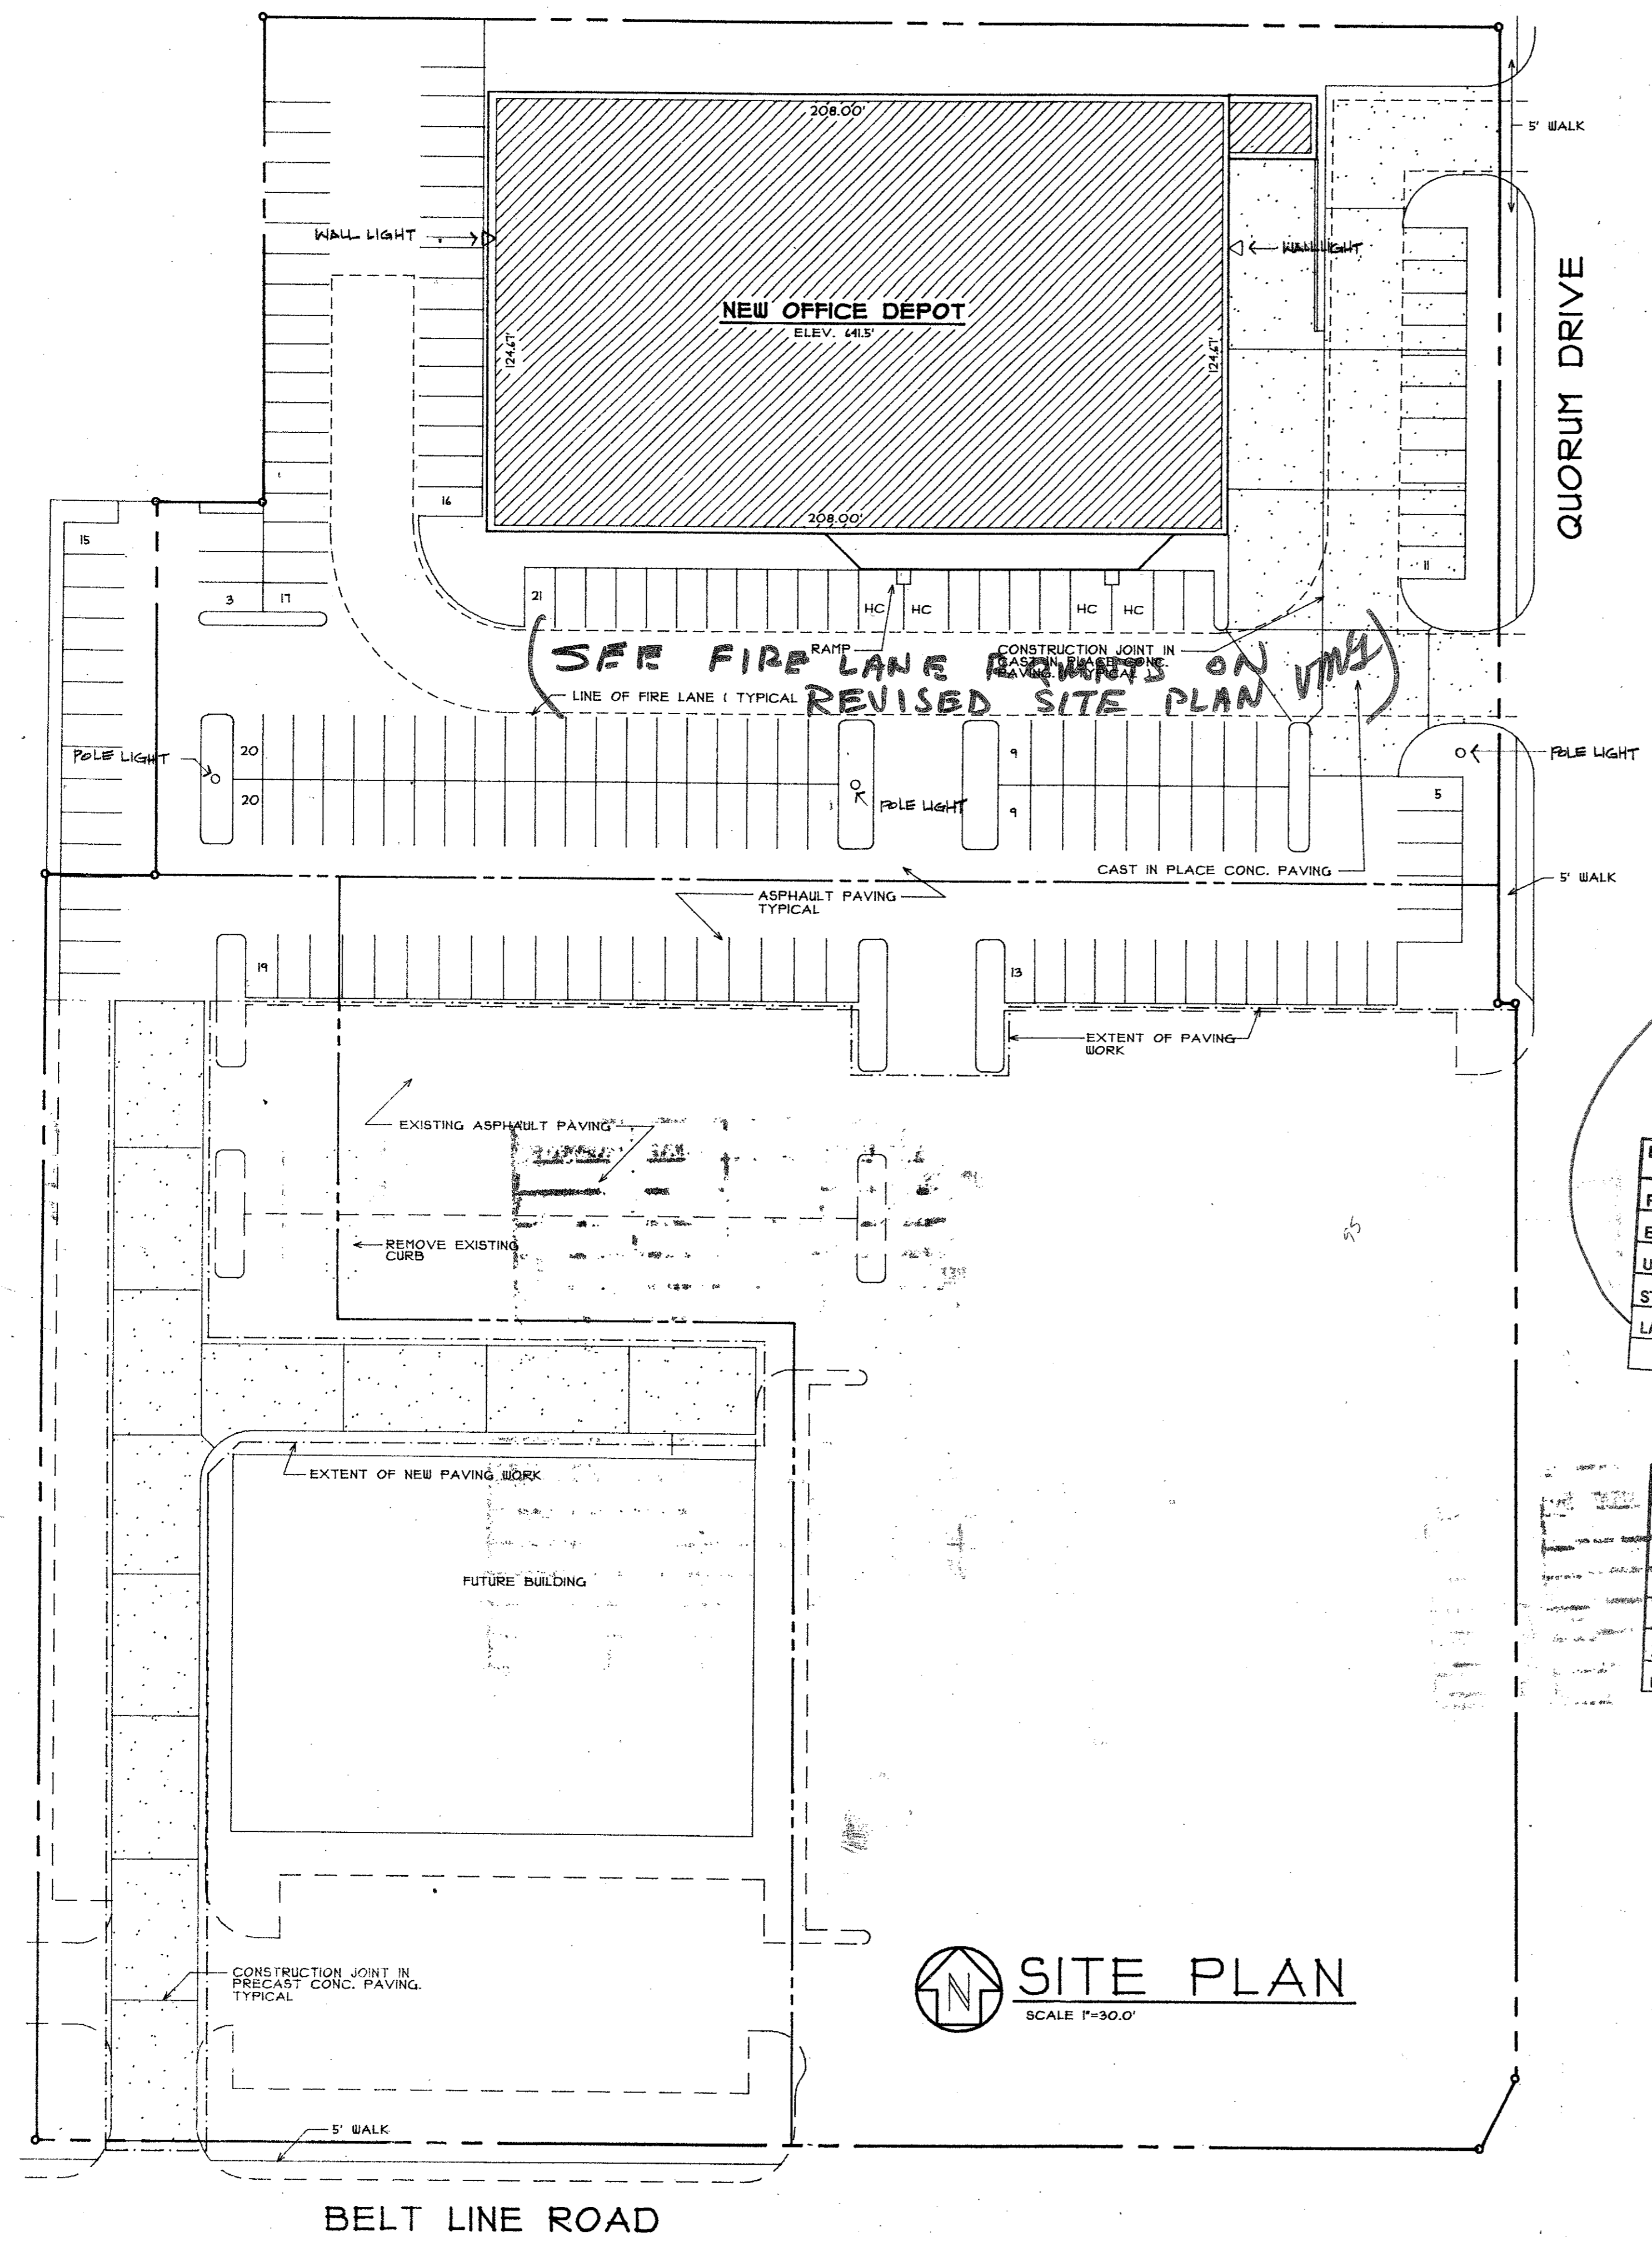

QUORUM DRIVE

BELT LINE ROAD

SITE PLAN
 SCALE 1"=30.0'

*LANDSCAPE
 SEE ATTACHED
 CORRECTED PLAN 2-22-91
 SEE NOTES ON
 REVISED
 ATTACHED LANDSCAPE PLAN.*

DRAWING LEGEND

- C-1 GRADING AND DRAINAGE PLAN
- C-2 WATER AND SANITARY SEWER PLAN
- C-3 DIMENSION CONTROL PLAN
- LS-1 LANDSCAPE PLAN
- A-1 FIRST FLOOR PLAN
- A-2 FIRST FLOOR REFLECTED CEILING PLAN
- A-3 SECOND FLOOR PLAN AND RCP
 SECOND FLOOR FRAMING PLAN AND DETAILS
- A-4 EXTERIOR ELEVATIONS
- A-5 ROOM FINISH AND DOOR SCHEDULE
 LARGE SCALE SECTIONS AND DETAILS
- A-6 LARGE SCALE WALL SECTIONS
- S-1 FOUNDATION PLAN
- S-2 ROOF FRAMING PLAN
- S-3 FOUNDATION DETAILS
- S-4 PRE-CAST PANEL DETAILS AND GEN NOTES
- S-5 STEEL DETAILS
- M-1 FIRST FLOOR HVAC PLAN
- M-2 SECOND FLOOR HVAC PLAN
 HVAC SCHEDULES, DETAILS
- P-1 PLUMBING FLOOR PLAN
- P-2 PLUMBING SCHEDULES AND DETAILS
- E-1 FIRST FLOOR LIGHTING PLAN
- E-2 FIRST FLOOR POWER PLAN
- E-3 SECOND FLOOR ELECTRICAL PLAN
 ELECTRICAL SCHEDULES
- E-4 ELECTRICAL DETAILS

DEPARTMENTAL REVIEW	HOLD	APPROVED	REVIEWED BY
FIRE	✓	2-22-91	JMM
ENGINEERING	✓	(8/6/91)	JRB 2-18-91
UTILITIES	✓	(8/6/91)	REN'S
STREETS	✓	(8/6/91)	see attached
LANDSCAPE	✓	2-22-91	B. STRICKLAND 1-30-28/91

INSPECTION REVIEW	HOLD	APPROVED	REVIEWED BY
BUILDING		2-11-91	RC
PLUMBING		2-19-91	RC
ELECTRICAL		2-11-91	RC
MECHANICAL		2-18-91	RC
ZONING			
HEALTH			

BRUCE:
 IS PRO RATA DUE?
 WATER TAP FEE _____
 SEWER TAP FEE _____