
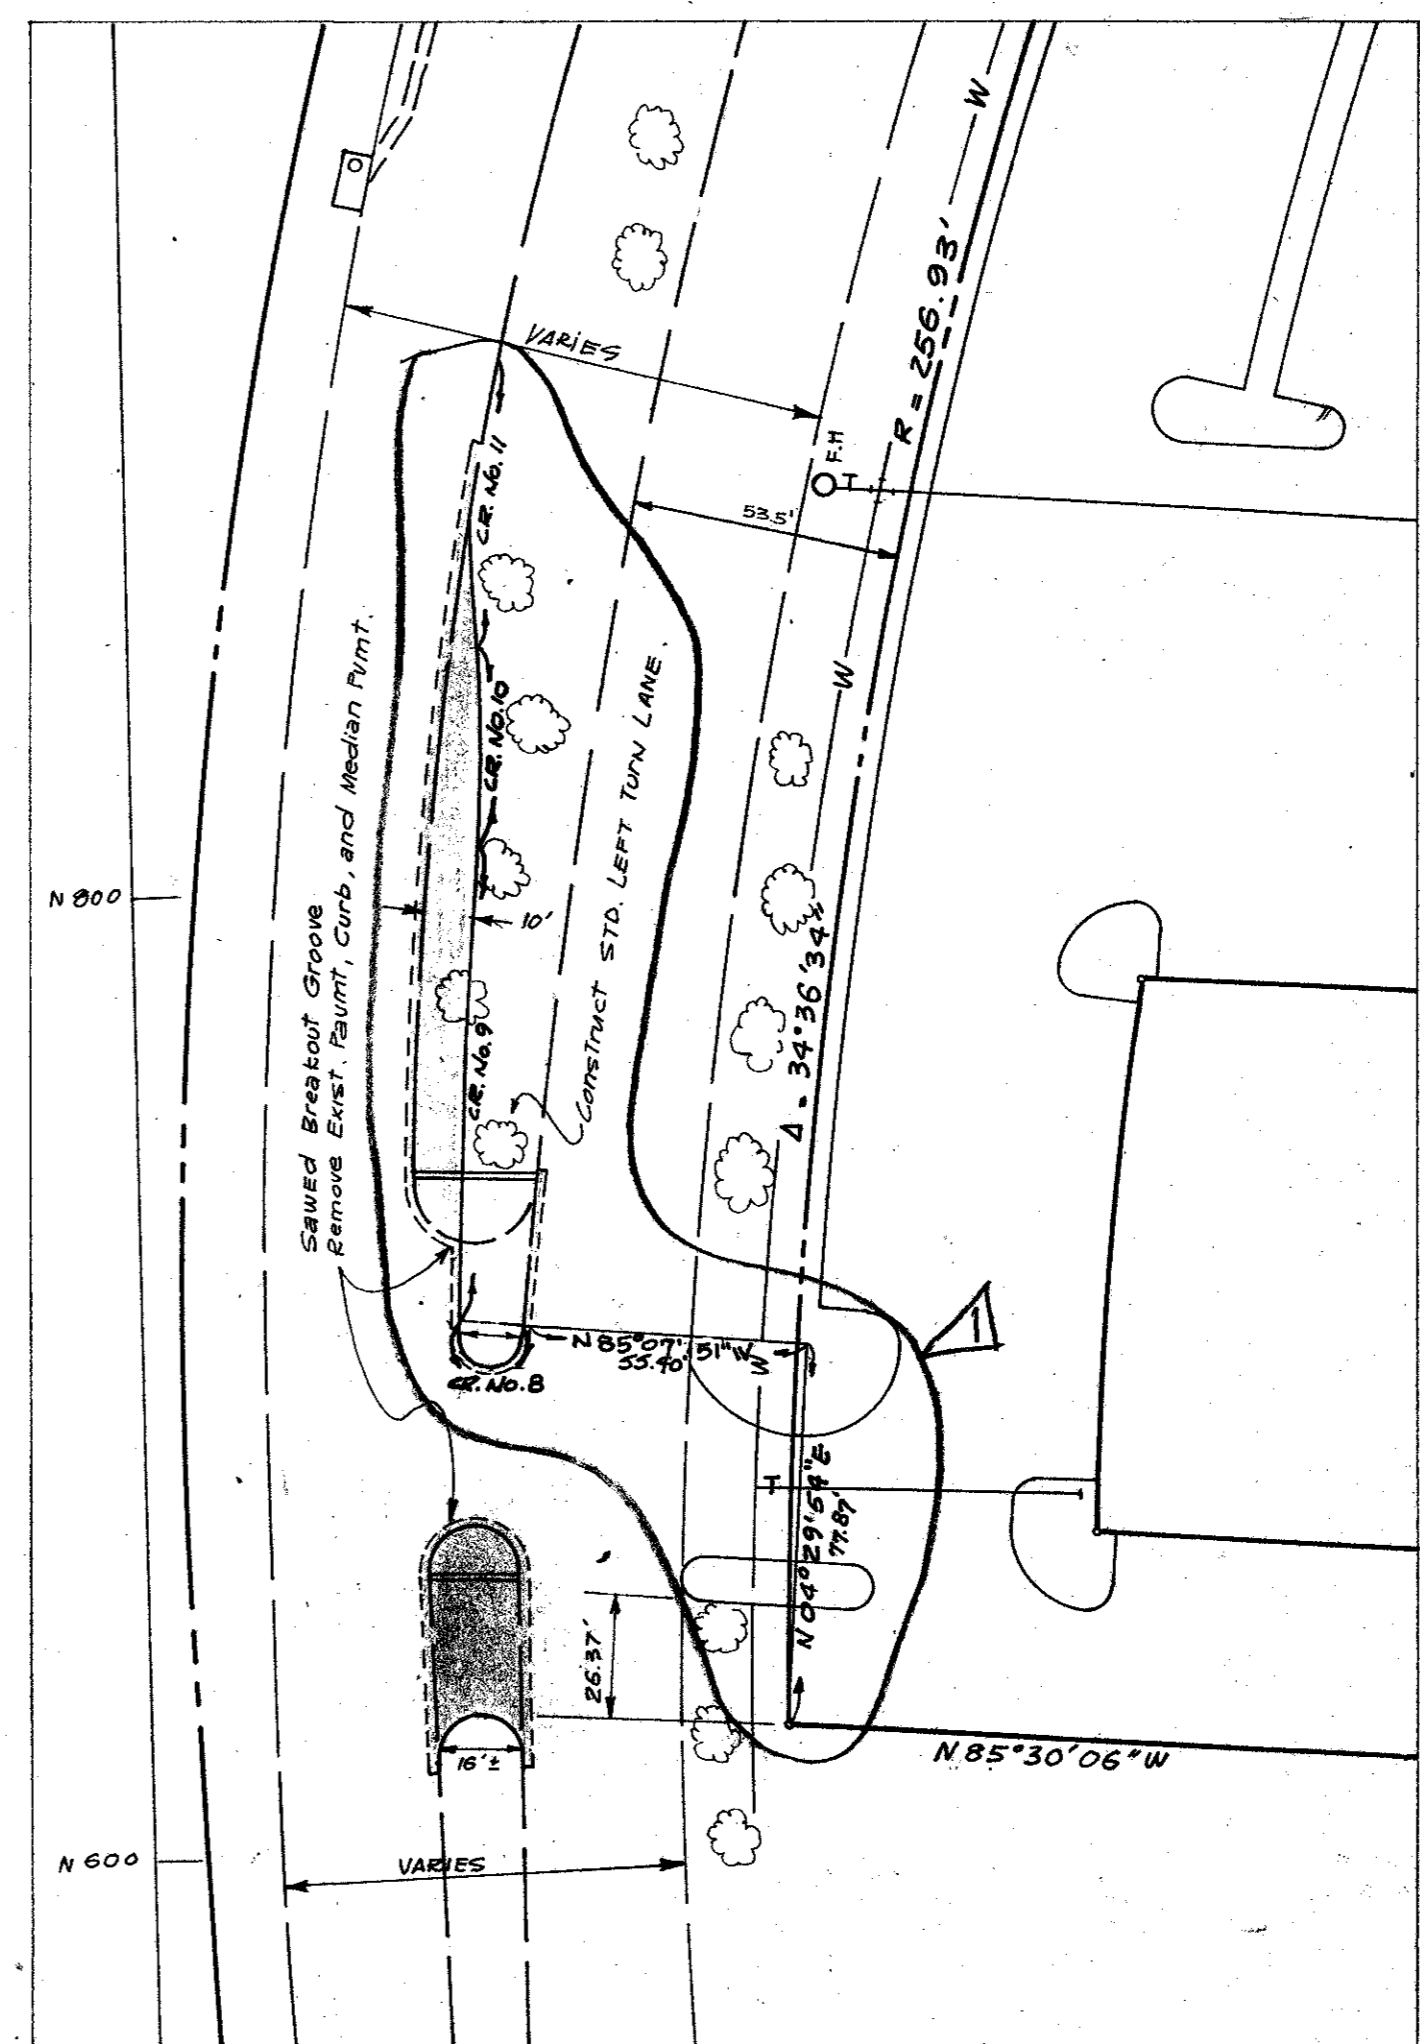



Curve	B	A	T	L
1	90°00'00"	20.0'	20.0'	31.82'
2	90°00'00"	16.0'	16.0'	25.13'
3	86°55'20"	16.0'	10.51'	18.40'
4	90°00'00"	5.0'	5.0'	7.85'
5	156°53'20"	3.0'	14.74'	8.22'
6	203°01'00"	6.0'	24.56'	17.72'
7	113°24'00"	16.0'	24.36'	31.67'
8	179°11'43"	5.7'	135.86'	11.43'
9	06°01'19"	951.43'	50.05'	100.0'
10	09°10'02"	280.0'	20.04'	40.0'
11	15°05'10"	226.0'	29.93'	58.51'
12	108°55'25"	16.0'	22.40'	30.42'
13	90°00'00"	7.0'	7.0'	11.00'
14	28°14'35"	7.0'	1.75'	3.43'
15	151°55'25"	10.0'	63.99'	42.43'
16	180°00'00"	3.0'	-	9.42'
17	180°00'00"	6.5'	-	15.71'
18	180°00'00"	6.0'	-	15.71'
19	71°04'36"	12.0'	11.83'	19.85'
20	108°55'25"	12.00'	16.91'	22.96'
21	108°55'25"	6.0'	7.0'	9.51'
22	89°18'49"	5.0'	4.94'	7.79'
23	46°18'49"	44.0'	18.88'	35.57'
24	108°55'25"	20.0'	Match	Ext. Int.
25	71°04'36"	20.0'	"	"
26	132°00'00"	20.0'	"	"
27	208°14'35"	6.0'	-	18.16'
28	28°14'35"	37.49'	9.37'	18.57'
29	180°00'00"	2.5'	-	7.85'

* Note: Curve numbers refer to curve data for curves on this sheet only. Do not use curve data shown in this table for sheets 14 or 15

MATCH LINE SHEET 15

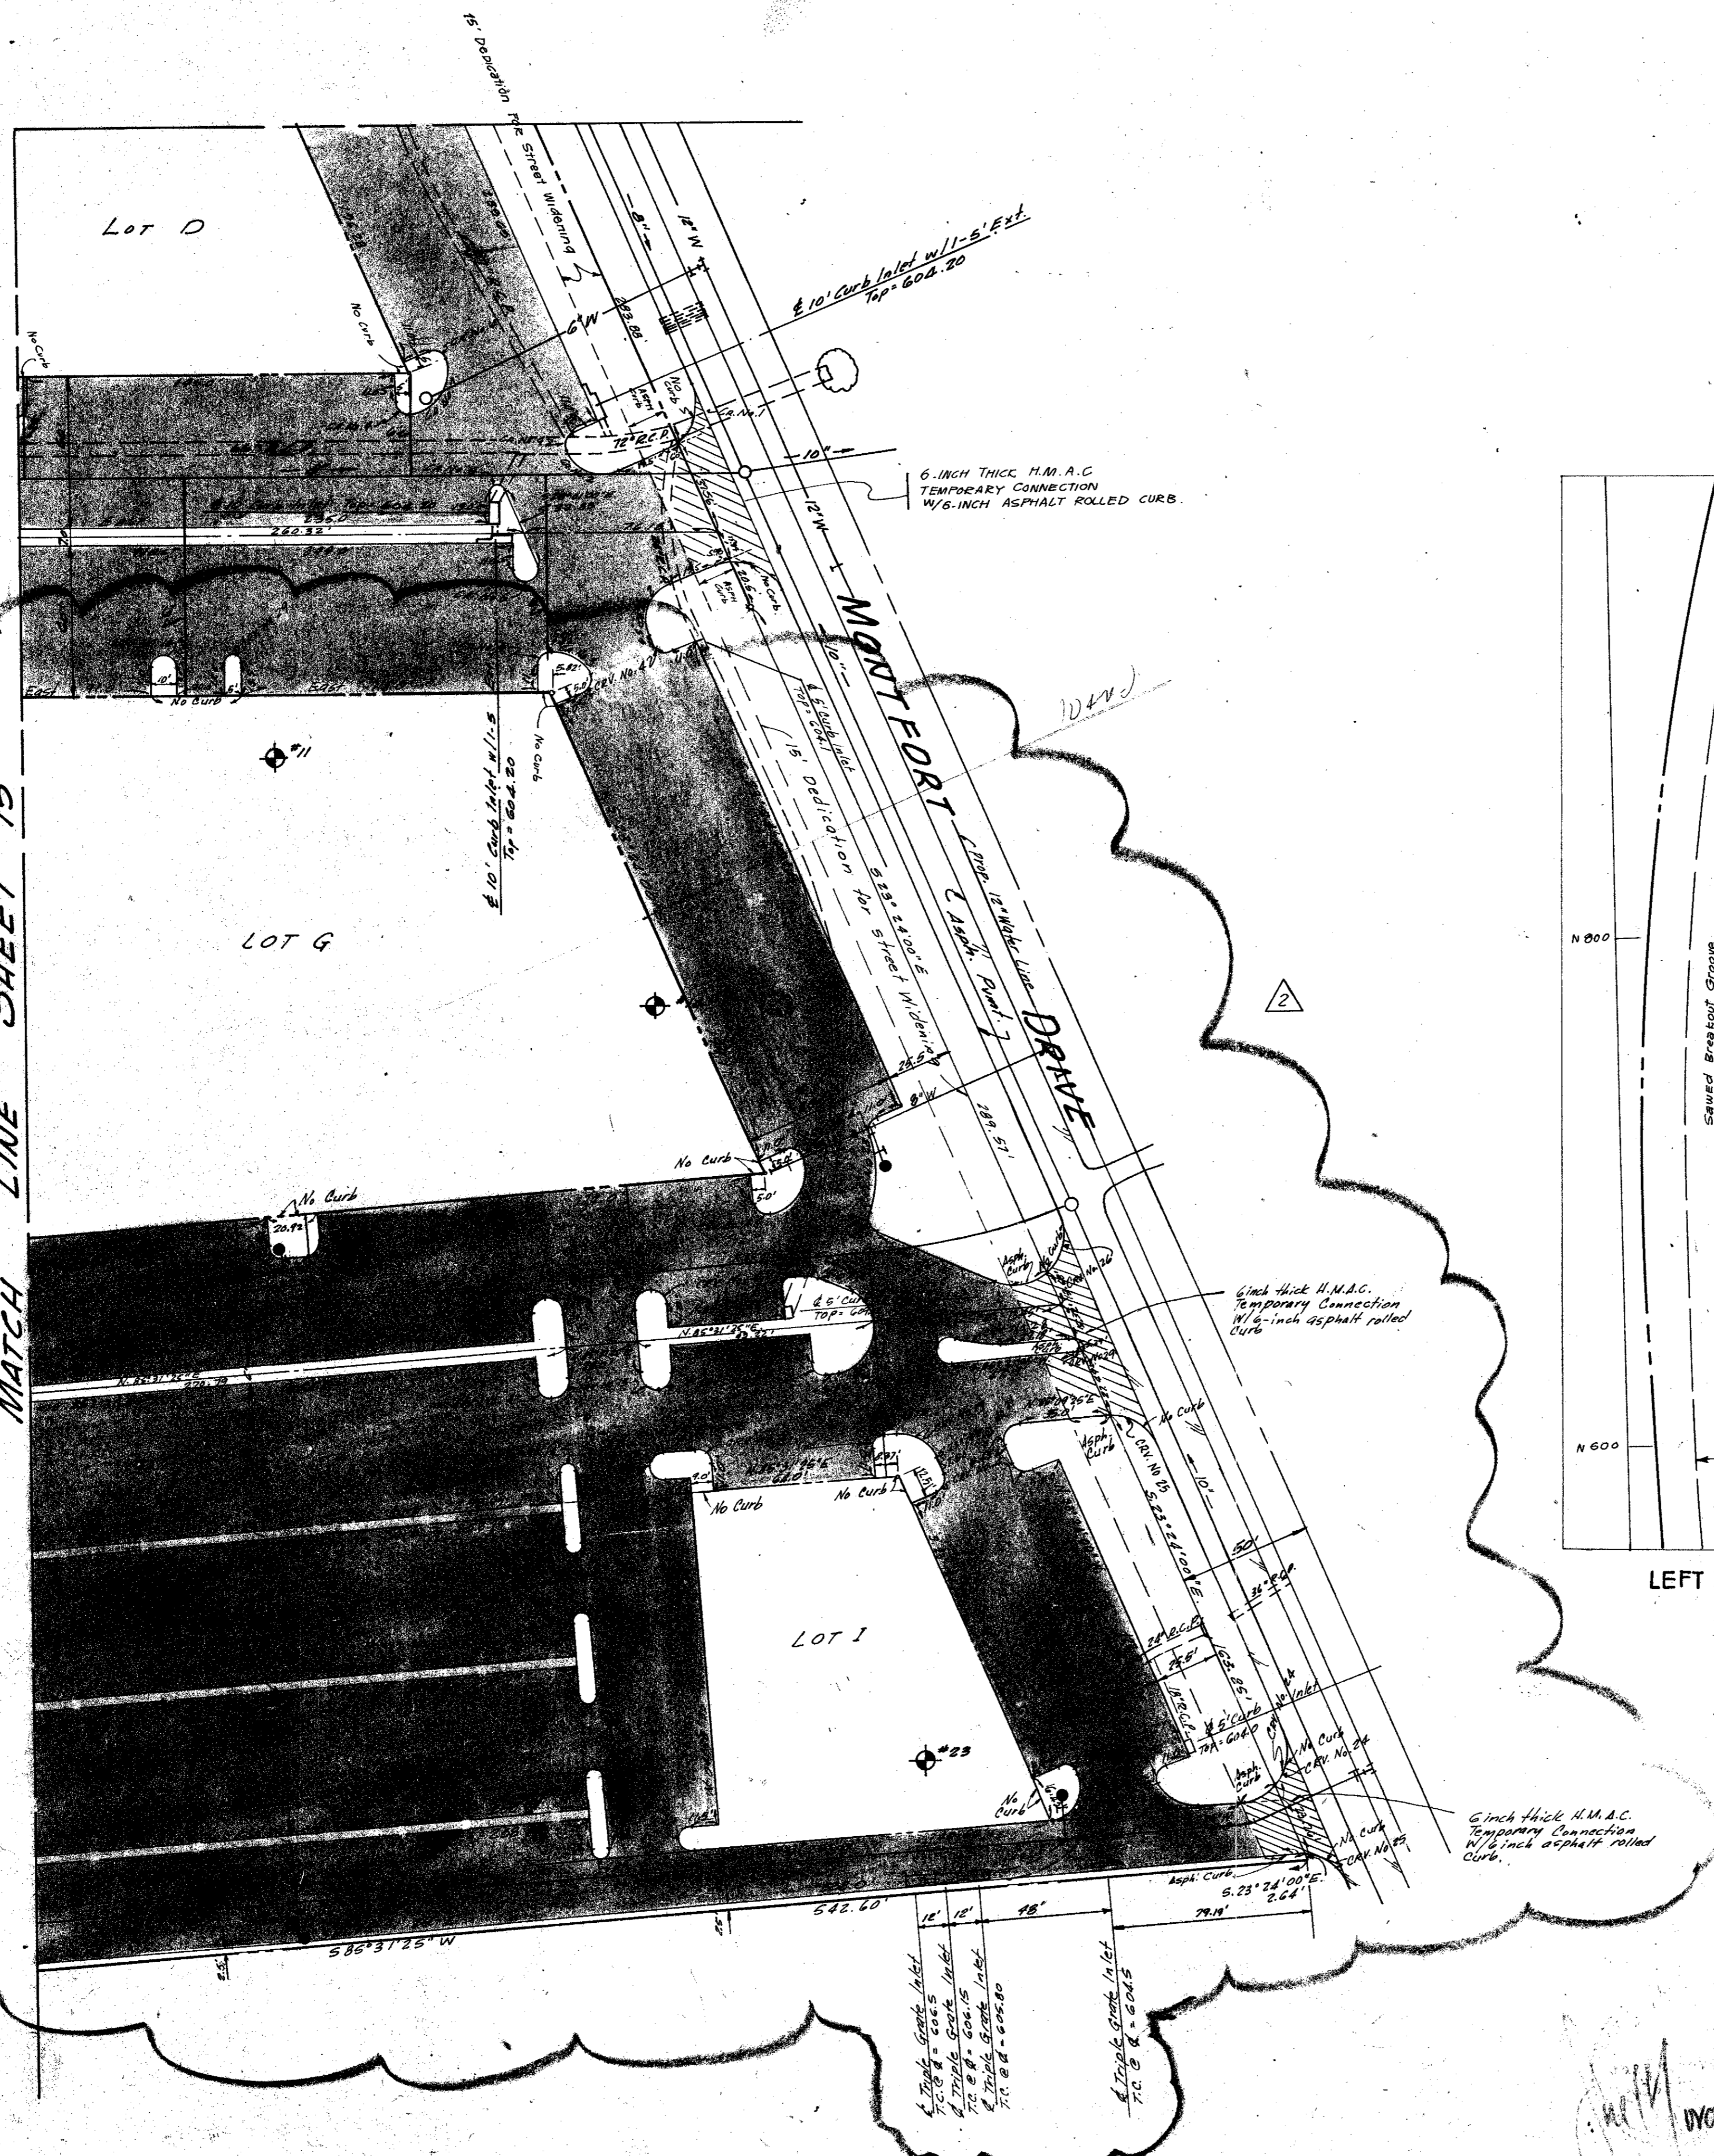

LEFT TURN LANE DETAILS @ SOUTHWEST ENTRANCE

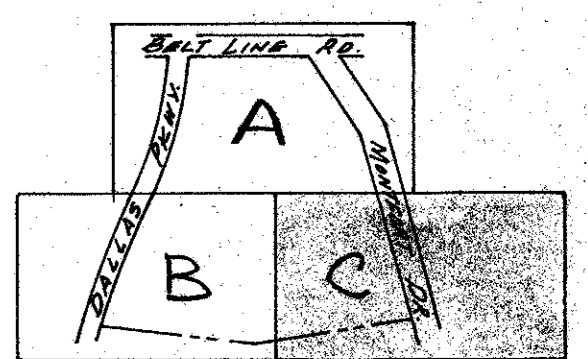

KEY MAP

- HOT MIX ASPHALTIC CONCRETE - 6" THICK
- STANDARD REINFORCED CONCRETE PAVEMENT W/ INTEGRAL CURB

NOTE:
ALL DIMENSIONS ARE TO BACK OF CURB
⊕ Indicates Soil Boring

3/28/79 Added Horizontal Layout & Paving Plan for Second Installation.
7/26/78 Added TURN LANE CURSE DATA

16

Bench Mark: Standard water dept. bench mark center inlet northwest corner Bellline Road and Dallas Pkwy. ELEV: 632.00

Note: All curbs shall be standard 6-inch concrete integral curb unless otherwise noted.

HORIZONTAL LAYOUT & PAVING PLAN						
VILLAGE ON THE PARKWAY						
VILLAGE PARKWAY VENTURE						
Albert H. Holt Associates, Inc. - Engineers						
CITY OF ADDISON, TEXAS						
DESIGN	DRAWN	DATE	SCALE	NOTES	FILE	No.
A. H. H. ASSOC.	A. H. H.	JUNE 78	1"=20'	6143		