



Village Parkway Venture July 28, 1978
 10' Water Main easement located on the East 10' of Dallas Pkwy and 120' South of the Village Pkwy
 Csm's Dimensions 80.8' x 102.9' x 44' x 102.9' Block 8170
 Temp. No. King Space Granted C.O. 733444 5-16-78 Vol. 78176 Pg. 0780

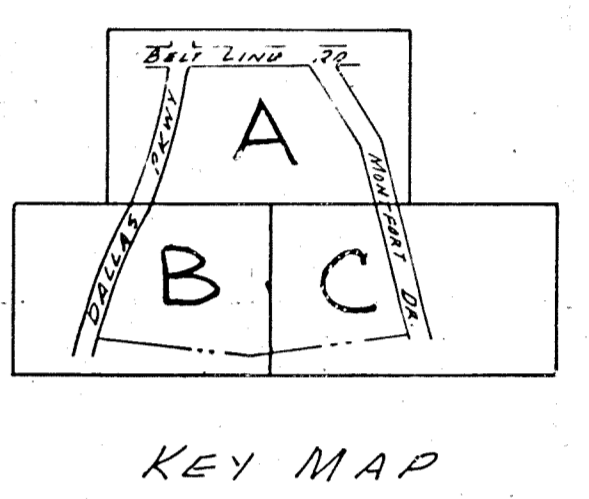

LOT CORNER COORDINATES

#	Y	X
31	599.786	2448.241
32	716.143	2448.263
33	663.998	1632.055
34	779.394	1644.281
35	873.683	2072.684
36	1074.196	2072.684
37	1074.196	2199.684
38	863.092	2199.684
39	843.534	2448.286
40	845.835	2477.684
41	1074.196	2477.684
42	1074.196	1803.553
43	899.359	1738.696
51	1201.196	2399.684
53	1201.196	2272.684
57	1201.196	1873.316
70	740.099	2143.765
71	624.456	2134.167
72	621.240	2175.641
73	736.883	2184.639
77	724.789	2558.102
78	609.142	2567.755

REFER TO SHEET 36 FOR GENERAL NOTES
 REFER TO SHEET 31 FOR SANITARY SEWER PROFILE

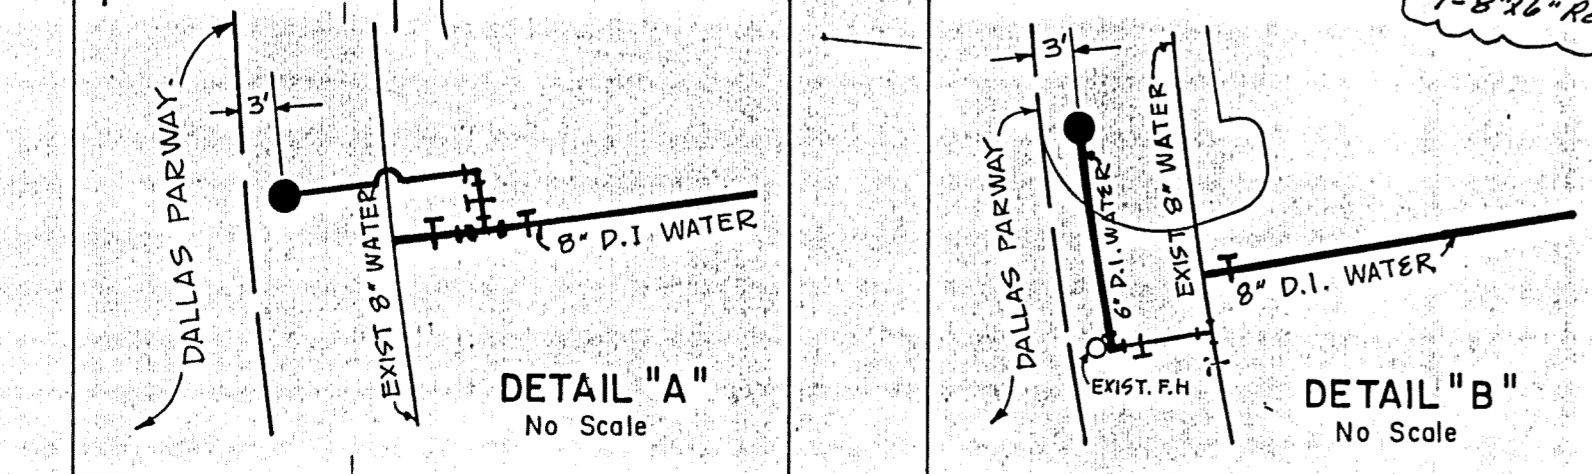

VERDE VALLEY PARKWAY PLACE ADDITION No. 1 VOL. 70202 PG. 1934 BLOCK A/B/D0
 BENCHMARK: STANDARD WATER DEPT BENCHMARK CENTER INLET - NORTHWEST CORNER BELT LINE ROAD AND DALLAS PKWY. ELEV.: 692.08

LOCATION: VILLAGE ON THE PARKWAY PHASE 1
 DESIGNED BY: ALBERT H. HALFF ASSOCIATES, INC. - ENGINEERS
 R.O.W. APPROVED BY: T.C. DISTRICT 10-17-78
 CONTRACTING: 10-17-78
 ENGINEER OF DESIGN: DALLAS WATER UTILITIES DEPT.
 CONTRACT NO. 78-261P, 78-262P - Slinson Sept. 25, 1978

WATER & SANITARY SEWER PLANS					
VILLAGE ON THE PARKWAY					
VILLAGE PARKWAY VENTURE					
ALBERT H. HALFF ASSOCIATES, INC. - ENGINEERS					
CITY OF ADDISON, TEXAS - P. ENG. 15E					
DESIGN	DRAWN	DATE	SCALE	NOTES	FILE
A.H.H.	T.P.	MAY 1978	1"=40'	6145	411Q
					19610