

AS-BUILT


CONSTRUCTION PLANS

FOR

WATER AND WASTEWATER SERVICES PRESTONWOOD PLACE TOWN OF ADDISON, TEXAS

OWNER

NORTHWOOD RETAIL
8080 PARK LANE #600
DALLAS, TX, 752413
214-365-0222

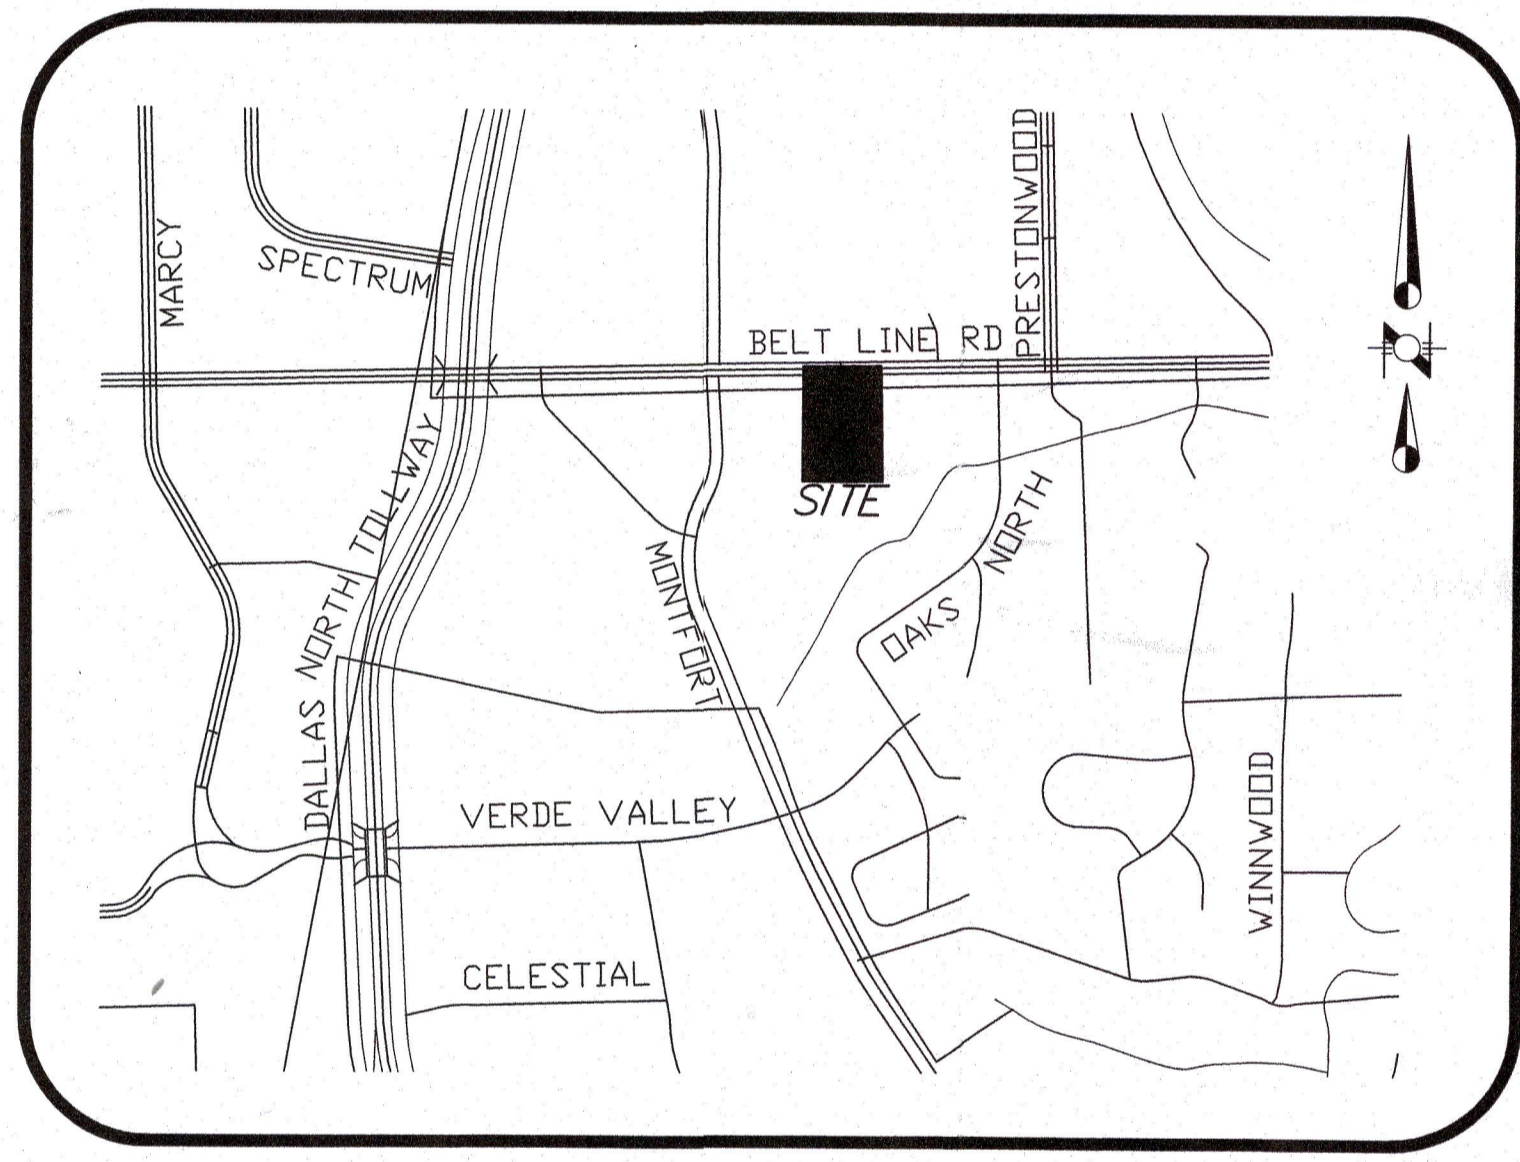

Vicinity Map
NTS

SHEET LIST


- C1.00 UTILITY PLAN
- C2.00 TOWN OF ADDISON DETAILS

RLG CONSULTING ENGINEERS

12001 N. CENTRAL EXPRESSWAY
SUITE 300 DALLAS, TEXAS 75243
(214) 739-8100
FIRM REG: F-493



APPROVED FOR CONSTRUCTION
INFRASTRUCTURE & DEVELOPMENT SERVICES
BY: *[Signature]*
DATE: 9/9/19

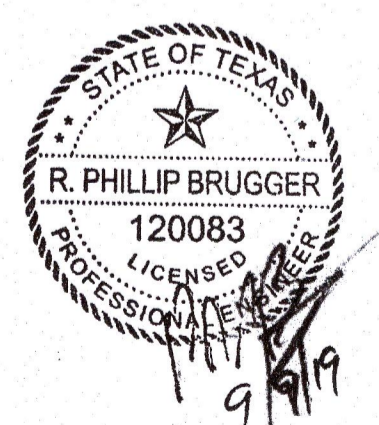

IN APPROVING THESE PLANS, THE TOWN OF ADDISON ASSUMES NO RESPONSIBILITY FOR THEIR ADEQUACY, WHICH REMAINS WITH THE ENGINEER OF RECORD.
18801 WESTGROVE DRIVE, ADDISON, TX 75001 - (972) 450-2871

1913.009 PRESTONWOOD SHAKE SHACK UTILITY SERVICES

AS-BUILT

AS-BUILT