

CITY OF ADDISON

BELT LINE

Estate Owner's: Rose Ann Julian Smith, John E. Julian Jr. & S.L. Christie (Agent) ~ Dec. 8, 1975  
 Mildred Julian Christie ~ Dec. 8, 1975  
 15' Sanitary Sewer Easement  
 Parallel With N. ROW of Adjacent To Belt Line Rd. From E. ROW of Dallas Hwy To W. ROW of Noel Rd.  
 Temp. Working Space Granted.  
 C.O. - 75374 Vol. - 75253 Pg. - 014015 Date - Dec. 31, 1975

Prestonwood National Bank  
 Note: Polyethylene Wrap to be Used on all Prop. D.I. Water Pipes, D.I. Fittings and Fire Hydrant Bases.

City of Addison - Dec. 5, 1975  
 Authorized Construction of Water & Sanitary Mains to Reach Prop. Prestonwood National Bank  
 C.T. Webster  
 A City Administrator  
 Also See Letter From County Director of Public Works. Dec. 1, 1975

Simons Land Co. - Acting Through President Herman Ruppel - Nov. 25, 1975  
 15' Sanitary Sewer Easement  
 Adjacent To And Parallel With The N. ROW of Belt Line Rd. From E. ROW of Noel Rd. East To End of Esmt. 53  
 Temp. Working Space Granted.  
 C.O. - 75374 Vol. - 75253 Pg. - 014015 Date - Dec. 31, 1975

Simons Land Co. 10-31-73  
 CITY OF ADDISON  
 CITY OF DALLAS Ordinance No. 15119, March 1, 1976  
 HOCKADAY SCHOOL, INC.

ABSTRACT 1580  
 CITY OF DALLAS  
 BLK. 8222


**NOTE!!**  
 ALL R.C. FLANGE OUTLET CONNECTIONS ON CONCRETE PRESSURE PIPES MADE TO C.I. FLANGE FITTINGS SHALL BE INSULATED AS SHOWN ON APPURT. SHEET 414D-11

CONTRACT NO. 61-45  
 See Also 1960-3147

Sanitary Sewer Survey Along N. Side of Belt Line Rd. From Noel Rd. West. Contract # 571-13  
 Scale: 1"=40' Plan 1"=6' Vert.

TEMP. BENCH MARK:  
 R.R. Spike in pole at S.W. corner of Belt Line Rd. and Noel Rd. Elev. 626.77

**NOTE!** BORINGS BY:  
 MASON-JOHNSTON & ASSOCIATES.  
 BORING B-5 DRY AT 24-HR.  
 WATER CHECK. 30 NOV, 1960.

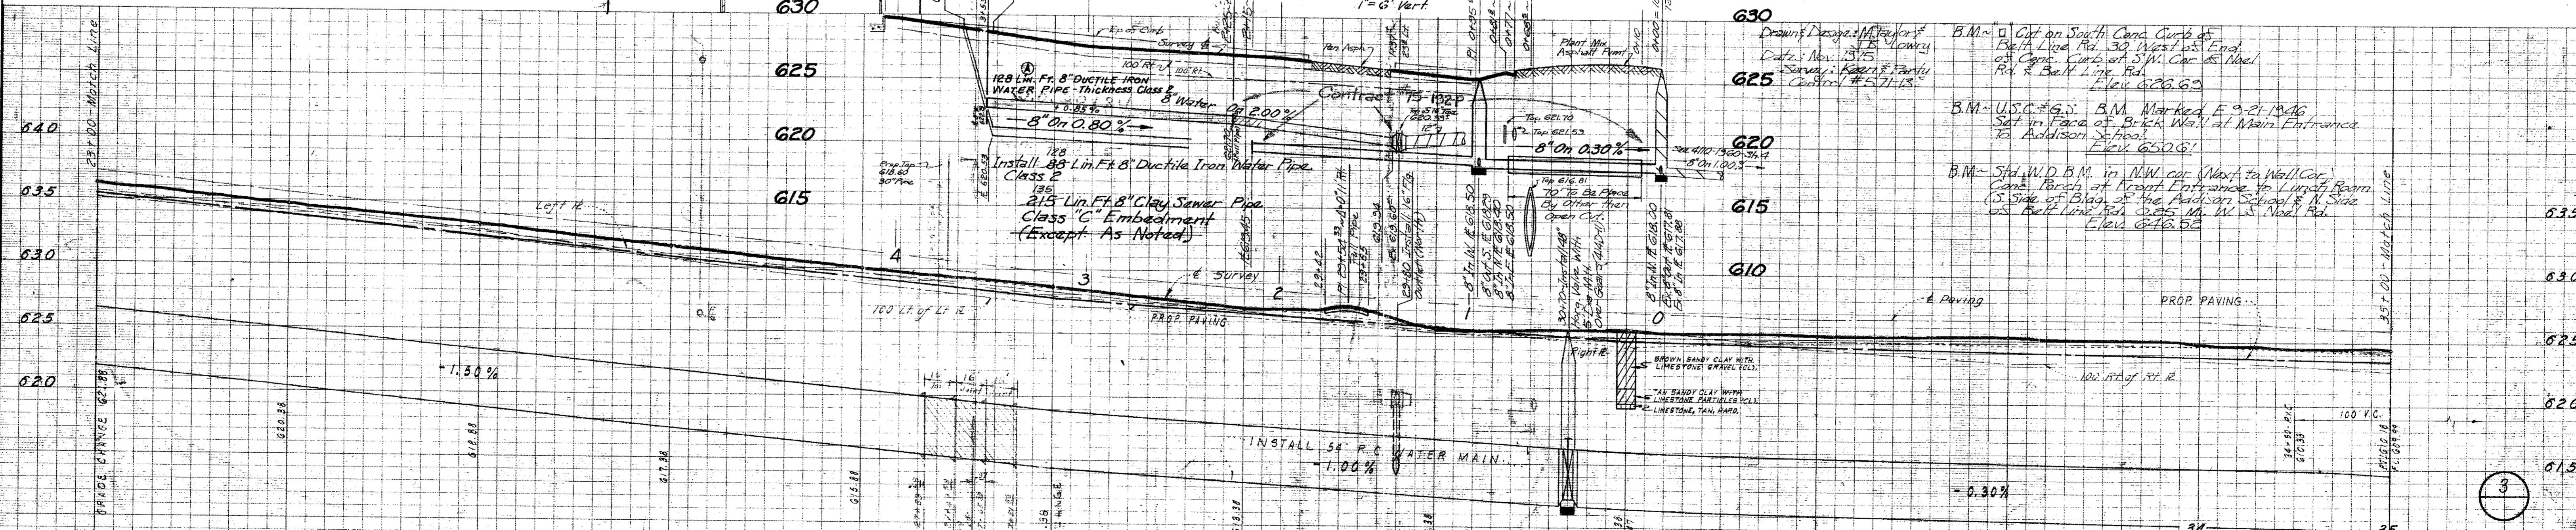

1200 LIN. FT. OF 54" DOUBLE WRAP PRETENSIONED CONC. CYLINDER PIPE CLASS 125 OR  
 2400 LIN. FT. OF 54" PRESTRESSED REINFORCED CONC. EMBEDDED CYLINDER PIPE CLASS 125  
 CLASS 3 EMBEDMENT

**54" R.C. WATER MAIN**  
 IN BELT LINE ROAD  
 FROM INWOOD RD. TO DULUS RD.  
**DALLAS CITY WATERWORKS**  
 CITY OF DALLAS, TEXAS

DESIGN	DRAWN	DATE	SCALE	NOTES	FILE	NO.
C.L. Moon Engineers	D.P.	May 60	1/4"=1'-0"	See notes	685-W	540-A

ROW Approved: [Signature] Date: 12-23-75  
 C.L. Moon Inc. Engineers  
 Approved By: [Signature] Date: 12-23-75  
 Engineer of Design: Dallas City Waterworks  
 Contract No. 75-192-P-2 - Welch Const. Co. 12-18-75

CONTRACT OF W.O. #