


DRAINAGE SUMMARY

AREA	ACRES	C	1100	Q100	REMARKS
A1	0.68	0.9	8.74	5.35	INC. ROOF DRAIN-BLDG. A
A2	0.87	0.7	8.74	5.32	FROM RES. SUBD.
A3	0.56	0.9	8.74	4.40	TO 10' C.I.
A4	2.69	0.9	8.74	21.13	KMART ROOF DRAINAGE
A5	1.18	0.4	7.70	3.60	PARK AREA
A6	0.49	0.9	8.74	3.85	TO 10' C.I.
A7	0.15	0.9	8.74	1.41	GARDEN SHOP DRAINAGE
A8	0.44	0.9	8.74	3.46	TO 8' C.I.
A9	0.36	0.9	8.74	2.83	TO MARCH LANE
B1	1.96	0.7	8.74	11.99	FROM SUBD. TO 34"
B2	4.45	0.45	7.70	15.4	PARK AREA
B3	1.46	0.9	8.74	11.48	TO 14' C.I.
B4	1.24	0.9	8.74	9.75	TO 10' C.I.
B4-1	1.84	0.9	8.74	14.75	WIND-DRIVE ROOF DRAIN
B5	0.10	0.9	8.74	0.79	8" GRATE INLET
B6	1.44	0.7	8.74	9.91	BLDG. B ROOF DRAIN
B7	1.93	0.4	7.70	5.94	FROM SUBD.
B8	11.51	0.9	8.74	96.54	FUTURE PARK
C1	1.22	0.9	8.74	8.80	FUTURE PH. II (BLS etc. PH. 1)
C2	2.84	0.9	8.74	20.80	TO 10' C.I.
D1	1.66	0.9	8.74	13.06	TO 14' C.I.
D2	0.21	0.9	8.74	1.57	TO 8' C.I.
D3	0.81	0.9	8.74	4.80	TO 10' C.I.
D4	0.93	0.9	8.74	7.31	
E1	1.58	0.9	8.74	12.43	
E2	0.87	0.9	8.74	6.84	TO 10' C.I.
E3	0.90	0.9	8.74	4.73	TO 10' C.I.
F1	0.51	0.9	8.74	4.01	TO 8' C.I.
G1	0.40	0.9	8.74	3.15	TO 8' C.I.
G2	0.75	0.9	8.74	5.90	TO 8' C.I.
H1	2.00	0.9	8.74	15.73	TO 8' C.I.
J1	0.18	0.9	8.74	1.42	FUTURE LOT 2
K	0.12	0.9	8.74	0.94	TO EXIST. INLET
L1	1.47	0.45	7.70	5.09	TO BELT LINE ROAD
L2	7.85	0.9	8.74	61.75	FUTURE PARK
OS-1	175.00	0.60	6.8	07.14	FUTURE RETAIL
OS-2	414.00	0.80	4.8	1590	FROM 96" RCP
OS-3	40.98	0.90	7.7	284	FROM AREA N. OF BELT LINE
OS-4	01.14	0.90	8.7	9	54" (BUSINESS DR.)
OS-5	82.00	0.52	7.8	246	WIND-DRIVE ROOF DRAIN
					4" GRATE INLET

NOTE: THE AS-BUILT STAMP ON THIS SHEET PERTAINS TO THE SUBDIVISION AREA ONLY. OTHER AREAS ARE OUTSIDE THE LIMITS OF THIS PROJECT & CURRENTLY UNDER CONSTRUCTION.

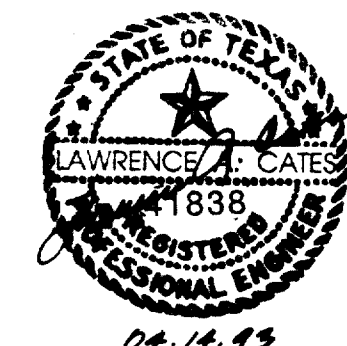

AS-BUILTS
I CERTIFY THIS PROJECT WAS CONSTRUCTED IN GENERAL CONFORMANCE WITH THESE CONSTRUCTION PLANS AND WILL FUNCTION AS DESIGNED.

REV. 5-11-93: REV. DA, A2 & "C" FOR DA'S A2, B1, & B6

DRAINAGE AREA MAP						
KMART No. 4885						
ADDISON TOWN CENTER						
TOWN OF ADDISON, TEXAS						
LAWRENCE A. CATES & ASSOC.						CONSULTING ENGINEERS DALLAS, TEXAS
DESIGN	DRAWN	DATE	SCALE	NOTES	FILE	NO.
LAC	LAC	4-1-93	1"=100'	D.P.	91012 DRMGAREA	C-4