


AS-BUILTS
 I CERTIFY THIS PROJECT WAS CONSTRUCTED IN GENERAL CONFORMANCE WITH THESE CONSTRUCTION PLANS AND WILL FUNCTION AS DESIGNED.

BENCHMARK:
 "□" CUT ON STORM SEWER INLET ON SOUTH SIDE OF BELT LINE ROAD 70'± WEST OF COMMERCIAL DRIVE.
 ELEV. 580.56'

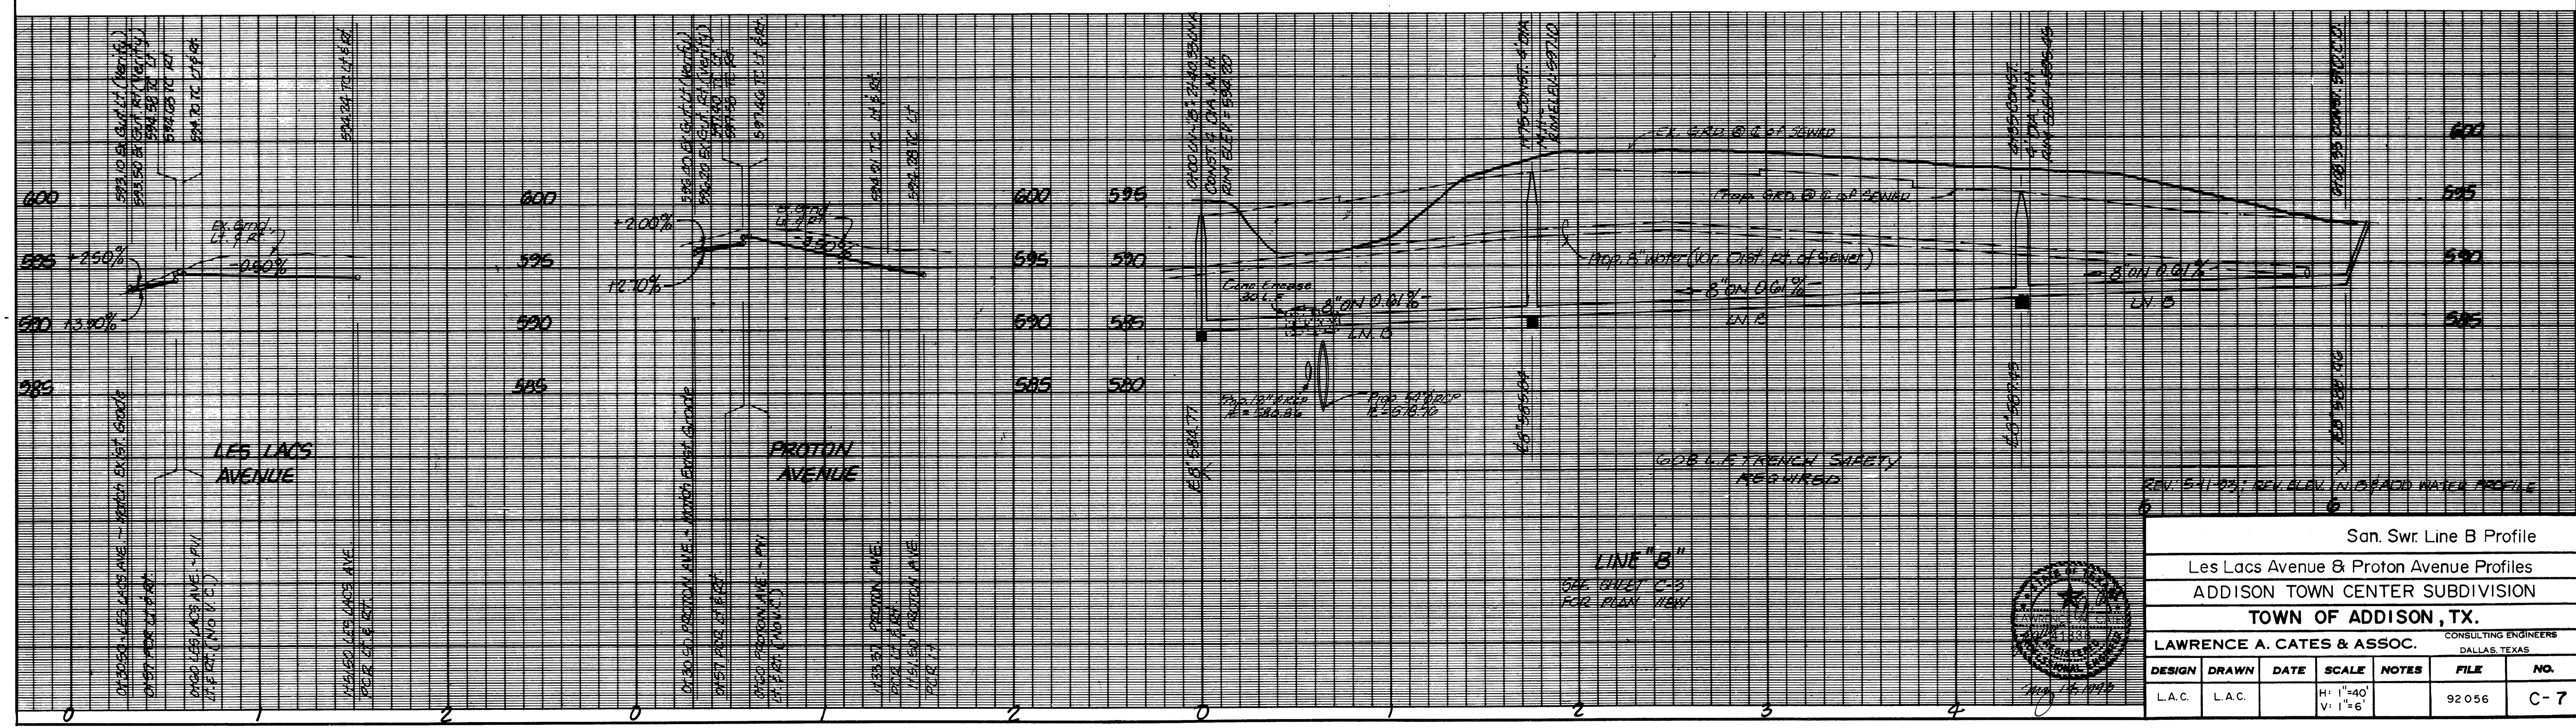

REV. 5-11-93; REV. ELEV. IN SUBACID WATER PROFILE

San. Swr. Line B Profile						
Les Lacs Avenue & Proton Avenue Profiles						
ADDISON TOWN CENTER SUBDIVISION						
TOWN OF ADDISON, TX.						
LAWRENCE A. CATES & ASSOC. CONSULTING ENGINEERS DALLAS, TEXAS						
DESIGN	DRAWN	DATE	SCALE	NOTES	FILE	NO.
L.A.C.	L.A.C.		H: 1"=40' V: 1"=6'		92056	C-7