


# THE CITY OF ADDISON AND THE COUNTY OF DALLAS

## CONSTRUCTION PLANS FOR:

-BELT LINE ROAD IMPROVEMENTS-  
MARSH LANE TO NORTH DALLAS PARKWAY

PROJECT LENGTH: 10,185 FT.

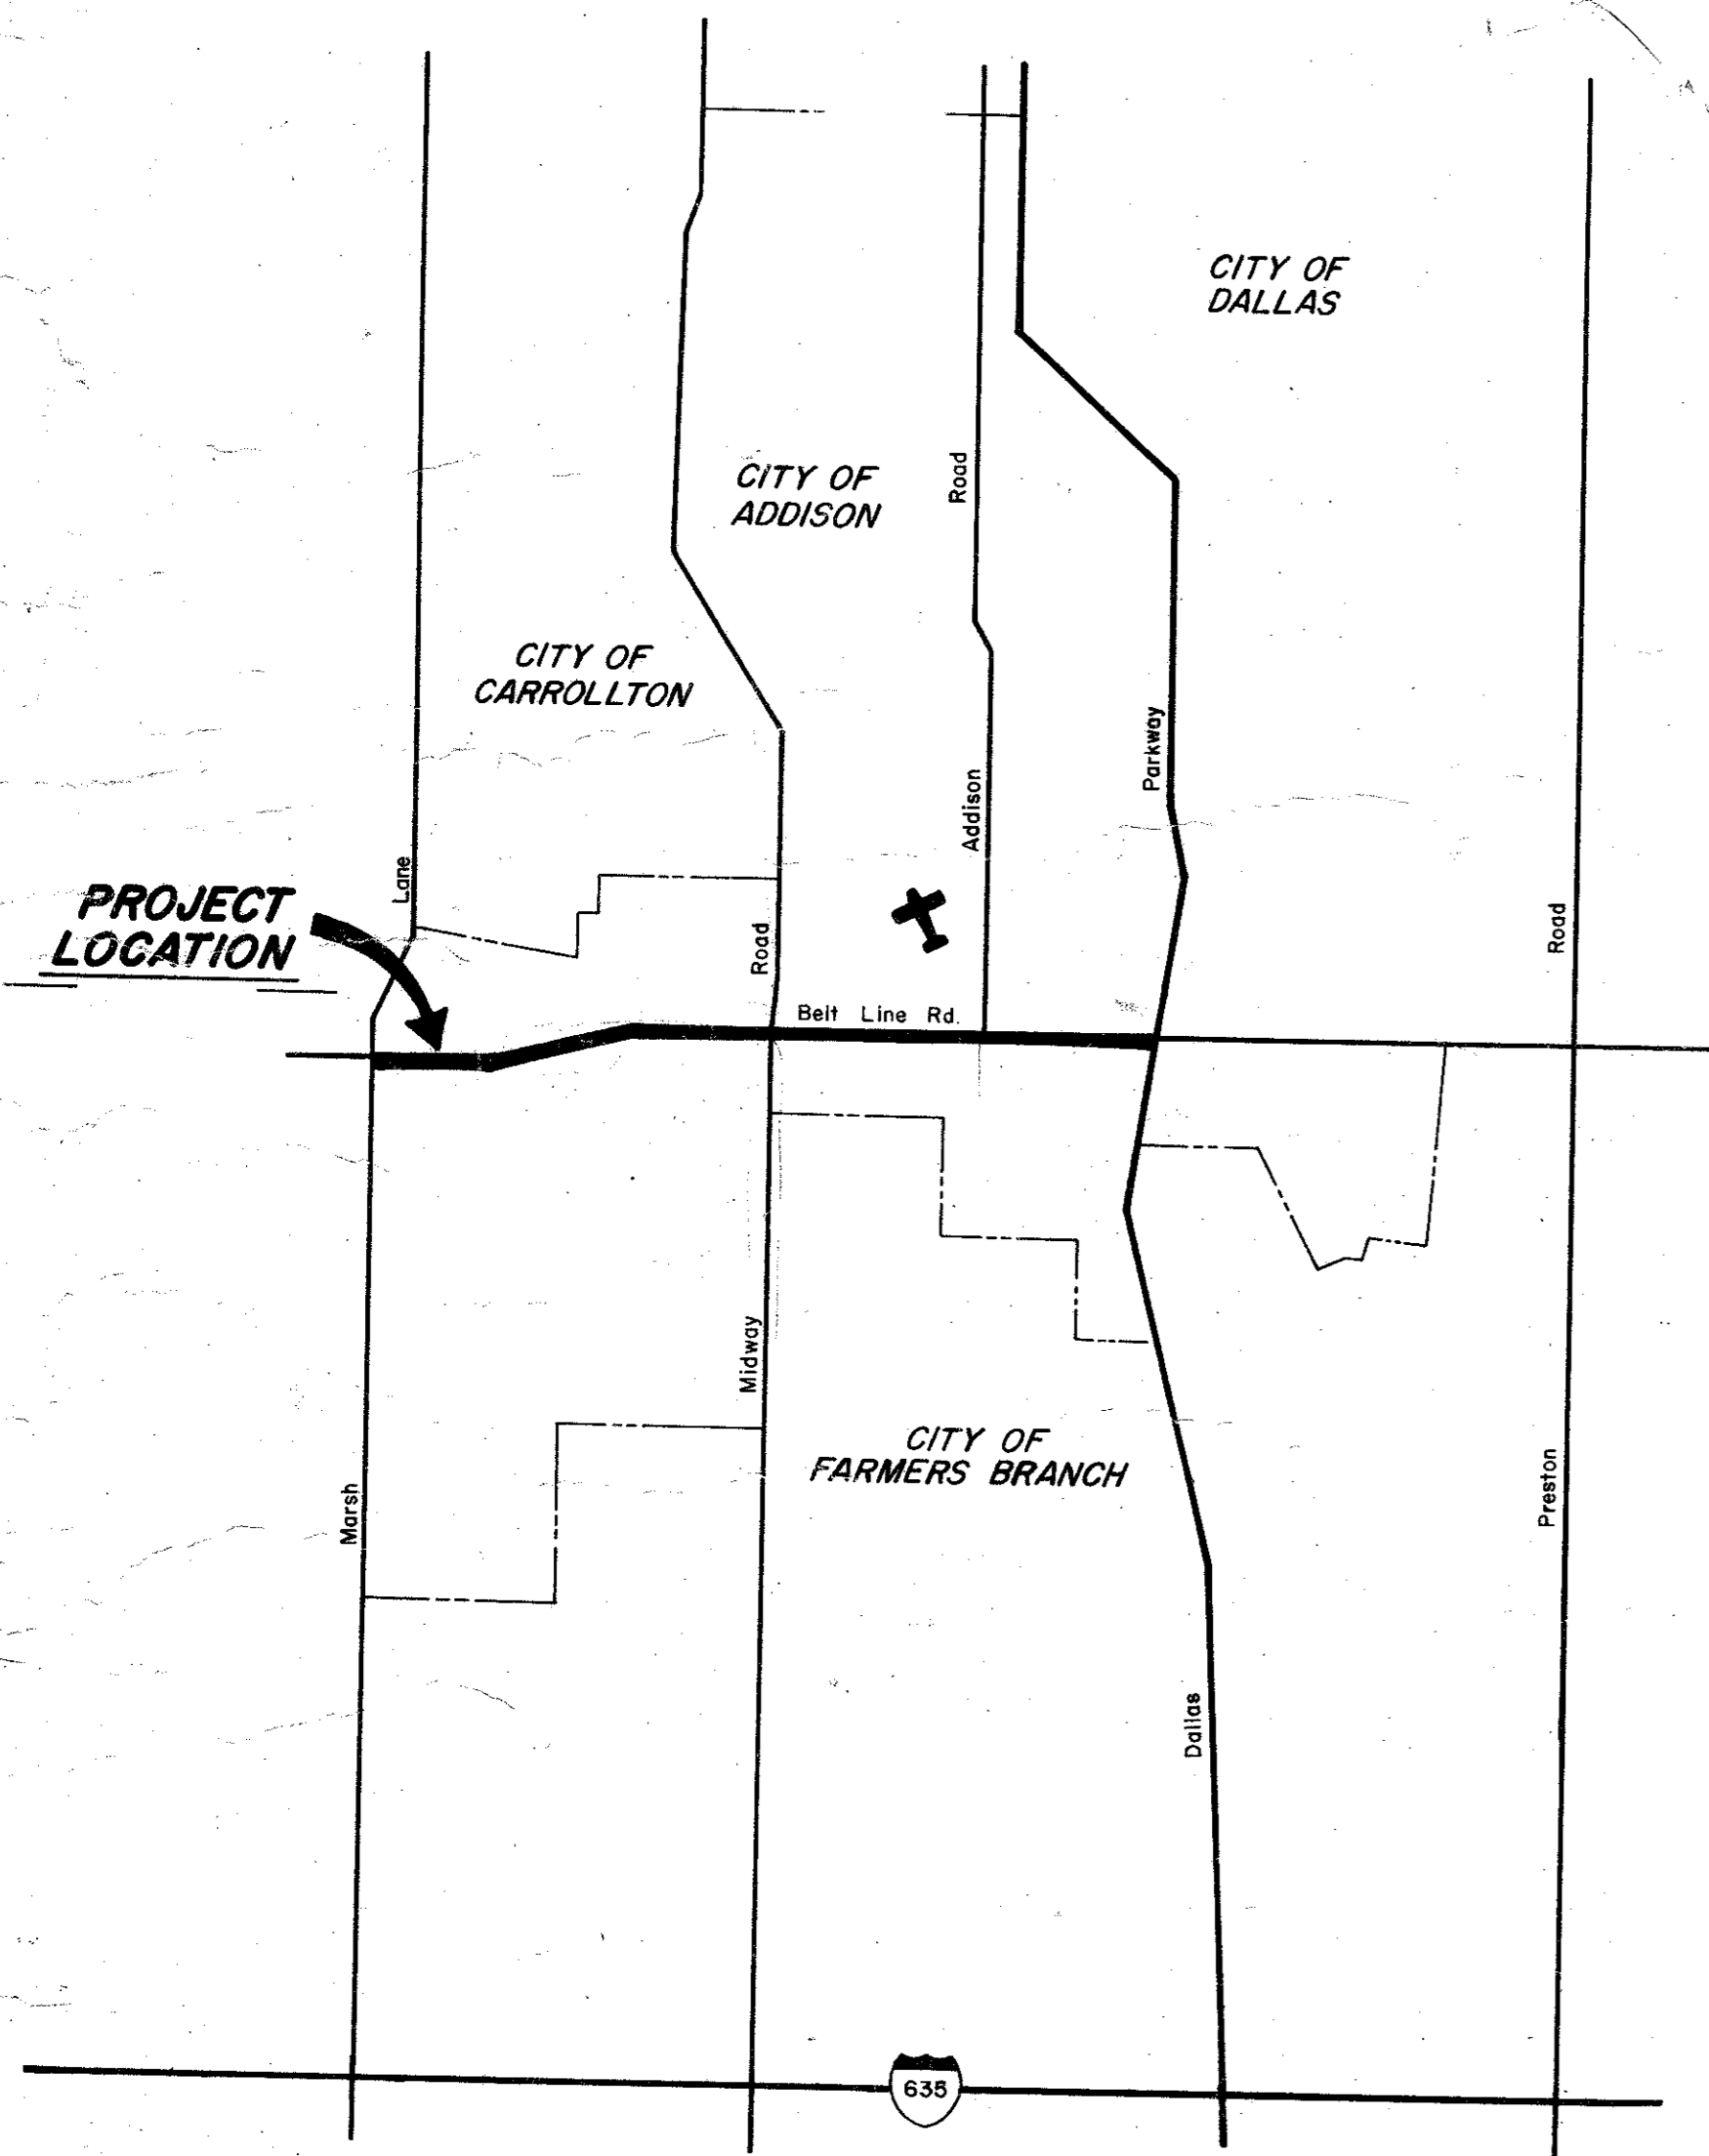

JERRY J. REDDING - MAYOR  
COUNCILMEN:

JOHN B. ALLEN  
RICHARD RODER  
WILLIAM F. SELLMAYER  
JACK DINGLER  
TERRY ROBERTS

G. J. WEBSTER - CITY ADMINISTRATOR  
DON PREECE - DIRECTOR OF PUBLIC WORKS

RECORD  
SET



GINN INC.  
CONSULTING ENGINEERS  
DALLAS, TEXAS  
1980

CITY OF ADDISON

Approved By: *[Signature]*  
Mayor

COUNTY OF DALLAS

Approved By: \_\_\_\_\_

C. Judson Shock P.E.  
Director Of Public Works