


ESTIMATED QUANTITIES			
ITEM	DESCRIPTION	UNIT	QUANTITY
100	Prepare Roadway R.O.W	Sta.	5
104.1	Remove Old Concrete, Pavement & Median	SY	---
104.2	Sawed Break-Out Groove	LF	99
110	Unclassified Road Excavation (Dens Cont.)	CY	3602
160	Placing 4" Topsoil	CY	---
248	6" Flex Base (Dens Cont.) (Ty A, Gr 2, C13)	CY	---
260.1	Lime (Ty A) Slurry Method	Ton	57.08
260.2	6" Lime Treated Subgrade (Dens Cont)	SY	4566.73
340.1	3" Hot Mix Asphalt (Ty D) Resurf Shoulder	Ton	73.34
340.2	6" Hot Mix Asphalt (Ty B)	Ton	---
360.1	8" Conc Pavement (3000 PSI)	SY	4341.49
360.2	6" Conc Monolithic Curb (3000 PSI)	LF	1550
360.3	4" Non-Reinf Conc In Median (2000PSI)	SY	131.48
522	Conc Curb & Gutter Class A	LF	---
524	Conc Driveways, Appr 5" Reinf Conc (3000PSI)	SY	244.94
630.1	Foundation (Ty A) Traffic Sig In Place	EA	---
630.2	Foundation (Ty B) Traffic Sig In Place	EA	---
630.3	Foundation (Ty C) Traffic Sig In Place	EA	---
630.4	Foundation (Ty D) Illumination	EA	2
640.1	1/2" PVC Conduit, Furnish & Install	LF	500
640.2	2" PVC Conduit, Furnish & Install	LF	500
640.3	3" PVC Conduit, Furnish & Install	LF	---
640.4	Pull Box, Complete In Place	EA	3
752.1	Traffic Buttons-Single Refl Ty P15 White	EA	48
752.2	Traffic Buttons-Single Refl Ty P18-1 White	EA	20
754.1	Traffic Buttons-Nonrefl, Ty P7 White	EA	240

LEGEND	
□	Bench Mark
○	Iron Pin
○	Manhole
W	Gas Meter
W	Gas Valve
W	Gas Line
W	Power Pole (Typical Pole Symbol)
W	Power Line
W	Eye Wire Anchor
W	Telephone Line
W	Water Meter
W	Water Valve
W	Water Line
W	Fire Hydrant
W	Manhole
W	Sanitary Sewer Line
W	Fence Line
W	Flow Direction Indicator
W	Property or Right-of-Way Line (ROW)
W	Construction Line
W	Traffic Pull Box
W	Manhole Foundation (Type A or B)
W	Pedestal Pole Foundation (Type C)
W	Signal Illumination Pole Foundation (Type D)
W	Top of Curb
W	Flow Line

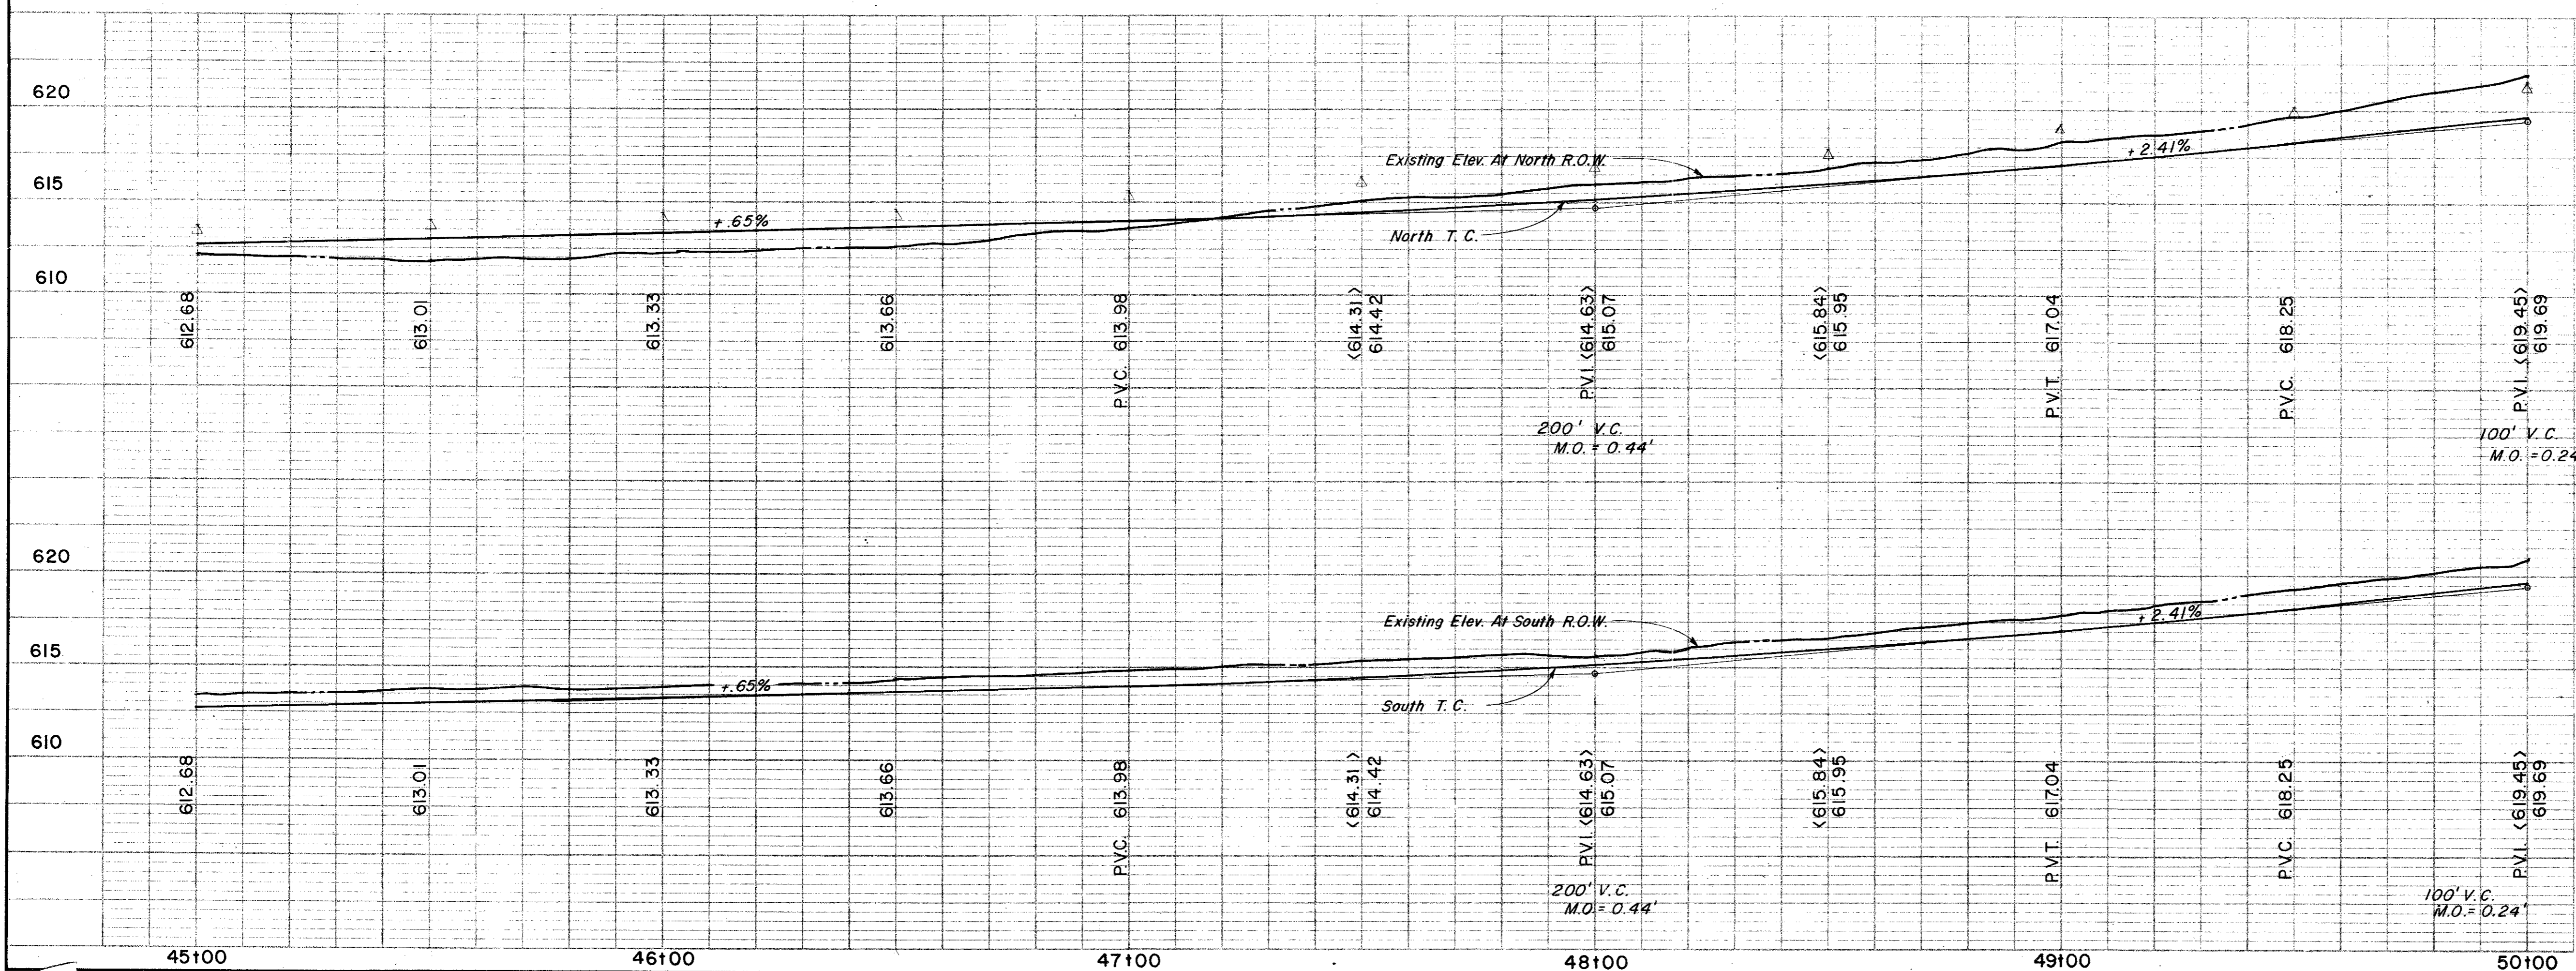

No. 1 Move drive 5' East Add Drives - 47+18, 50+14 & Chg. Qty.	Revision Date	3-4-81 2/25/81 615
--	------------------	--------------------------

**CITY OF ADDISON**  
**COUNTY OF DALLAS, TEXAS**  
 DEPARTMENT OF PUBLIC WORKS  
**PAVING Sta. 45+00 to 50+00**  
**BELT LINE ROAD**  
 MARSH LANE TO NORTH DALLAS PKWY.  
**GINN, INC., CONSULTING ENGINEERS**

DESIGNED - H.B.J. DRAWN - S.M. DATE - MAY - 1980 FILE  
 APPROVED - H.W.G. CHECKED - B.H. SCALE - H=1"=20' V=1"=5' SHEET 15 OF