


ESTIMATED QUANTITIES			
ITEM	DESCRIPTION	UNIT	QUANTITY
100.	Prepare Roadway R.O.W	Sta.	5
104.1	Remove Old Concrete, Pavement & Median	SY	
104.2	Sawed Break-Out Groove	LF	59
110	Unclassified Road Excavation (Dens Cont.)	CY	3762
160	Placing 4" Topsoil	CY	
248	6" Flex Base (Dens Cont.) (Ty A, Gr 2, C13)	CY	
260.1	Lime (Ty A) Slurry Method	Ton	44.11
260.2	6" Lime Treated Subgrade (Dens Cont.)	SY	3528.89
340.1	3" Hot Mix Asp (Ty D) Resurf Shoulder	Ton	69.67
340.2	6" Hot Mix Asphalt (Ty B)	Ton	607.02
360.1	8" Conc Pavement (3000 PSI)	SY	5254.82
360.2	6" Conc Monolithic Curb (3000 PSI)	LF	1556
360.3	4" Non-Reinf Conc In Median (2000 PSI)	LF	140
360.4	Conc. Sl. Header	LF	78
479.1	Adjust Water Valves	EA	7
522	Conc Curb & Gutter Class A	LF	
524	Conc Driveways, Appr 5" Reinf Conc (3000 PSI)	SY	192.5
630.1	Foundation (Ty A) Traffic Sig In Place	EA	4
630.2	Foundation (Ty B) Traffic Sig In Place	EA	4
630.3	Foundation (Ty C) Traffic Sig In Place	EA	4
640.1	Foundation (Ty D) Illumination	EA	2
640.2	1/2" PVC Conduit, Furnish & Install	LF	500
640.3	2" PVC Conduit, Furnish & Install	LF	433
640.4	3" PVC Conduit, Furnish & Install	LF	475
640.4	Pull Box, Complete In Place	EA	8
752.1	Traffic Buttons - Single Refl Ty P15 White	EA	40
752.2	Traffic Buttons - Single Refl Ty P18-1 White	EA	38
754.1	Traffic Buttons - Nonrefl, Ty P7 White	EA	200

LEGEND	
□	Blank Mark
○	Iron Pin
○	Manhole
○	Gas Meter
○	Gas Valve
○	Gas Line
○	Power Pole (Typical Pole Symbol)
○	Power Line
○	Gas Wire Anchor
○	Telephone Line
○	Water Main
○	Water Valve
○	Water Line
○	Fire Hydrant
○	Manhole
○	Sanitary Sewer Line
○	Face Line
○	Face Direction Indicator
○	Property or Right-of-Way Line (R.O.W.)
○	Excavation Line
○	Traffic Pole Box
○	Manhole Foundation (Type A or B)
○	Manhole Foundation (Type C)
○	Signal Illumination Pole Foundation (Type D)
○	Top Of Curb
○	Face Line

B.M. #8 "a" Top Of Curb At N.W. Corner Of Parking Lot For Gulf Oil Station At S.W. Corner Int. Midway & Belt Line, ELEV = 624.32

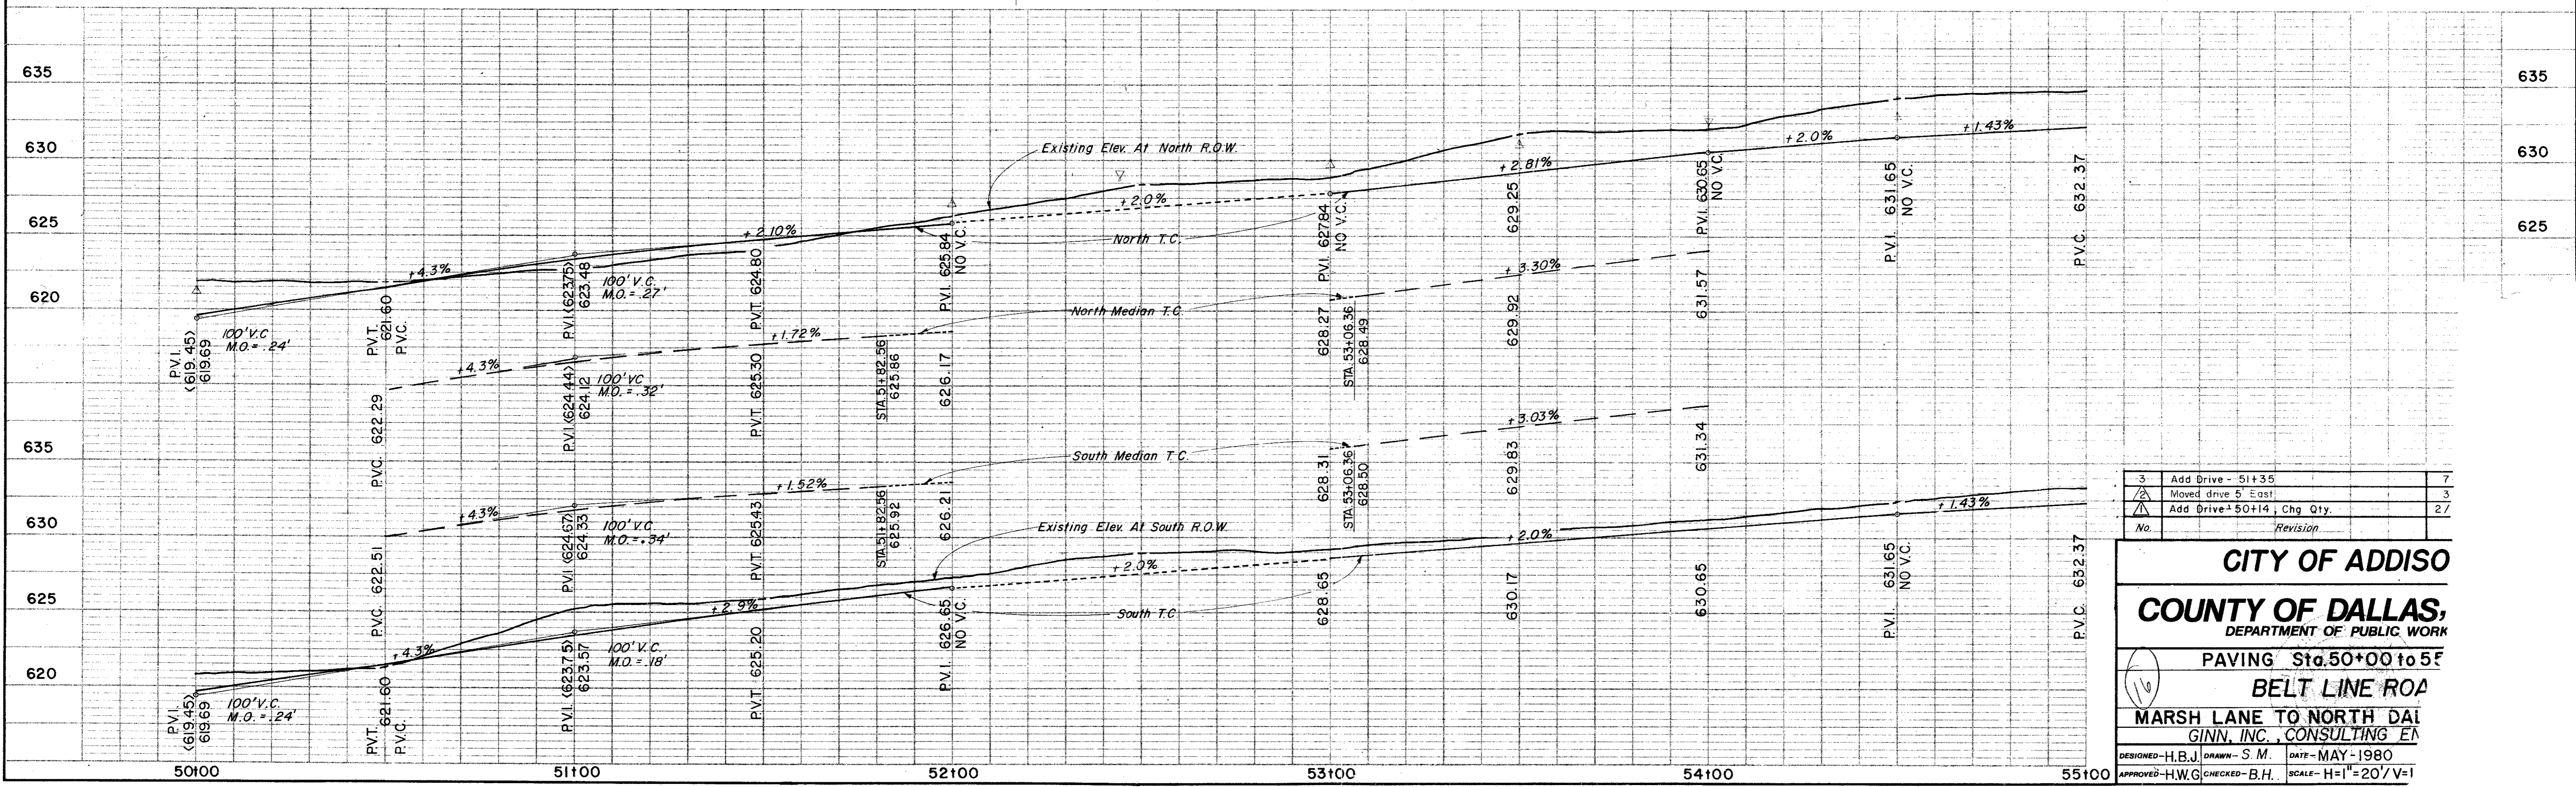

No.	Revision
3	Add Drive - 51+35
2	Moved drive 5' East
1	Add Drive + 50+14, Chg Qty.

CITY OF ADDISO
COUNTY OF DALLAS,
 DEPARTMENT OF PUBLIC WORK

PAVING Sta. 50+00 to 55+00
BELT LINE ROAD

MARSH LANE TO NORTH DAI
 GINN, INC., CONSULTING EN

DESIGNED - H.B.J. DRAWN - S.M. DATE - MAY - 1980
 APPROVED - H.W.G. CHECKED - B.H. SCALE - H=1"=20' V=1"