


ESTIMATED QUANTITIES			
ITEM	DESCRIPTION	UNIT	QUANTITY
100.	Prepare Roadway R.O.W.	Sta.	5
104.1	Remove Old Concrete, Pavement & Median	SY	
104.2	Sawed Break-Out Groove	LF	7.4
110	Unclassified Road Excavation (Dens Cont.)	CY	3482
160	Placing 4" Topsoil	CY	24.58
248	6" Flex Base (Dens Cont) (Ty A, Gr 2, C13)	CY	
260.1	Line (Ty A) Slurry Method	Ton	55.12
260.2	6" Lime Treated Subgrade (Dens Cont)	SY	4409.96
340.1	3" Hot Mix Asphalt (Ty D) Resurf Shoulder	Ton	91.68
340.2	6" Hot Mix Asphalt (Ty B)	Ton	
360.1	8" Conc Pavement (3000 PSI)	SY	4160.52
360.2	6" Conc Monolithic Curb (3000 PSI)	LF	1878
360.3	4" Non-Reinf Conc In Median (2000 PSI)	SY	115.97
479.1	Adjust Water Valves	EA	2
479.2	Adjust Manhole	EA	1
640.5	2" PVC. SCH 40 (Conc. Encasement)	L.F.	45
522	Conc Curb & Gutter Class A	LF	
524	Conc Driveways, Appr 5" Reinf Conc (3000 PSI)	SY	150.89
630.1	Foundation (Ty A) Traffic Sig In Place	EA	
630.2	Foundation (Ty B) Traffic Sig In Place	EA	
630.3	Foundation (Ty C) Traffic Sig In Place	EA	
630.4	Foundation (Ty D) Illumination	EA	2
640.1	1/2" PVC Conduit, Furnish & Install	LF	500
640.2	2" PVC Conduit, Furnish & Install	LF	500
640.3	3" PVC Conduit, Furnish & Install	LF	
640.4	Pull Box, Complete In Place	EA	1
752.1	Traffic Buttons - Single Refl Ty P15 White	EA	48
752.2	Traffic Buttons - Single Refl Ty P18-1 White	EA	22
754.1	Traffic Buttons - Nonrefl, Ty P7 White	EA	240



B.M. #2 "b" on Conc. Walk At S.E. Corner Of Storage Building For Payless
Cashways East Of Addison Road & North Of Belt Line Road. ELEV.=638.65

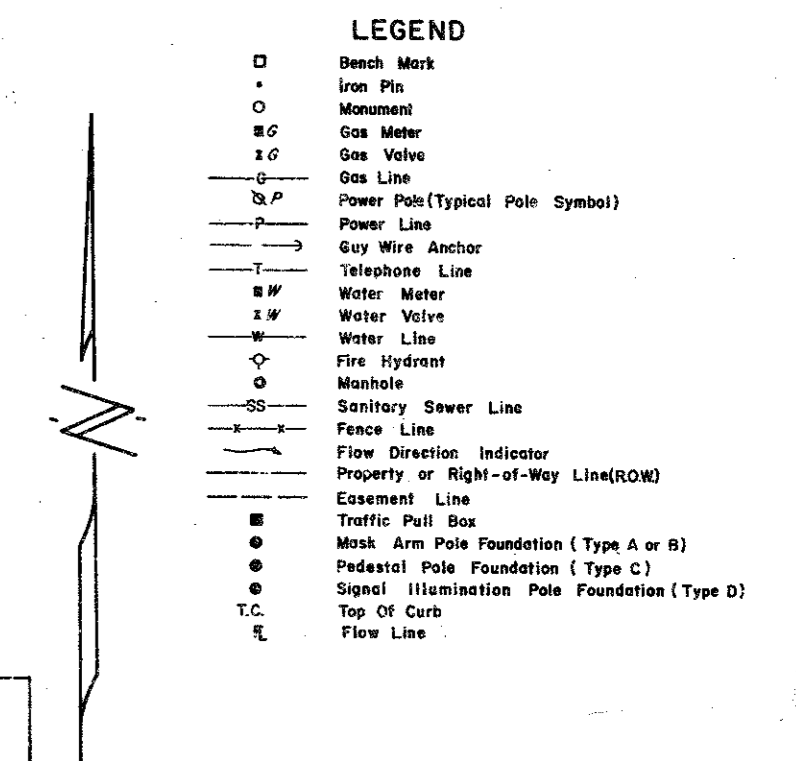