


ESTIMATED QUANTITIES			
ITEM	DESCRIPTION	UNIT	QUANTITY
470.3	10' Standard C.I.	EA	1.0
471.3	8' Standard C.I.	EA	1.0

LEGEND	
□	Manhole
○	Iron Pipe
○	Moment
○	Gas Meter
○	Gas Valve
○	Gas Line
○	Power Pole (Typical Pole Symbol)
○	Power Line
○	City Wire Anchor
○	Telephone Line
○	Water Meter
○	Water Valve
○	Water Line
○	Fire Hydrant
○	Manhole
○	Sanitary Sewer Line
○	Fence Line
○	Flow Direction Indicator
○	Property or Right-of-Way Line (R.O.W.)
○	Traffic Pole Box
○	Man. Arm Pole Foundation (Type A or B)
○	Pedestal Pole Foundation (Type C)
○	Signal Illumination Pole Foundation (Type D)
○	Top of Curb
○	Flow Line

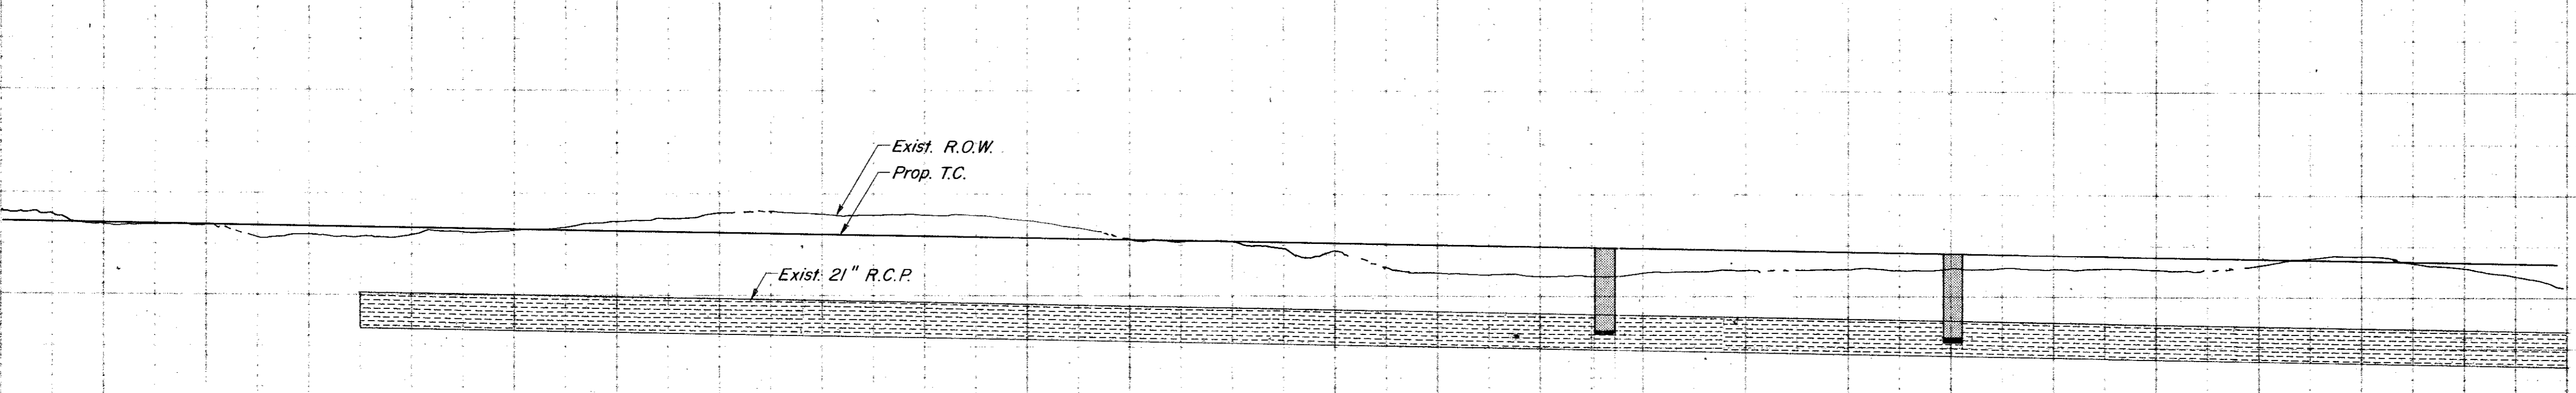

**CITY OF ADDISON**  
**COUNTY OF DALLAS, TEXAS**  
DEPARTMENT OF PUBLIC WORKS  
**DRAINAGE STA. 60100 - 65100**  
**BELT LINE ROAD**  
**MARSH LN. TO NORTH DALLAS PKWY.**  
**GINN, INC., CONSULTING ENGINEERS**

DESIGNED - J.C.H. DRAWN - S.M. DATE - MAY - 1980 FILE  
APPROVED - H.W.G. CHECKED - B.H. SCALE - H=1"=20' / V=1"=5' SHEET 39 OF