


ITEM	DESCRIPTION	UNIT	QUANTITY
421.0	Cl. A Conc. Pipe (Ringwall)	CY	15.3
430	Extend 6x3 Box (Conc.)	CY	17.3
440.0	Reinf. Steel Ringwall	LBS	479.0
440.4	Reinf. Steel Box Culvert	LBS	2085.0
465.1	18\"/>		

LEGEND	
○	Head Mark
●	Iron Pin
○	Manhole
⊕	Gas Meter
⊕	Gas Valve
⊕	Gas Line
⊕	Power Pole (Typical Pole Symbol)
⊕	Power Line
⊕	Wire Anchor
⊕	Telephone Line
⊕	Water Meter
⊕	Water Valve
⊕	Water Line
⊕	Fire Hydrant
⊕	Manhole
⊕	Sanitary Sewer Line
⊕	Fence Line
→	Flow Direction Indicator
→	Priority or Right-of-Way Line (ROW)
→	Easement Line
⊕	Traffic Pole Box
⊕	Man. Am. Pole Foundation (Type A w/ B)
⊕	Pedestal Pole Foundation (Type C)
⊕	Signal Illumination Pole Foundation (Type D)
⊕	Top of Cut
⊕	Flow Line

PROFILE OF 6'x3' BOX CULVERT

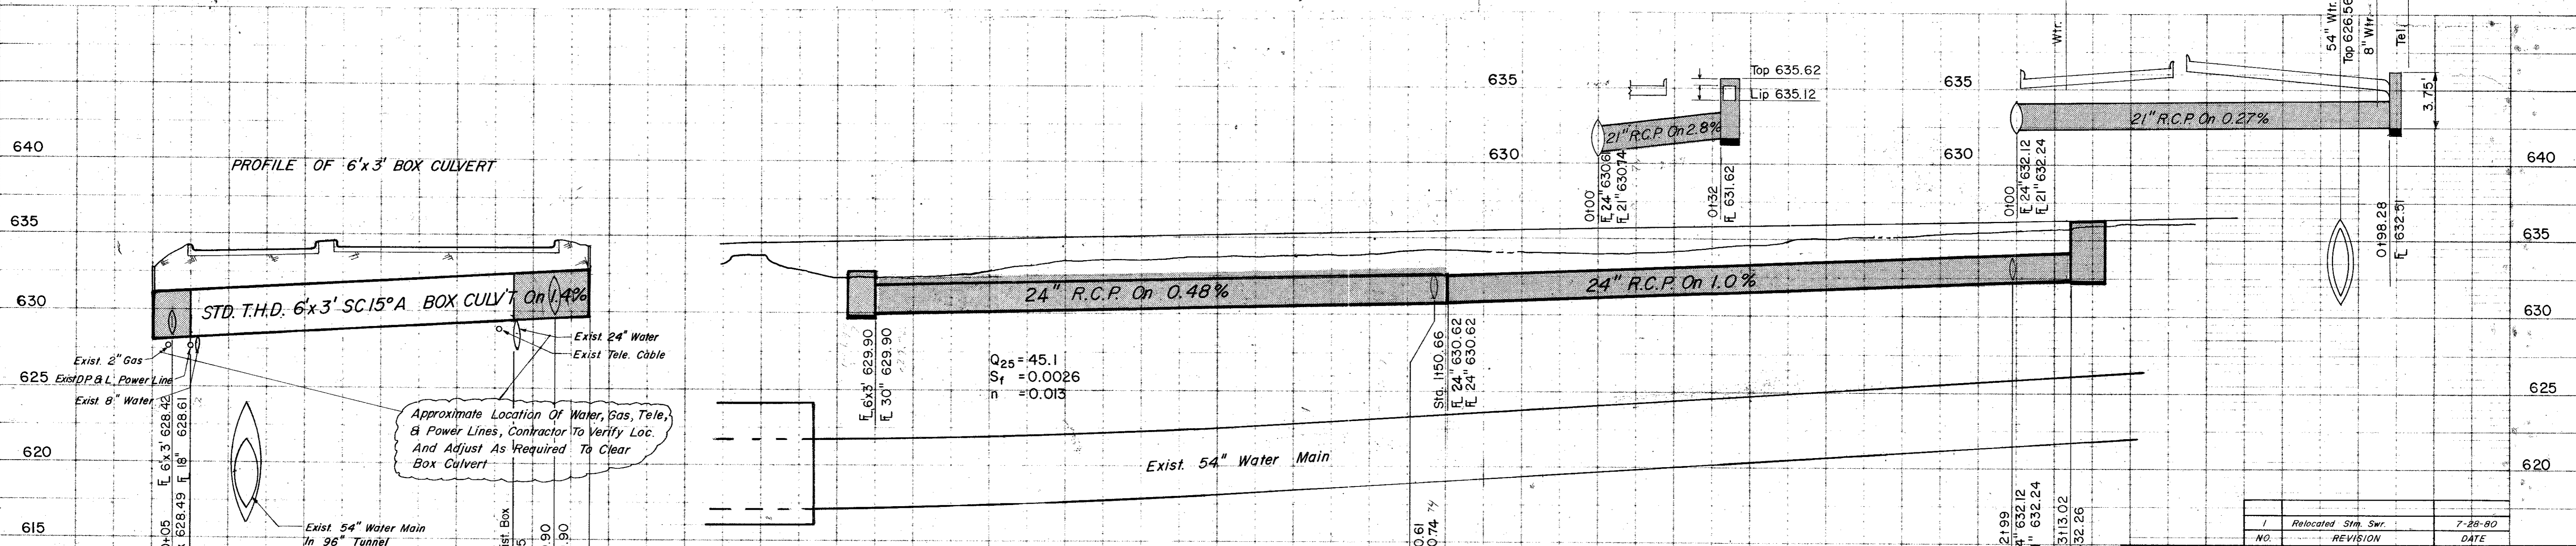

**CITY OF ADDISON**  
**COUNTY OF DALLAS, TEXAS**  
 DEPARTMENT OF PUBLIC WORKS  
**DRAINAGE STA. 78100 - 82100**  
**BELT LINE ROAD**  
 MARSH LN. TO NORTH DALLAS PKWY.  
 GINN, INC., CONSULTING ENGINEERS

DESIGNED - J.C.H.	DRAWN - S.M.	DATE - MAY - 1980	FILE
APPROVED - H.W.G.	CHECKED - S.M.	SCALE - H=1"=20' V=1"=5'	SHEET 42 OF