

Curve Data


C2 $\Delta = 27^\circ 22' 17''$ $R = 452.5'$ $T = 110.19'$ $L = 215.73'$	C4 $\Delta = 27^\circ 22' 17''$ $R = 397.5'$ $T = 96.79'$ $L = 189.89'$	C7 $\Delta = 44^\circ 15' 37''$ $R = 425'$ $T = 172.84'$ $L = 328.31'$
C3 $\Delta = 27^\circ 22' 17''$ $R = 425'$ $T = 103.49'$ $L = 203.03'$	C6 $\Delta = 44^\circ 15' 37''$ $R = 397.5'$ $T = 167.65'$ $L = 307.06'$	C8 $\Delta = 44^\circ 15' 37''$ $R = 452.5'$ $T = 184.02'$ $L = 349.55'$

LEGEND

- Beach Mark
- Iron Pin
- Monument
- ⊕ Gas Meter
- ⊕ Gas Valve
- ⊕ Gas Line
- ⊕ Power Pole (Typical Pole Symbol)
- ⊕ Power Line
- ⊕ Guy Wire Anchor
- ⊕ Telephone Line
- ⊕ Water Meter
- ⊕ Water Valve
- ⊕ Water Line
- ⊕ Fire Hydrant
- ⊕ Manhole
- ⊕ Sanitary Sewer Line
- ⊕ Fence Line
- ⊕ Flow Direction Indicator
- ⊕ Property or Right-of-Way Line (ROW)
- ⊕ Easement Line
- ⊕ Traffic Pull Box
- ⊕ Manhole Pole Foundation (Type A or B)
- ⊕ Pedestal Pole Foundation (Type C)
- ⊕ Sign Illumination Pole Foundation (Type D)
- ⊕ Top Of Curve
- ⊕ Flow Line

ESTIMATED QUANTITIES

ITEM	DESCRIPTION	UNIT	QUANTITY
01	CL A Conc. For Headwalls	CS	380.0
02	Rcp. Steel Headwall	LBC	302.0
03	48" RCP, CI III	LB	302.0

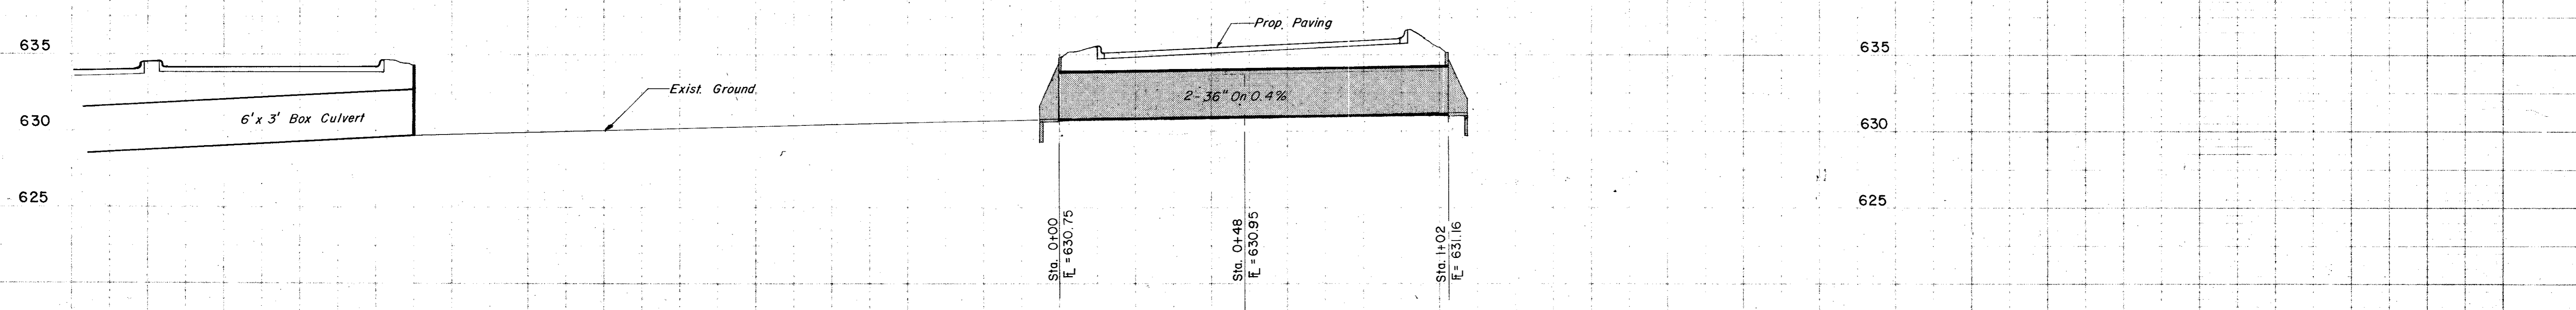

1	Revised Str. Swr.	7-28-80
No.	Revisions	Date

CITY OF ADDISON
COUNTY OF DALLAS, TEXAS
 DEPARTMENT OF PUBLIC WORKS
DRAINAGE INWOOD RD. (NEW)
BELT LINE ROAD
 MARSH LN. TO NORTH DALLAS PKWY.
 GINN, INC., CONSULTING ENGINEERS
 DESIGNED-J.C.H. DRAWN-S.M. DATE-MAY-1980 FILE
 APPROVED-HWG. CHECKED-S.M. SCALE-H=1"=20'/V=1"=5' SHEET 4.4 OF