



20 0 20 40
 scale 1" = 20' feet

SEE SHEET 12
 MATCH LINE STA. N 0+75

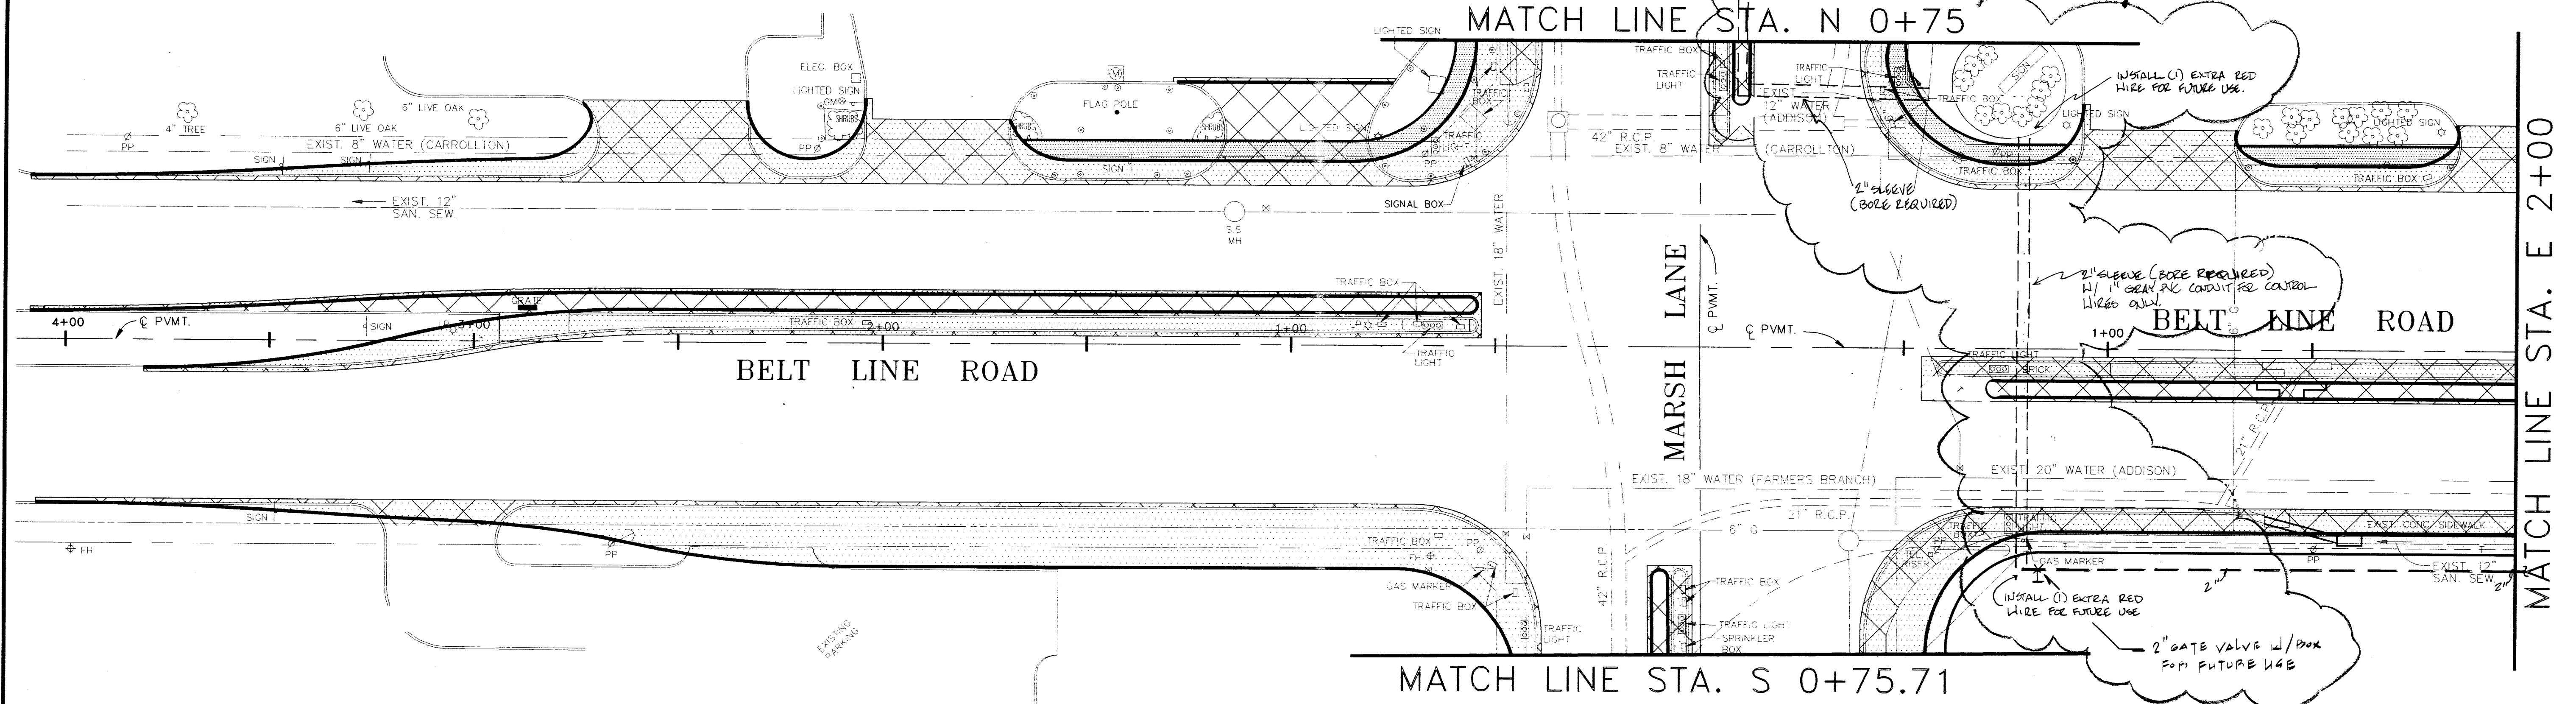


MATCH LINE STA. E 2+00

MATCH LINE STA. S 0+75.71

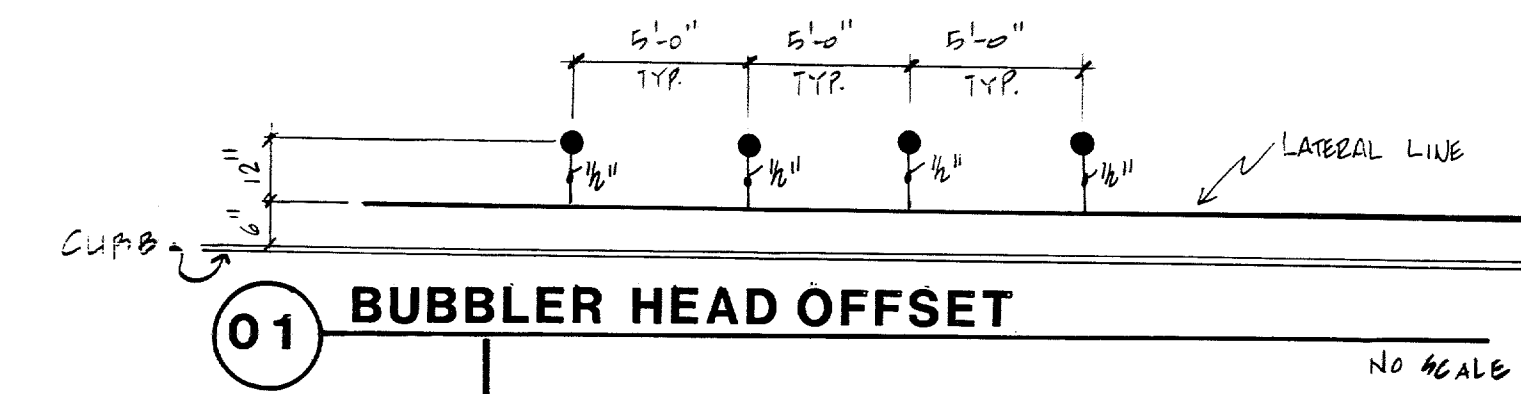

MATCH LINE STA. E 2+00

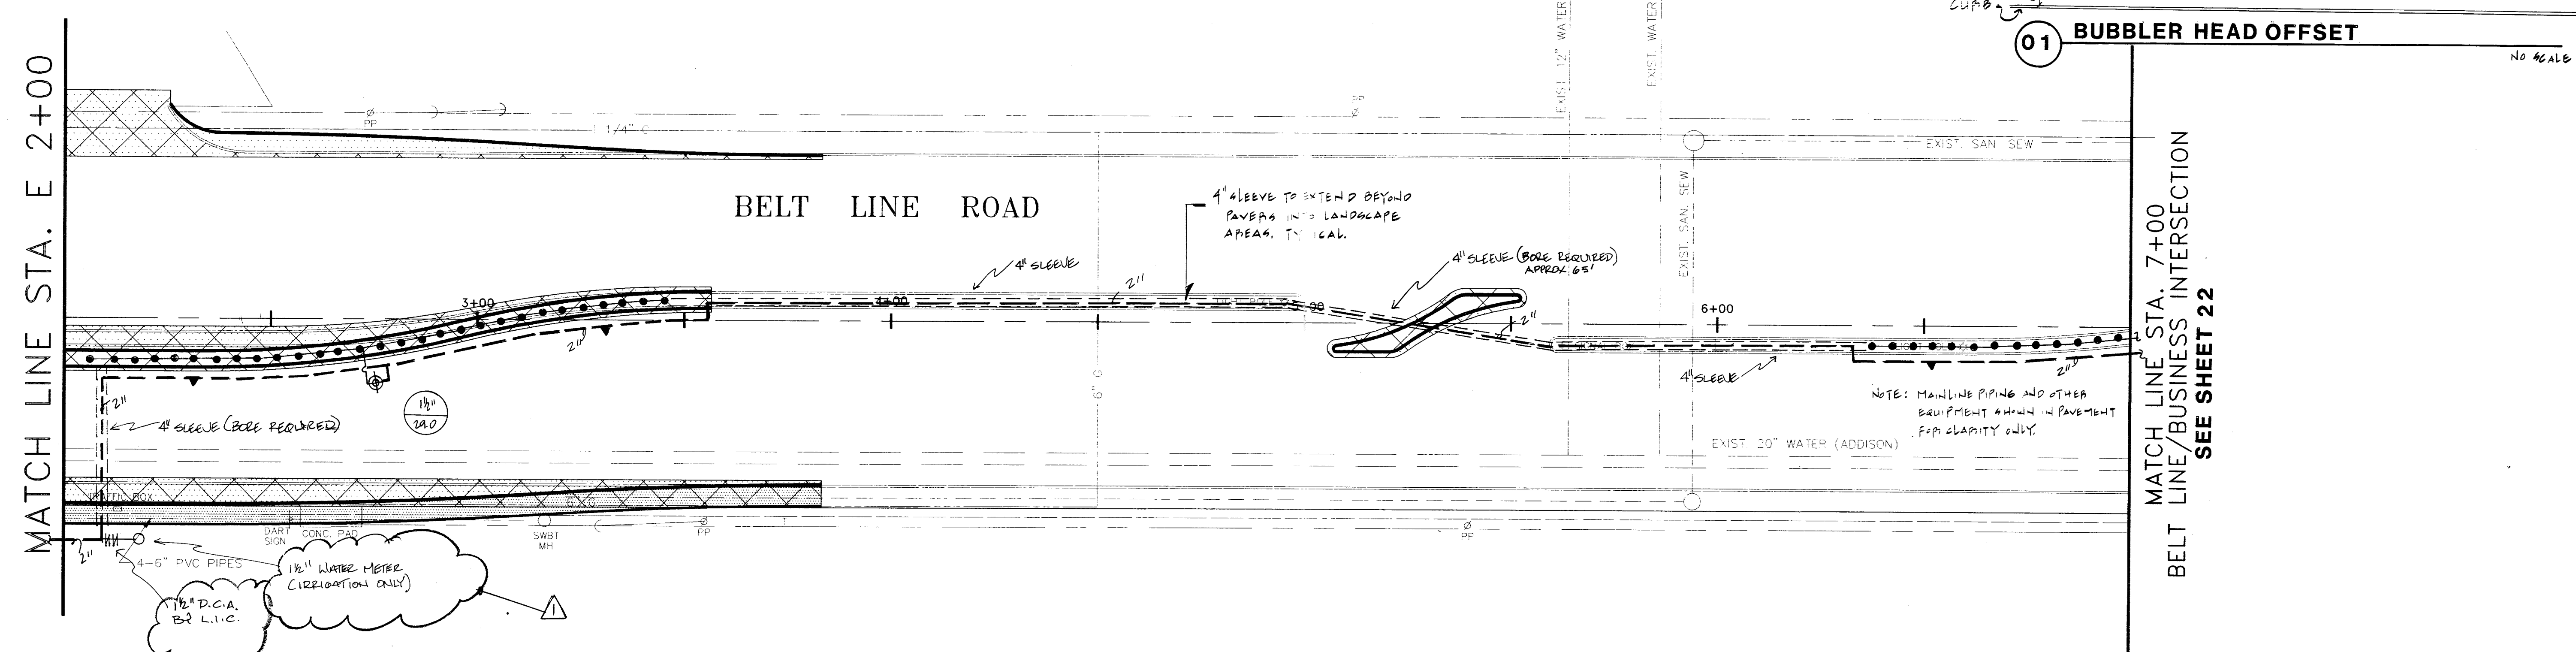

MATCH LINE STA. 7+00
 BELT LINE/BUSINESS INTERSECTION
 SEE SHEET 22

NOTE: MAINLINE PIPING AND OTHER EQUIPMENT SHALL BE IN PAVEMENT FOR CLARITY ONLY.

NO.	TOWN OF ADDISON COMMENTS	REVISION	BY	DATE	DESIGNED BY: J.W.	 Espey, Huston & Associates, Inc. Engineering & Environmental Consultants 13800 Montfort Drive, Suite 230 Dallas, Texas 75240 (214) 387-0771	SMR Landscape Architects 703 McKinney, LB 107 Suite 403 Dallas, Texas 75202 (214) 871 0083 Steven M. Rahn, ASLA	IRRIGATION PLAN BELT LINE ROAD EAST OF MARSH LANE TO BUSINESS AVE. PAVING AND DRAINAGE IMPROVEMENTS BELT LINE ROAD AT MARSH LANE for THE TOWN OF ADDISON	SHEET NO.
					FILE:				13 OF 46 SHEETS JOB NO. 13921