


10/28/92  
 10:28:92  
 10/28/92  
 10:28:92  
 10/28/92  
 10:28:92


THESE PLANS HAVE BEEN  
 REVISED TO CONFORM WITH  
 CONSTRUCTION RECORDS  
 BY **Tom Sinerly**  
 DATE **10-28-92**

| REVISIONS |             |      |    |
|-----------|-------------|------|----|
| NO.       | DESCRIPTION | DATE | BY |
|           |             |      |    |
|           |             |      |    |
|           |             |      |    |

**DUNAWAY ASSOCIATES,  
 INC.**


**DeShazo, Starek, & Tang, Inc.**  
 ENGINEERS • PLANNERS  
 330 Union Station  
 Dallas, Texas 75202-4802  
 (214) 748-6740  
 Fax: (214) 748-7037

DESIGN BY: BDJ DATE: 2-14-92  
 DRAWN BY: SAM DATE: 2-14-92  
 CHECKED BY: BDJ DATE: 2-14-92  
 APPROVED BY: \_\_\_\_\_ DATE: \_\_\_\_\_

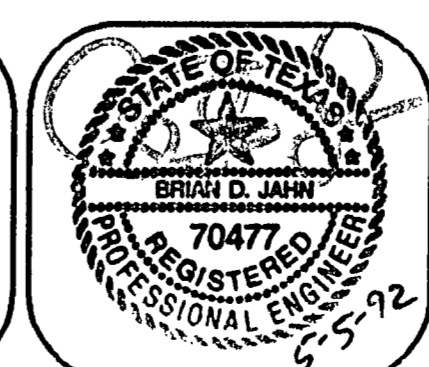

**PAVEMENT MARKINGS**  
 Scale: 1" = 20'

SHEET  
**7**  
 OF  
**19**  
 91268-07