

SERVICE ASSEMBLY SCHEMATIC

CONNECTIONS AT SIGNAL CONTROLLERS

CONNECTIONS AT POLE BASE

SIGNAL CONTROLLER

SIGNAL POLE BASE


THESE PLANS HAVE BEEN REVISIONED TO CONFORM WITH LATEST CODES AND RECORDS
 DRAWN BY *Tom Simms*
 DATE: 10-28-92

REVISIONS			
NO.	DESCRIPTION	DATE	BY

DUNAWAY ASSOCIATES, INC.

DeShazo, Starek, & Tang, Inc.
 ENGINEERS • PLANNERS
 330 Union Station
 Dallas, Texas 75202-4802
 (214) 748-6740
 Fax: (214) 748-7037

DESIGN BY: BDJ DATE: 2-14-92
 DRAWN BY: SAM DATE: 2-14-92
 CHECKED BY: BDJ DATE: 2-14-92
 APPROVED BY: _____ DATE: _____

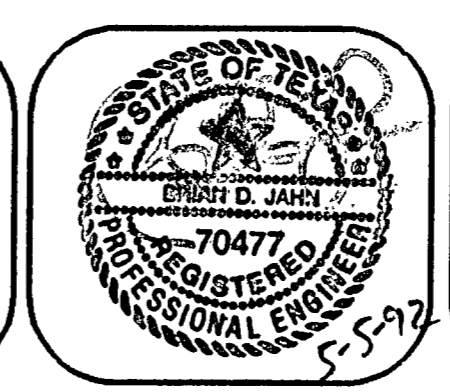

SERVICE POLE AND GROUNDING DETAILS
 Scale: NONE

SHEET 17 OF 19
 91268-17