

WARNING: CONTRACTOR SHALL TAKE MEASURES TO INSURE PROTECTION OF EXISTING TRAFFIC LOOP DETECTOR. THE AREA OF THIS LOOP MUST NOT BE BROKEN OR CUT DURING CONSTRUCTION.

RELOCAT EXIST. TRAFFIC SIGNAL POLE & PULL BOX TO BEHIND SIDEWALK AS SHOWN. EXTEND EXIST. 3" PVC TRAFFIC CONDUIT & SIGNAL CABLE TO NEW PULL BOX LOCATION.


EXISTING 2'-6"x40' TRAFFIC LOOPS TO BE RE-SAWED AT COMPLETION OF CONSTRUCTION & NEW 1"IN DETECTOR LOOP CABLE (1C#12) TO BE LAID PER DETAIL SHEET T-4.

30' PED. VEHICULAR ACCESS & INGRESS/EGRESS ESMT. VOL. 88165, PG. 3914

50' S.S. & DRNG. ESMT. VOL. 92016, PG. 2251

*Lawrence A. Cates*  
10/9/93

AS-BUILTS  
I CERTIFY THIS PROJECT WAS CONSTRUCTED IN GENERAL CONFORMANCE WITH THESE CONSTRUCTION PLANS AND WILL FUNCTION AS DESIGNED.

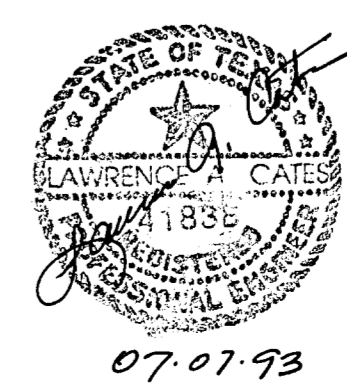

TRAFFIC SIGNAL INSTALLATION						
COMMERCIAL DR. AT BELTLINE ROAD						
TOWN OF ADDISON, TEXAS						
LAWRENCE A. CATES & ASSOC. CONSULTING ENGINEERS DALLAS, TEXAS						
DESIGN	DRAWN	DATE	SCALE	NOTES	FILE	NO.
LAC	LAC	7/7/93	1"=20'		92076	T-1