
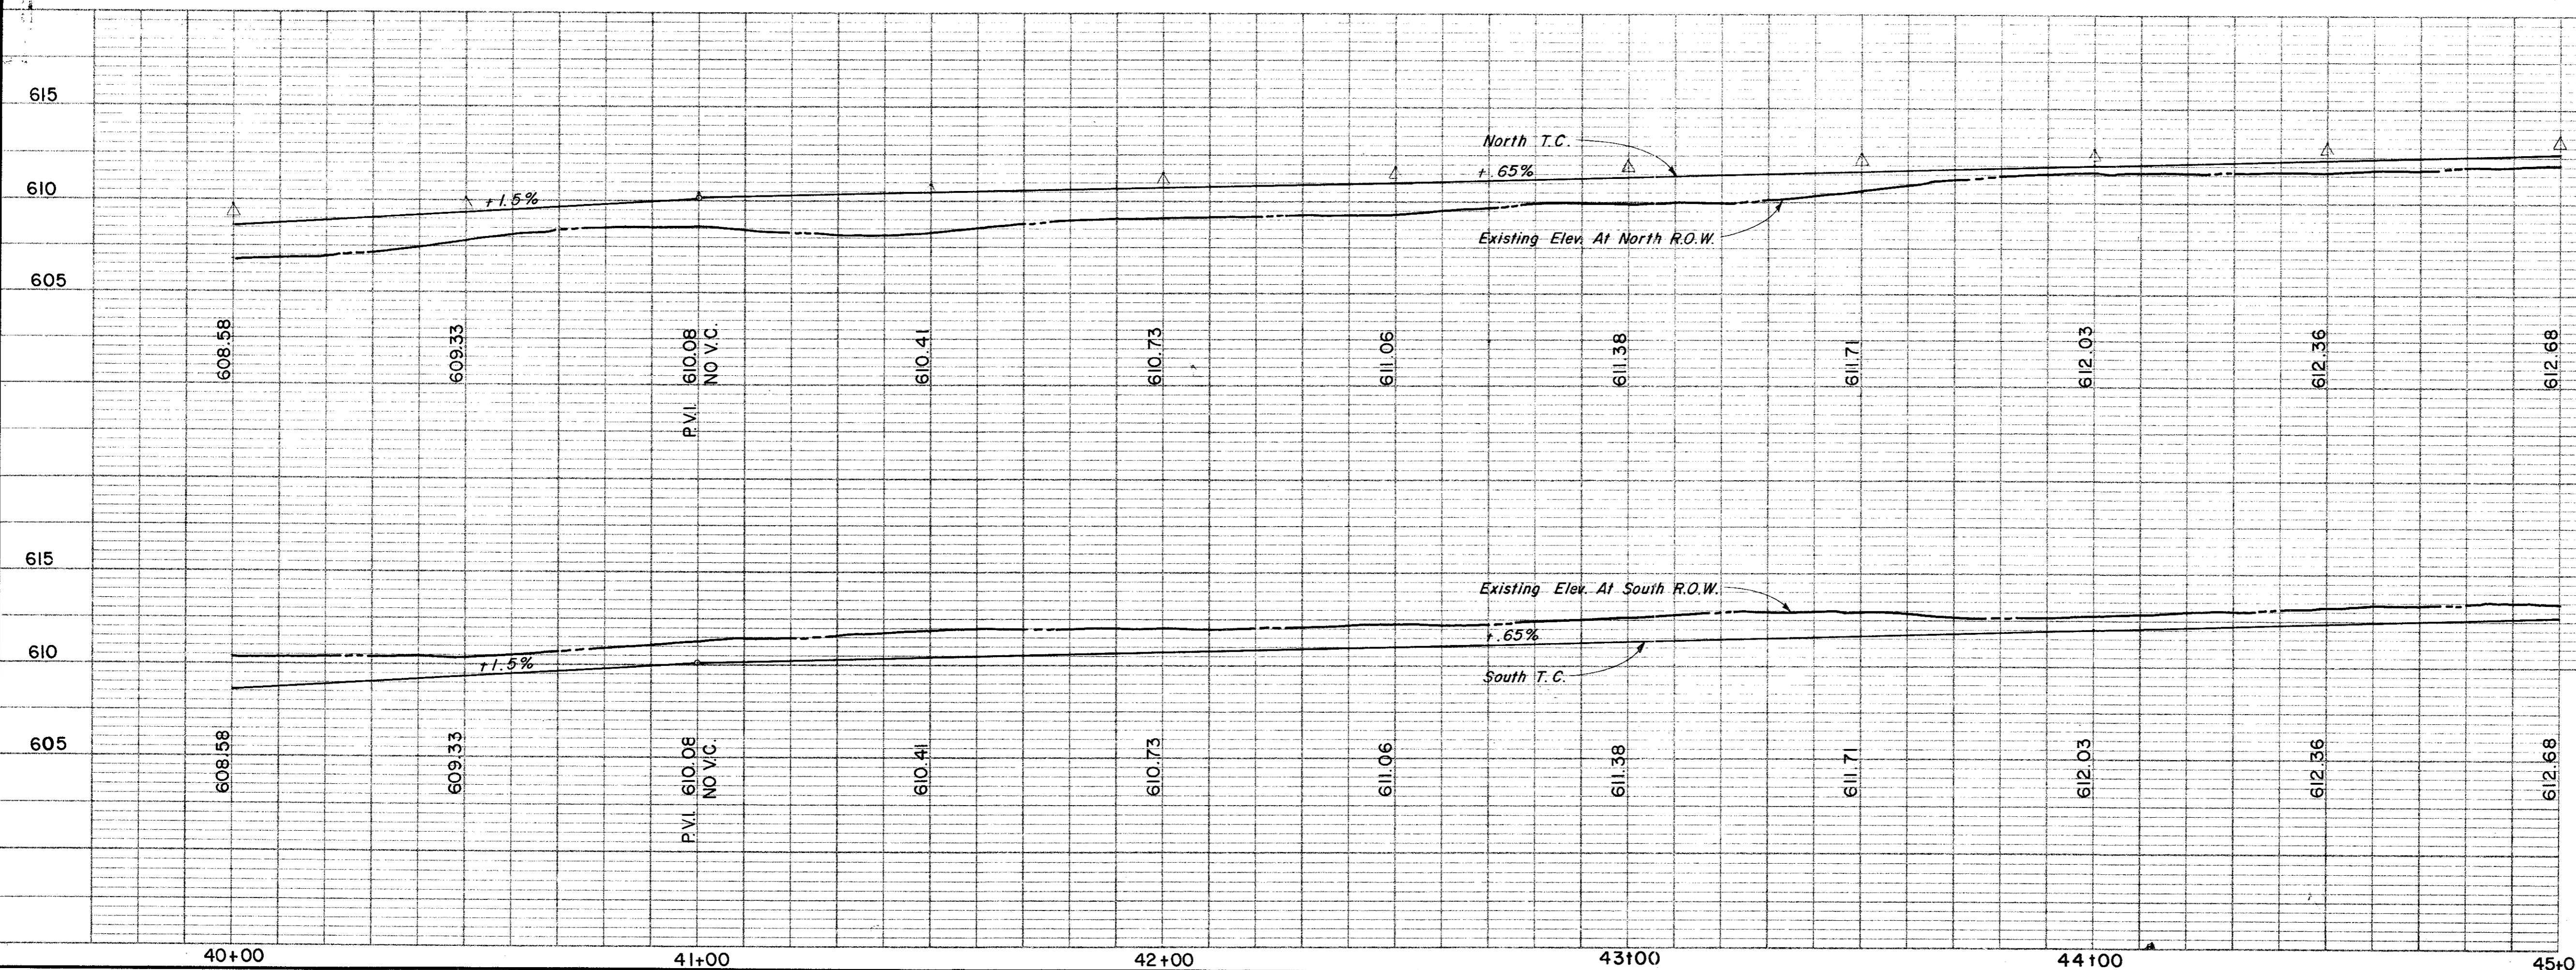


ESTIMATED QUANTITIES			
ITEM	DESCRIPTION	UNIT	QUANTITY
100	Prepare Roadway R.O.W	Sta.	5
104.1	Remove Old Concrete, Pavement & Median	LF	45
104.2	Sawed Break-Out Groove	CY	261.8
160	Unclassified Road Excavation(Dens Cont.)	CY	16.27
248	6" Flex Base (Dens Cont)(Ty A, Gr 2,C13)	TY	10
260.1	Lime (TyA) Slurry Method	SY	55.97
260.2	6" Lime Treated Subgrade (Dens Cont)	SY	4477.22
340.1	3" Hot Mix Asph (Ty D) Resurf Shoulder	Ton	73.34
340.2	6" Hot Mix Asphalt (Ty B)	Ton	
360.1	8" Conc Pavement (3000 PSI)	SY	4255
360.2	6" Conc Monolithic Curb(3000 PSI)	LF	1473
360.3	4" Non-Reinf Conc In Median(2000PSI)	SY	100.96
340.3	2" Hot Mix Asphalt (Ty D) Transition	Ton	6.05
640.5	2" PVC SCH 40 (Conc. Encasement)	L.F	45
522	Conc Curb & Gutter Class A	LF	
524	Conc Driveways, App 5" Reinf Conc(3000PSI)	SY	249.19
630.1	Foundation (Ty A) Traffic Sig In Place	EA	
630.2	Foundation (Ty B) Traffic Sig In Place	EA	
630.3	Foundation (Ty C) Traffic Sig In Place	EA	
630.4	Foundation (Ty D) Illumination	EA	3
640.1	1/2" PVC Conduit, Furnish & Install	LF	500
640.2	2" PVC Conduit, Furnish & Install	LF	500
640.3	3" PVC Conduit, Furnish & Install	LF	
640.4	Pull Box, Complete In Place	EA	2
752.1	Traffic Buttons - Single Refl Ty P15 White	EA	52
752.2	Traffic Buttons - Single Refl Ty P18-1 White	EA	18
754.1	Traffic Buttons - Nonrefl, Ty P7 White	EA	252

LEGEND	
□	Sheet Mark
○	Line Pin
⊕	Monument
⊕	Gas Meter
⊕	Gas Valve
⊕	Gas Line
⊕	Power Pole (Typical Pole Symbol)
⊕	Power Line
⊕	Gay Wire Anchor
⊕	Telephone Line
⊕	Water Meter
⊕	Water Valve
⊕	Water Line
⊕	Fire Hydrant
⊕	Manhole
⊕	Sanitary Sewer Line
⊕	Fence Line
⊕	Flow Direction Indicator
⊕	Property or Right-of-Way Line(R.O.W)
⊕	Easement Line
⊕	Traffic Pole Base
⊕	Mast Arm Pole Foundation (Type A or B)
⊕	Pedestal Pole Foundation (Type C)
⊕	Signal Illumination Pole Foundation (Type D)
⊕	Top Of Curb
⊕	Flow Line

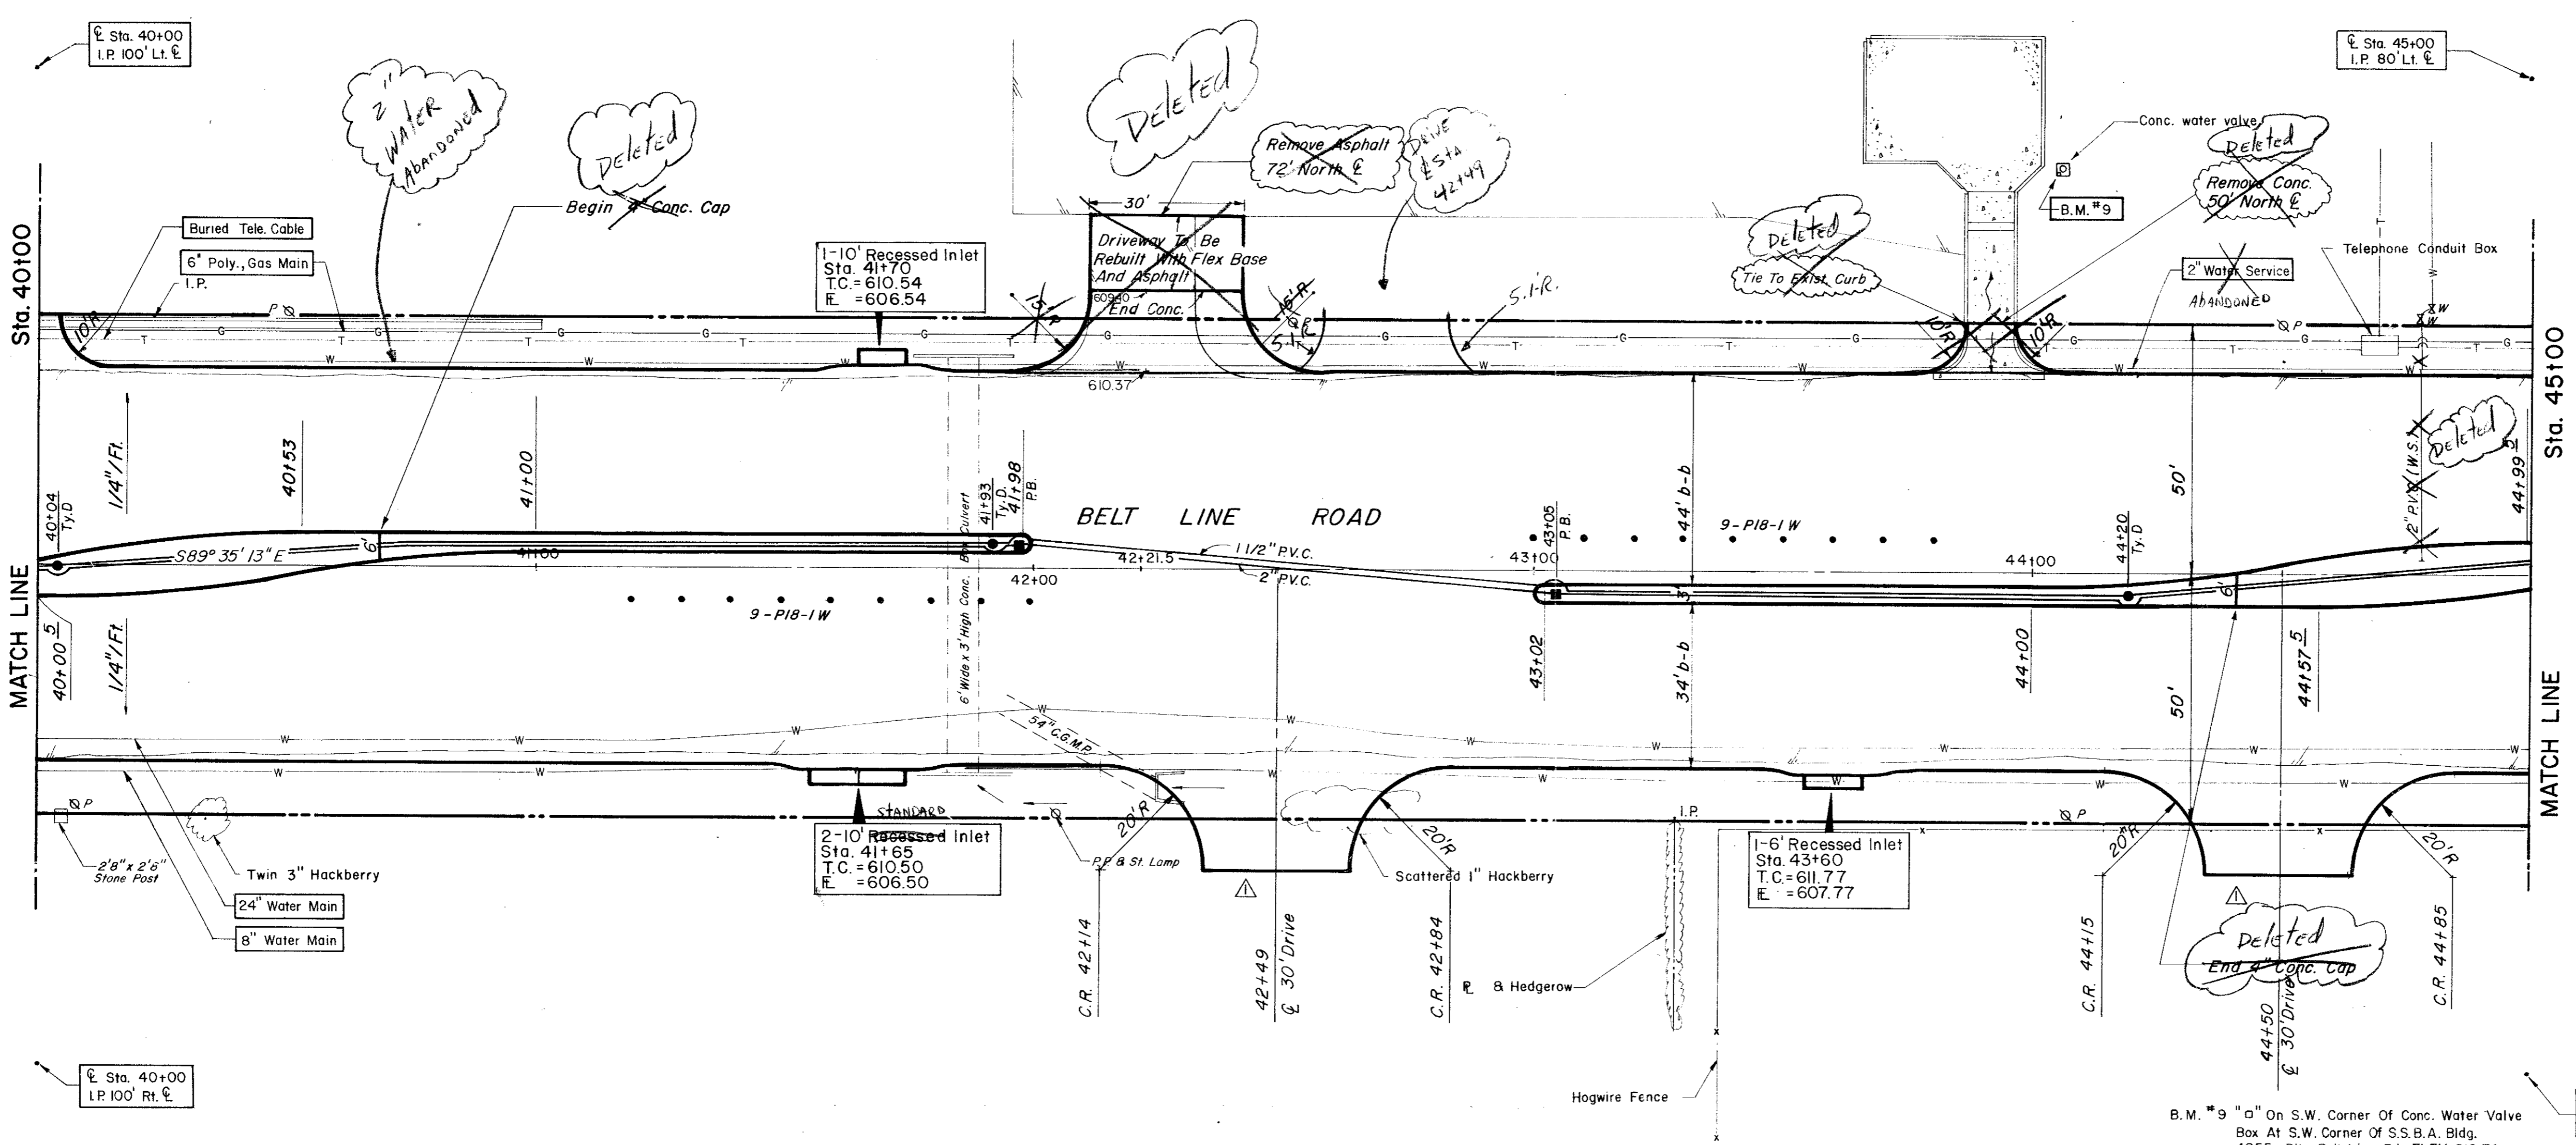

CITY OF ADDISON		
COUNTY OF DALLAS, TEXAS		
DEPARTMENT OF PUBLIC WORKS		
PAVING Sta. 40+00 to 45+00		
BELT LINE ROAD		
MARSH LANE TO NORTH DALLAS PKWY.		
GINN, INC., CONSULTING ENGINEERS		
DESIGNED - H.B.J.	DRAWN - B.H.	DATE - MAY - 1980
APPROVED - H.W.G.	CHECKED - S.M.	SCALE - H=1"=20'/V=1"=5'
No. _____		Date 2/25/81
Revision _____		